

A close-up photograph of a rusty metal grate. The grate is made of a grid of rectangular openings. The word "STOP" is embossed in large, bold, capital letters across the center of the grate. The metal is heavily corroded, with a thick layer of reddish-brown rust covering most of the surface. The lighting is bright, creating strong shadows and highlights on the raised edges of the letters and the grid.

**Appendix D: Lift Station Evaluation
sheets**



District of West Kelowna

Sanitary Lift Station Evaluation

Station: Inverness LS 1
Reviewed By: Jim Kentel

Year Constructed: 8/1/2011
Year Upgraded:

Matrix Rating		
(10 - highest rating)	Civil	35
(1 - lowest rating)	Process Mechanical	152
	Electrical Instrumentation	142
	Total Station Rating	329 (max. rating 370 points)



Civil:**Matrix
Rating**

Parking Area:	Yes	n/a
Drainage:	Good	10
Influent sewer:	Good 200mm Gravity PVC	10
Site access:	Good	10
Water service:	Irrigation service only	5
		35

Process Mechanical:


Station type:	FRP 2.44m diameter	n/a
Number of pumps:	2	n/a
Pump Redundancy:	Yes	n/a
Pump Manufacturer / Type:	FLYGT	10
Pump Model:	NP 3085MT	n/a
Rated Capacity:	10.2L/S @ 5.9m TDH	n/a
Capacity Confirmation:		n/a
Forcemain pipe type / diameter:	PVC/100mm	10
Header pipe type / diameter:	FRP/100	10
Check valve type / diameter:	Sinking Ball HOL5087/100	10
Isolation valve type / diameter:	Valmatic Camcentric 5804N	10
Piping Condition:	NEW	10
Emergency pumpout connection:	Yes	10
Pressure gauges:	Yes	10
Inlet bar screen:	No	1
Wetwell condition:	Good	10
Access Hatches:	MSU	10
Ladder / Platform:	Alum/FRP	10
Wetwell benching:	Top base	10
Odour Control:	Carbon	10
Ventilation:	Yes	10
Water washdown:	No	1
Confined Space Entry Requirements	Yes Davit	10
		152

Electrical / Instrumentation:


Matrix
Rating

Service Type	V / A / Phase / Wire	n/a
Pump 1 :	HP 3.0	n/a
	Volts/600 Rpm/1695	n/a
	FLA 3.3A	n/a
Starting Current	17A	n/a
Pump 2 :	HP 3.0	n/a
	Volts/600 Rpm/1695	n/a
	FLA 3.3	n/a
Starting Current	17A	n/a
Control System:	Yes	10
Alarm Functions:	Yes	10
		n/a
		n/a
		n/a
Receptacles:	Yes	10
Interior Lighting:	Yes	10
Exterior Lighting:	No	1
SCADA / Telemetry:	Yes	10
Main Breaker:	100A	10
Control Panel:	Yes	10
Lighting Panel:	Yes	10
Flowmeter:	Siemons FM 5100W	10
Grounding:	Yes	10
Surge Protection:	Yes	10
UPS:	Yes	10
PLC:	Yes	10
Level Control:	Milltronics/Bulbs	10
Standby Generator:	No	1
		142
Comments:	New Station	

"Please note that it is the user's responsibility to confirm the accuracy of the as-constructed information shown on this drawing before proceeding with any work (i.e. design or construction) that is based on that information."

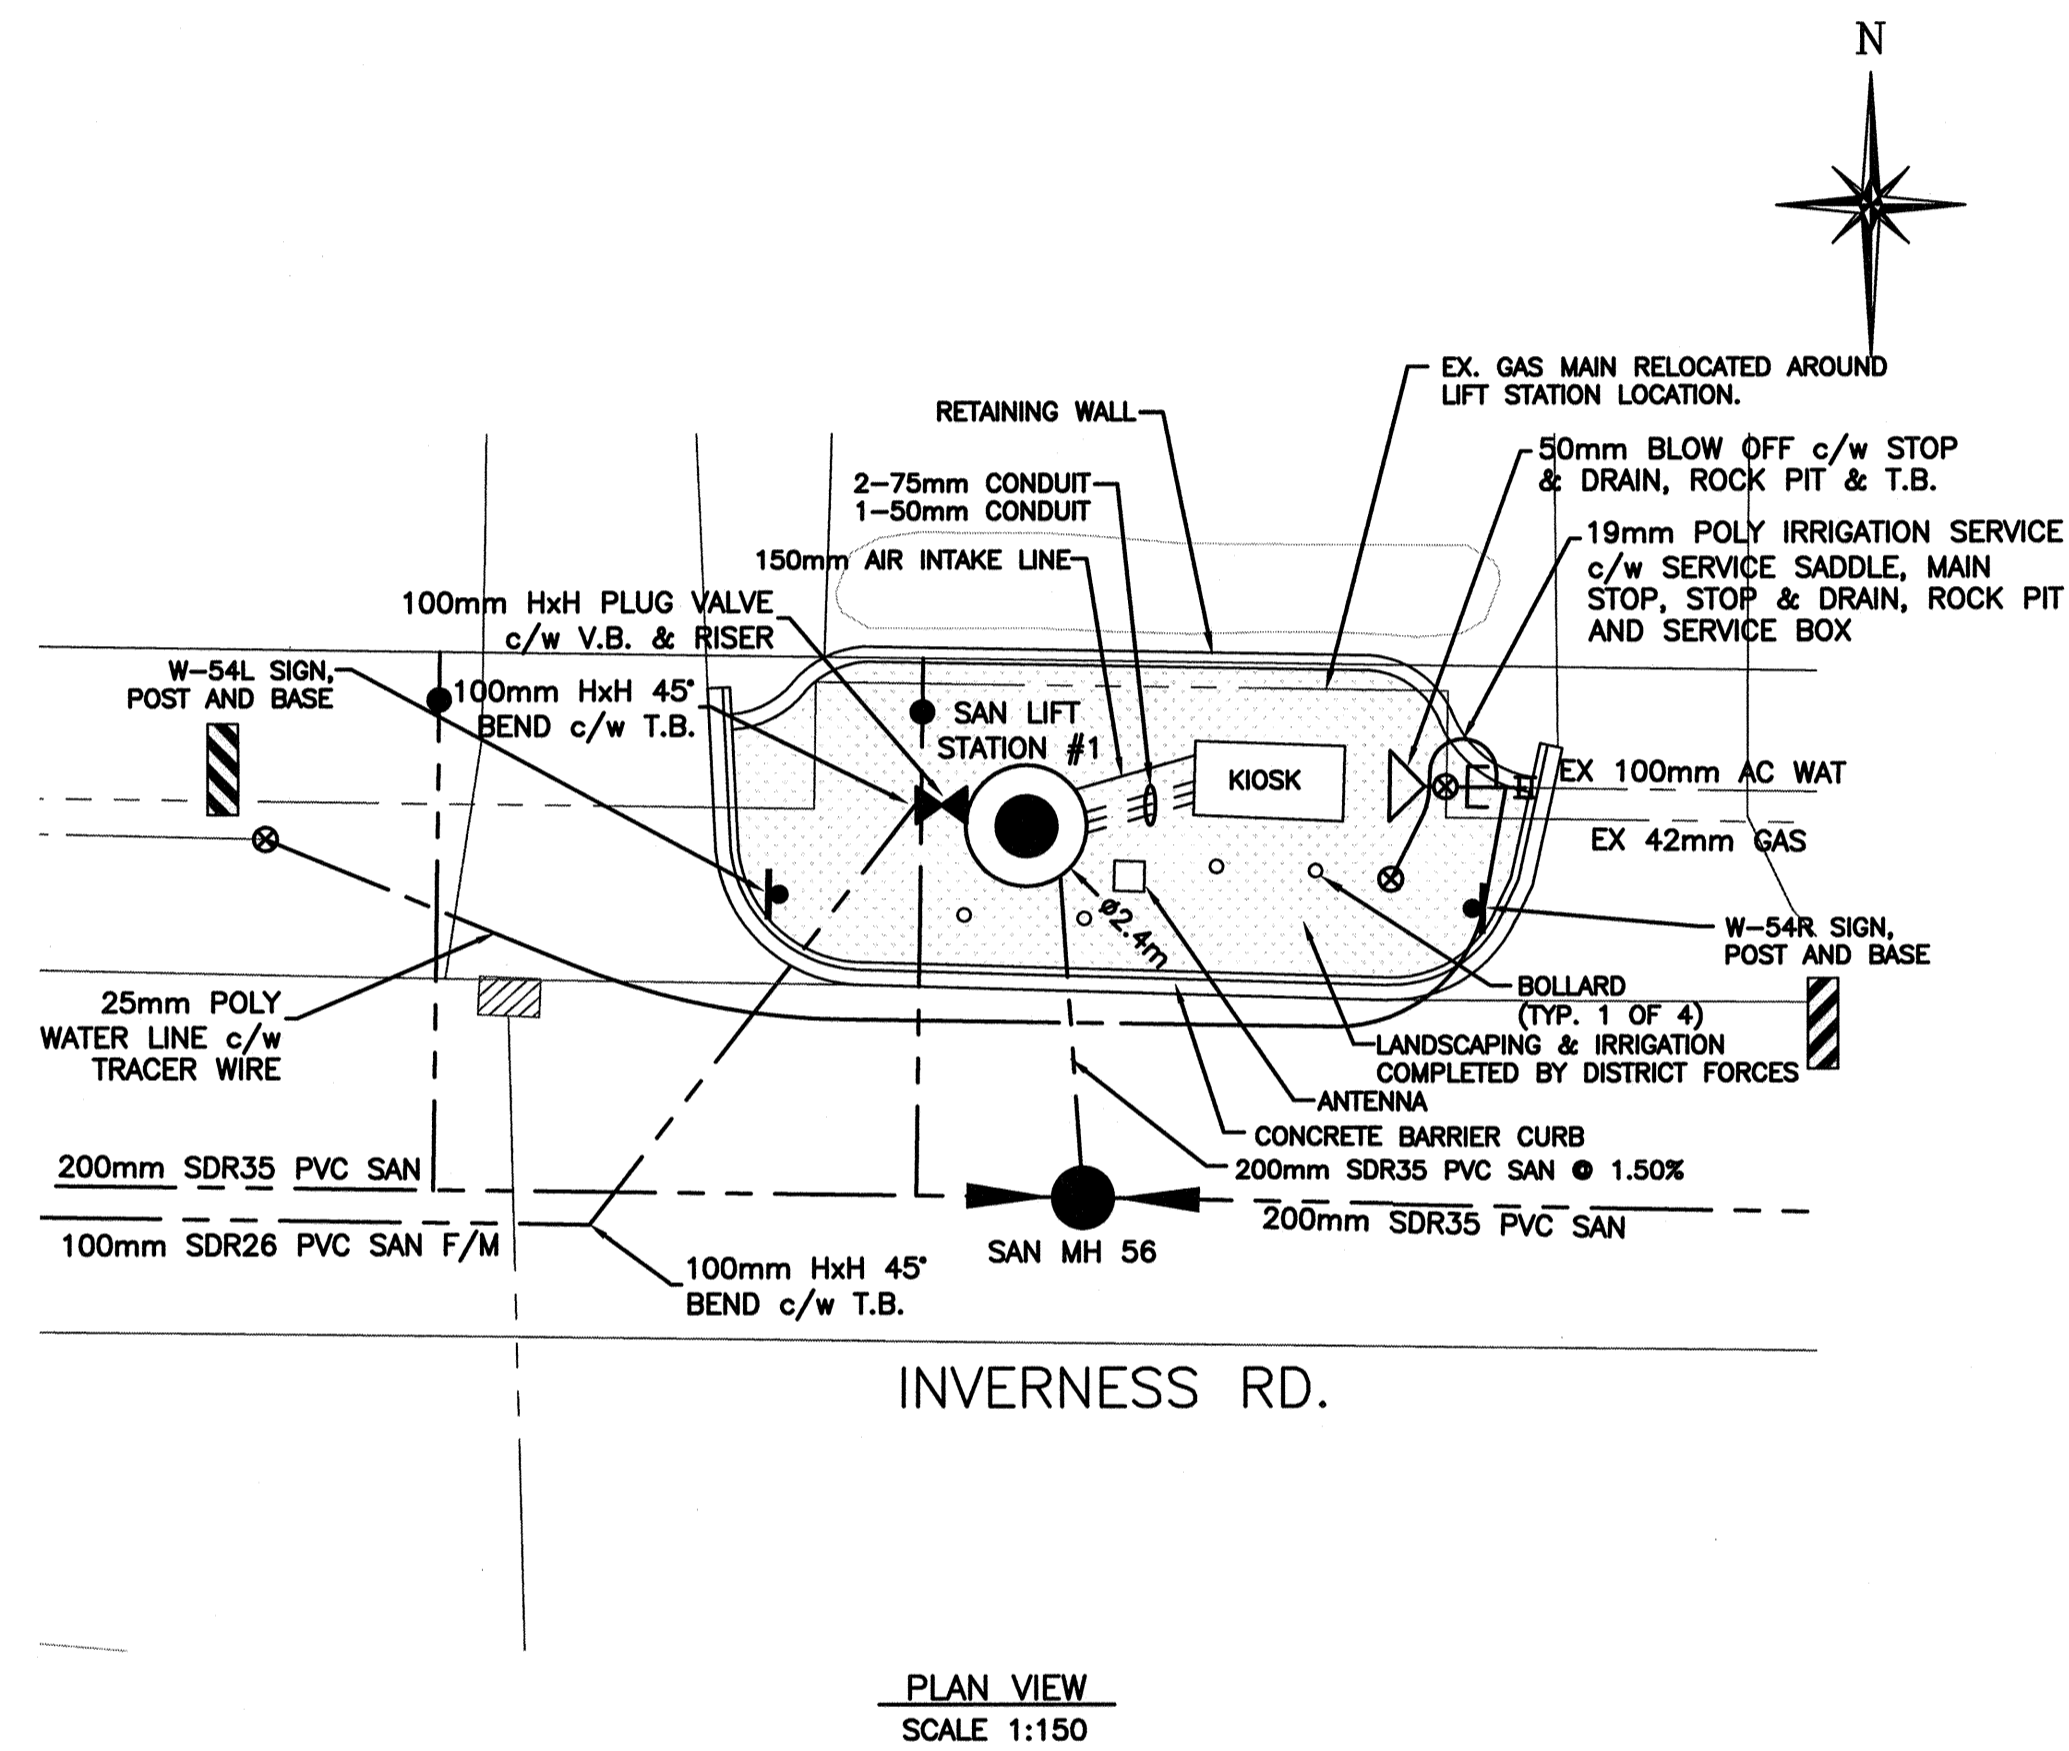



PLAN VIEW
SCALE 1:150

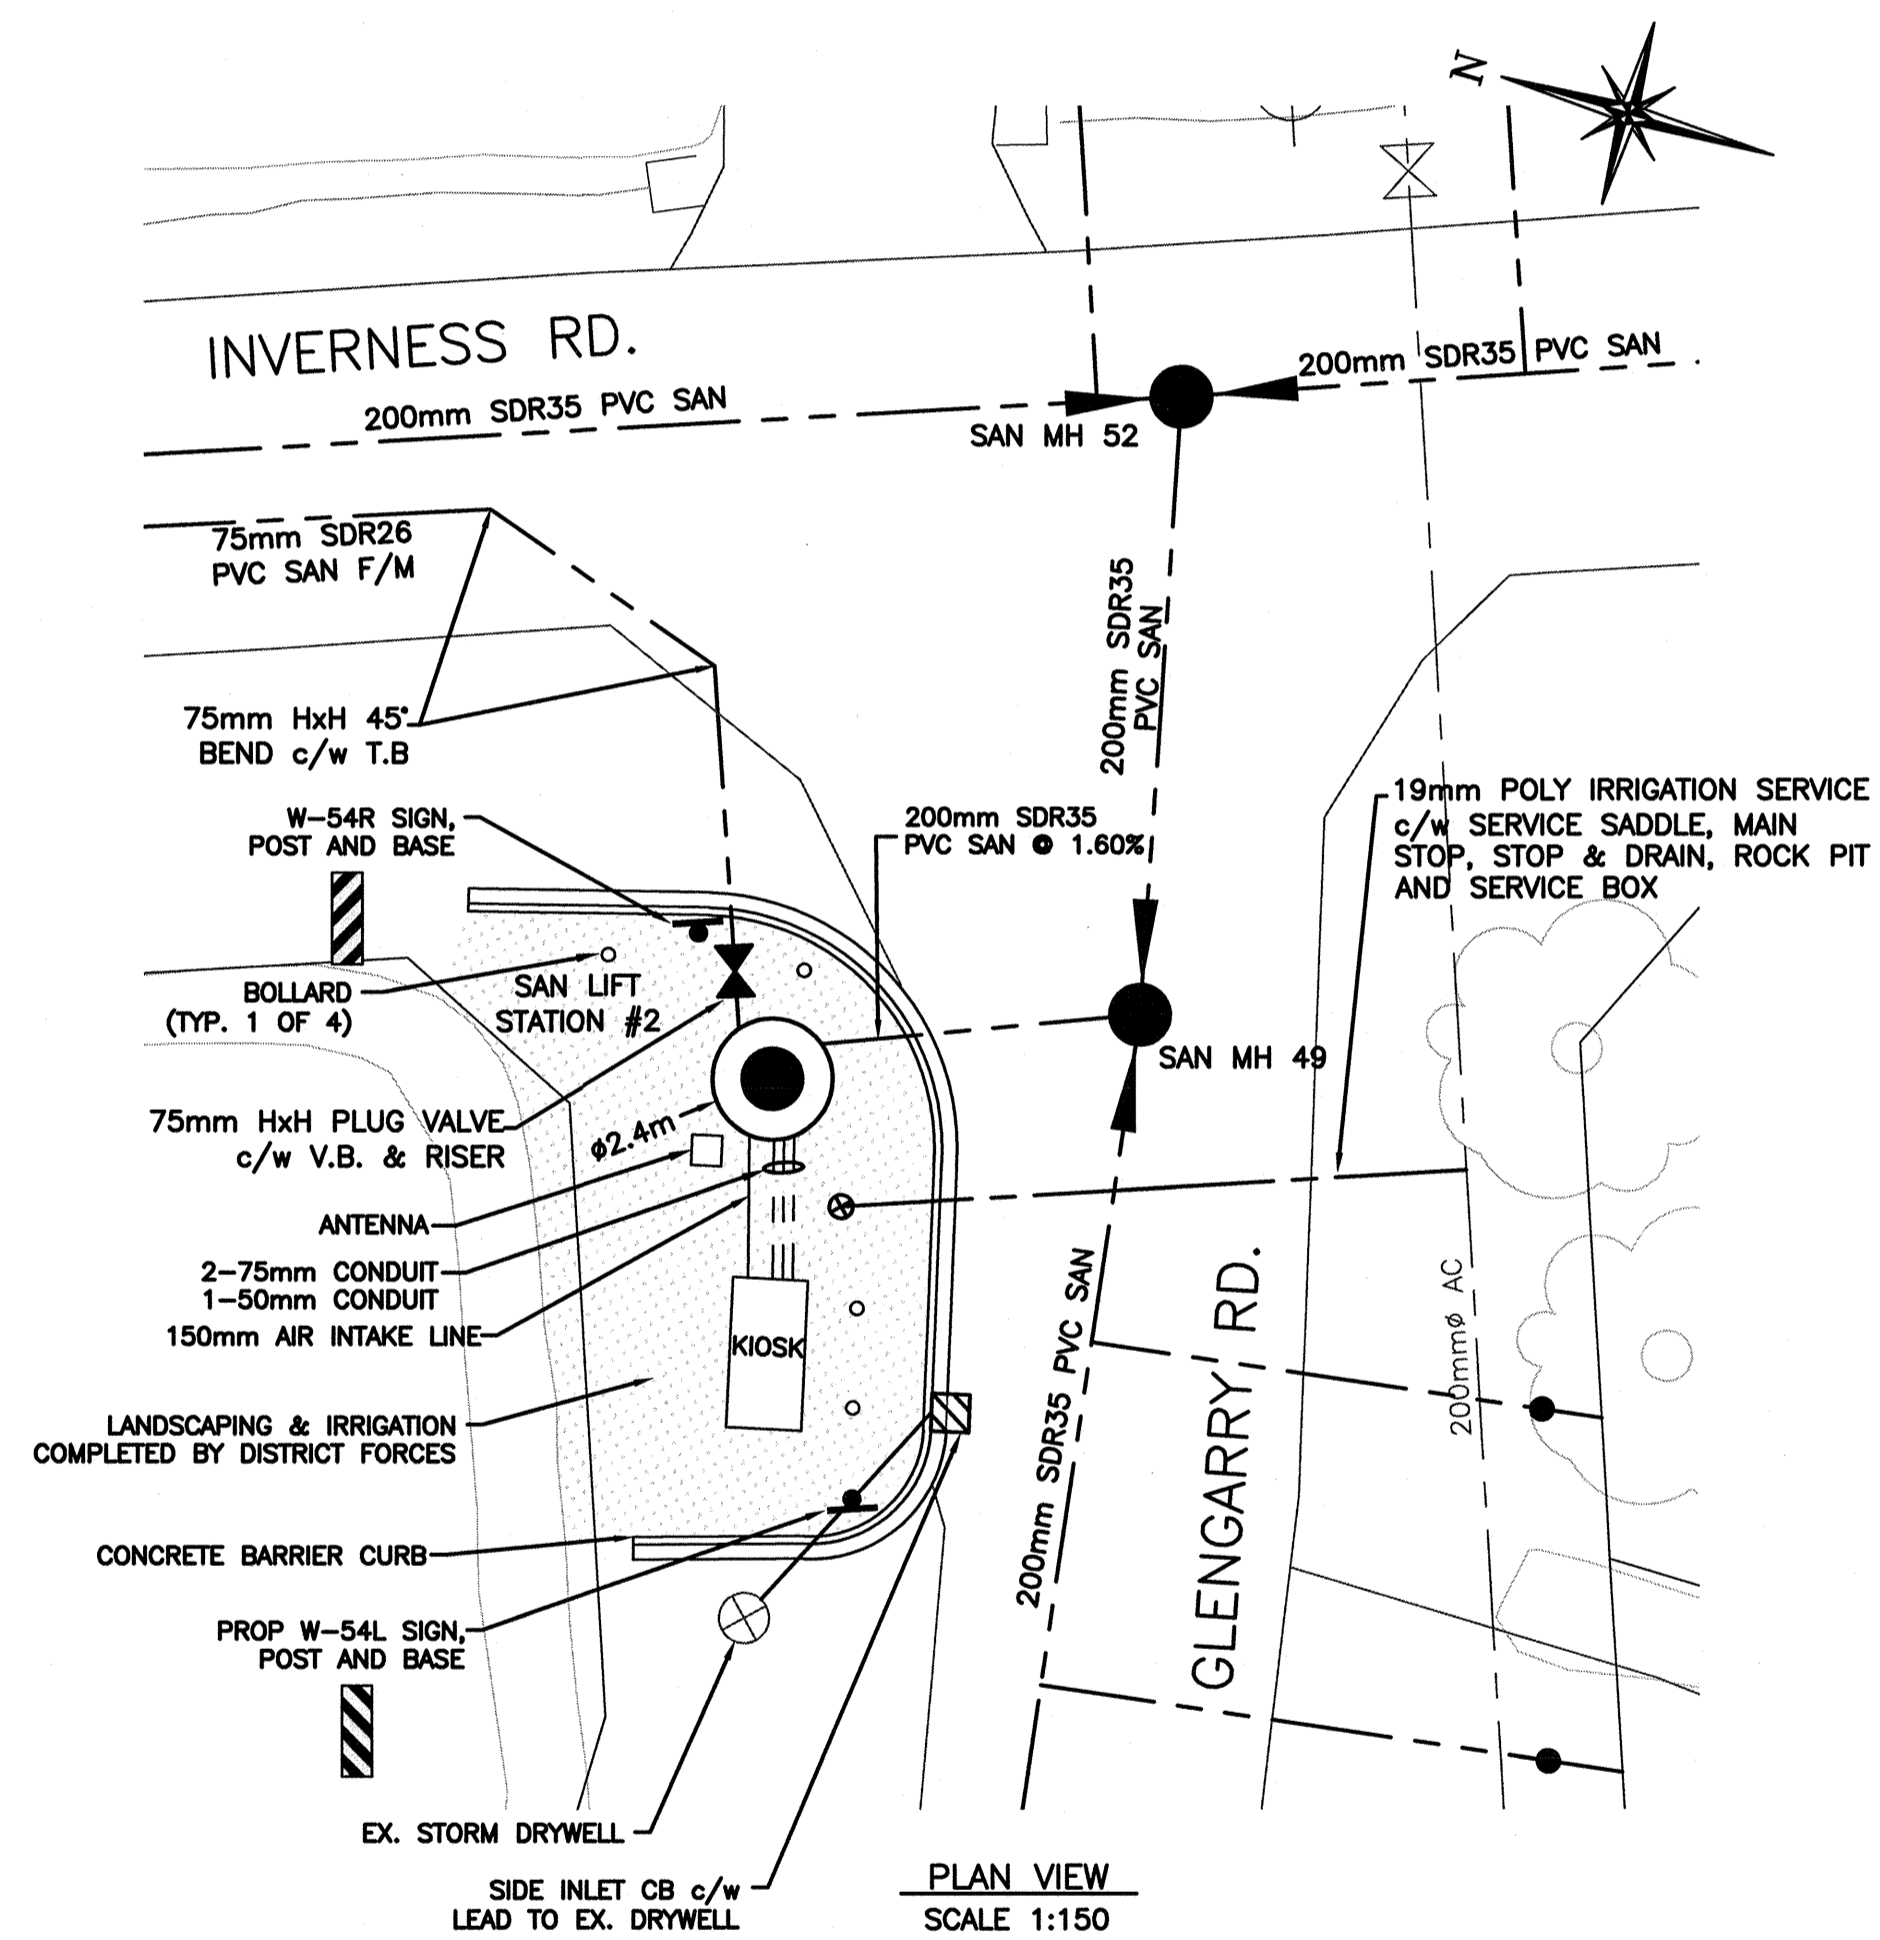

PLAN VIEW
SCALE 1:150

LEGEND	
CABLE TV	∩ CAP
GAS	■ CATCH BASIN
SAN. SEWER	∇ ELECTRICAL BOX
STORM SEWER	⊕ HYDRANT
U.G. ELECTRICAL	⊘ VALVE
U.G. TELEPHONE	□ LAMP STANDARD
WATER	○ SAN # SANITARY MH (EXISTING OR FUTURE)
	● SAN # SANITARY MH
	○ STM # STORM MH (EXISTING OR FUTURE)
	● STM # STORM MH
	⊠ TRANSFORMER
	⊞ UTILITY JUNCTION BOX

No.	DATE	BY	REVISION	Chk'd	No.	DATE	BY	STATUS	Chk'd
5					5			PLAN OF RECORD	
4	04.03.2012	CLS	PLAN OF RECORD		4			APPROVAL FOR CONSTRUCTION	
3	05.31.2011	CLS	ISSUED FOR CONSTRUCTION		3			FOR TENDER	
2	05.02.2011	CLS	ISSUED FOR TENDER		2			FOR APPROVAL	
1	03.11.2011	CLS	ISSUED FOR TENDER REVIEW		1			PRELIMINARY	







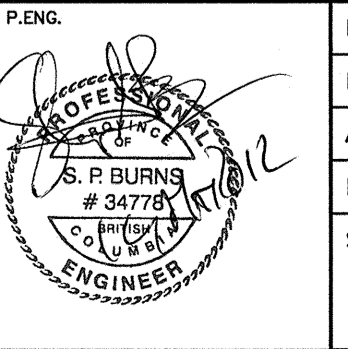
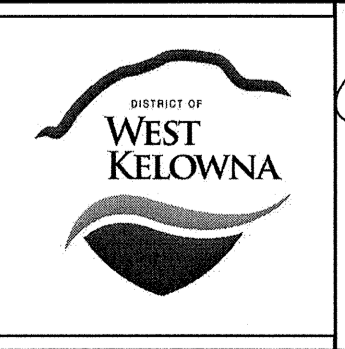


DRAWN	CLS
DESIGN	SPB
APPROVED	SPB
DATE	JANUARY 2011
SCALE	AS NOTED

Stantec Consulting Ltd.
400-1620 Dickson Avenue,
Kelowna, B.C. V1Y 9Y2
Tel. (250) 860-3225
Fax. (250) 860-3367

**GLENROSA SEWER - PHASE 3
INVERNESS RD. & GLENGARRY RD.
SANITARY LIFT STATION DETAILS**

DRAWING NO.	S01
REV. NO.	4
	112720220

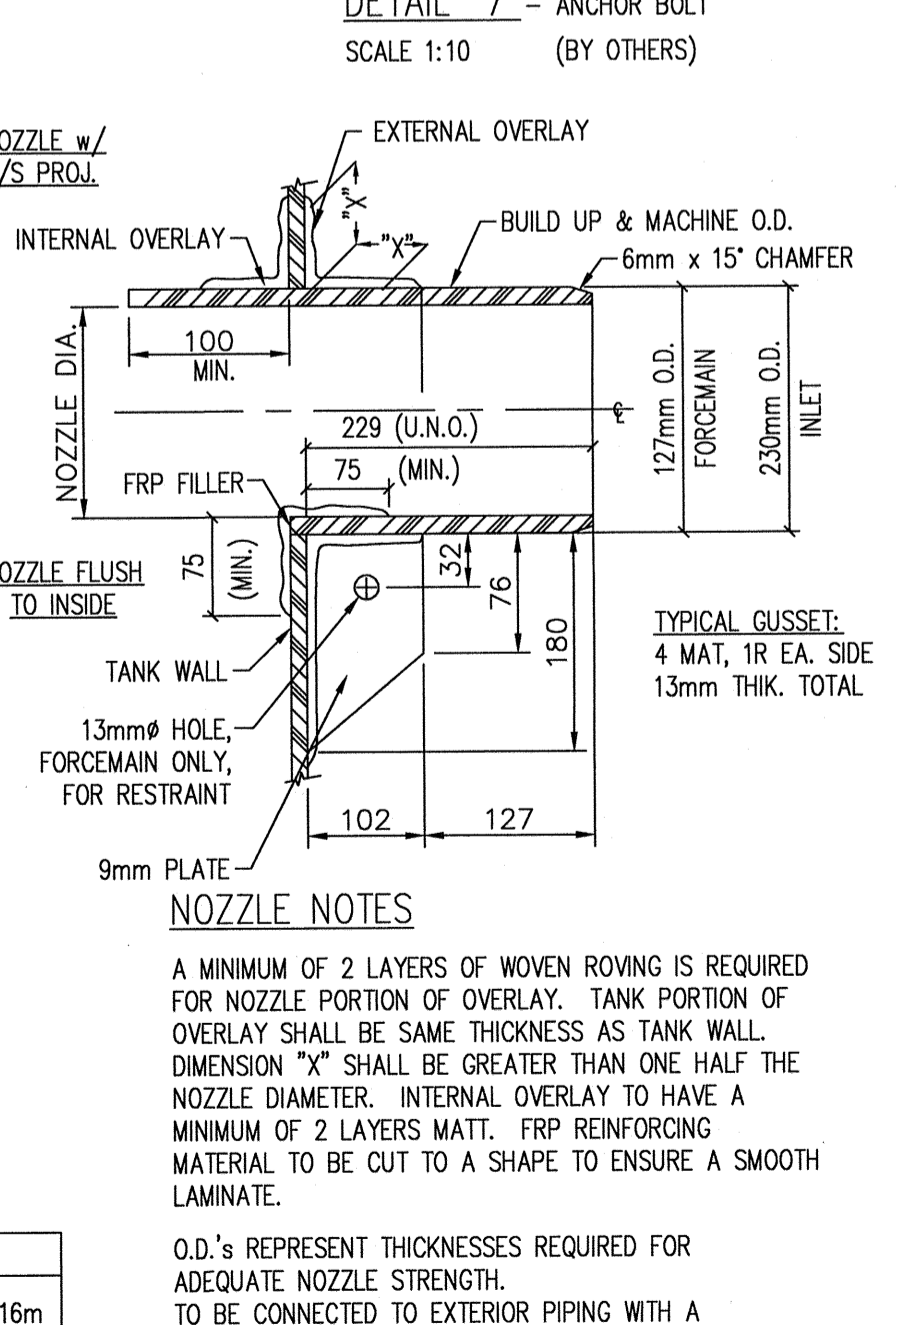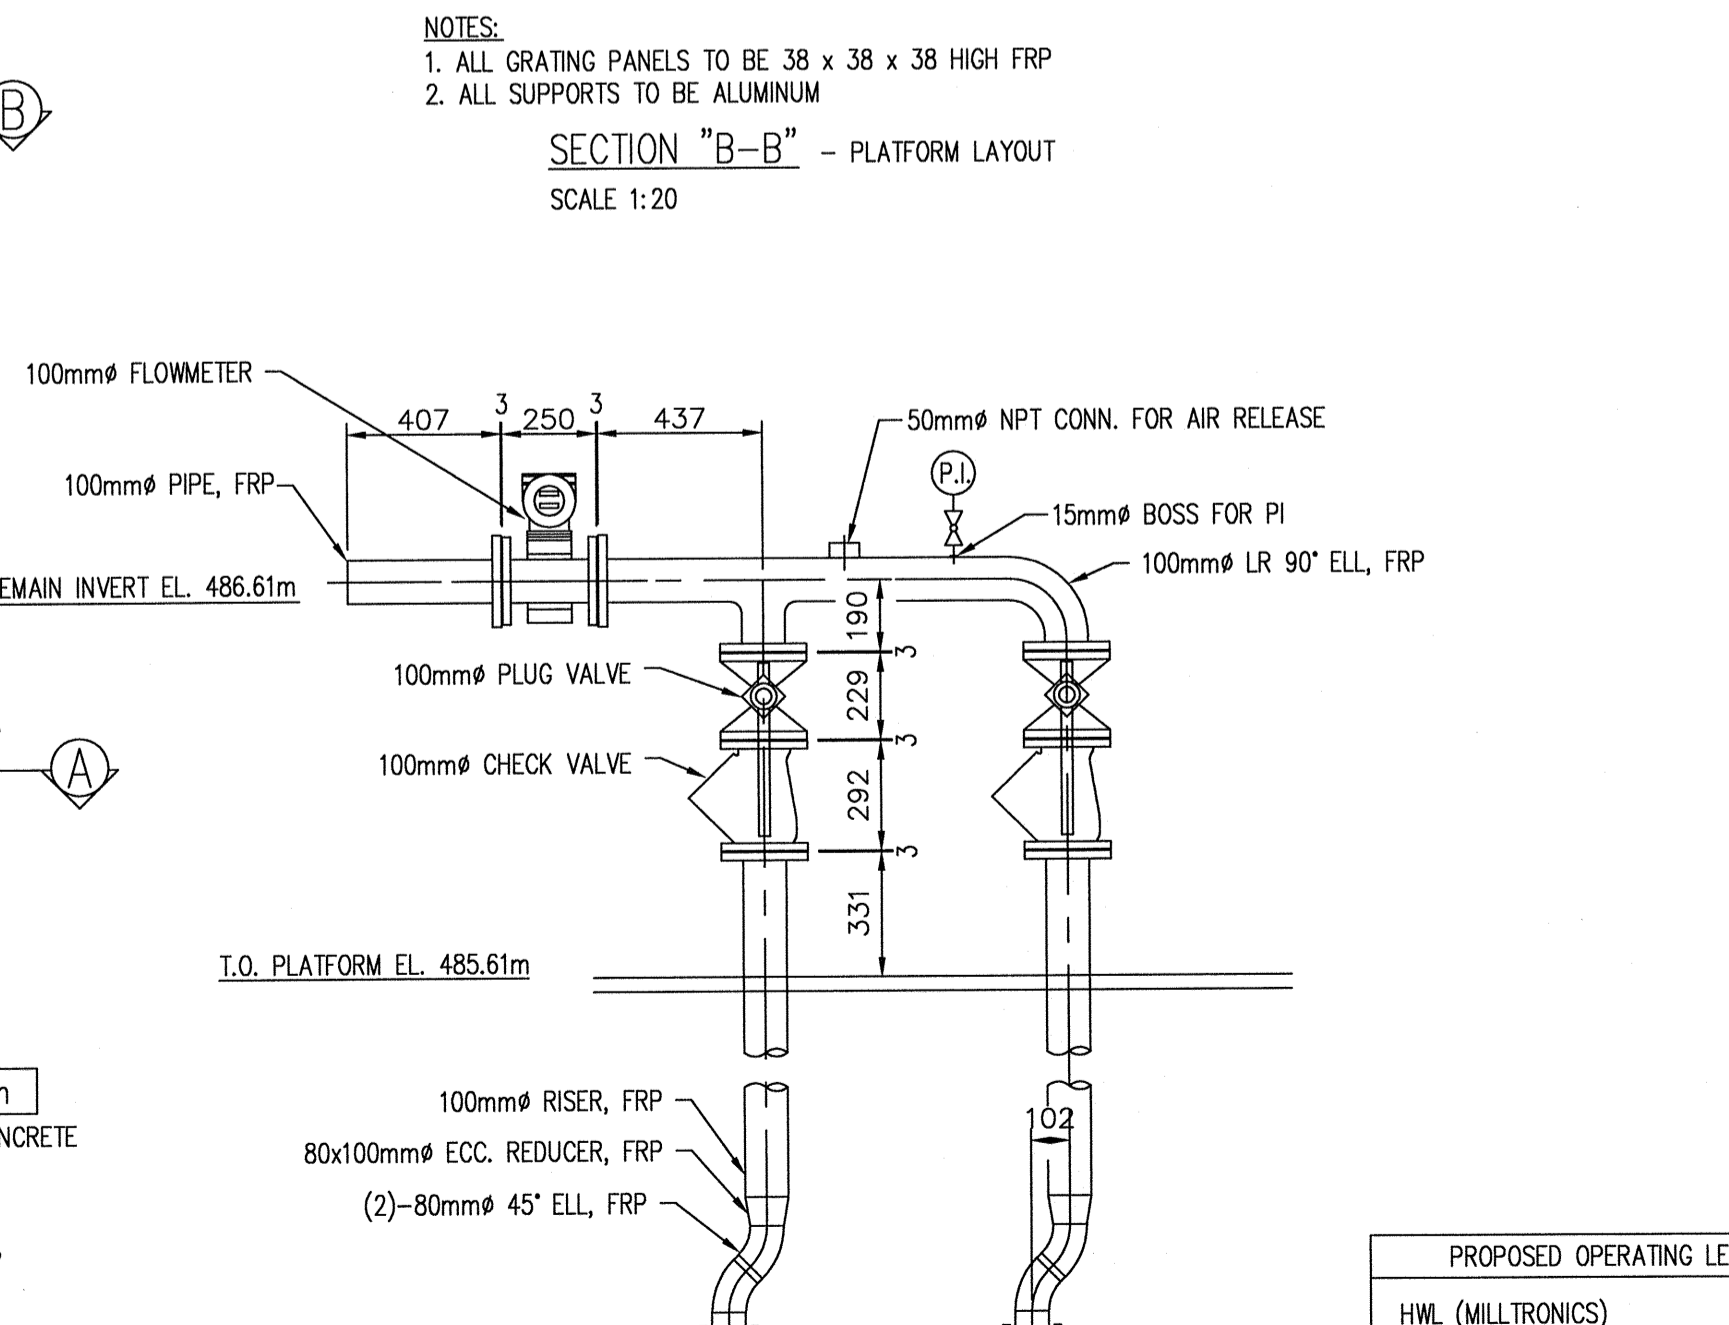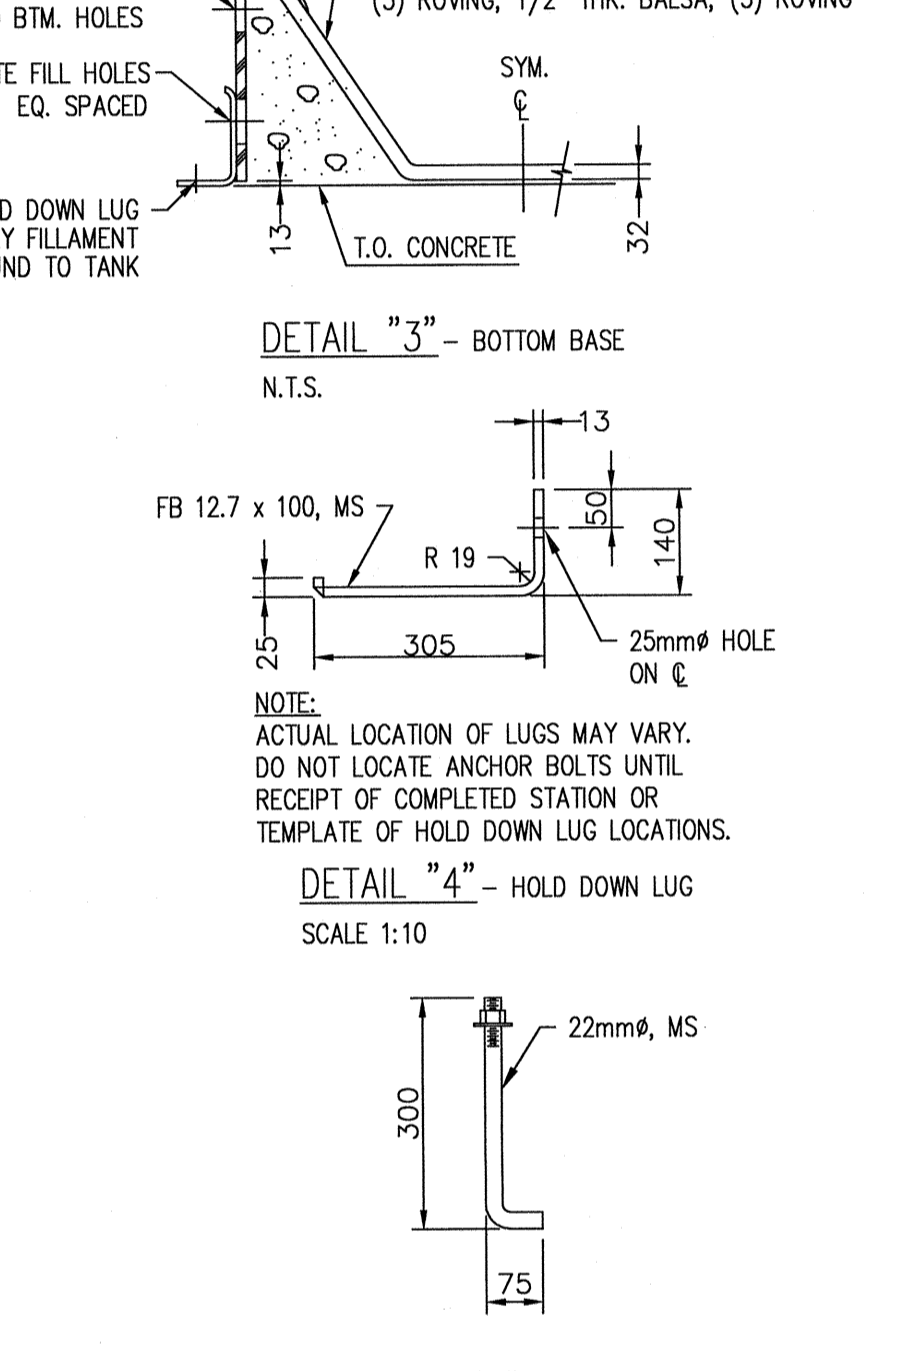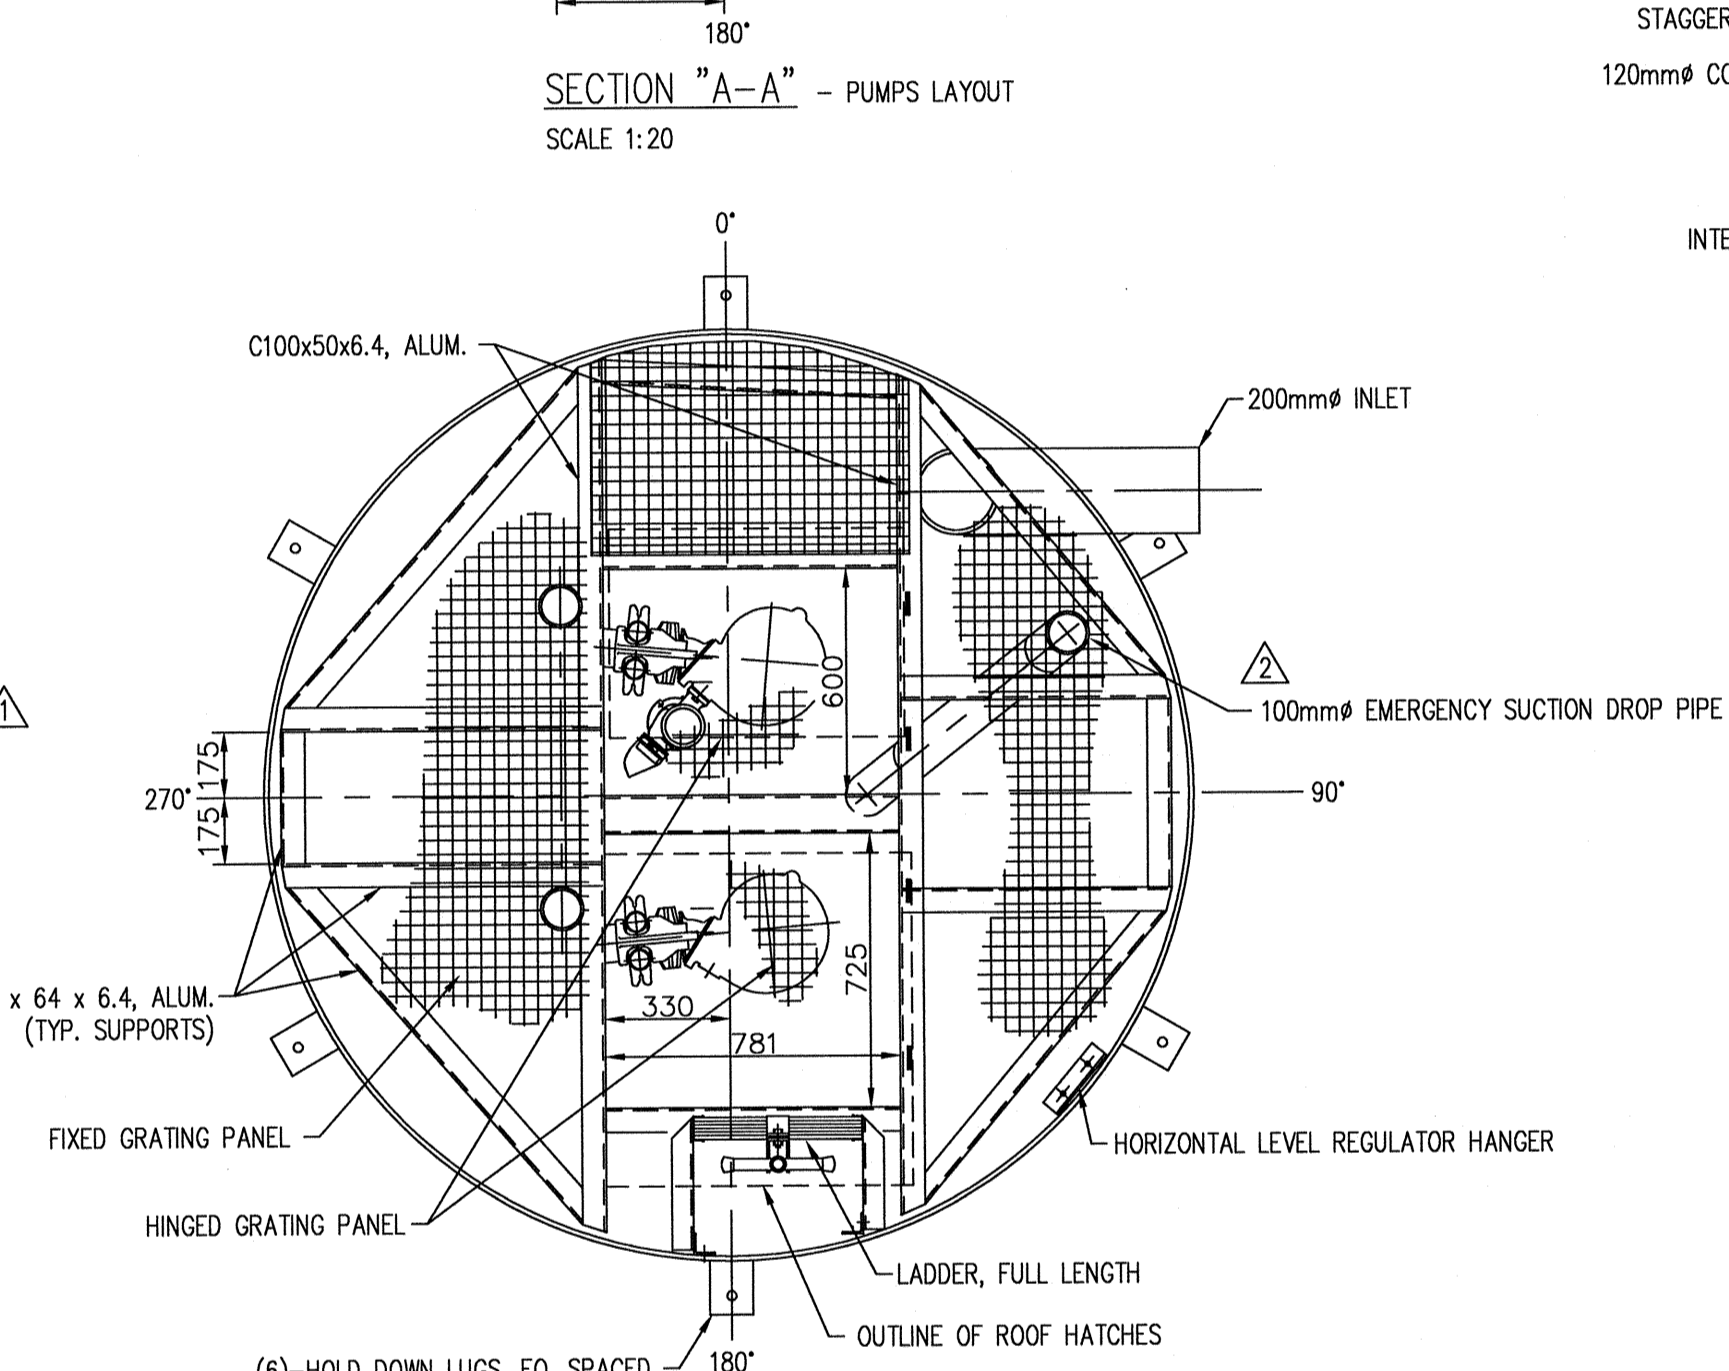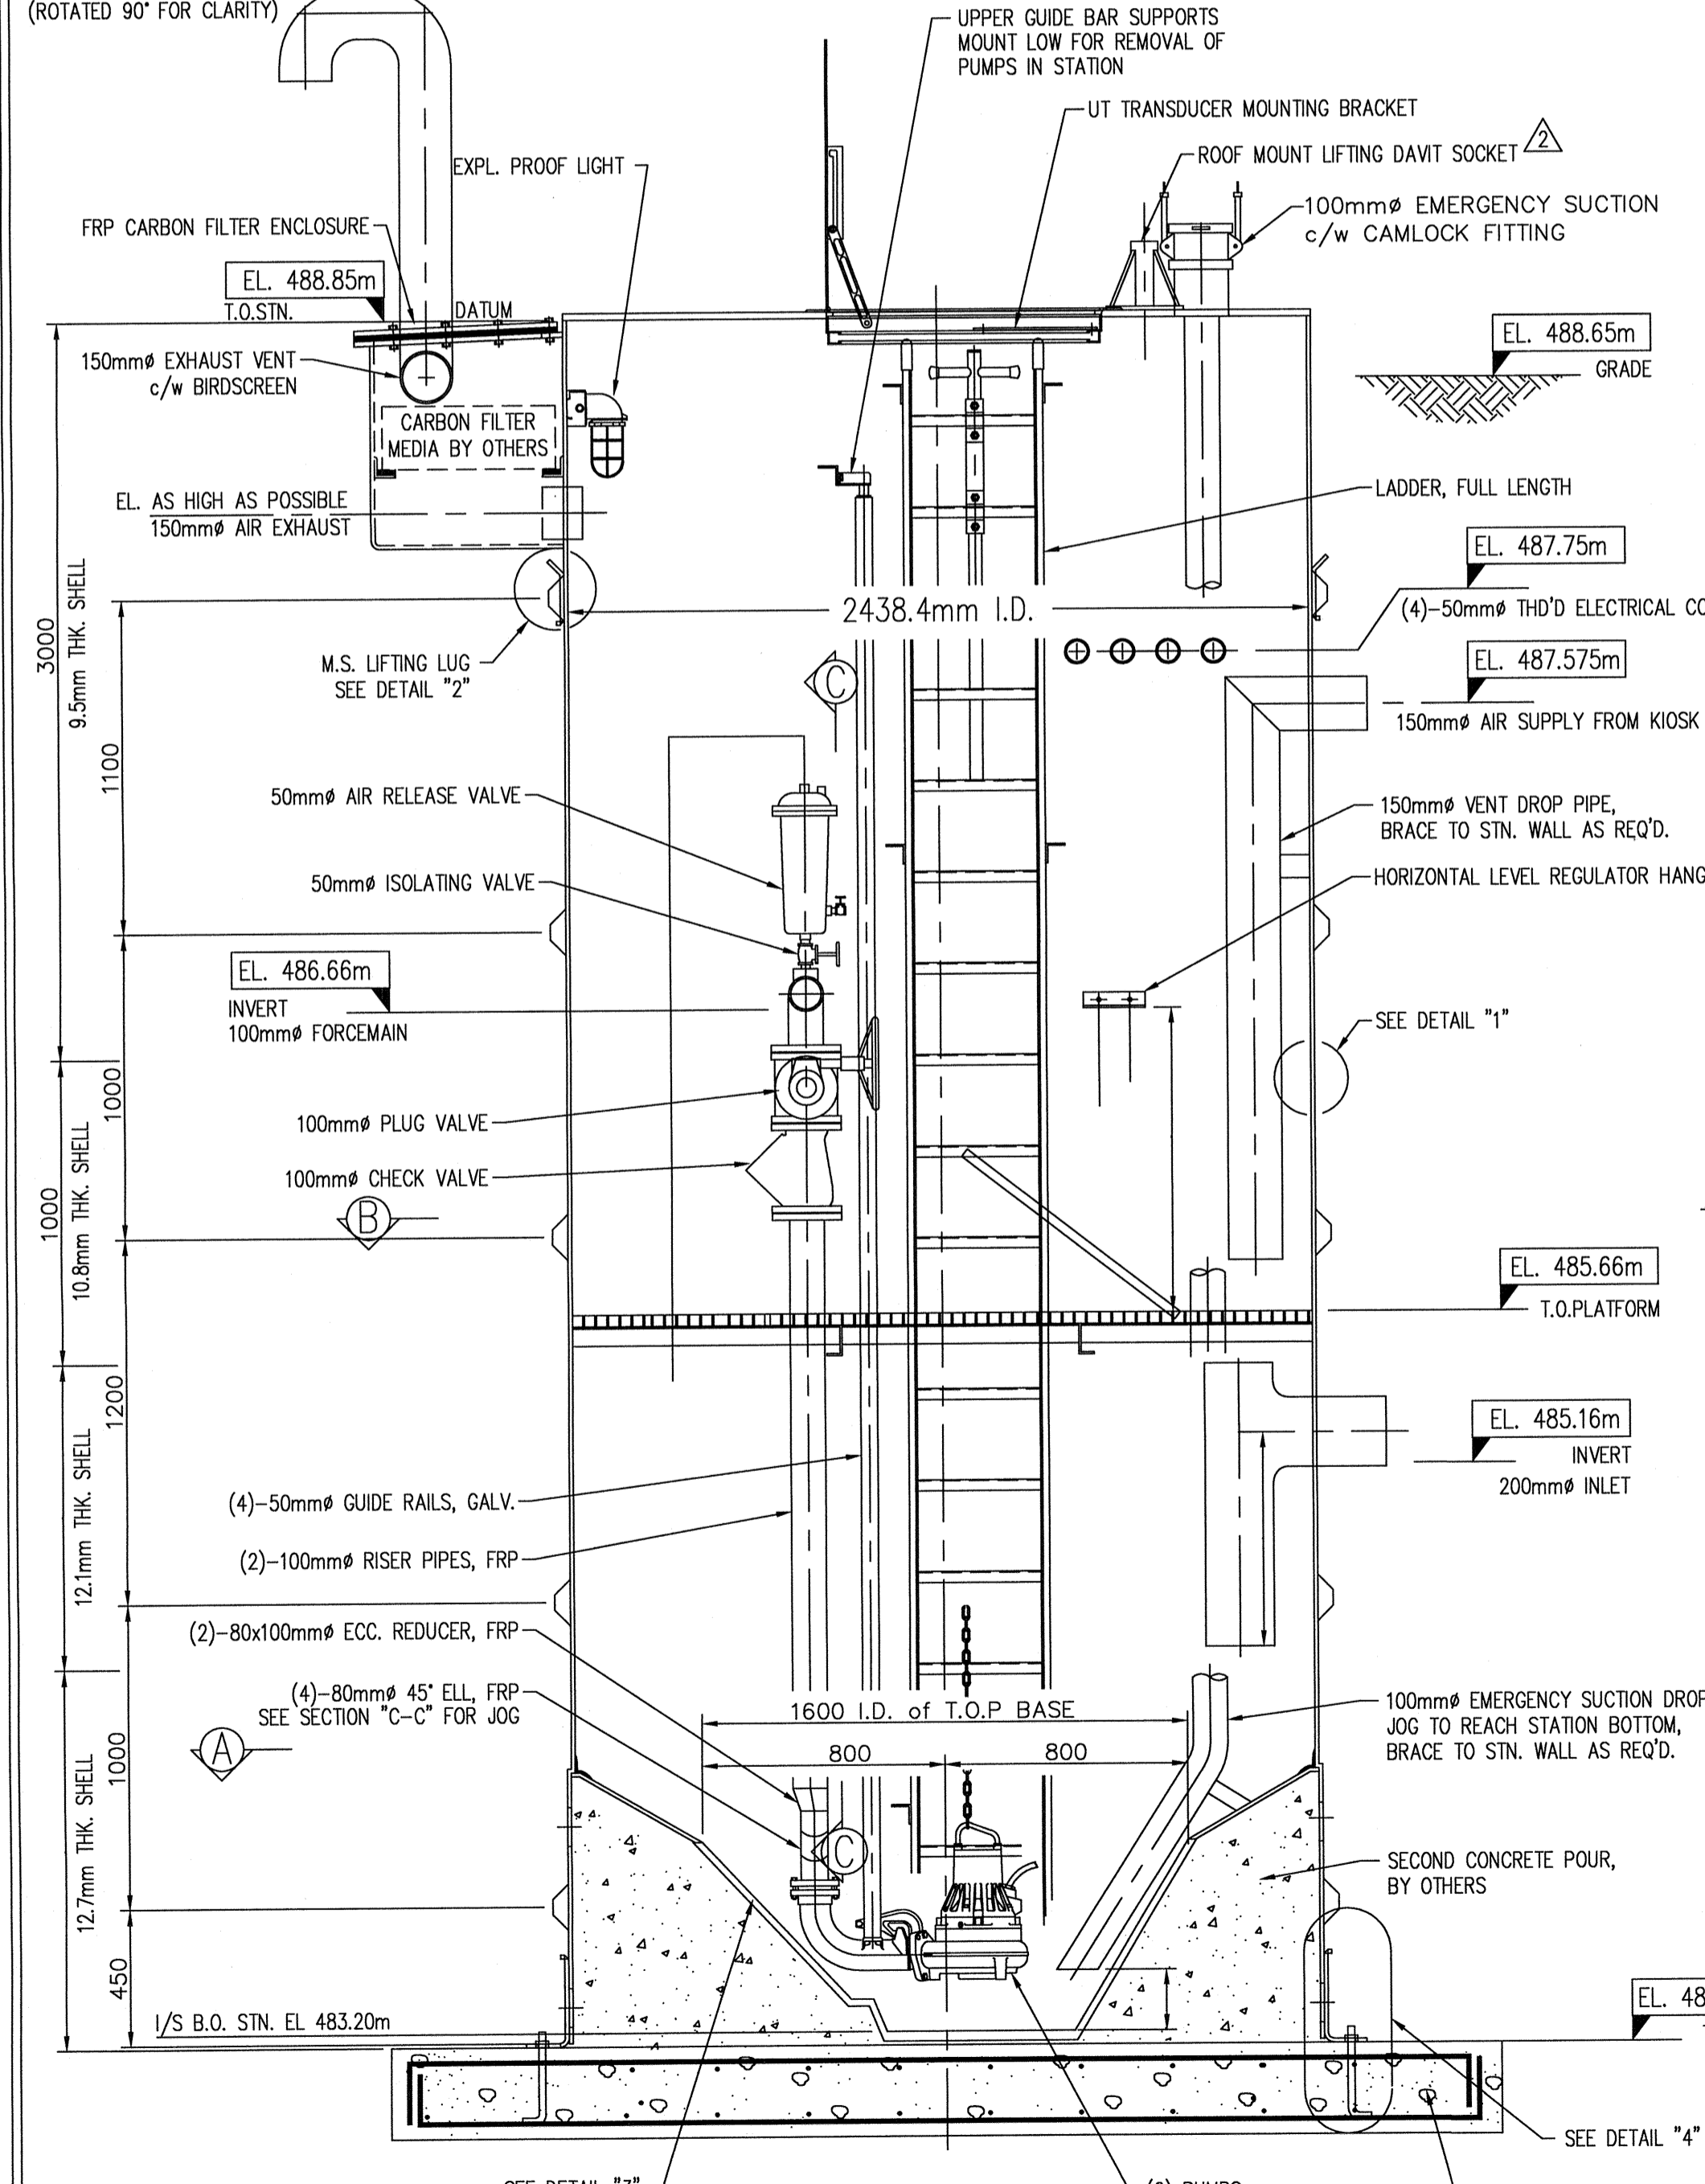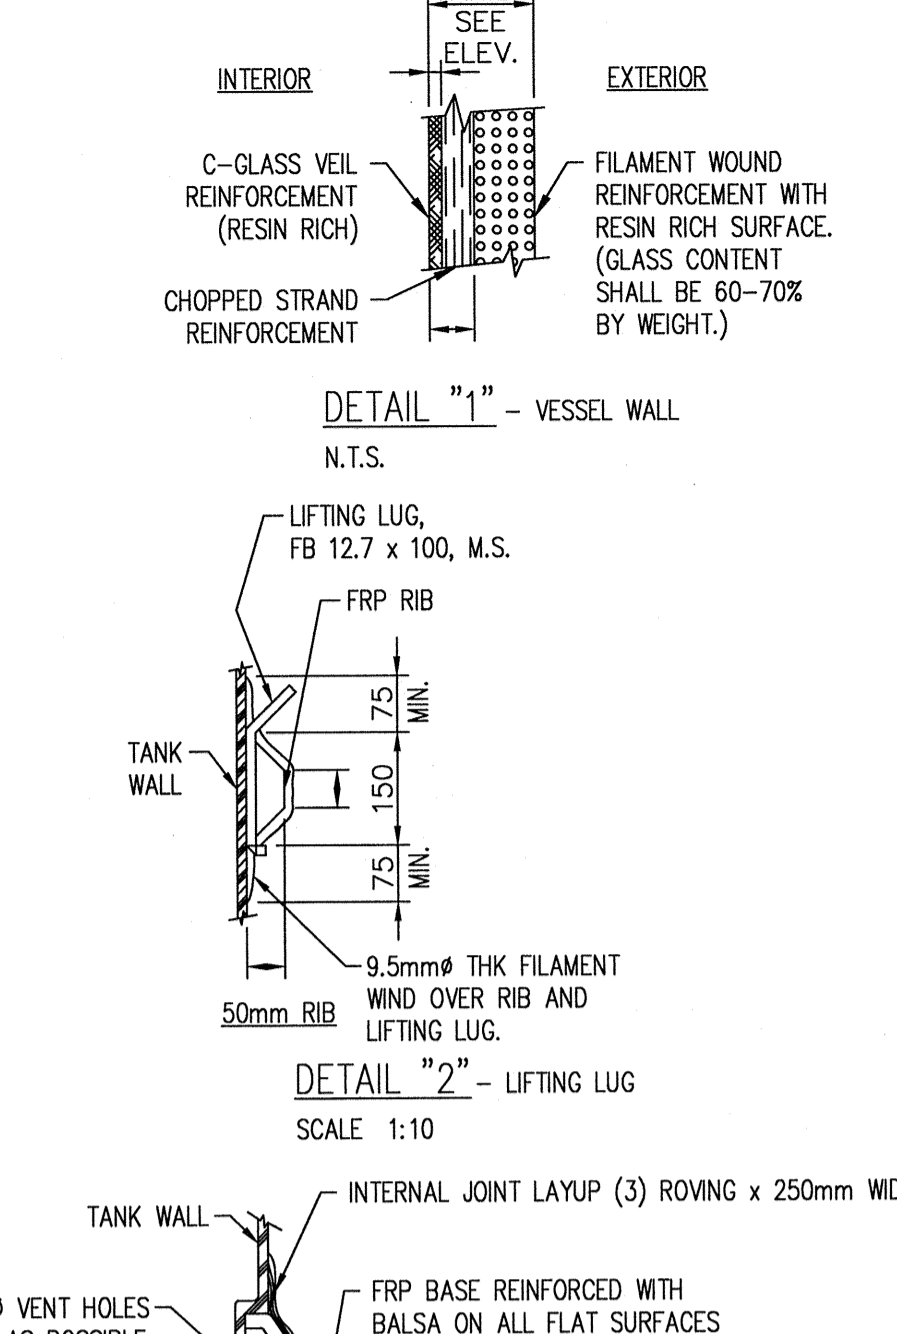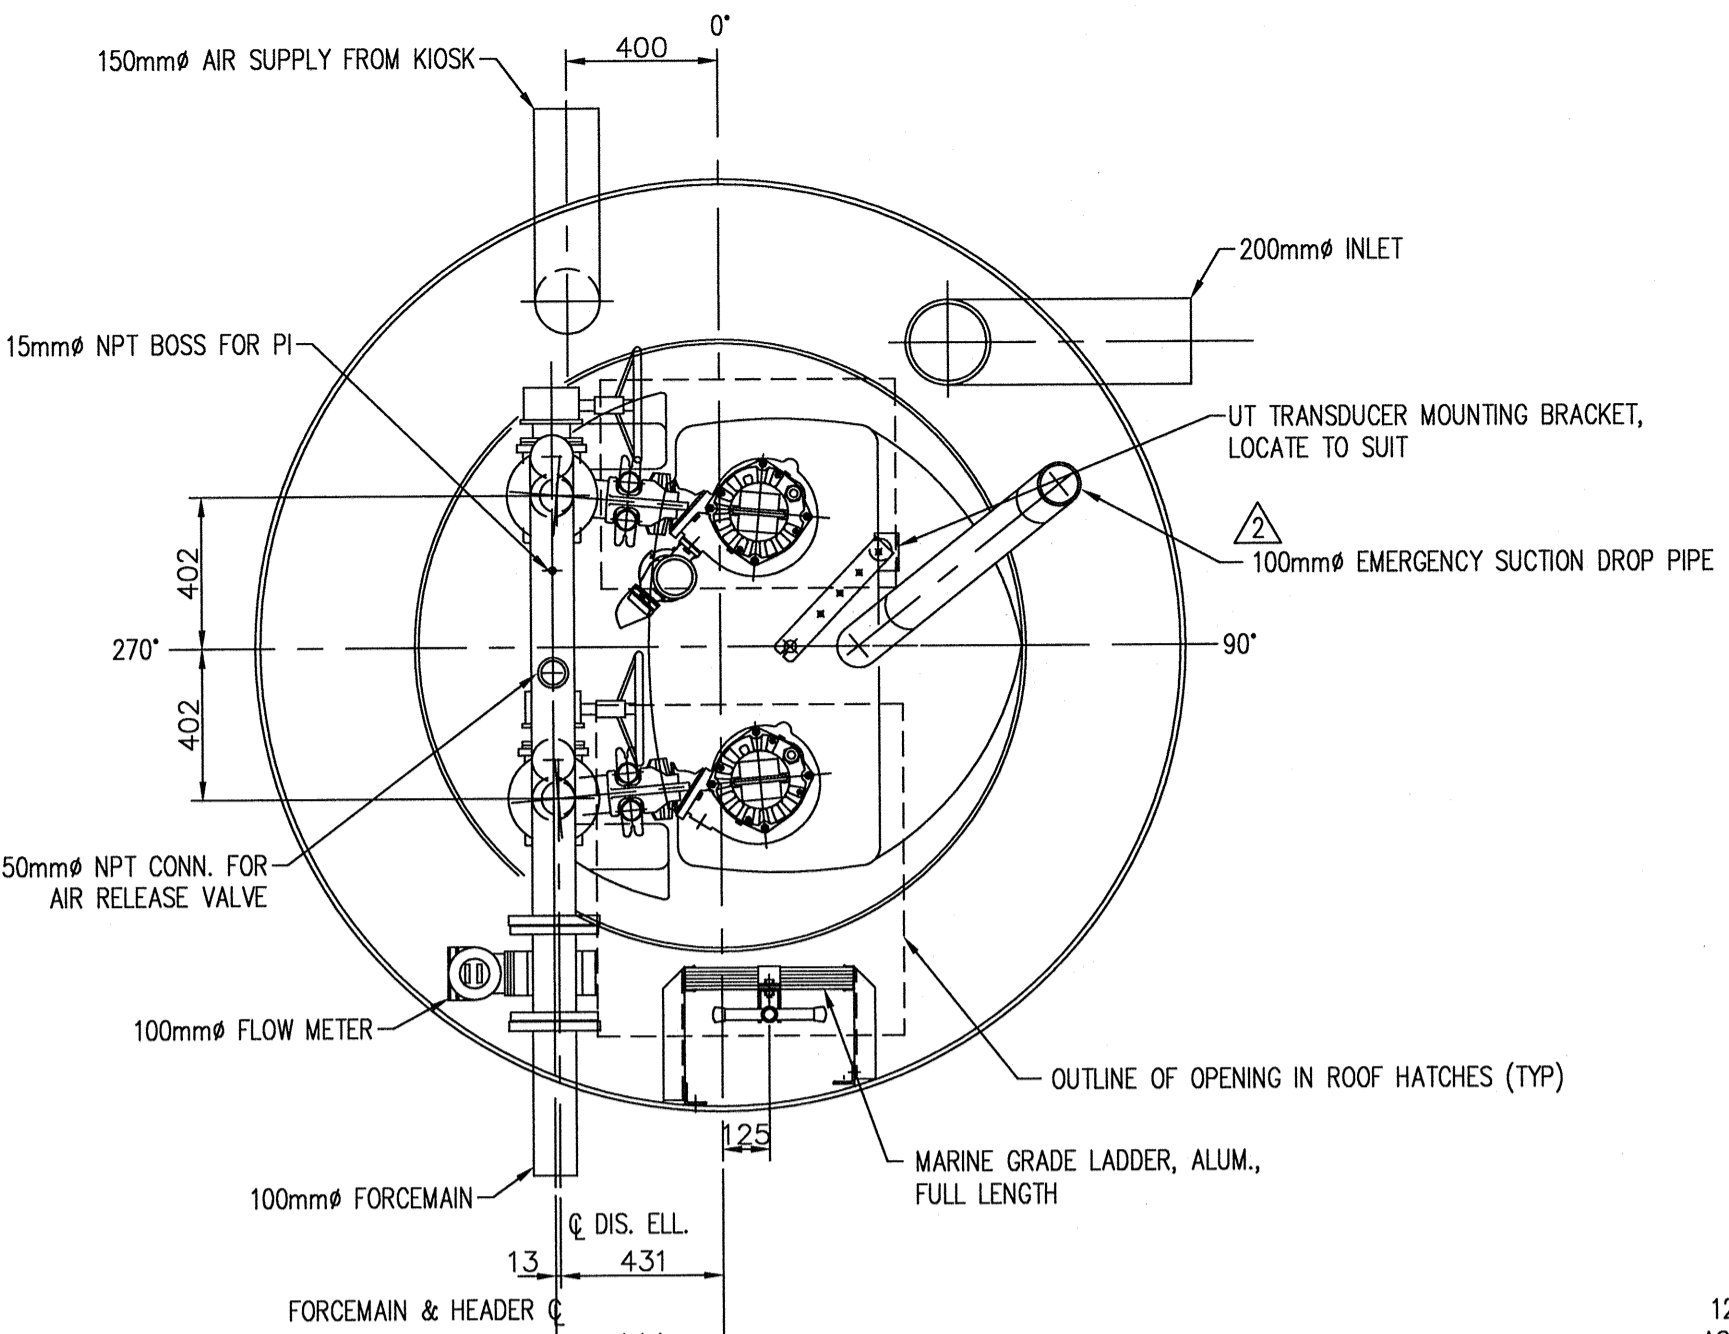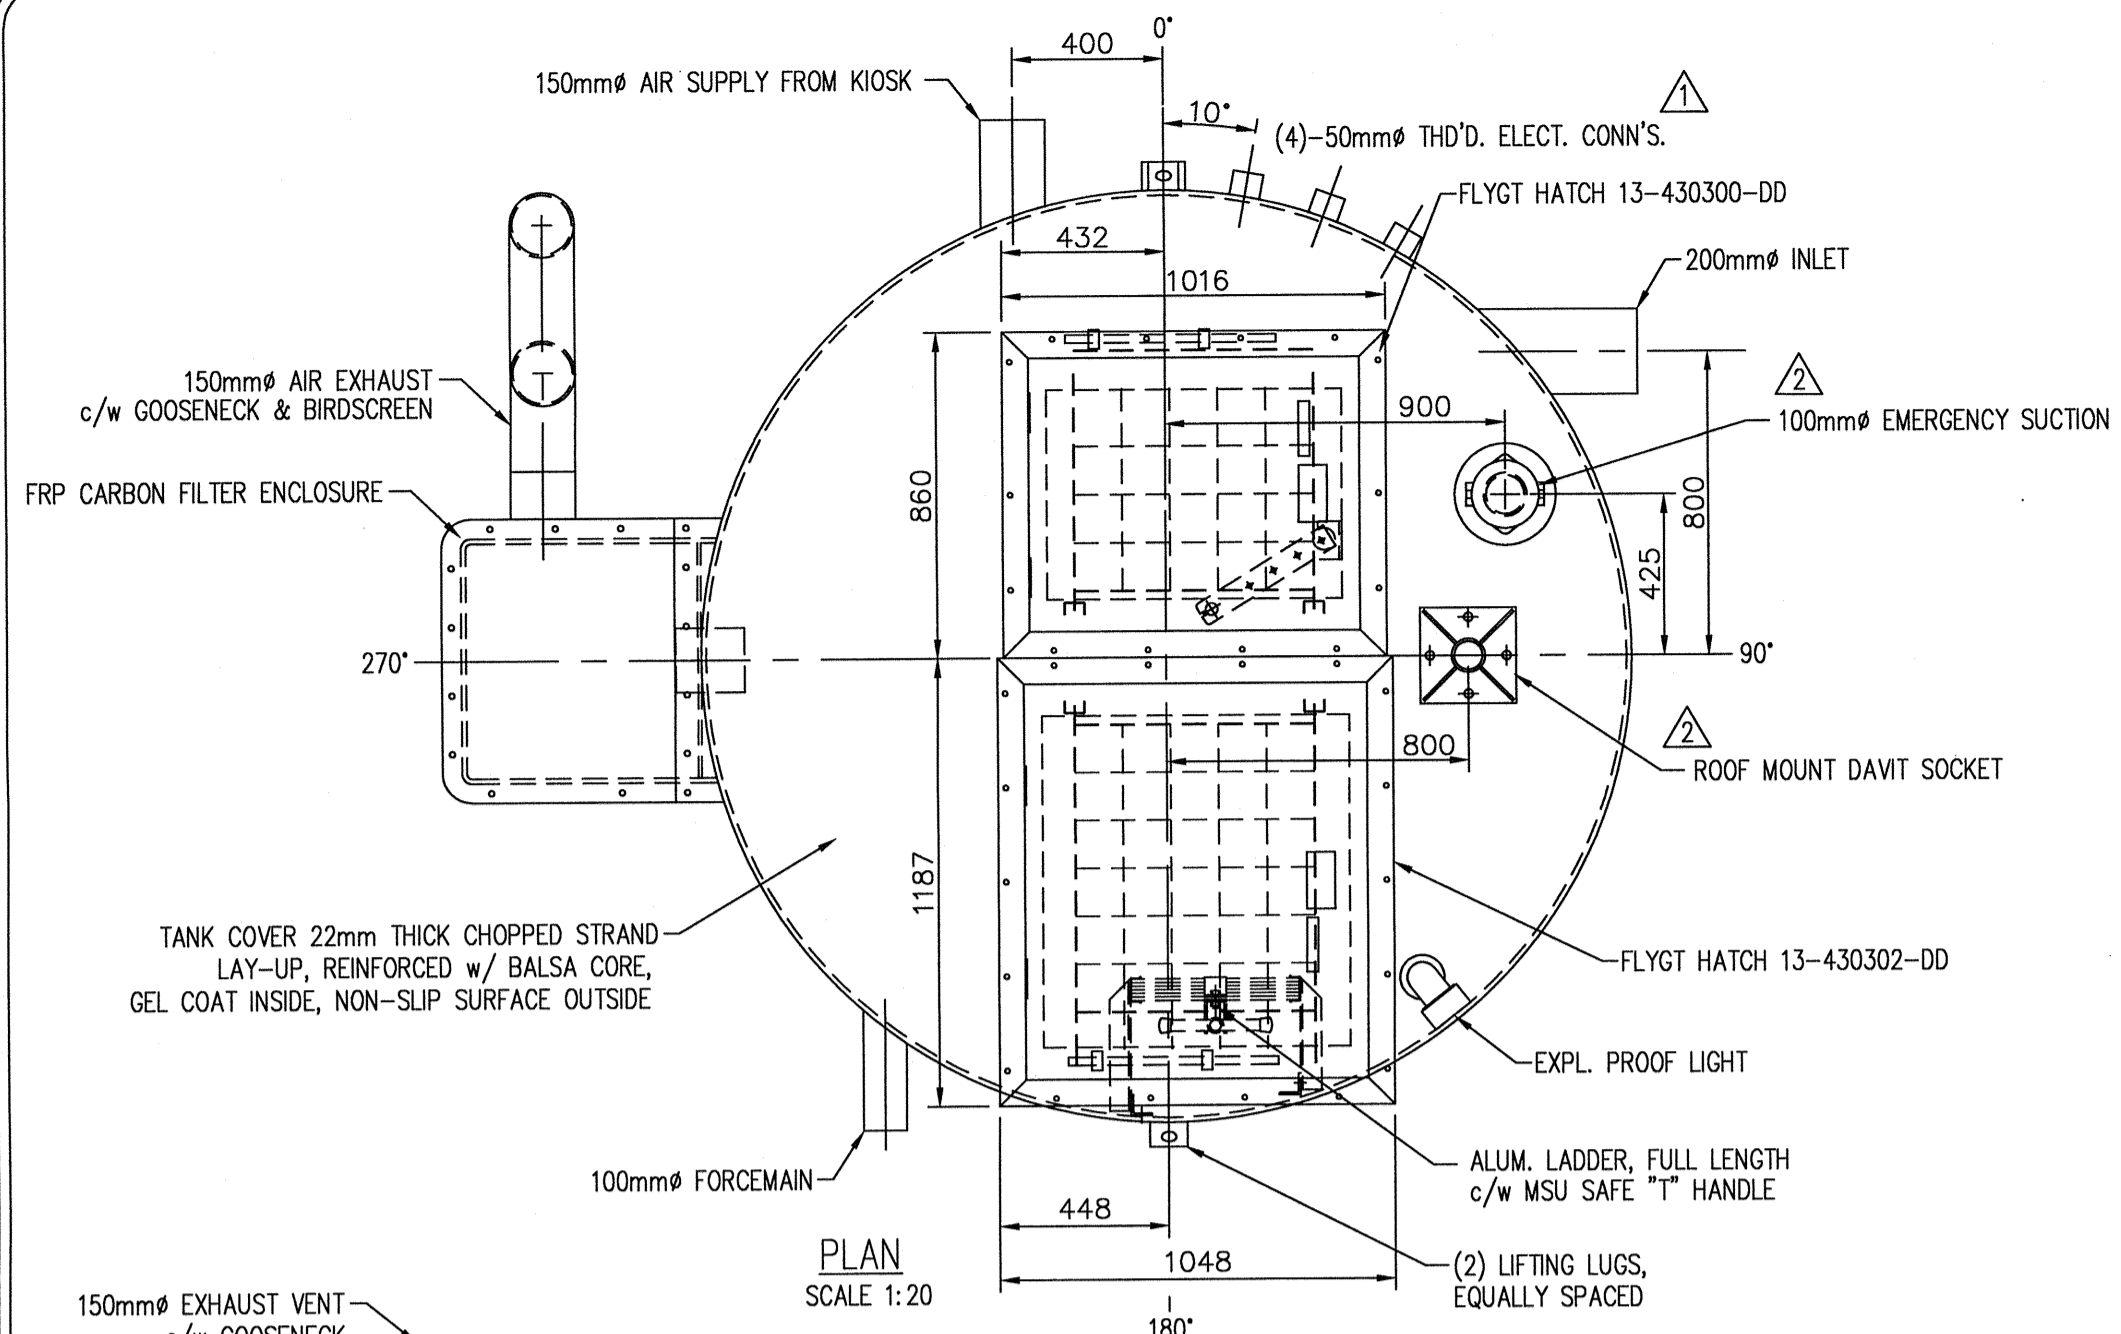

Please note that it is the user's responsibility to confirm the accuracy of the as-constructed information shown on this drawing before proceeding with any work (i.e. design or construction) that is based on that information.

NOTE: CONCRETE SHOWN FOR ILLUSTRATIVE PURPOSES ONLY. FOUNDATION TO BE DESIGNED & SUPPLIED BY OTHERS.

NOTE: ALL GRATING PANELS TO BE 38 x 38 x 38 HIGH FRP. ALL SUPPORTS TO BE ALUMINUM.

PROPOSED OPERATING LEVELS	
H/M (MILLITRONS)	485.16m
H/M (FLOAT)	485.06m
LAG PUMP START	484.96m
LEAD PUMP START	484.76m
PUMP STOP	484.00m
L/W (FLOAT)	483.70m

BILL OF MATERIALS	
QTY	DESCRIPTION
6	HOLD DOWN LUGS, EPOXY COATED MS
2	LIFTING LUGS, EPOXY COATED MS
1	MARINE GRADE SAFETY LADDER, ALUMINUM, FULL LENGTH c/w MSU SAFE "T" HANDLE
1	200mm INLET, FRP, MACHINED c/w INTERNAL TEE & DROP PIPE
1	100mm FORCEMAIN, FRP, MACHINED c/w (2)-100mm RISERS, FRP x FL; (4)-80mm 45° ELL, FRP; (2)-80x100mm ECC. REDUCER, FRP; (1)-100mm LR 90° ELL, FLXFRP; (1)-100mm STR. TEE, FRP;FRP;FL; (2)-100mm-150° FF FLANGE, FRP;
	(1)-15mm NPT BOSS FOR PI.; (1)-50mm NPT CONN. FOR AIR RELEASE
1	100mm EMERGENCY SUCTION, FRP, c/w DROP PIPE & 100mm CAMLOCK FITTING
1	150mm AIR SUPPLY, FRP, c/w DROP PIPE
1	150mm AIR EXHAUST, FRP c/w CARBON FILTER ENCLOSURE (FILTER MEDIA BY OTHERS)
4	50mm THD'D. ELECTRICAL CONNECTION
8	20mm PUMP BASE BOLTS, 304 SS
4	20mm GUIDE BARS, GALV.
1	INTERMEDIATE PLATFORM, c/w ALUMINUM SUPPORT MEMBERS & FRP GRATING PANELS
1	UT TRANSDUCER MOUNTING BRACKET, ALUM.
1	EXPLOSION PROOF LIGHT, COOPER CROUSE-HINDS HAZGUARD EXACTA MODEL IPEH, WALL MOUNT, 150W, 120V/60Hz, CLEAR GLASS GLOBE, SS GUARD
1	FLYGT ALUMINUM ACCESS HATCH, 13-430302-DD, GAS ASSIST (BY FLYGT)
1	FLYGT ALUMINUM ACCESS HATCH, 13-430300-DD, GAS ASSIST (BY FLYGT)
2	UPPER GUIDE BAR SUPPORTS (BY FLYGT)
2	PUMP NP 3085 MT DN80 c/w DISCHARGE ELBOW FOR T.O.P. BASE (BY FLYGT)
2	100mm FLG'D. SINKING BALL CHECK VALVE, HDL 5087 (BY FLYGT)
2	100mm FLG'D PLUG VALVE, VALMATIC CAMCENTRIC, 5808N (BY FLYGT)
1	HORIZONTAL LEVEL REGULATOR HANGER & (2) ENM BULBS (BY FLYGT)
1	AIR RELEASE VALVE c/w ISO VALVE (BY FLYGT)
1	100mm FLG'D MAGFLOW METER, SIEMENS SITRANS FM3 5100W OR EQUAL (BY FLYGT)
1	PRESSURE GAUGE & STOP COCK (BY FLYGT)
1	ROOF MOUNT LIFTING DAWT SOCKET (810mm REACH) (BY FLYGT)
6	22mm ANCHOR BOLTS, MS (BY OTHERS)

FABRICATION DESIGN STANDARDS

- FLYGT SPECIFICATION GE-1008-04, REVISION MAY 2002
- AMEC 45-10.01 MANUFACTURE AND INSTALLATION FOR FRP STRUCTURES
- AMEC 45-10.02 FRP PRESSURE PIPE, FITTINGS AND FLANGES

GENERAL NOTES

- WINDING ANGLE - 75°
- TANK WALL - VARIES, SEE ELEVATION VIEW
- LINER - C-GLASS VEIL AND (2)-1 1/2 oz. MATT
- RESIN - ISOPHTHALIC
- EXTERIOR (ABOVE GRADE) TO HAVE DARK GREEN GELCOAT
- INTERIOR FINISH: WHITE ISOPHTHALIC NPG GELCOAT
- DIMENSIONS ARE IN MILLIMETERS U.N.O.
- SHIPPING WEIGHT: 2910 kg (6400 LBS)

INSTALLATION PROCEDURES

THE FOLLOWING RECOMMENDATIONS ARE BASED ON FLYGT EXPERIENCE AND ARE IN NO WAY MEANT TO REPLACE THE ENGINEER'S INSTRUCTIONS OR SPECIFICATIONS AND MUST BE USED IN CONJUNCTION WITH THE EXISTING AND ANTICIPATED CONDITIONS AT THE JOBSITE.

- USE THE LIFTING LUGS PROVIDED FOR VERTICAL HANDLING.
- USE SLINGS AROUND THE MAIN TANK FOR HORIZONTAL HANDLING.
- ENSURE UNIT IS STANDING VERTICAL ON CONCRETE PAD.
- BOLT UNIT FIRMLY AND SQUARELY IN PLACE, SHIM WHERE NECESSARY.
- FILL ANNULUS BETWEEN THE TANK SHELL AND OUTSIDE OF THE "T.O.P." SUMP WITH CONCRETE. AT THE SAME TIME ENCASE LOWER RIB IN CONCRETE TO A MINIMUM HEIGHT OF 150mm ABOVE RIB TO PROVIDE ANCHORAGE. REBAR TO CONNECT SECOND POUR TO CONCRETE BASE PAD.
- WHEN EXTERNAL VALVES ARE MOUNTED, SUPPORT PIPING CONNECTIONS DIRECT TO CONCRETE PAD.
- MAINTAIN A DRY SITE UNTIL BACKFILLING OPERATIONS COMMENCE.
- USE A GOOD QUALITY SCREENING OR SAND AS BACKFILL MATERIAL TO 90% COMPACTION.
- PLACE THE BACKFILL IN EQUAL INCREMENTS NOT EXCEEDING 300mm THICK AROUND THE STATION TO PREVENT UNBALANCED LOADS BEING IMPOSED DURING BACKFILLING OPERATIONS. PROGRESSIVELY TAMP BACKFILL AROUND STATION TO FULL HEIGHT TO REDUCE SETTLEMENT TO AN ABSOLUTE MINIMUM.

REV	DATE	DESCRIPTION	BY
3	2012/04/03	PLAN OF RECORD	
2	2011/07/29	CHANGED DAWT SOCKET; MOVED EMERGENCY SUCTION ON ROOF	LMc
1	2011/07/15	ADDED (1) ELECTRICAL CONNECTION	LMc
0	2011/06/21	ISSUED FOR APPROVAL	LMc

TOLERANCES (U.N.O.)	
LINEAR	ANGULAR
x ± 1.5	x x ± 1/2°

B BARKSI INDUSTRIES (1985) LTD. 2378 WESTLAKE RD. KELOWNA, B.C. V2Z 2V2

NOTICE: THIS DRAWING HAS NOT BEEN PUBLISHED AND IS THE SOLE PROPERTY OF BARKSI INDUSTRIES (1985) LTD. AND IS LOANED TO THE BORROWER FOR HIS CONFIDENTIAL USE ONLY, AND IN CONSIDERATION OF THE LOAN OF THIS DRAWING, THE BORROWER PROMISES AND AGREES TO RETURN IT UPON REQUEST AND AGREES THAT IT SHALL NOT BE REPRODUCED, COPIED, LENT OR OTHERWISE DISPOSED OF DIRECTLY OR INDIRECTLY, NOR USED FOR ANY PURPOSE OTHER THAN THAT FOR WHICH IT WAS FURNISHED.


CLIENT: ITT WAWW COQUITLAM, B.C. ENGINEER: STANTEC CONSULTING LTD.

PROJECT: GLENROSA SEWER - PHASE 3 INVERNESS ROAD SANITARY LIFT STATION


TITLE: 2438.4mm I.D. INVERNESS ROAD LIFT STATION

ENG BY:	DATE:	CAD FILE:	PROJECT:
LMc	2011/06/20	Inverness	
APP BY:	DATE:	SCALE:	AS SHOWN
		DRAWING NUMBER:	11-122
ISSUED BY:	DATE:		

PROPOSED OPERATING LEVELS	
H.W.L. (MILLITRONICS)	477.31m
H.W.L. (FLOAT)	477.21m
LAG PUMP START	477.11m
LEAD PUMP START	476.91m
PUMP STOP	476.72m
L.W.L. (FLOAT)	476.42m


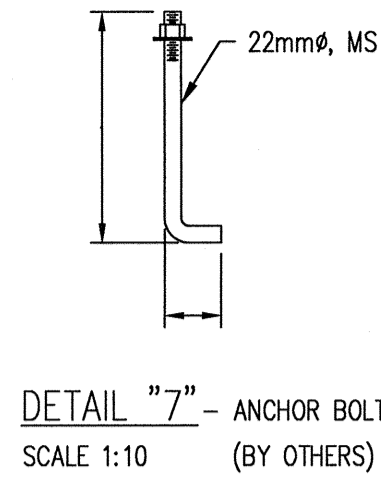


"Please note that it is the user's responsibility to confirm the accuracy of the as-constructed information shown on this drawing before proceeding with any work (i.e. design or construction) that is based on that information."

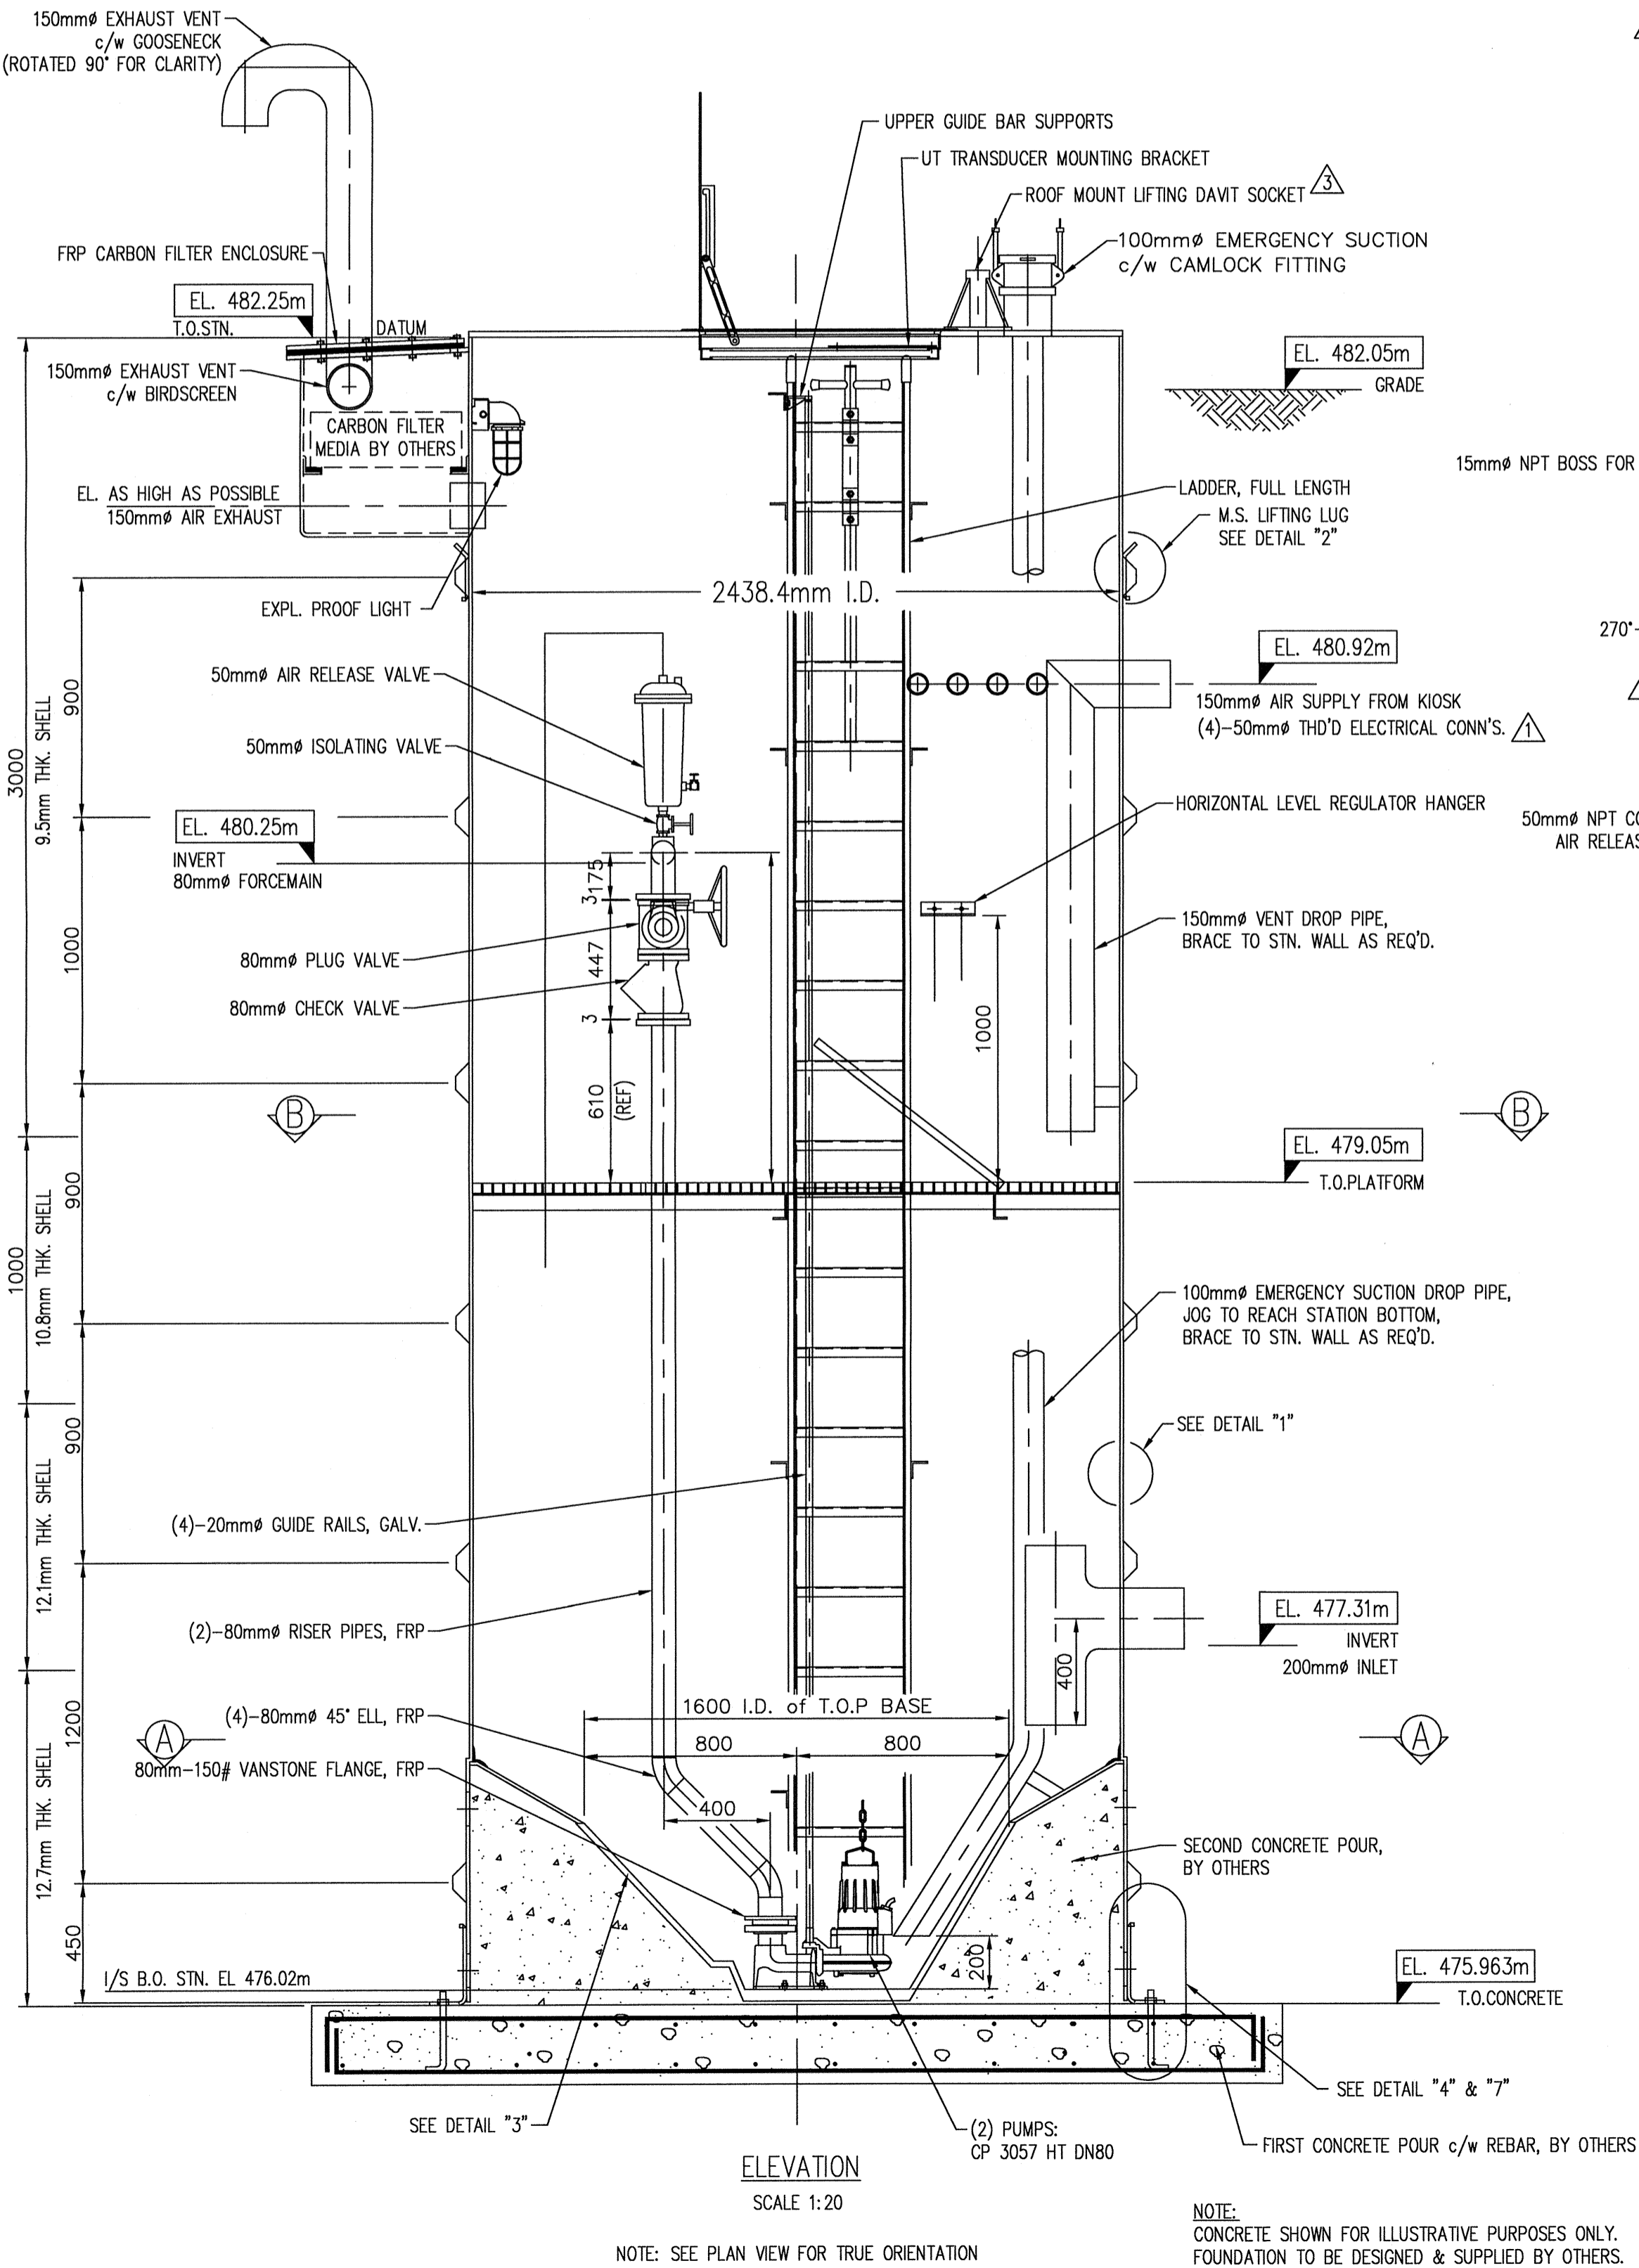


NOTE: SEE PLAN VIEW FOR TRUE ORIENTATION



NOTE: CONCRETE SHOWN FOR ILLUSTRATIVE PURPOSES ONLY. FOUNDATION TO BE DESIGNED & SUPPLIED BY OTHERS.

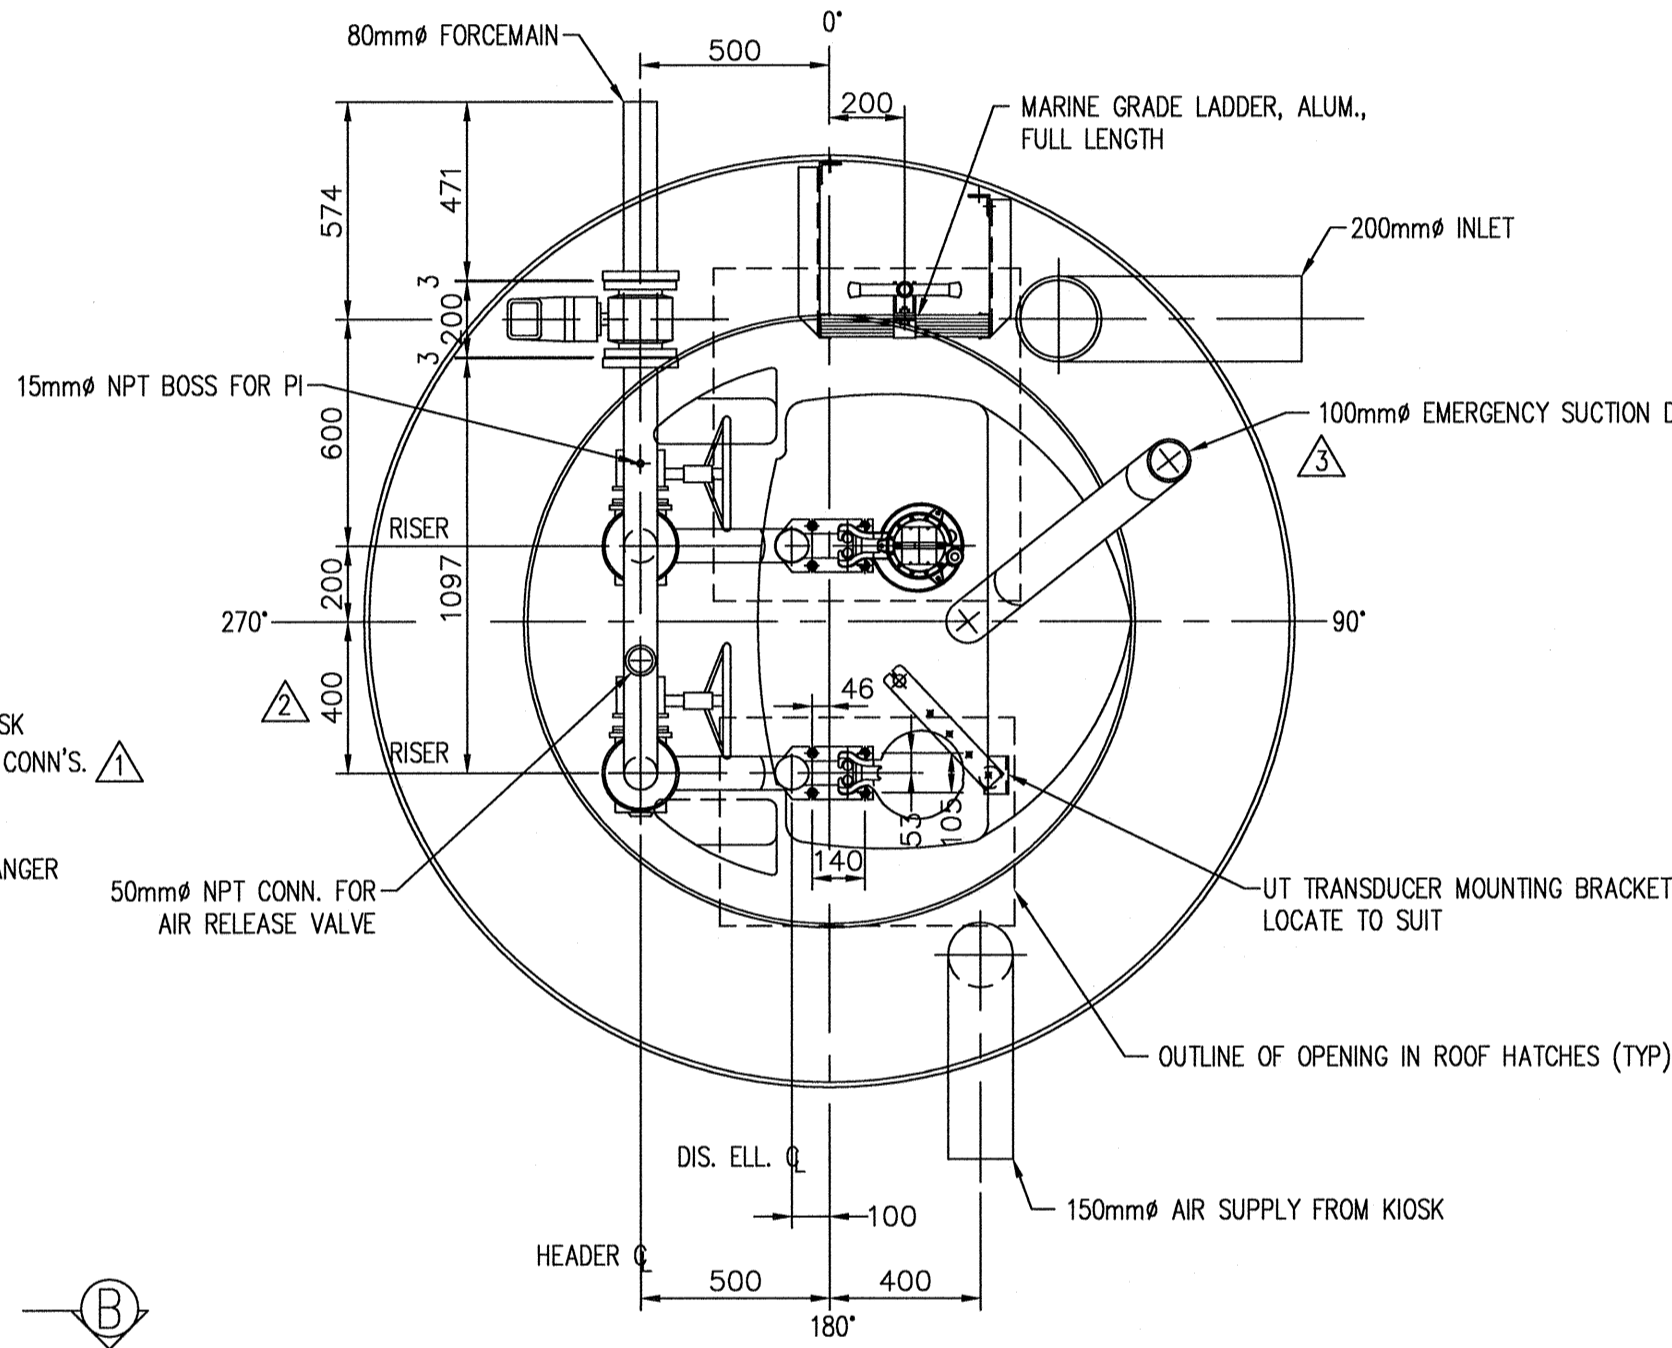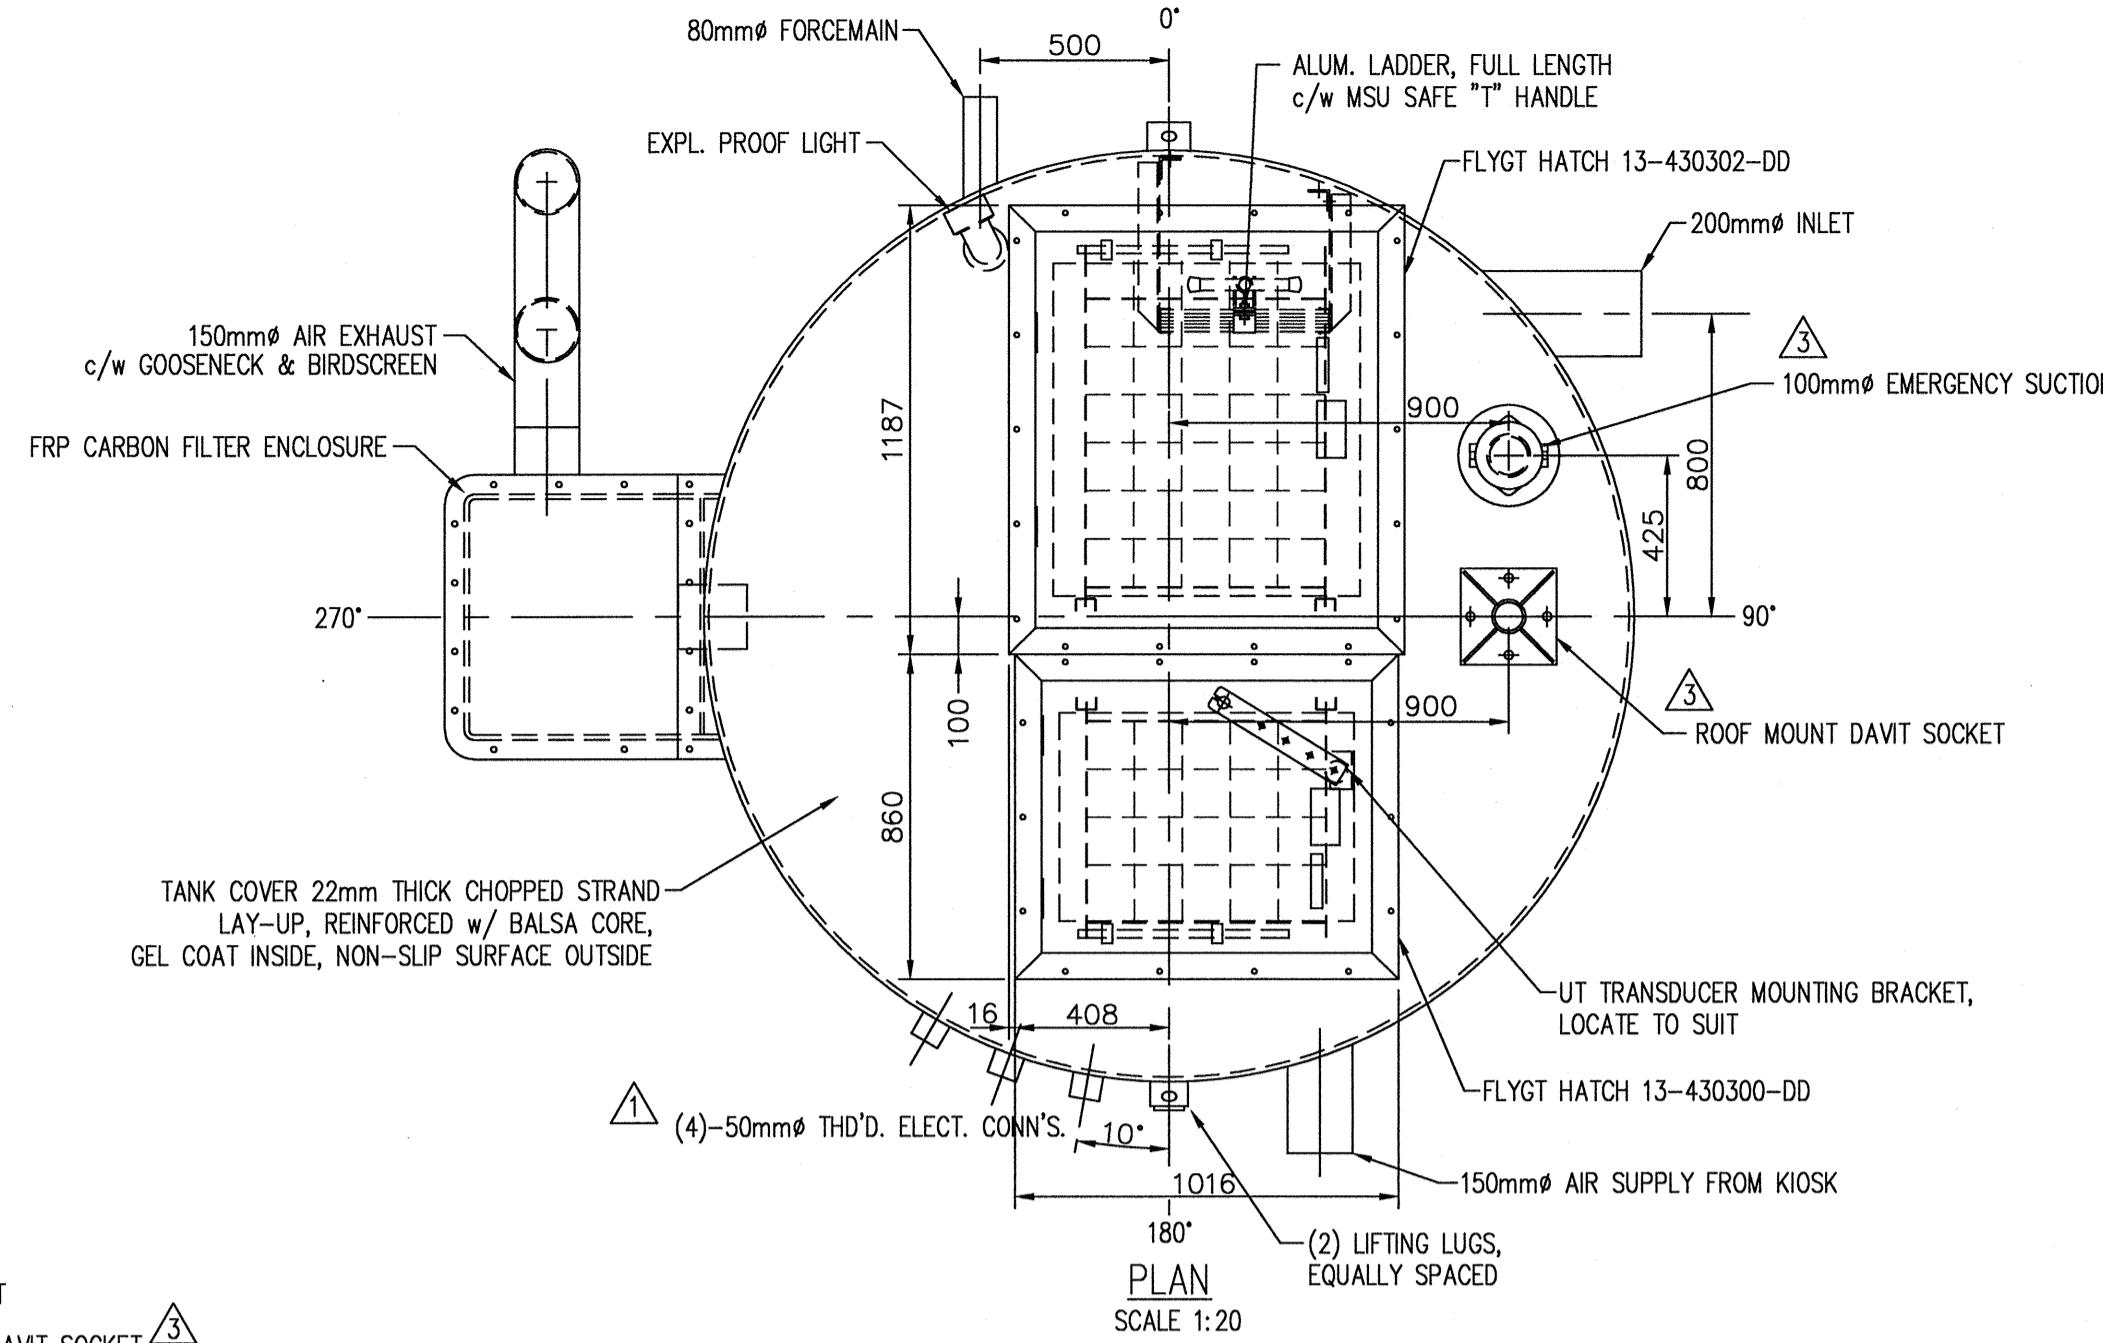


SECTION "A-A" - PUMPS LAYOUT
SCALE 1:20

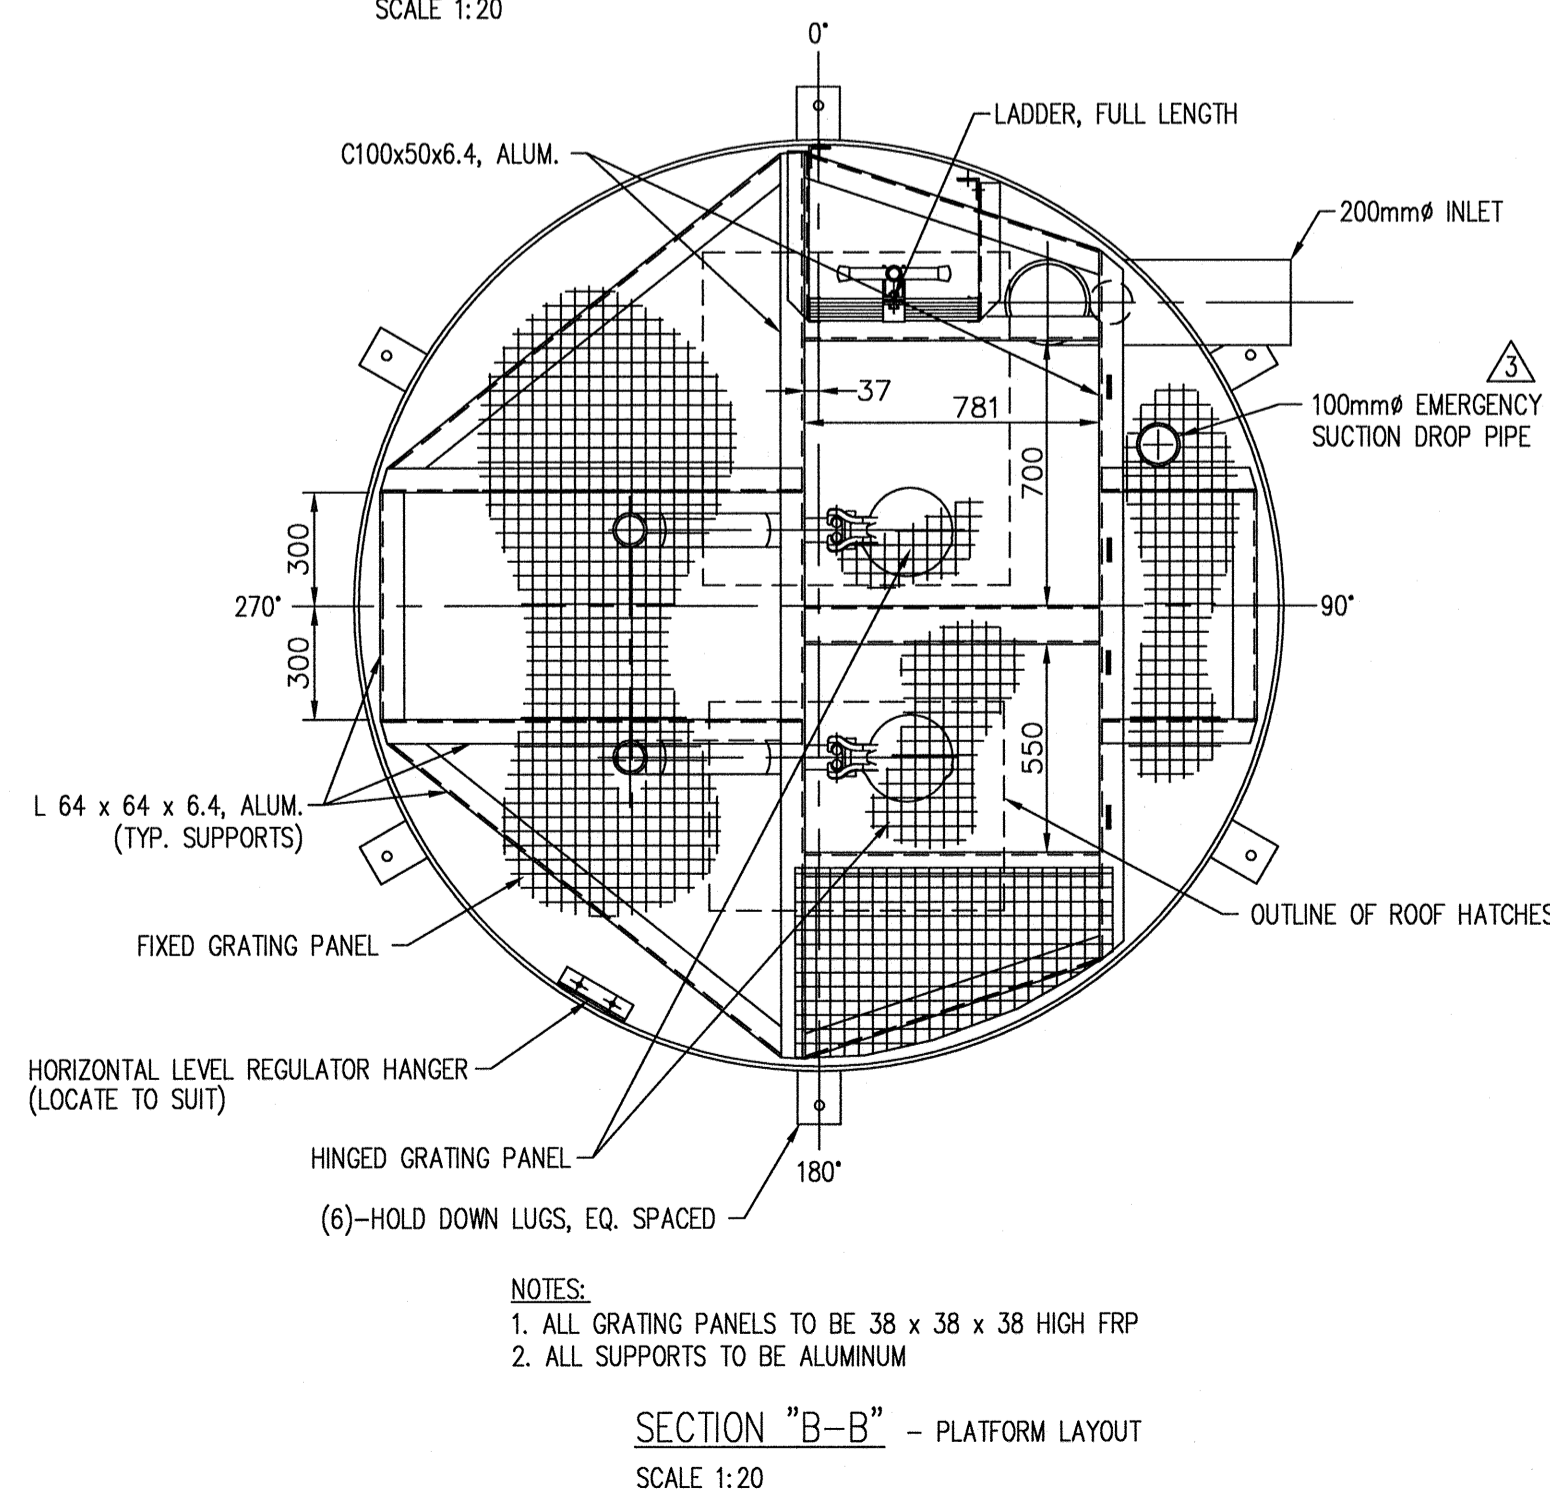


SECTION "B-B" - PLATFORM LAYOUT
SCALE 1:20

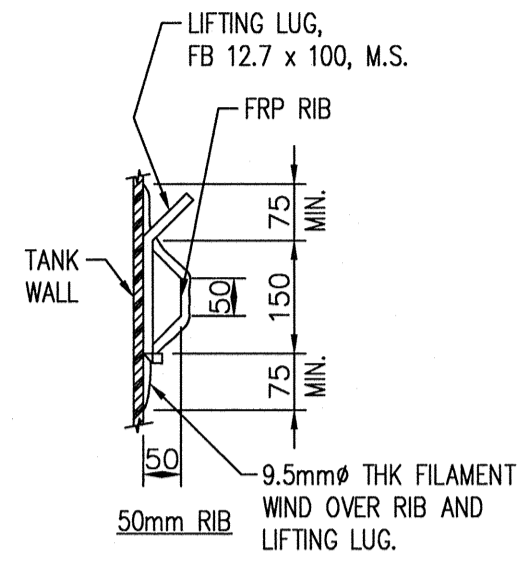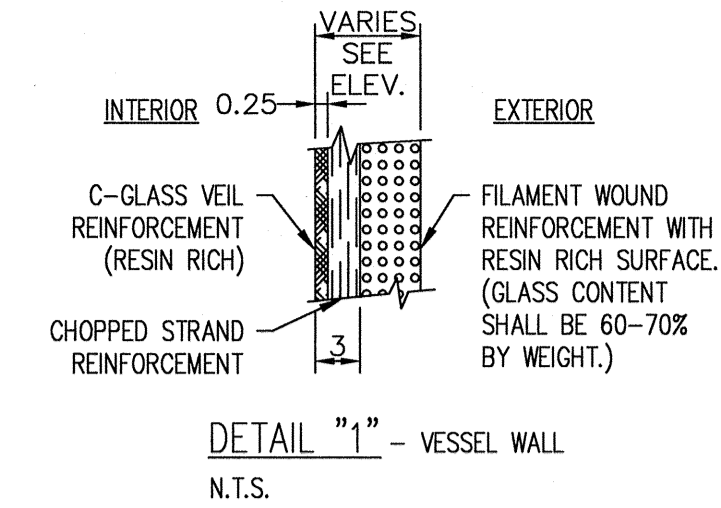


DETAIL "2" - LIFTING LUG
SCALE 1:10

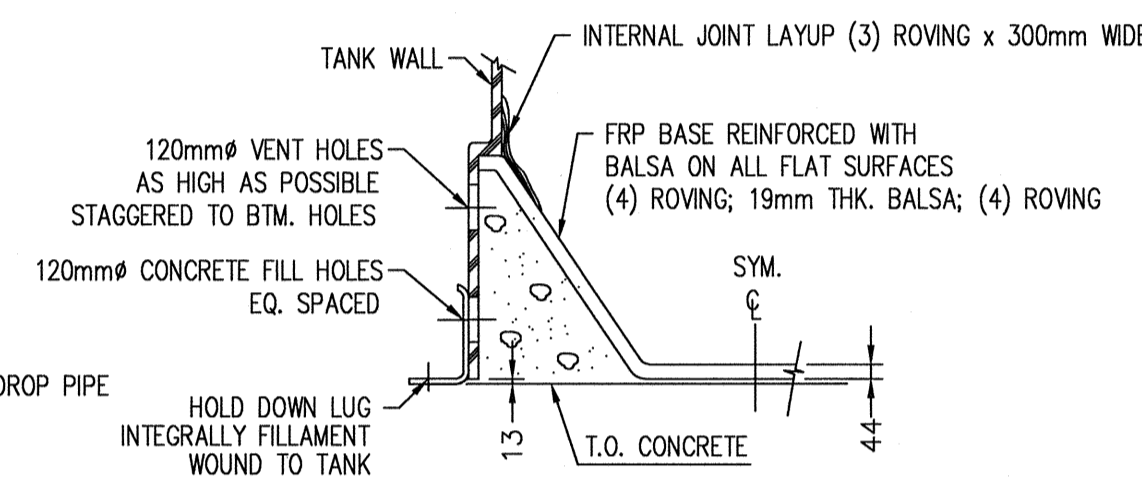

DETAIL "3" - BOTTOM BASE
N.T.S.

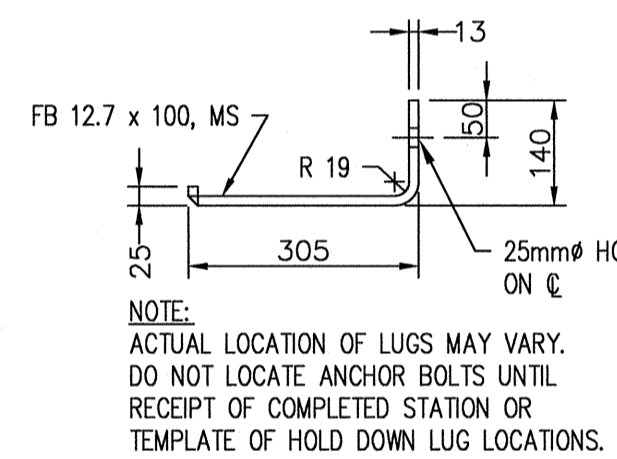

DETAIL "4" - HOLD DOWN LUG
SCALE 1:10

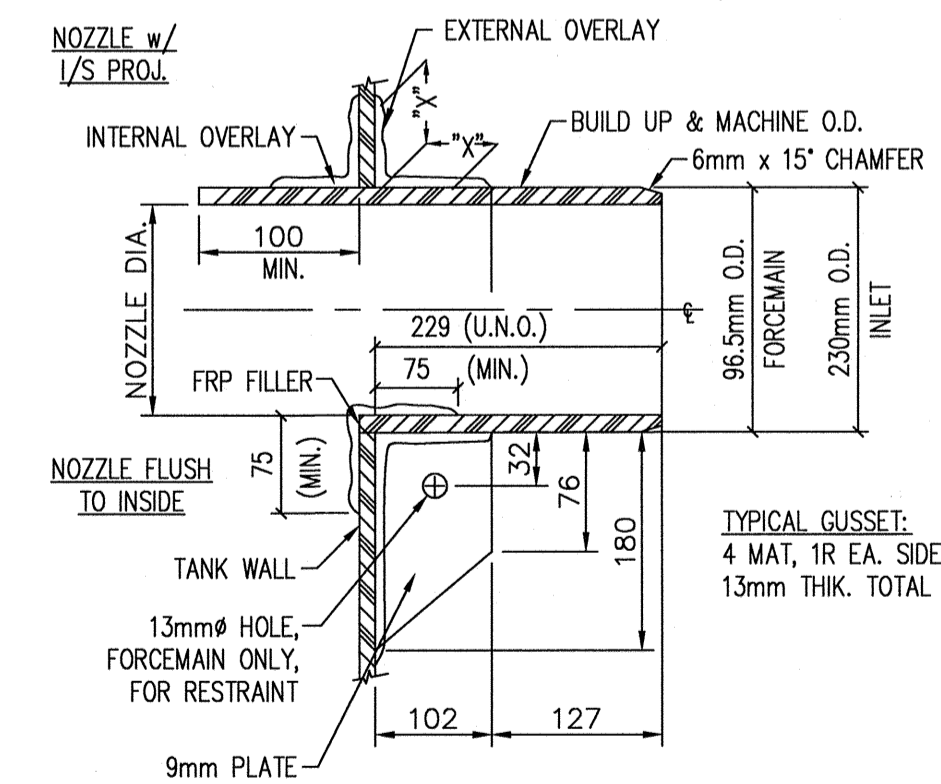

NOZZLE NOTES

A MINIMUM OF 2 LAYERS OF WOVEN ROVING IS REQUIRED FOR NOZZLE PORTION OF OVERLAY. TANK PORTION OF OVERLAY SHALL BE SAME THICKNESS AS TANK WALL DIMENSION "X" SHALL BE GREATER THAN ONE HALF THE NOZZLE DIAMETER. INTERNAL OVERLAY TO HAVE A MINIMUM OF 2 LAYERS MAT. FRP REINFORCING MATERIAL TO BE CUT TO A SHAPE TO ENSURE A SMOOTH LAMINATE.

DETAIL "5" - TYPICAL NOZZLE, MACHINED
N.T.S.

BILL OF MATERIALS

QTY	DESCRIPTION	BY
6	HOLD DOWN LUGS, EPOXY COATED MS	
2	LIFTING LUGS, EPOXY COATED MS	
1	MARINE GRADE SAFETY LADDER, ALUMINUM, FULL LENGTH c/w MSU SAFE "T" HANDLE	
1	200mm INLET, FRP, MACHINED c/w INTERNAL TEE & DROP PIPE	
1	80mm FORCEMAIN, FRP, MACHINED c/w (2)-80mm RISERS, VAN x FL; (2)-80mm THD' NIPPLE; (2)-80mm-150 THD' FLG, CS; (2)-80mm-45' ELL, FRP; (1)-80mm LR 90' ELL, FLx FRP; (1)-80mm STR. TEE, FRP; (4)-80mm-150 FF FLG, FRP; (1)-15mm NPT BOSS FOR P.I.; (1)-50mm NPT CONN. FOR AIR RELEASE	
1	100mm EMERGENCY SUCTION, FRP, c/w DROP PIPE & 100mm CAMLOCK FITTING	
1	150mm AIR SUPPLY, FRP, c/w DROP PIPE	
1	150mm AIR EXHAUST, FRP c/w CARBON FILTER ENCLOSURE (FILTER MEDIA BY OTHERS)	
4	50mm THD'D. ELECTRICAL CONNECTION	
8	12mm PUMP BASE BOLTS, 304 SS	
4	20mm GUIDE BARS, GALV.	
1	INTERMEDIATE PLATFORM, c/w ALUMINUM SUPPORT MEMBERS & FRP GRATING PANELS	
1	UT TRANSDUCER MOUNTING BRACKET, ALUM.	
1	EXPLOSION PROOF LIGHT, COOPER CROUSE-HINDS HAZGUARD EXACTA MODEL IPEH, WALL MOUNT, 150W, 120V/60Hz, CLEAR GLASS GLOBE, SS GUARD	
1	FLYGT ALUMINUM ACCESS HATCH, 13-430302-DD, GAS ASSIST (BY FLYGT)	
1	FLYGT ALUMINUM ACCESS HATCH, 13-430300-DD, GAS ASSIST (BY FLYGT)	
2	UPPER GUIDE BAR SUPPORTS (BY FLYGT)	
2	PUMP CP 3057 HT DN80 c/w DISCHARGE ELBOW FOR T.O.P. BASE (BY FLYGT)	
2	80mm FLG'D, SINKING BALL CHECK VALVE, HDL 5087 (BY FLYGT)	
2	80mm FLG'D PLUG VALVE, VALMATIC CAMCENTRIC, 5808N (BY FLYGT)	
1	HORIZONTAL LEVEL REGULATOR HANGER & (2) EXM BULBS (BY FLYGT)	
1	AIR RELEASE VALVE c/w ISO VALVE (BY FLYGT)	
1	80mm FLG'D MAGFLOW METER, SIEMENS SITRANS FM3 5100W OR EQUAL (BY FLYGT)	
1	PRESSURE GAUGE & STOP COCK (BY FLYGT)	
1	ROOF MOUNT LIFTING DAVIT SOCKET (810mm REACH) (BY FLYGT)	
6	22mm ANCHOR BOLTS, MS (BY OTHERS)	

FABRICATION DESIGN STANDARDS

1. FLYGT SPECIFICATION GE-1008-04, REVISION MAY 2002
2. AMEC 4S-10.01 MANUFACTURE AND INSTALLATION FOR FRP STRUCTURES
3. AMEC 4S-10.02 FRP PRESSURE PIPE, FITTINGS AND FLANGES

GENERAL NOTES

1. WINDING ANGLE - 75°
2. TANK WALL - VARIES, SEE ELEVATION VIEW
3. LINER - C-GLASS VEIL AND (2)-1 1/2 oz. MAT
4. RESIN - ISOPHTHALIC
5. EXTERIOR (ABOVE GRADE) TO HAVE DARK GREEN GELCOAT
6. INTERIOR FINISH: WHITE ISOPHTHALIC NPG GELCOAT
7. DIMENSIONS ARE IN MILLIMETERS U.N.O.
8. SHIPPING WEIGHT: 3045 kg (6700 LBS)

INSTALLATION PROCEDURES

THE FOLLOWING RECOMMENDATIONS ARE BASED ON FLYGT EXPERIENCE AND ARE IN NO WAY MEANT TO REPLACE THE ENGINEERS INSTRUCTIONS OR SPECIFICATIONS AND MUST BE USED IN CONJUNCTION WITH THE EXISTING AND ANTICIPATED CONDITIONS AT THE JOBSITE.

1. USE THE LIFTING LUGS PROVIDED FOR VERTICAL HANDLING.
2. USE SLINGS AROUND THE MAIN TANK FOR HORIZONTAL HANDLING.
3. ENSURE UNIT IS STANDING VERTICAL ON CONCRETE PAD.
4. BOLT UNIT FIRMLY AND SQUARELY IN PLACE, SHIM WHERE NECESSARY.
5. FILL ANNULUS BETWEEN THE TANK SHELL AND OUTSIDE OF THE "T.O.P." SUMP WITH CONCRETE. AT THE SAME TIME ENCASE LOWER RIB IN CONCRETE TO A MINIMUM HEIGHT OF 150mm ABOVE RIB TO PROVIDE ANCHORAGE. REBAR TO CONNECT SECOND POUR TO CONCRETE BASE PAD.
6. WHEN EXTERNAL VALVES ARE MOUNTED, SUPPORT PIPING CONNECTIONS DIRECT TO CONCRETE PAD.
7. MAINTAIN A DRY SITE UNTIL BACKFILLING OPERATIONS COMMENCE.
8. USE A GOOD QUALITY SCREENING OR SAND AS BACKFILL MATERIAL TO 90% COMPACTION.
9. PLACE THE BACKFILL IN EQUAL INCREMENTS NOT EXCEEDING 300mm THICK AROUND THE STATION TO PREVENT UNBALANCED LOADS BEING IMPOSED DURING BACKFILLING OPERATIONS. PROGRESSIVELY TAMP BACKFILL AROUND STATION TO FULL HEIGHT TO REDUCE SETTLEMENT TO AN ABSOLUTE MINIMUM.

REV	DATE	DESCRIPTION	BY
4	2012/04/03	PLAN OF RECORD	
3	2011/07/29	CHANGED DAVIT SOCKET; MOVED EMERGENCY SUCTION ON ROOF	LMc
2	2011/07/27	PUMP RELOCATION	LMc
1	2011/07/15	ADDED (1) ELECTRICAL CONNECTION	LMc
0	2011/06/21	ISSUED FOR APPROVAL	LMc

TOLERANCES (U.N.O.)

LINEAR	ANGULAR
X ± 1.5	X.X ± 1/2°



2378 WESTLAKE RD.
KELOWNA, B.C.
V1Z 2V2

NOTICE: THIS DRAWING HAS NOT BEEN PUBLISHED AND IS THE SOLE PROPERTY OF BARKSI INDUSTRIES (1985) LTD. AND IS LOANED TO THE BORROWER FOR HIS CONFIDENTIAL USE ONLY, AND IN CONSIDERATION OF THE LOAN OF THIS DRAWING, THE BORROWER PROMISES AND AGREES TO RETURN IT UPON REQUEST AND AGREES THAT IT SHALL NOT BE REPRODUCED, COPIED, LENT OR OTHERWISE DISPOSED OF DIRECTLY OR INDIRECTLY, NOR USED FOR ANY PURPOSE OTHER THAN THAT FOR WHICH IT WAS FURNISHED.

CLIENT	ENGINEER		
ITT W&W COQUITLAM, B.C.	STANTEC CONSULTING LTD.		
PROJECT			
GLENROSA SEWER - PHASE 3 GLENGARRY ROAD SANITARY LIFT STATION			
TITLE			
2438.4mm I.D. GLENGARRY ROAD LIFT STATION			
ENG BY:	DATE:	CAD FILE:	PROJECT:
LMc	2011/06/15	GlenGarry	
CAD BY:	DATE:	SCALE:	AS SHOWN
APP BY:	DATE:	DRAWING NUMBER	REV
		11-121	
ISSUED BY:	DATE:		



PERFORMANCE CURVE

PRODUCT
NP3085.183

TYPE
MT

DATE
2013-08-27



PROJECT
INVERNESS LS 1

CURVE NO
63-463-00-3806

ISSUE
4

MOTOR COS PHI	0.84	0.79	0.68	MOTOR SHAFT POWER	3	hp
MOTOR EFFICIENCY	77.0 %	78.5 %	77.0 %	STARTING CURRENT ...	17	A
GEAR EFFICIENCY	—	—	—	RATED CURRENT ...	3.3	A
COMMENTS	INLET/OUTLET - / 80 mm			RATED SPEED	1695	rpm
	IMP. THROUGHLET ---			TOT.MOM.OF INERTIA ...	0.018	kgm2
				NO. OF BLADES	2	

IMPELLER DIAMETER 135 mm		
MOTORTYPE 15-10-4AL	STATOR 51Y	REV 12
FREQ. 60 Hz	PHASES 3	VOLTAGE 600 V
GEARTYPE ---	RATIO ---	
POLES 4		

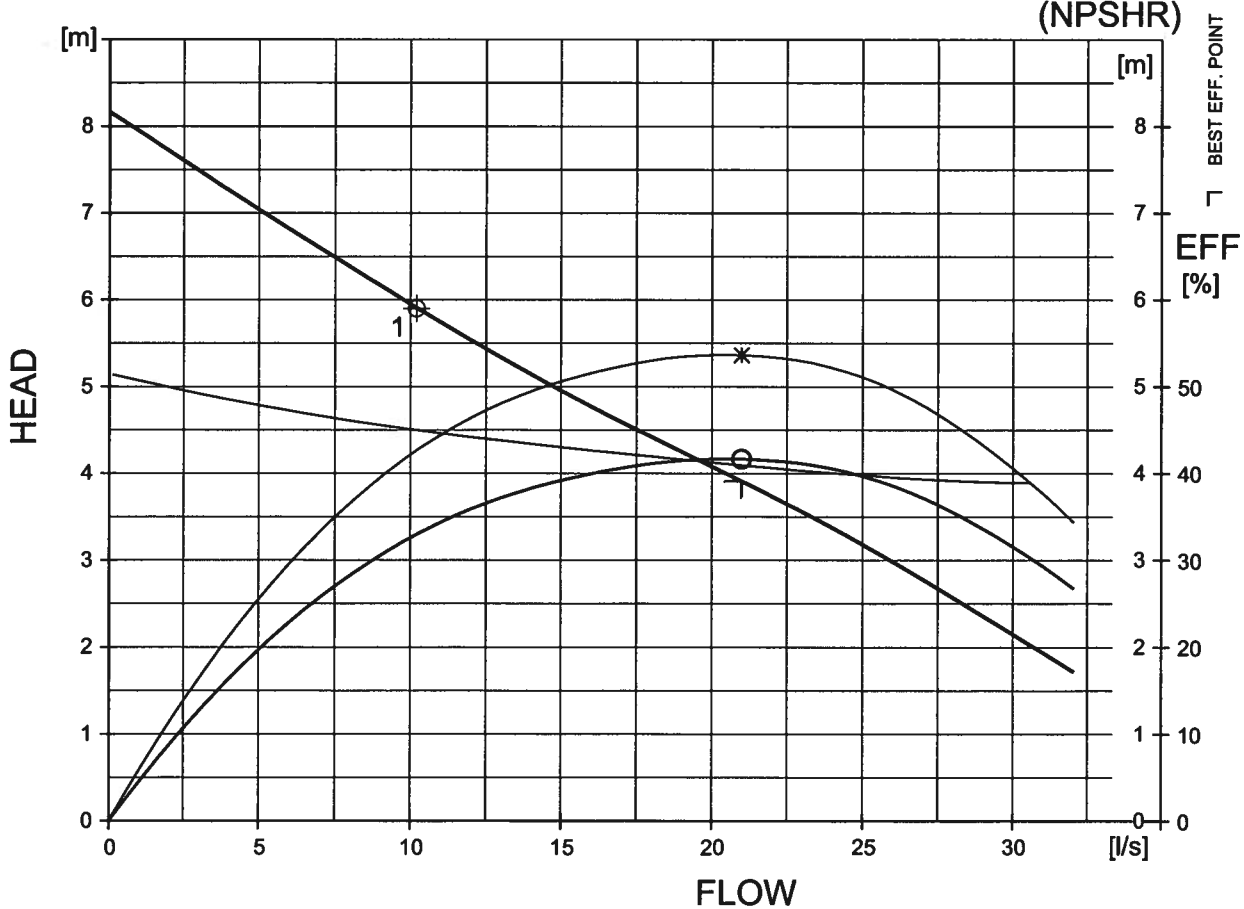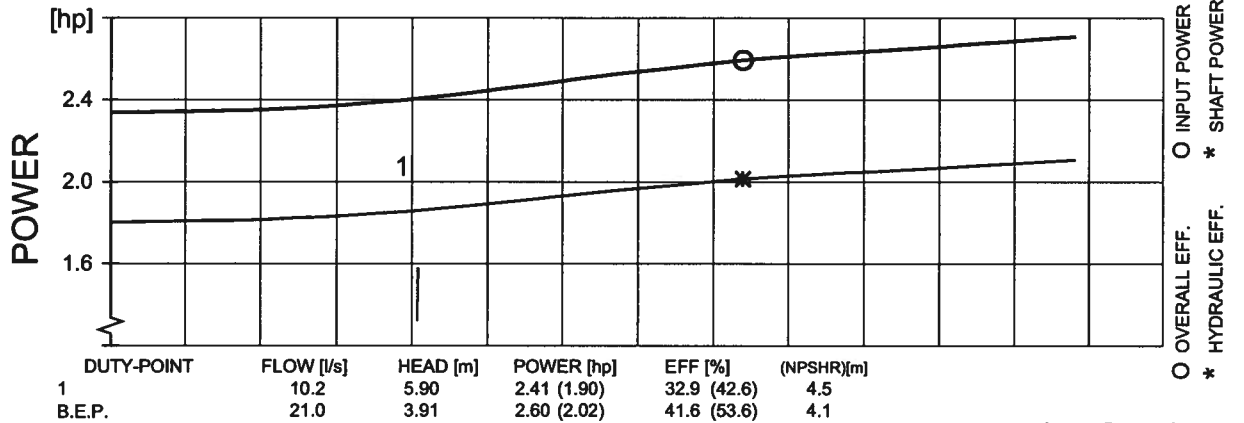

FLYPS3.1.5.7 (20060531)

(NPSHR) = (NPSH3) + margins
Performance with clear water and rating data at 40 °C



CURVE



District of West Kelowna

Sanitary Lift Station Evaluation

Station: Glengarry LS2
Reviewed By: Jim Kentel

Year Constructed: 8/1/2011
Year Upgraded:

Matrix Rating			
(10 - highest rating)	Civil	35	
(1 - lowest rating)	Process Mechanical	161	
	Electrical Instrumentation	132	
	Total Station Rating	328	(max. rating 370 points)



Civil:**Matrix
Rating**

Parking Area: Yes	n/a
Drainage: Good	10
Influent sewer: Good 200 Gavity PVC	10
Site access: Good	10
Water service: Irrigation service only	5
	35

Process Mechanical:



Station type: Submersible	n/a
Number of pumps: 2	n/a
Pump Redundancy: Yes	n/a
Pump Manufacturer / Type: FLYGT	10
Pump Model: CP3057 .181 HT	n/a
Rated Capacity: 9.4L/S @ 7.5m TDH	n/a
Capacity Confirmation:	n/a
Forcemain pipe type / diameter: PVC/100mm	10
Header pipe type / diameter: FRP/80	10
Check valve type / diameter: Sinking Ball HDL 5087/80	10
Isolation valve type / diameter: Plug Valmatic /80	10
Piping Condition: FRP	10
Emergency pumpout connection: Yes	10
Pressure gauges: Yes	10
Inlet bar screen: No	1
Wetwell condition: Good	10
Access Hatches: Alum	10
Ladder / Platform: Alum/FRP	10
Wetwell benching: T.O.P. base	10
Odour Control: Carbon	10
Ventilation: Yes	10
Water washdown: Yes/19mm	10
Confined Space Entry Requirements: Davit	10
	161

Electrical / Instrumentation:

Matrix
Rating



Service Type	V / A / Phase / Wire	n/a
Pump 1 :	HP 2.3	n/a
	Volts/400 Rpm 2700	n/a
	FLA 3.8A	n/a
Starting Current	17A	n/a
Pump 2 :	HP 2.3	n/a
	Volts/400 Rpm 2700	n/a
	FLA 3.8A	n/a
Starting Current	17A	n/a
Alarm Functions:	Yes	10
		n/a
		n/a
		n/a
Receptacle	Yes	10
Interior Lighting:	Yes	10
Exterior Lighting:	No	1
SCADA / Telemetry:	Yes	10
Main Breaker:	100A	10
Control Panel:	Yes	10
Lighting Panel:	Yes	10
Flowmeter:	Siemens Sitrans FM3 5100W	10
Grounding:	Yes	10
Surge Protection:	Yes	10
UPS:	Yes	10
PLC:	Yes	10
Level Control:	Yes Milltronics/Bulbs	10
Standby Generator:	No	1
		132
Comments:	New Station	

"Please note that it is the user's responsibility to confirm the accuracy of the as-constructed information shown on this drawing before proceeding with any work (i.e. design or construction) that is based on that information."

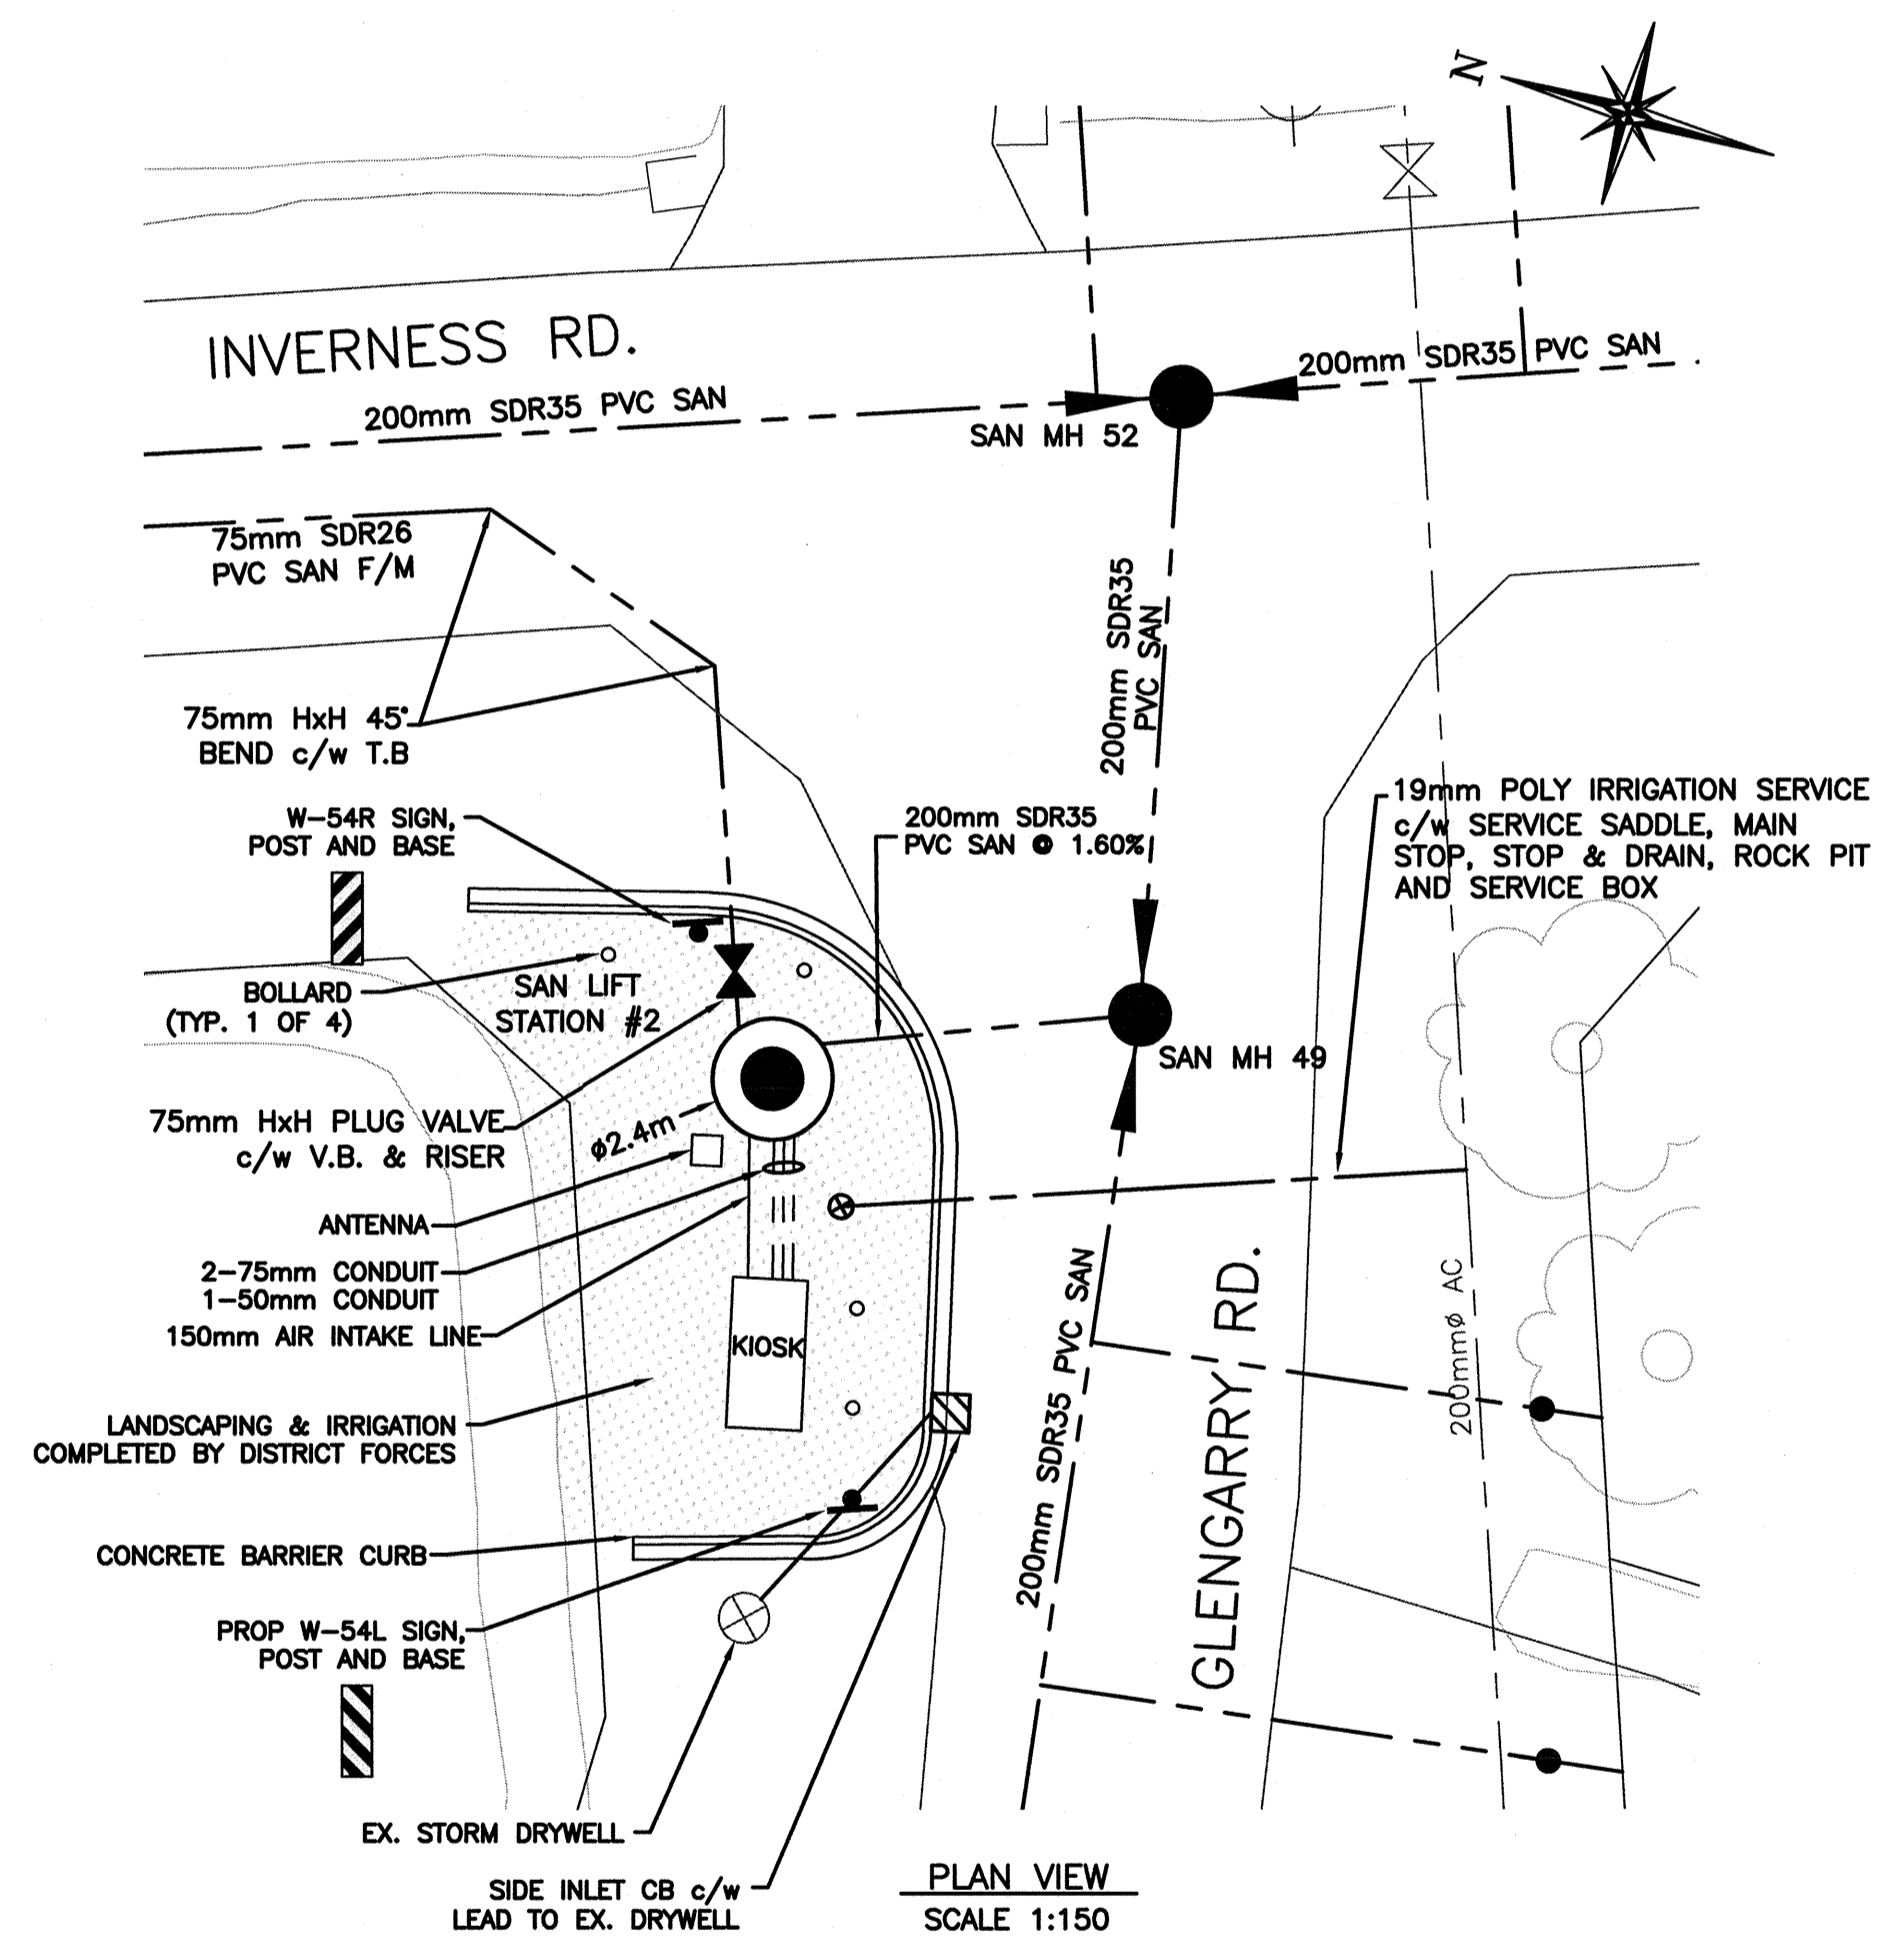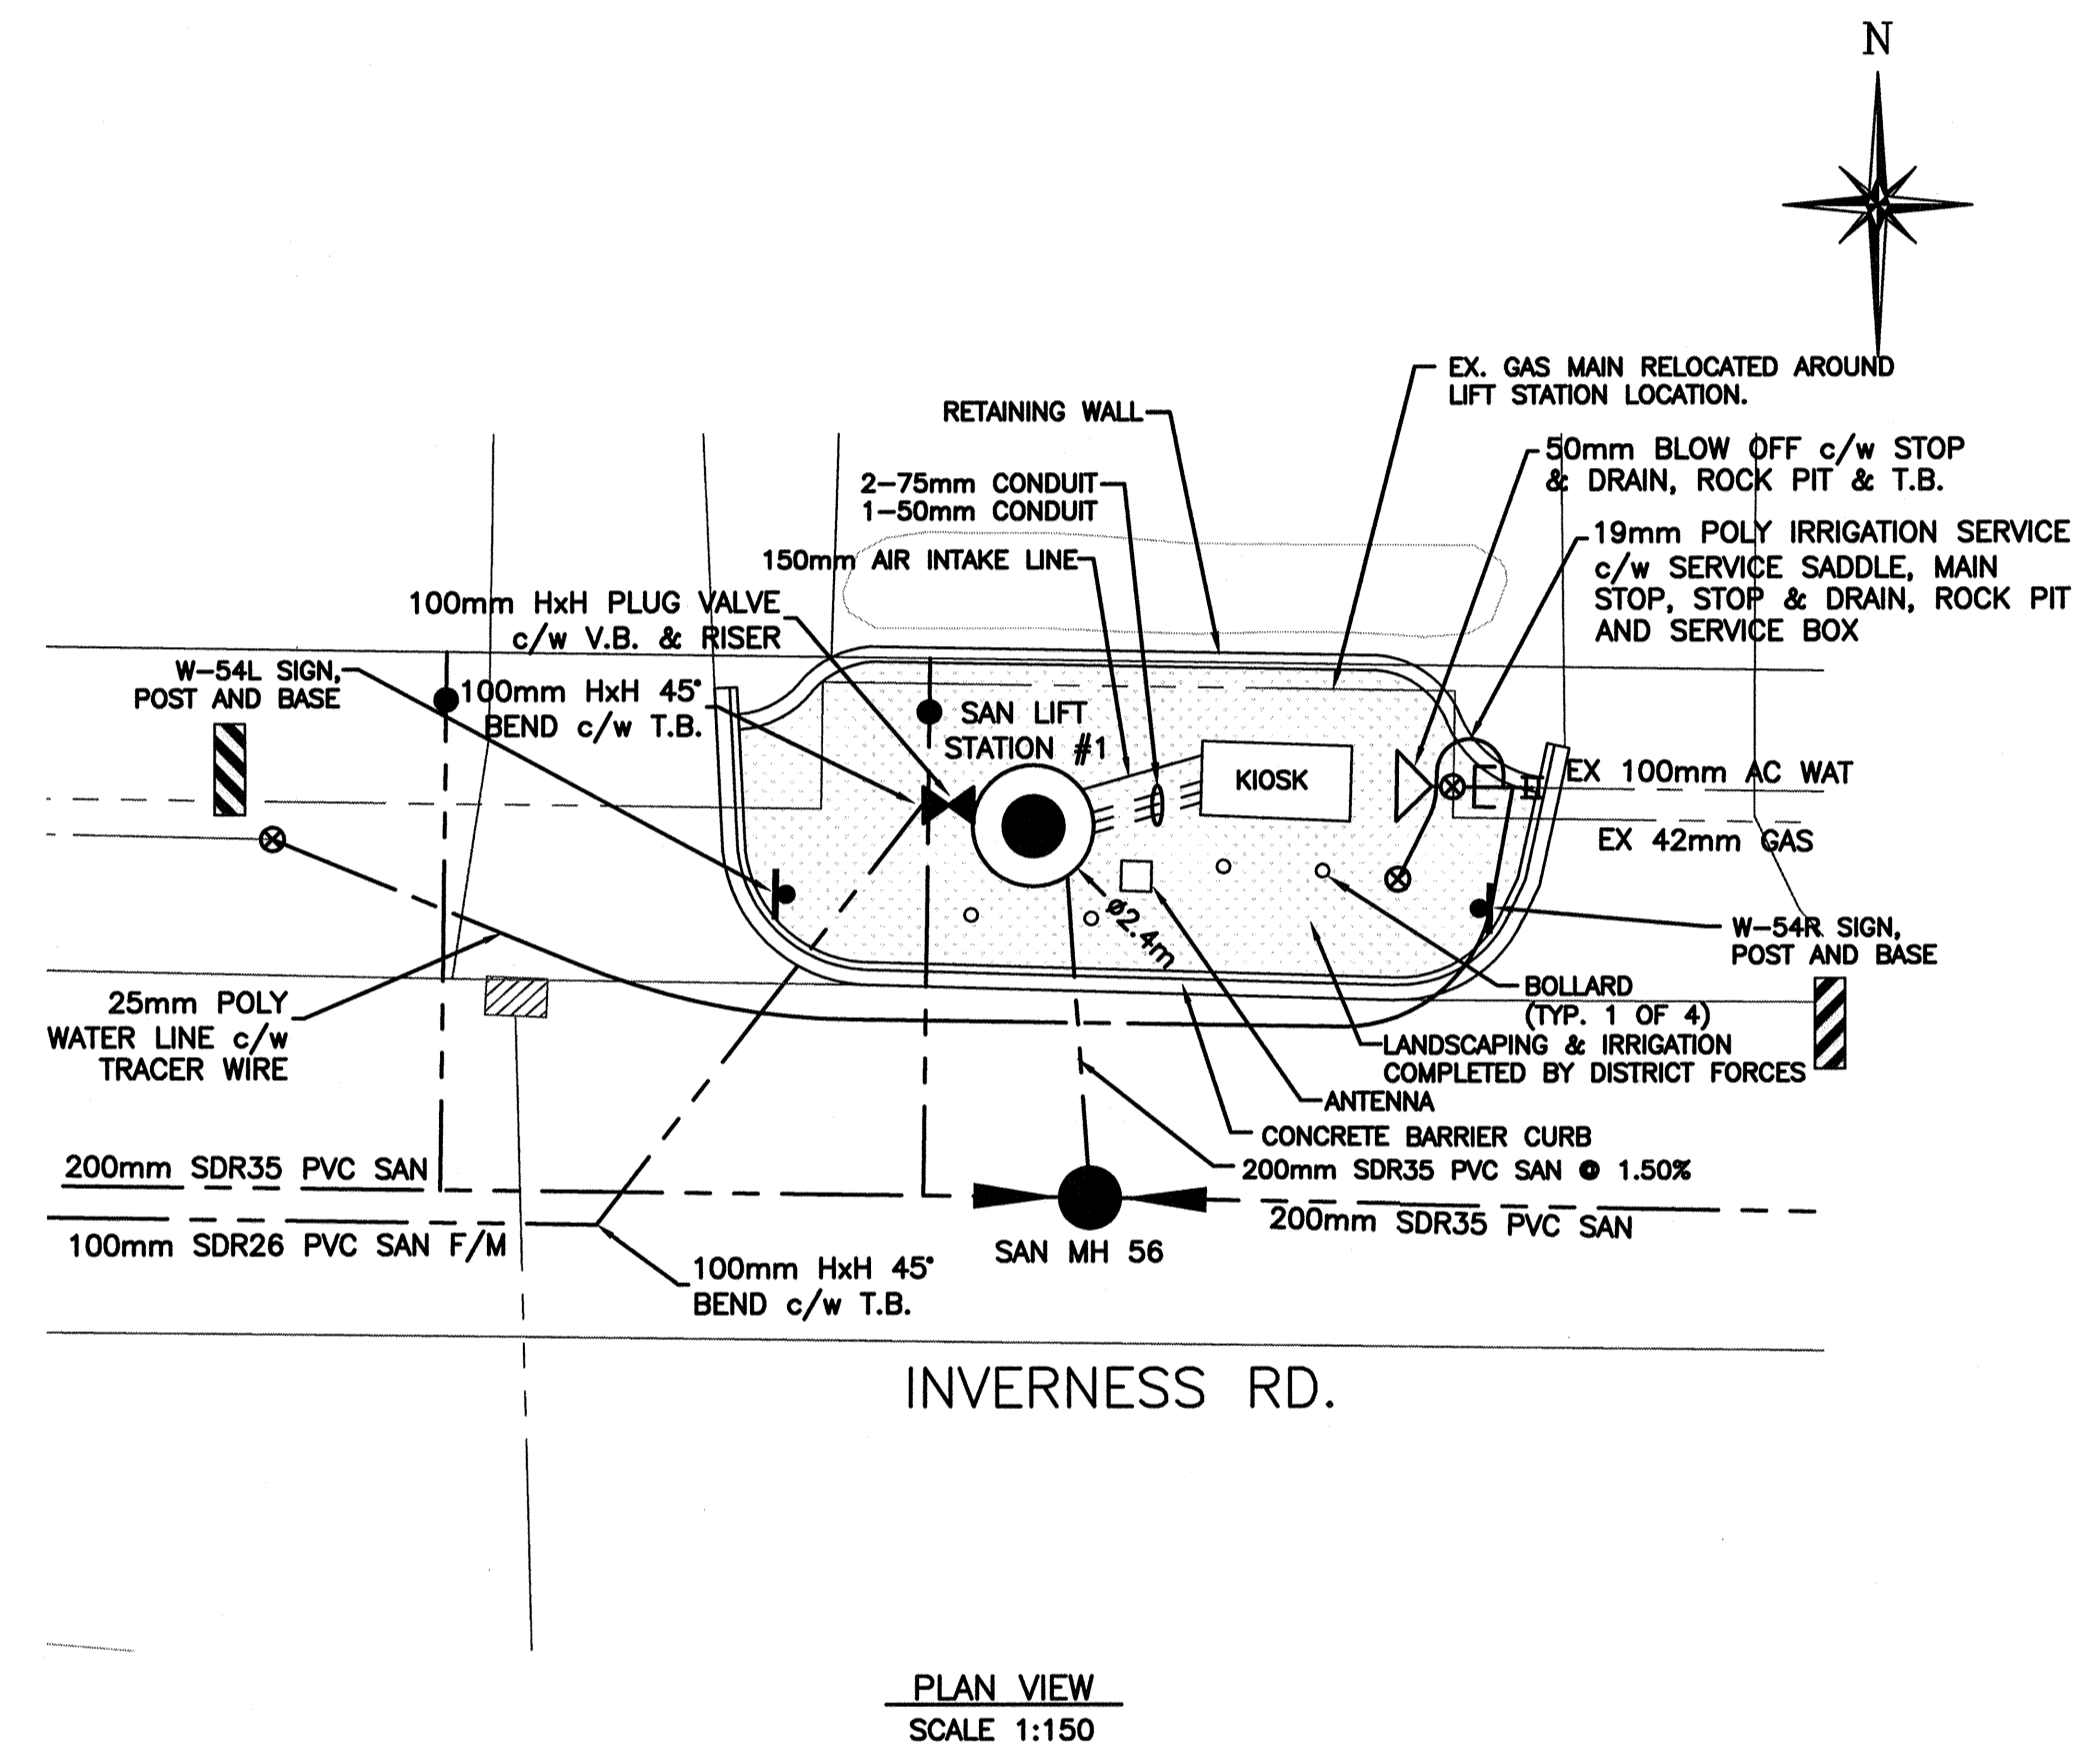

LEGEND	
CABLE TV	□ CAP
GAS	▣ CATCH BASIN
SAN. SEWER	∇ ELECTRICAL BOX
STORM SEWER	⊕ HYDRANT
U.G. ELECTRICAL	⊖ VALVE
U.G. TELEPHONE	⊞ LAMP STANDARD
WATER	○ SAN # SANITARY MH (EXISTING OR FUTURE)
	● SAN # SANITARY MH
	○ STM # STORM MH (EXISTING OR FUTURE)
	● STM # STORM MH
	⊞ TRANSFORMER
	⊞ UTILITY JUNCTION BOX

No.	DATE	BY	REVISION	Chk'd	No.	DATE	BY	STATUS	Chk'd
5					5			PLAN OF RECORD	
4	04.03.2012	CLS	PLAN OF RECORD		4			APPROVAL FOR CONSTRUCTION	
3	05.31.2011	CLS	ISSUED FOR CONSTRUCTION		3			FOR TENDER	
2	05.02.2011	CLS	ISSUED FOR TENDER		2			FOR APPROVAL	
1	03.11.2011	CLS	ISSUED FOR TENDER REVIEW		1			PRELIMINARY	







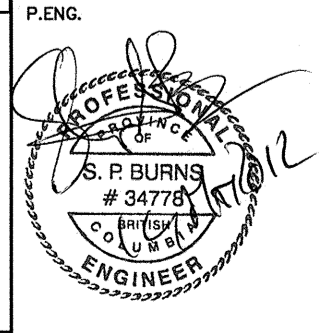
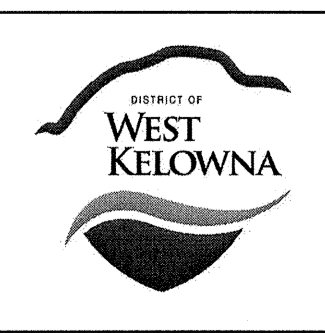


DRAWN	CLS
DESIGN	SPB
APPROVED	SPB
DATE	JANUARY 2011
SCALE	AS NOTED

Stantec Consulting Ltd.
400-1620 Dickson Avenue,
Kelowna, B.C. V1Y 9Y2
Tel. (250) 860-3225
Fax. (250) 860-3367

**GLENROSA SEWER - PHASE 3
INVERNESS RD. & GLENGARRY RD.
SANITARY LIFT STATION DETAILS**

DRAWING NO.	S01
REV. NO.	4
	112720220

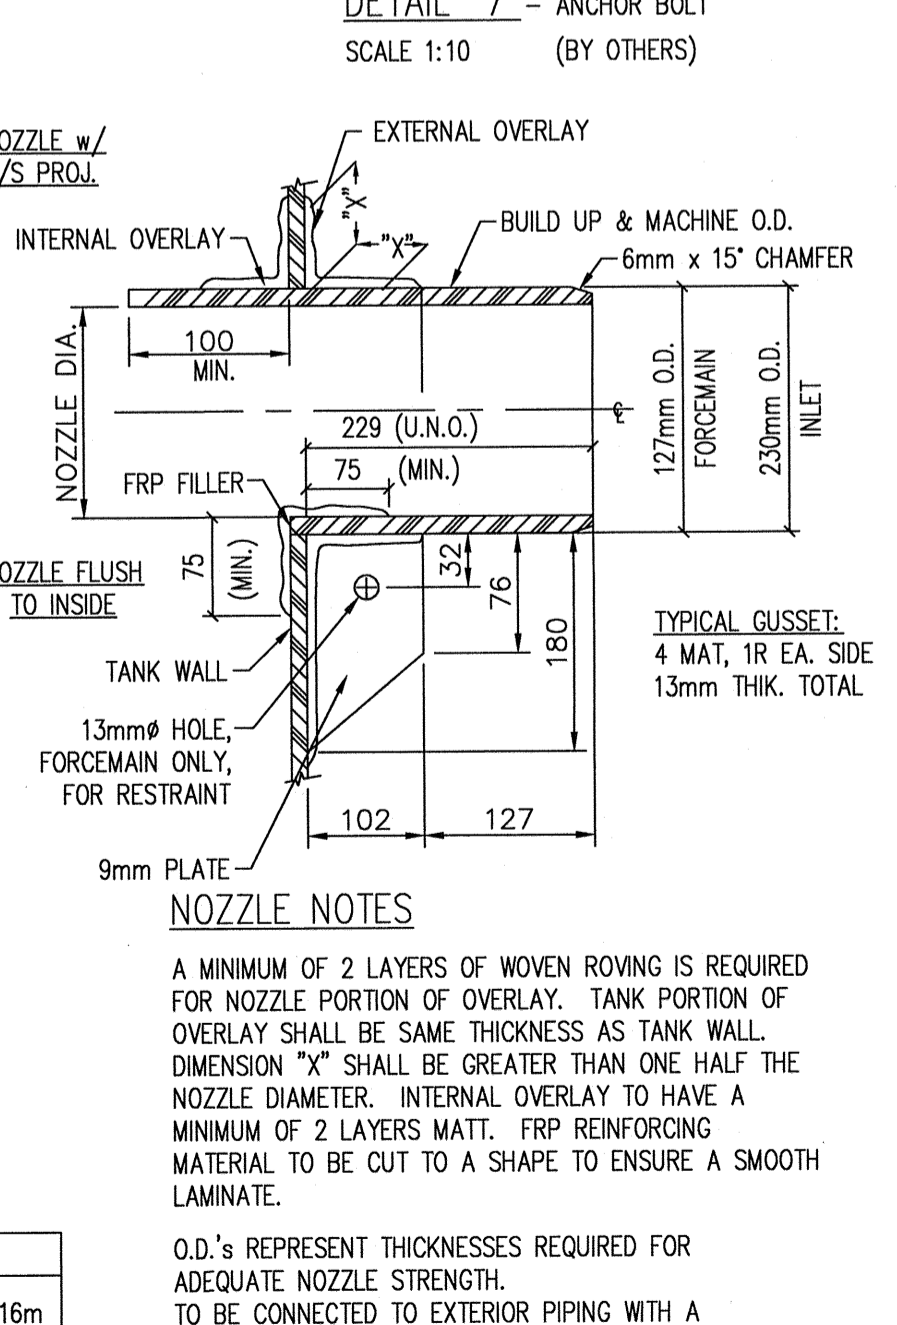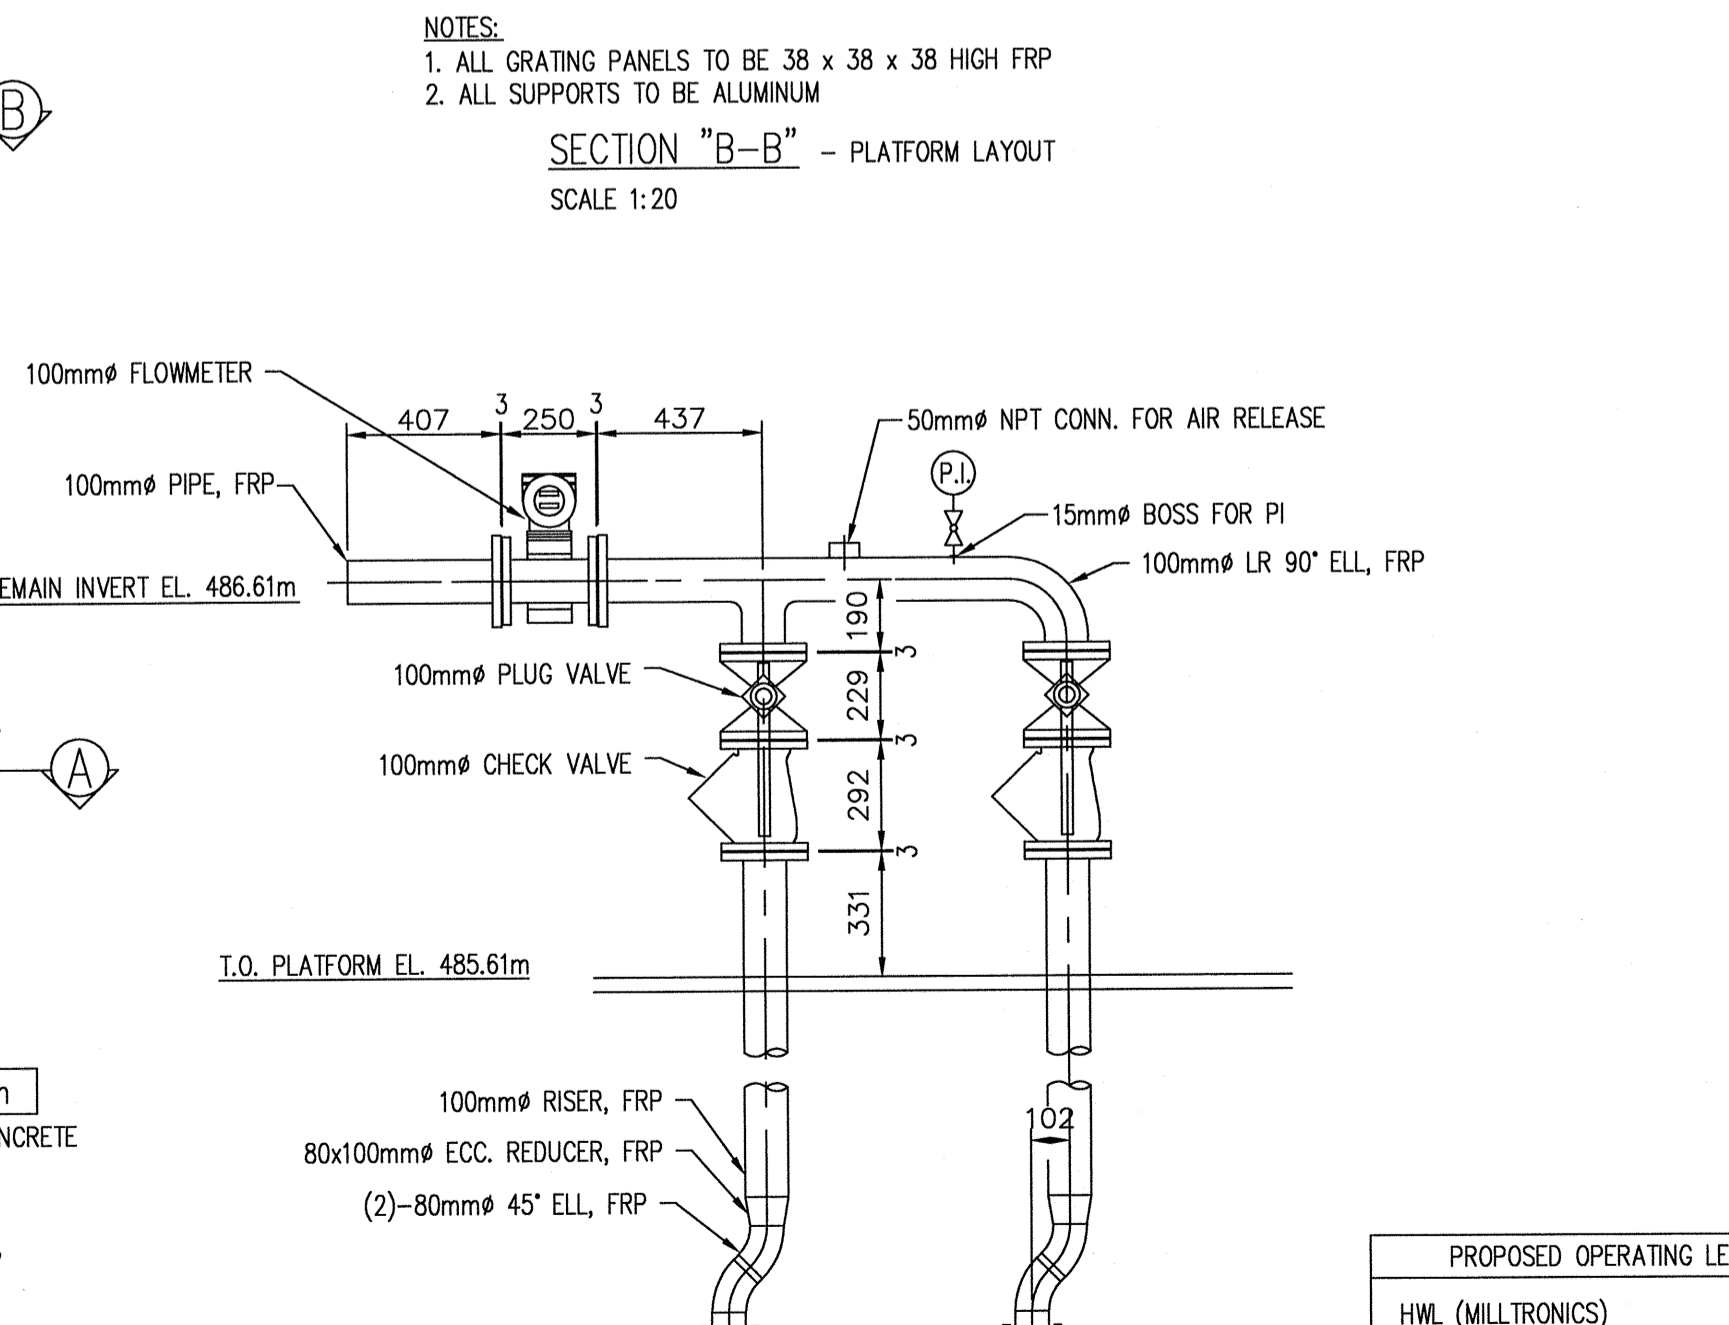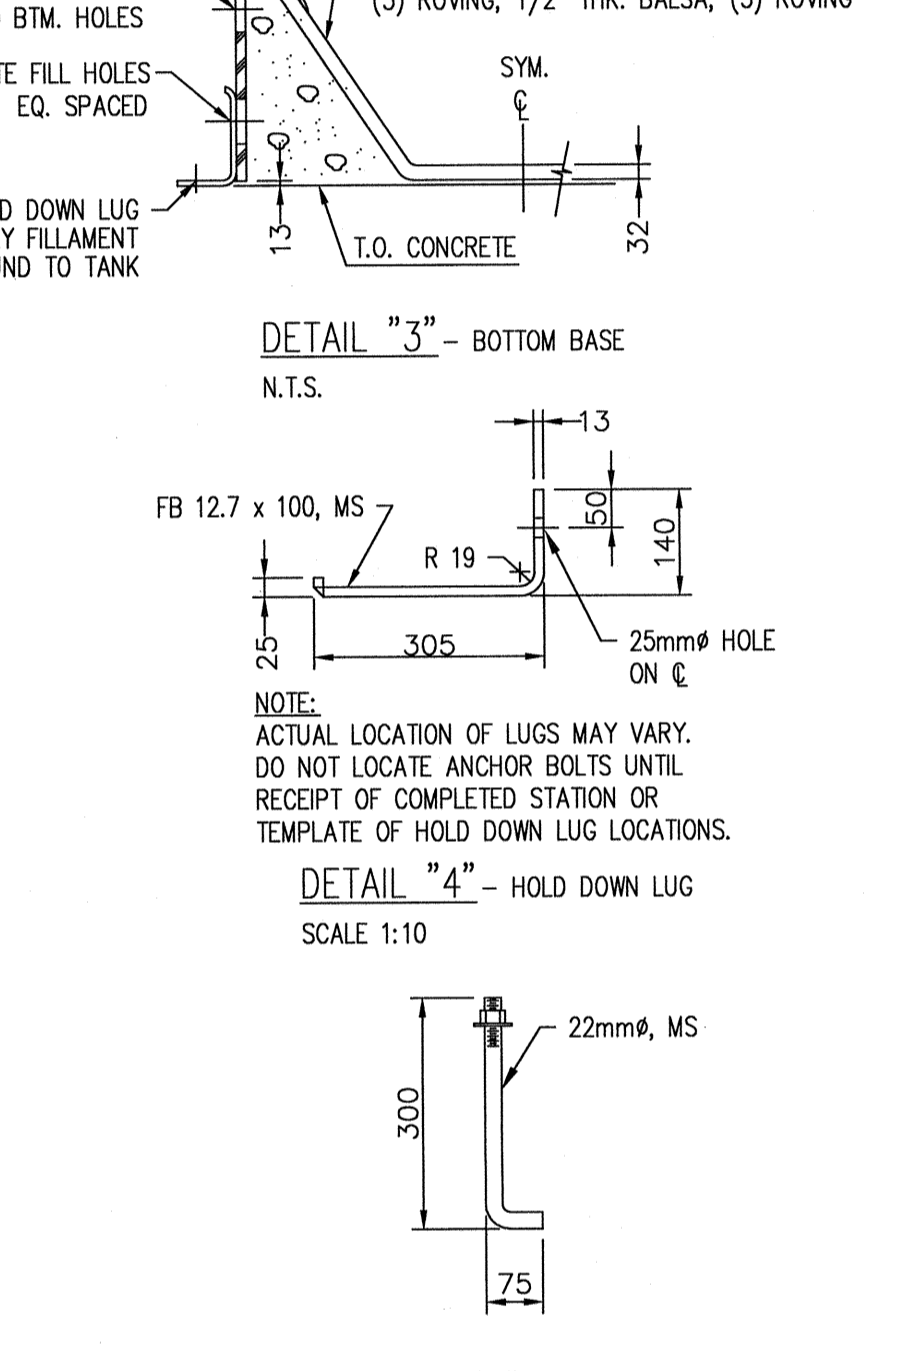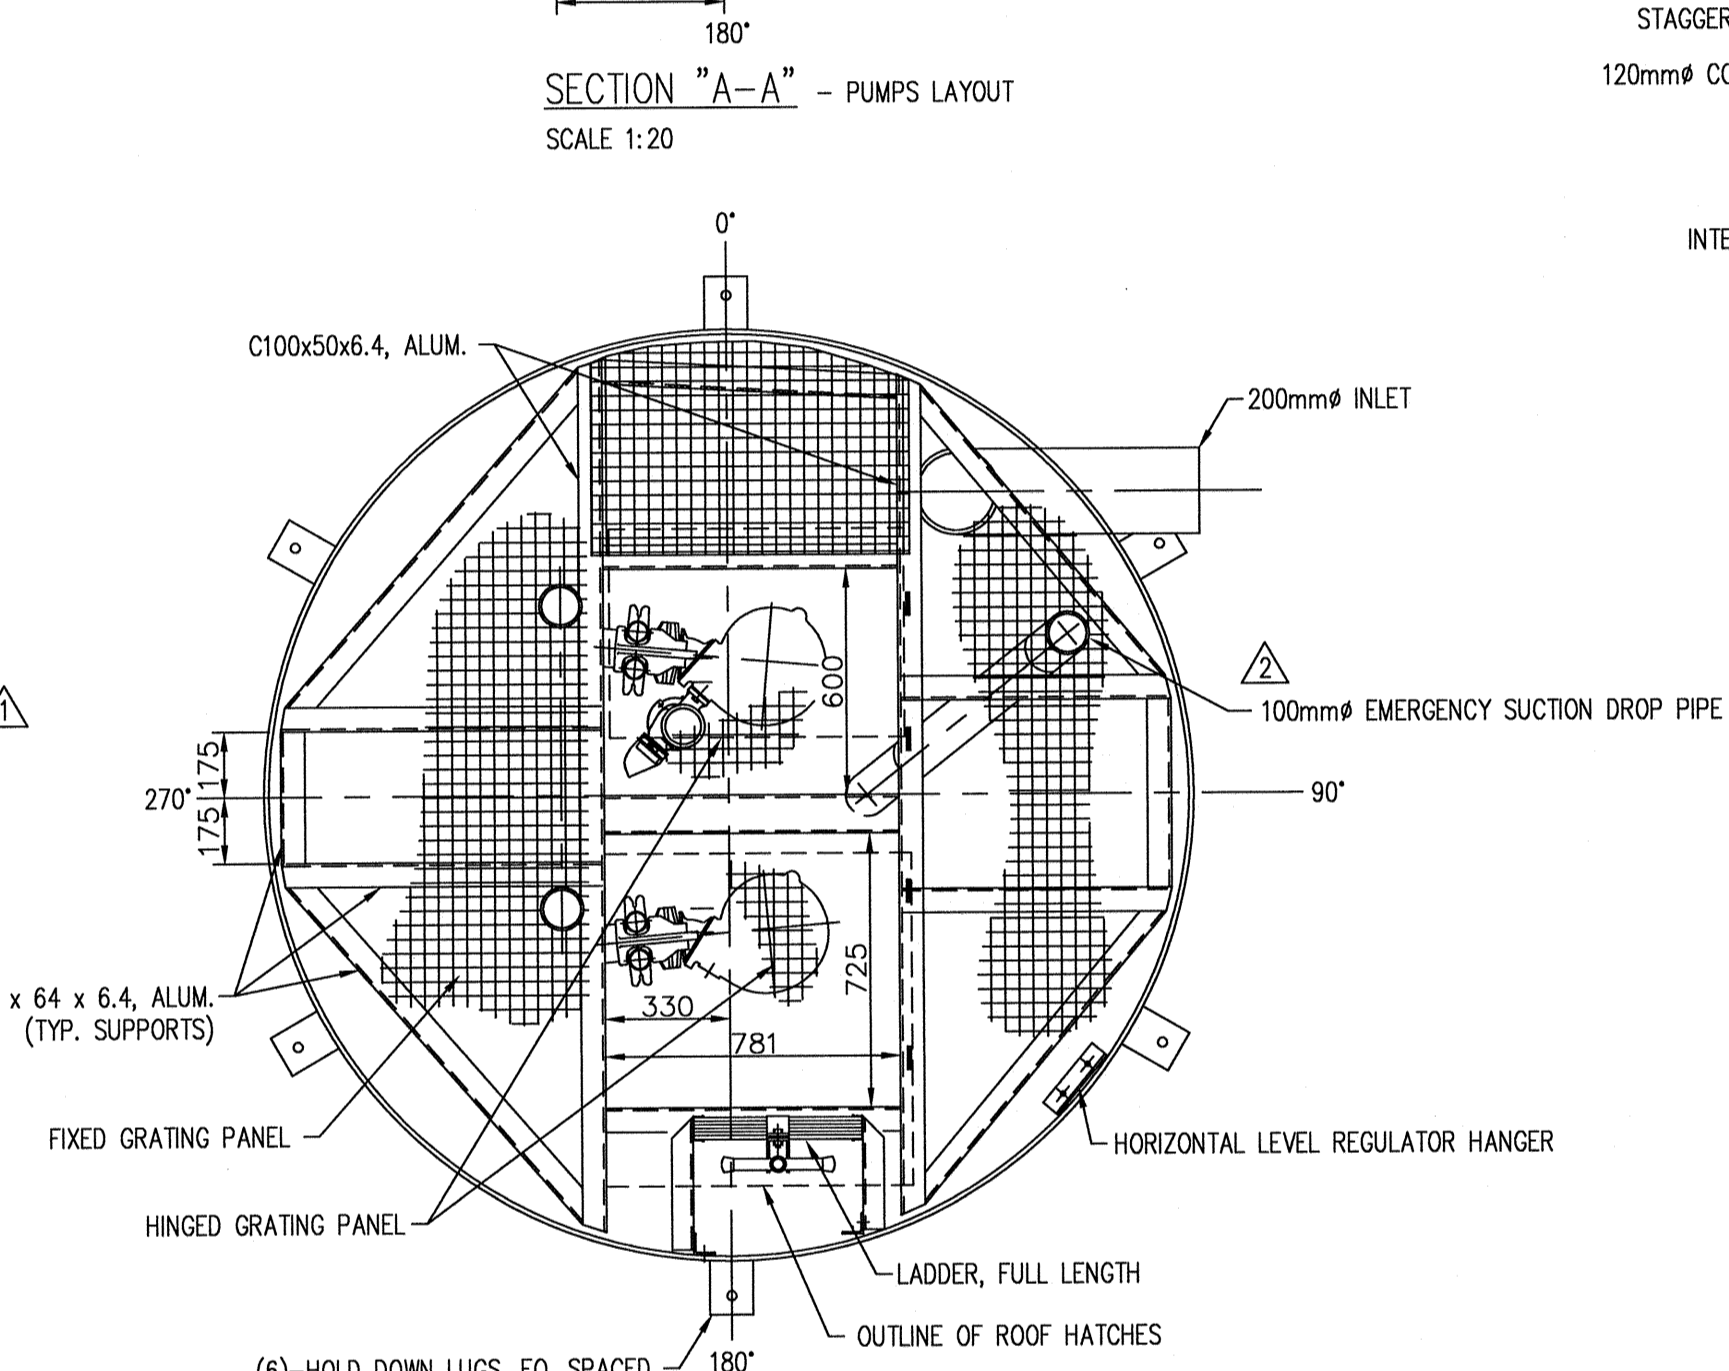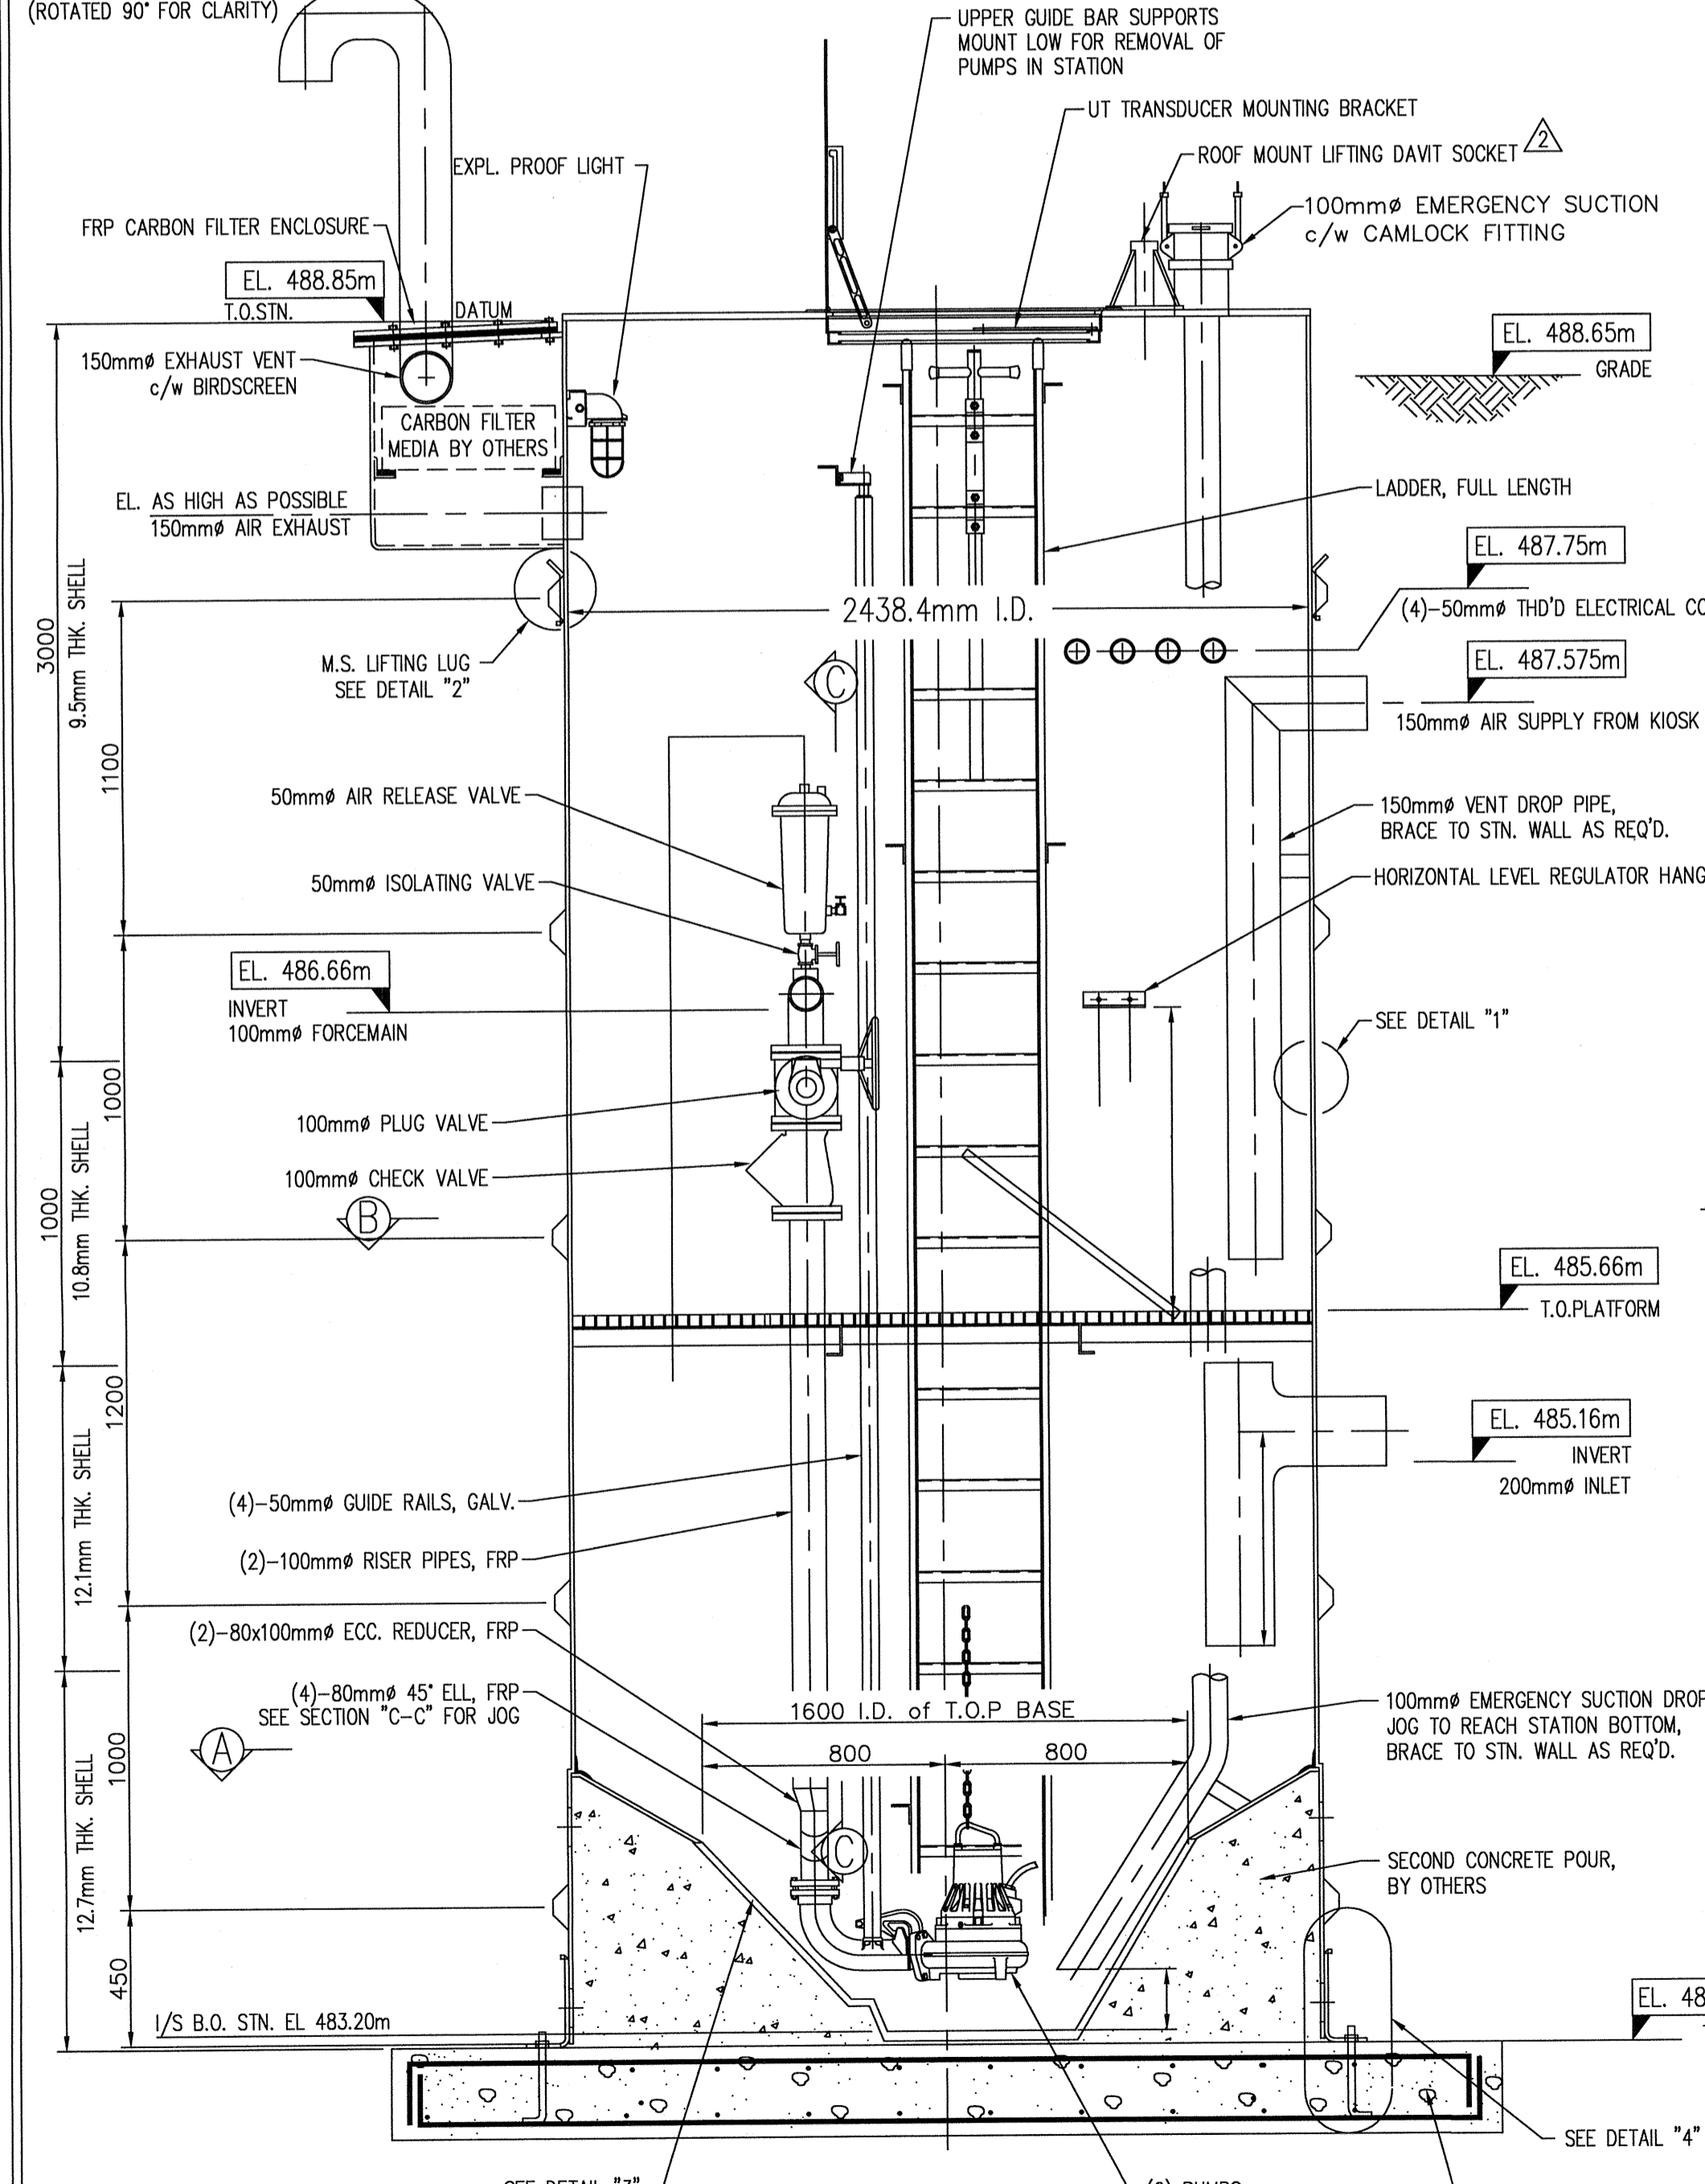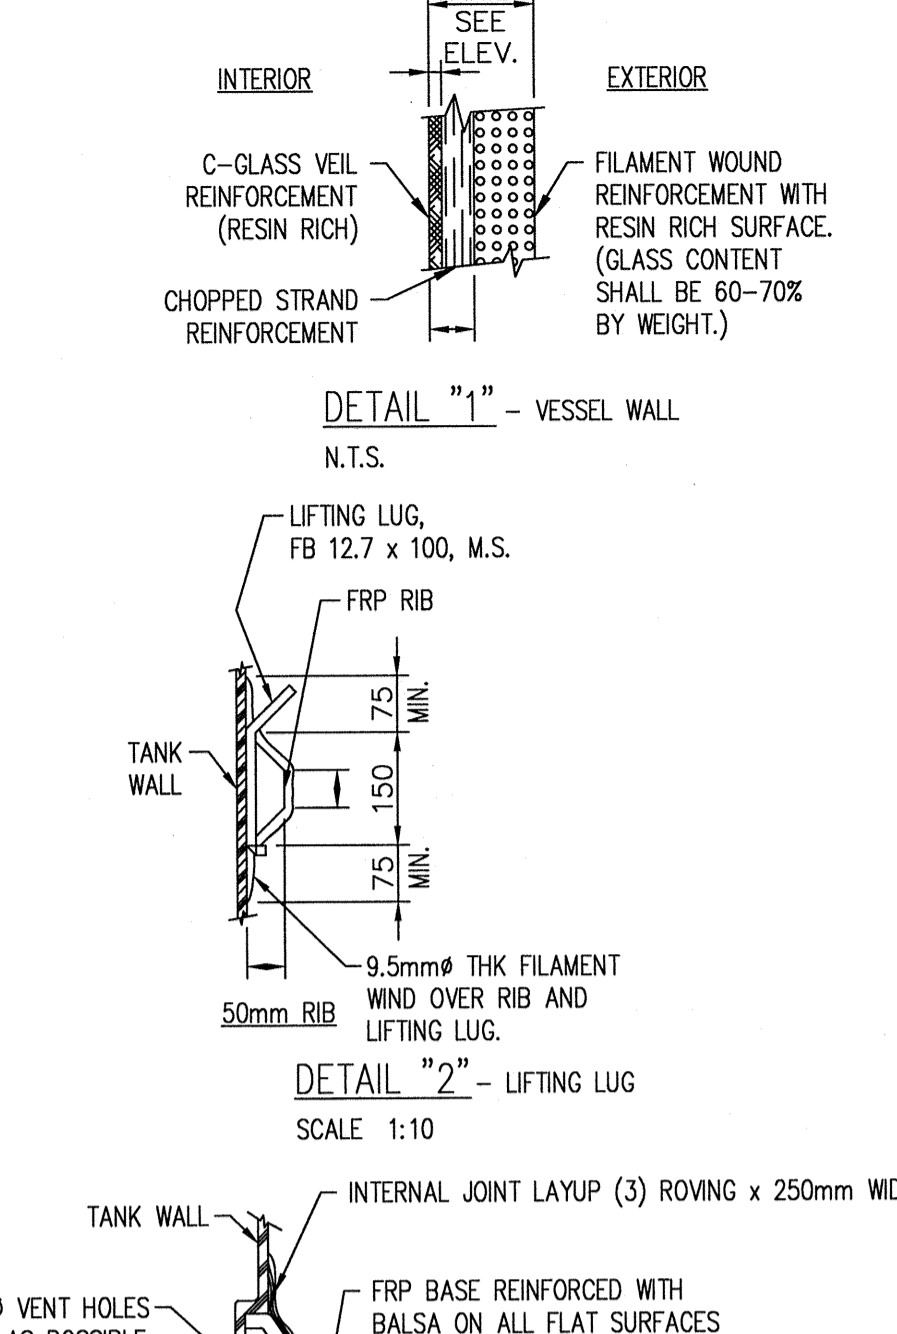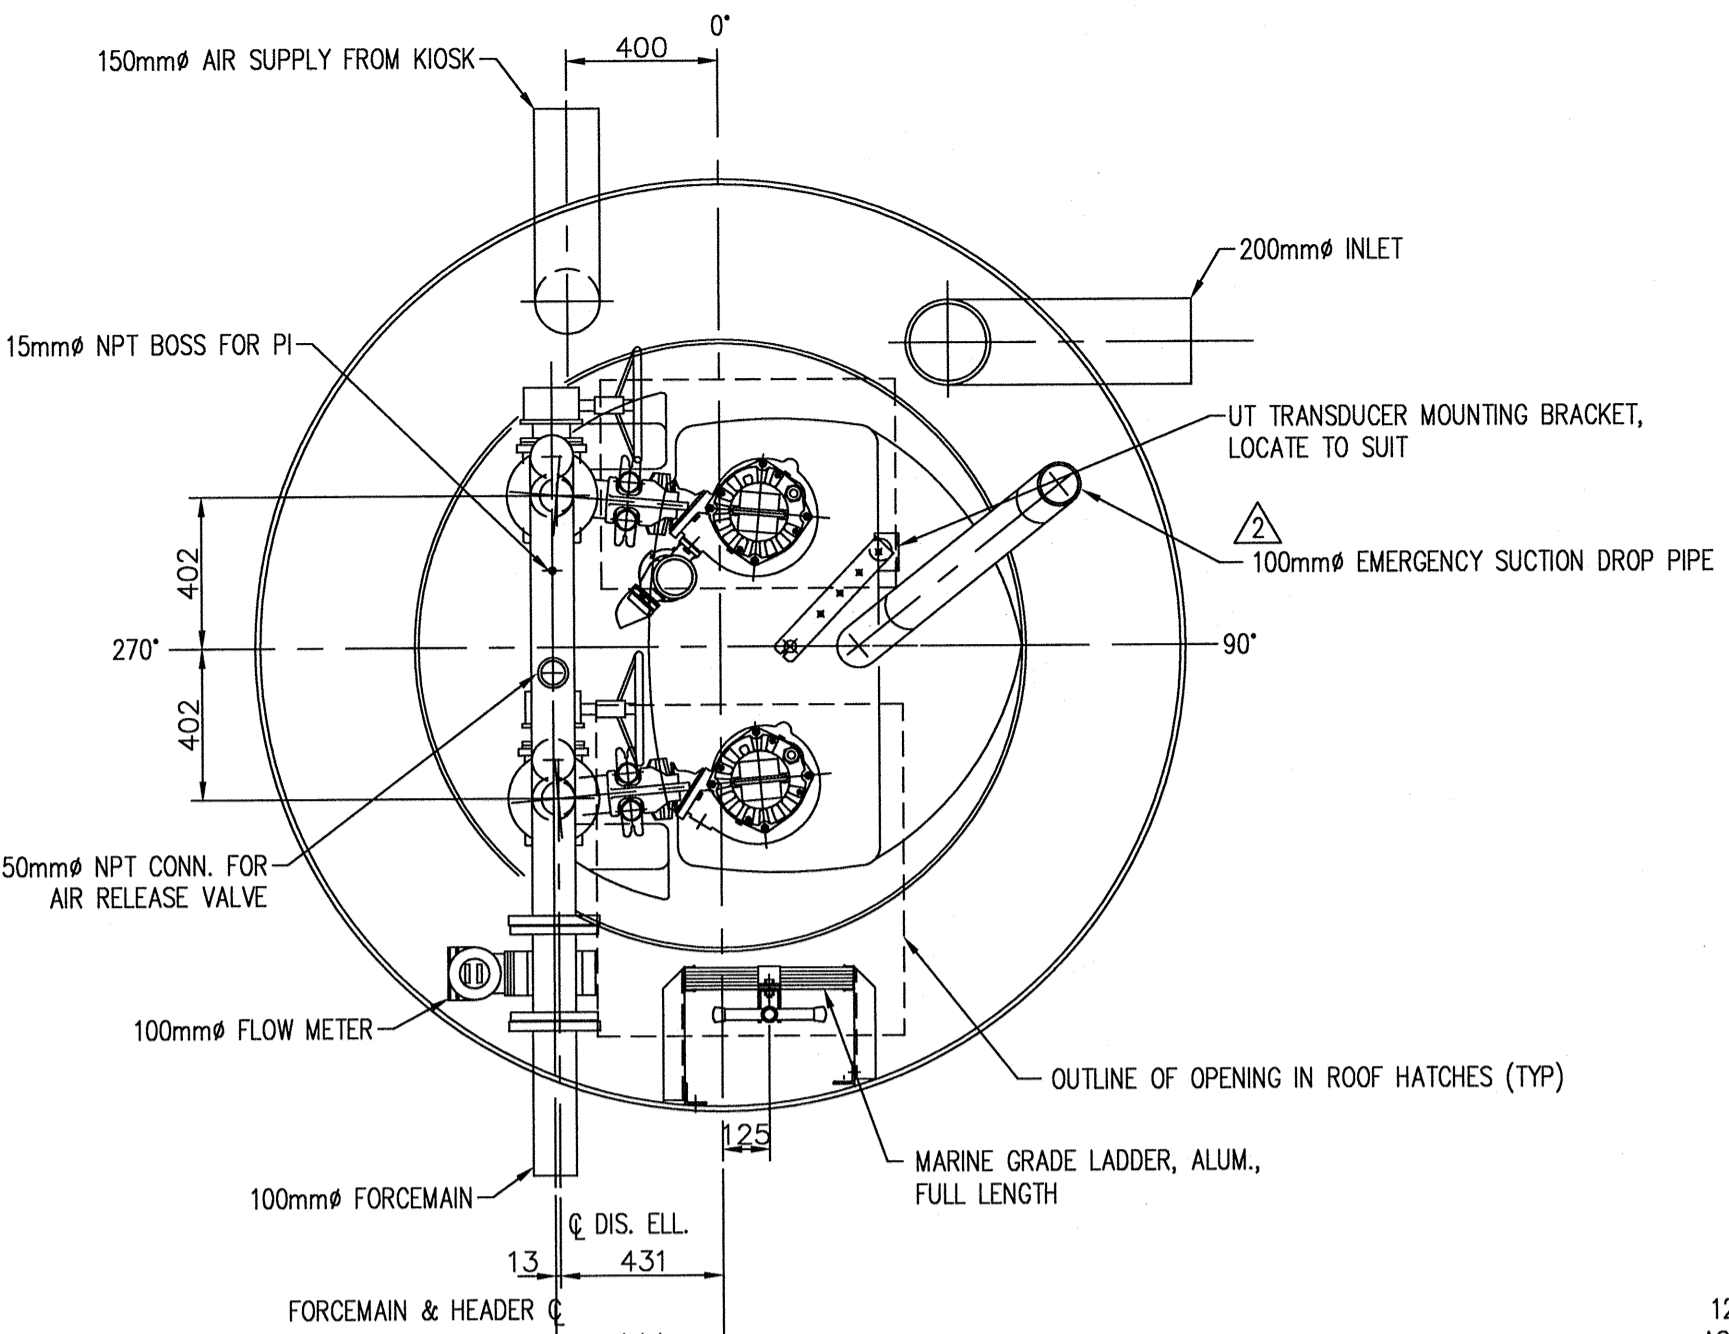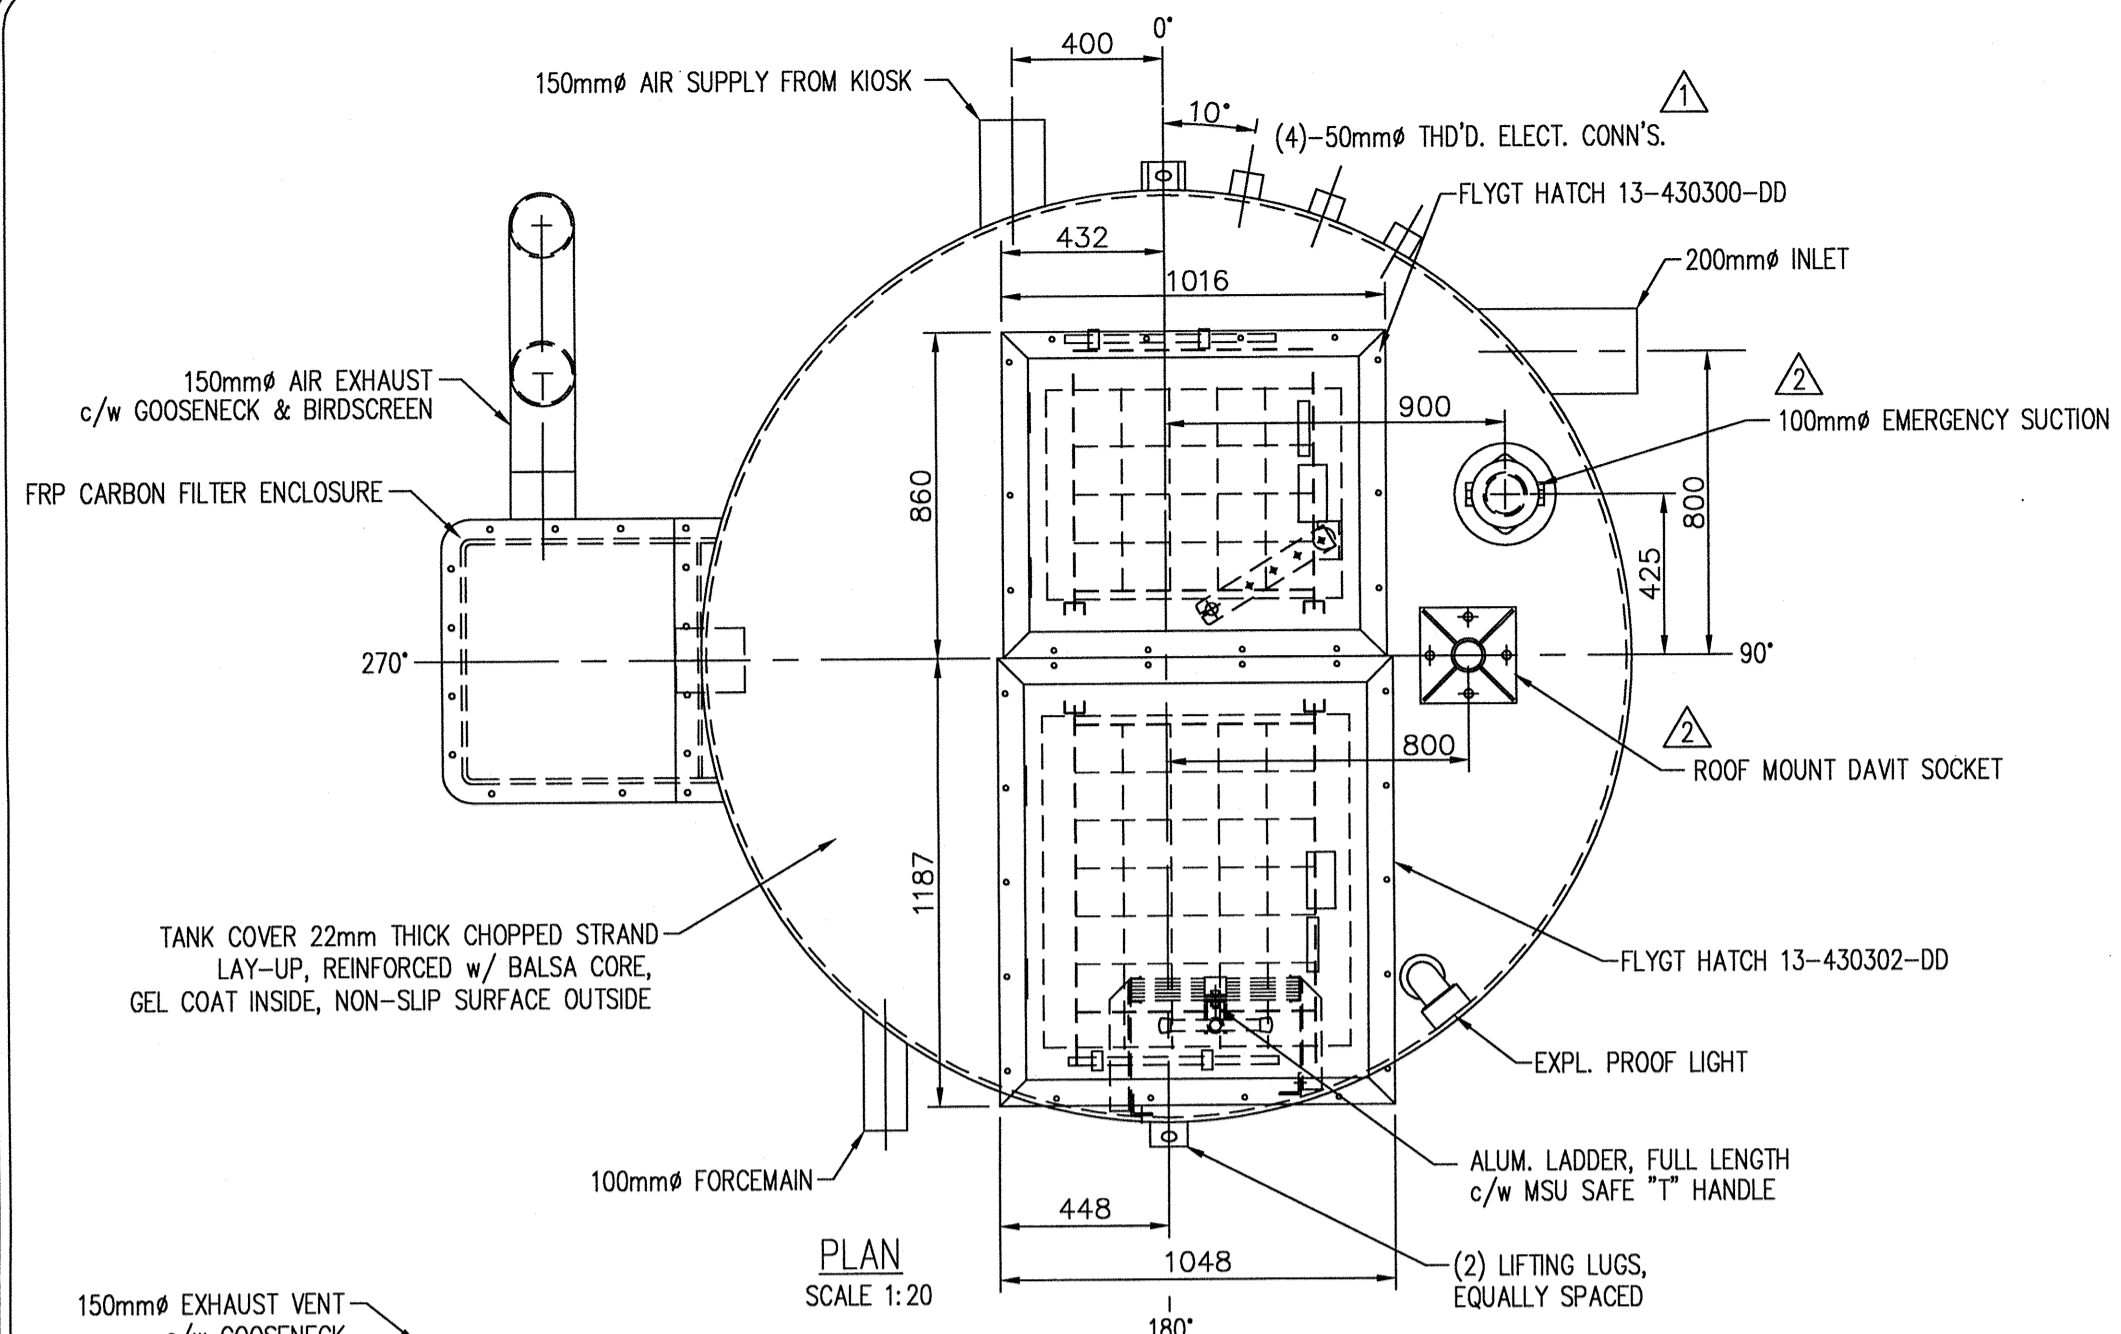

PROPOSED OPERATING LEVELS	
H/M (MILLITRONICS)	485.16m
H/M (FLOAT)	485.06m
LAG PUMP START	484.96m
LEAD PUMP START	484.76m
PUMP STOP	484.00m
L/W (FLOAT)	483.70m

BILL OF MATERIALS	
QTY	DESCRIPTION
6	HOLD DOWN LUGS, EPOXY COATED MS
2	LIFTING LUGS, EPOXY COATED MS
1	MARINE GRADE SAFETY LADDER, ALUMINUM, FULL LENGTH c/w MSU SAFE "T" HANDLE
1	200mm INLET, FRP, MACHINED c/w INTERNAL TEE & DROP PIPE
1	100mm FORCEMAIN, FRP, MACHINED c/w (2)-100mm RISERS, FRP x FL; (4)-80mm 45° ELL, FRP; (2)-80x100mm ECC. REDUCER, FRP; (1)-100mm LR 90° ELL, FLXFRP; (1)-100mm STR. TEE, FRP;FRP;FL; (2)-100mm-150° FF FLANGE, FRP;
	(1)-15mm NPT BOSS FOR PI.; (1)-50mm NPT CONN. FOR AIR RELEASE
1	100mm EMERGENCY SUCTION, FRP, c/w DROP PIPE & 100mm CAMLOCK FITTING
1	150mm AIR SUPPLY, FRP, c/w DROP PIPE
1	150mm AIR EXHAUST, FRP c/w CARBON FILTER ENCLOSURE (FILTER MEDIA BY OTHERS)
4	50mm THD'D. ELECTRICAL CONNECTION
8	20mm PUMP BASE BOLTS, 304 SS
4	20mm GUIDE BARS, GALV.
1	INTERMEDIATE PLATFORM, c/w ALUMINUM SUPPORT MEMBERS & FRP GRATING PANELS
1	UT TRANSDUCER MOUNTING BRACKET, ALUM.
1	EXPLOSION PROOF LIGHT, COOPER CROUSE-HINDS HAZGUARD EXACTA MODEL IPEH, WALL MOUNT, 150W, 120V/60Hz, CLEAR GLASS GLOBE, SS GUARD
1	FLYGT ALUMINUM ACCESS HATCH, 13-430302-DD, GAS ASSIST (BY FLYGT)
1	FLYGT ALUMINUM ACCESS HATCH, 13-430300-DD, GAS ASSIST (BY FLYGT)
2	UPPER GUIDE BAR SUPPORTS (BY FLYGT)
2	PUMP NP 3085 MT DN80 c/w DISCHARGE ELBOW FOR T.O.P. BASE (BY FLYGT)
2	100mm FLG'D. SINKING BALL CHECK VALVE, HDL 5087 (BY FLYGT)
2	100mm FLG'D PLUG VALVE, VALMATIC CAMCENTRIC, 5808N (BY FLYGT)
1	HORIZONTAL LEVEL REGULATOR HANGER & (2) ENM BULBS (BY FLYGT)
1	AIR RELEASE VALVE c/w ISO VALVE (BY FLYGT)
1	100mm FLG'D MAGFLOW METER, SIEMENS SITRANS FM3 5100W OR EQUAL (BY FLYGT)
1	PRESSURE GAUGE & STOP COCK (BY FLYGT)
1	ROOF MOUNT LIFTING DAWT SOCKET (810mm REACH) (BY FLYGT)
6	22mm ANCHOR BOLTS, MS (BY OTHERS)

FABRICATION DESIGN STANDARDS

- FLYGT SPECIFICATION GE-1008-04, REVISION MAY 2002
- AMEC 45-10.01 MANUFACTURE AND INSTALLATION FOR FRP STRUCTURES
- AMEC 45-10.02 FRP PRESSURE PIPE, FITTINGS AND FLANGES

GENERAL NOTES

- WINDING ANGLE - 75°
- TANK WALL - VARIES, SEE ELEVATION VIEW
- LINER - C-GLASS VEIL AND (2)-1 1/2 oz. MATT
- RESIN - ISOPHTHALIC
- EXTERIOR (ABOVE GRADE) TO HAVE DARK GREEN GELCOAT
- INTERIOR FINISH: WHITE ISOPHTHALIC NPG GELCOAT
- DIMENSIONS ARE IN MILLIMETERS U.N.O.
- SHIPPING WEIGHT: 2910 kg (6400 LBS)

INSTALLATION PROCEDURES

THE FOLLOWING RECOMMENDATIONS ARE BASED ON FLYGT EXPERIENCE AND ARE IN NO WAY MEANT TO REPLACE THE ENGINEER'S INSTRUCTIONS OR SPECIFICATIONS AND MUST BE USED IN CONJUNCTION WITH THE EXISTING AND ANTICIPATED CONDITIONS AT THE JOBSITE.

- USE THE LIFTING LUGS PROVIDED FOR VERTICAL HANDLING.
- USE SLINGS AROUND THE MAIN TANK FOR HORIZONTAL HANDLING.
- ENSURE UNIT IS STANDING VERTICAL ON CONCRETE PAD.
- BOLT UNIT FIRMLY AND SQUARELY IN PLACE, SHIM WHERE NECESSARY.
- FILL ANNULUS BETWEEN THE TANK SHELL AND OUTSIDE OF THE "T.O.P." SUMP WITH CONCRETE. AT THE SAME TIME ENCASE LOWER RIB IN CONCRETE TO A MINIMUM HEIGHT OF 150mm ABOVE RIB TO PROVIDE ANCHORAGE. REBAR TO CONNECT SECOND POUR TO CONCRETE BASE PAD.
- WHEN EXTERNAL VALVES ARE MOUNTED, SUPPORT PIPING CONNECTIONS DIRECT TO CONCRETE PAD.
- MAINTAIN A DRY SITE UNTIL BACKFILLING OPERATIONS COMMENCE.
- USE A GOOD QUALITY SCREENING OR SAND AS BACKFILL MATERIAL TO 90% COMPACTION.
- PLACE THE BACKFILL IN EQUAL INCREMENTS NOT EXCEEDING 300mm THICK AROUND THE STATION TO PREVENT UNBALANCED LOADS BEING IMPOSED DURING BACKFILLING OPERATIONS. PROGRESSIVELY TAMP BACKFILL AROUND STATION TO FULL HEIGHT TO REDUCE SETTLEMENT TO AN ABSOLUTE MINIMUM.

REV	DATE	DESCRIPTION	BY
3	2012/04/03	PLAN OF RECORD	
2	2011/07/29	CHANGED DAWT SOCKET; MOVED EMERGENCY SUCTION ON ROOF	LMc
1	2011/07/15	ADDED (1) ELECTRICAL CONNECTION	LMc
0	2011/06/21	ISSUED FOR APPROVAL	LMc

TOLERANCES (U.N.O.)	
LINEAR	ANGULAR
x ± 1.5	x x ± 1/2°

B BARKSI INDUSTRIES (1985) LTD. 2378 WESTLAKE RD. KELOWNA, B.C. V2Z 2V2

NOTICE: THIS DRAWING HAS NOT BEEN PUBLISHED AND IS THE SOLE PROPERTY OF BARKSI INDUSTRIES (1985) LTD. AND IS LENT TO THE BORROWER FOR HIS CONFIDENTIAL USE ONLY, AND IN CONSIDERATION OF THE LOAN OF THIS DRAWING, THE BORROWER PROMISES AND AGREES TO RETURN IT UPON REQUEST AND AGREES THAT IT SHALL NOT BE REPRODUCED, COPIED, LENT OR OTHERWISE DISPOSED OF DIRECTLY OR INDIRECTLY, NOR USED FOR ANY PURPOSE OTHER THAN THAT FOR WHICH IT WAS FURNISHED.

CLIENT	ITT W&W COQUITLAM, B.C.	ENGINEER	STANTEC CONSULTING LTD.
--------	-------------------------	----------	-------------------------

PROJECT: GLENROSA SEWER - PHASE 3
INVERNESS ROAD SANITARY LIFT STATION

TITLE: 2438.4mm I.D. INVERNESS ROAD LIFT STATION


ENG BY:	DATE:	CAD FILE:	PROJECT:
LMc	2011/06/20	Inverness	
APP BY:	DATE:	SCALE:	AS SHOWN
		DRAWING NUMBER	11-122
ISSUED BY:	DATE:		

"Please note that it is the user's responsibility to confirm the accuracy of the as-constructed information shown on this drawing before proceeding with any work (i.e. design or construction) that is based on that information."


NOTE: SEE PLAN VIEW FOR TRUE ORIENTATION

NOTE: CONCRETE SHOWN FOR ILLUSTRATIVE PURPOSES ONLY. FOUNDATION TO BE DESIGNED & SUPPLIED BY OTHERS.

PROPOSED OPERATING LEVELS	
HWL (MILLITRONICS)	477.31m
HWL (FLOAT)	477.21m
LAG PUMP START	477.11m
LEAD PUMP START	476.91m
PUMP STOP	476.72m
LWL (FLOAT)	476.42m

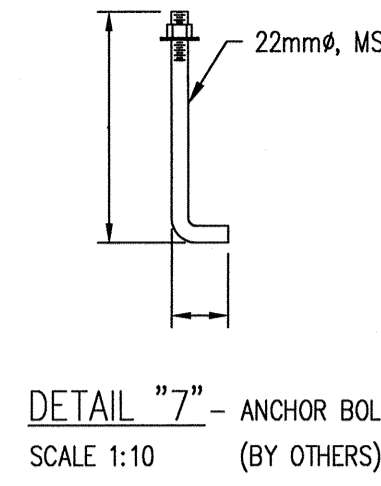


"Please note that it is the user's responsibility to confirm the accuracy of the as-constructed information shown on this drawing before proceeding with any work (i.e. design or construction) that is based on that information."

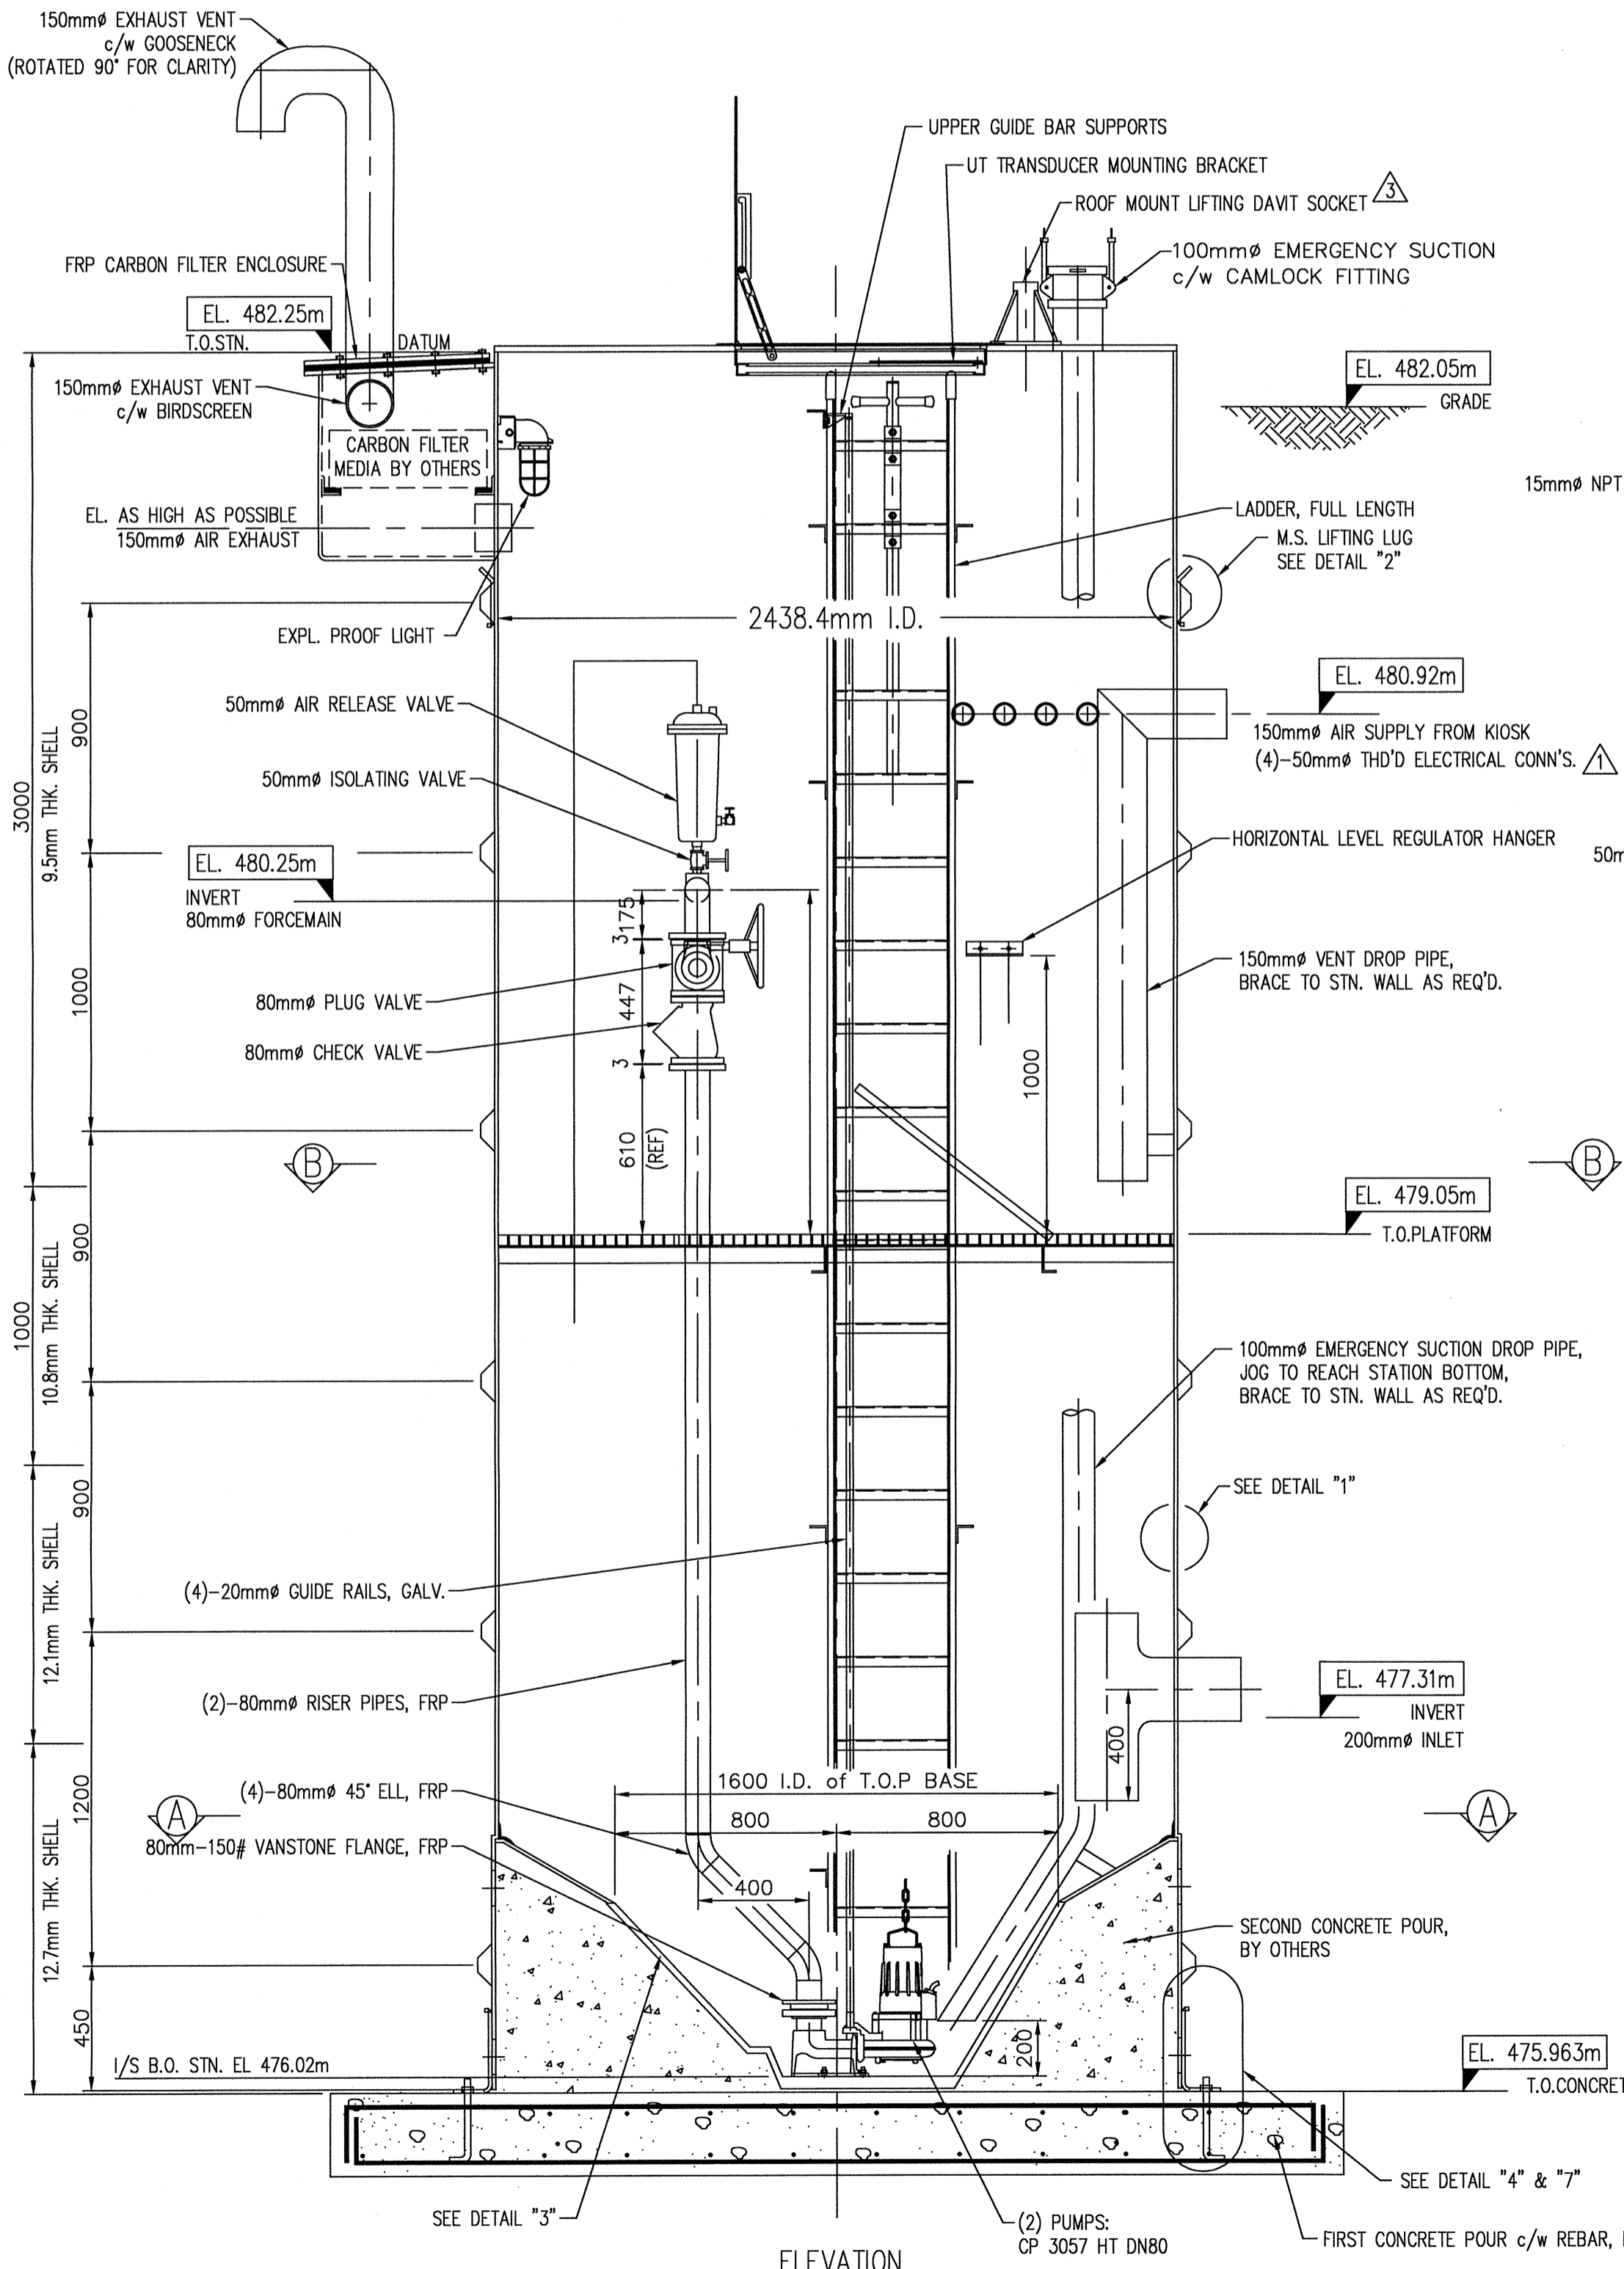


ELEVATION SCALE 1:20
NOTE: SEE PLAN VIEW FOR TRUE ORIENTATION


NOTE: CONCRETE SHOWN FOR ILLUSTRATIVE PURPOSES ONLY. FOUNDATION TO BE DESIGNED & SUPPLIED BY OTHERS.

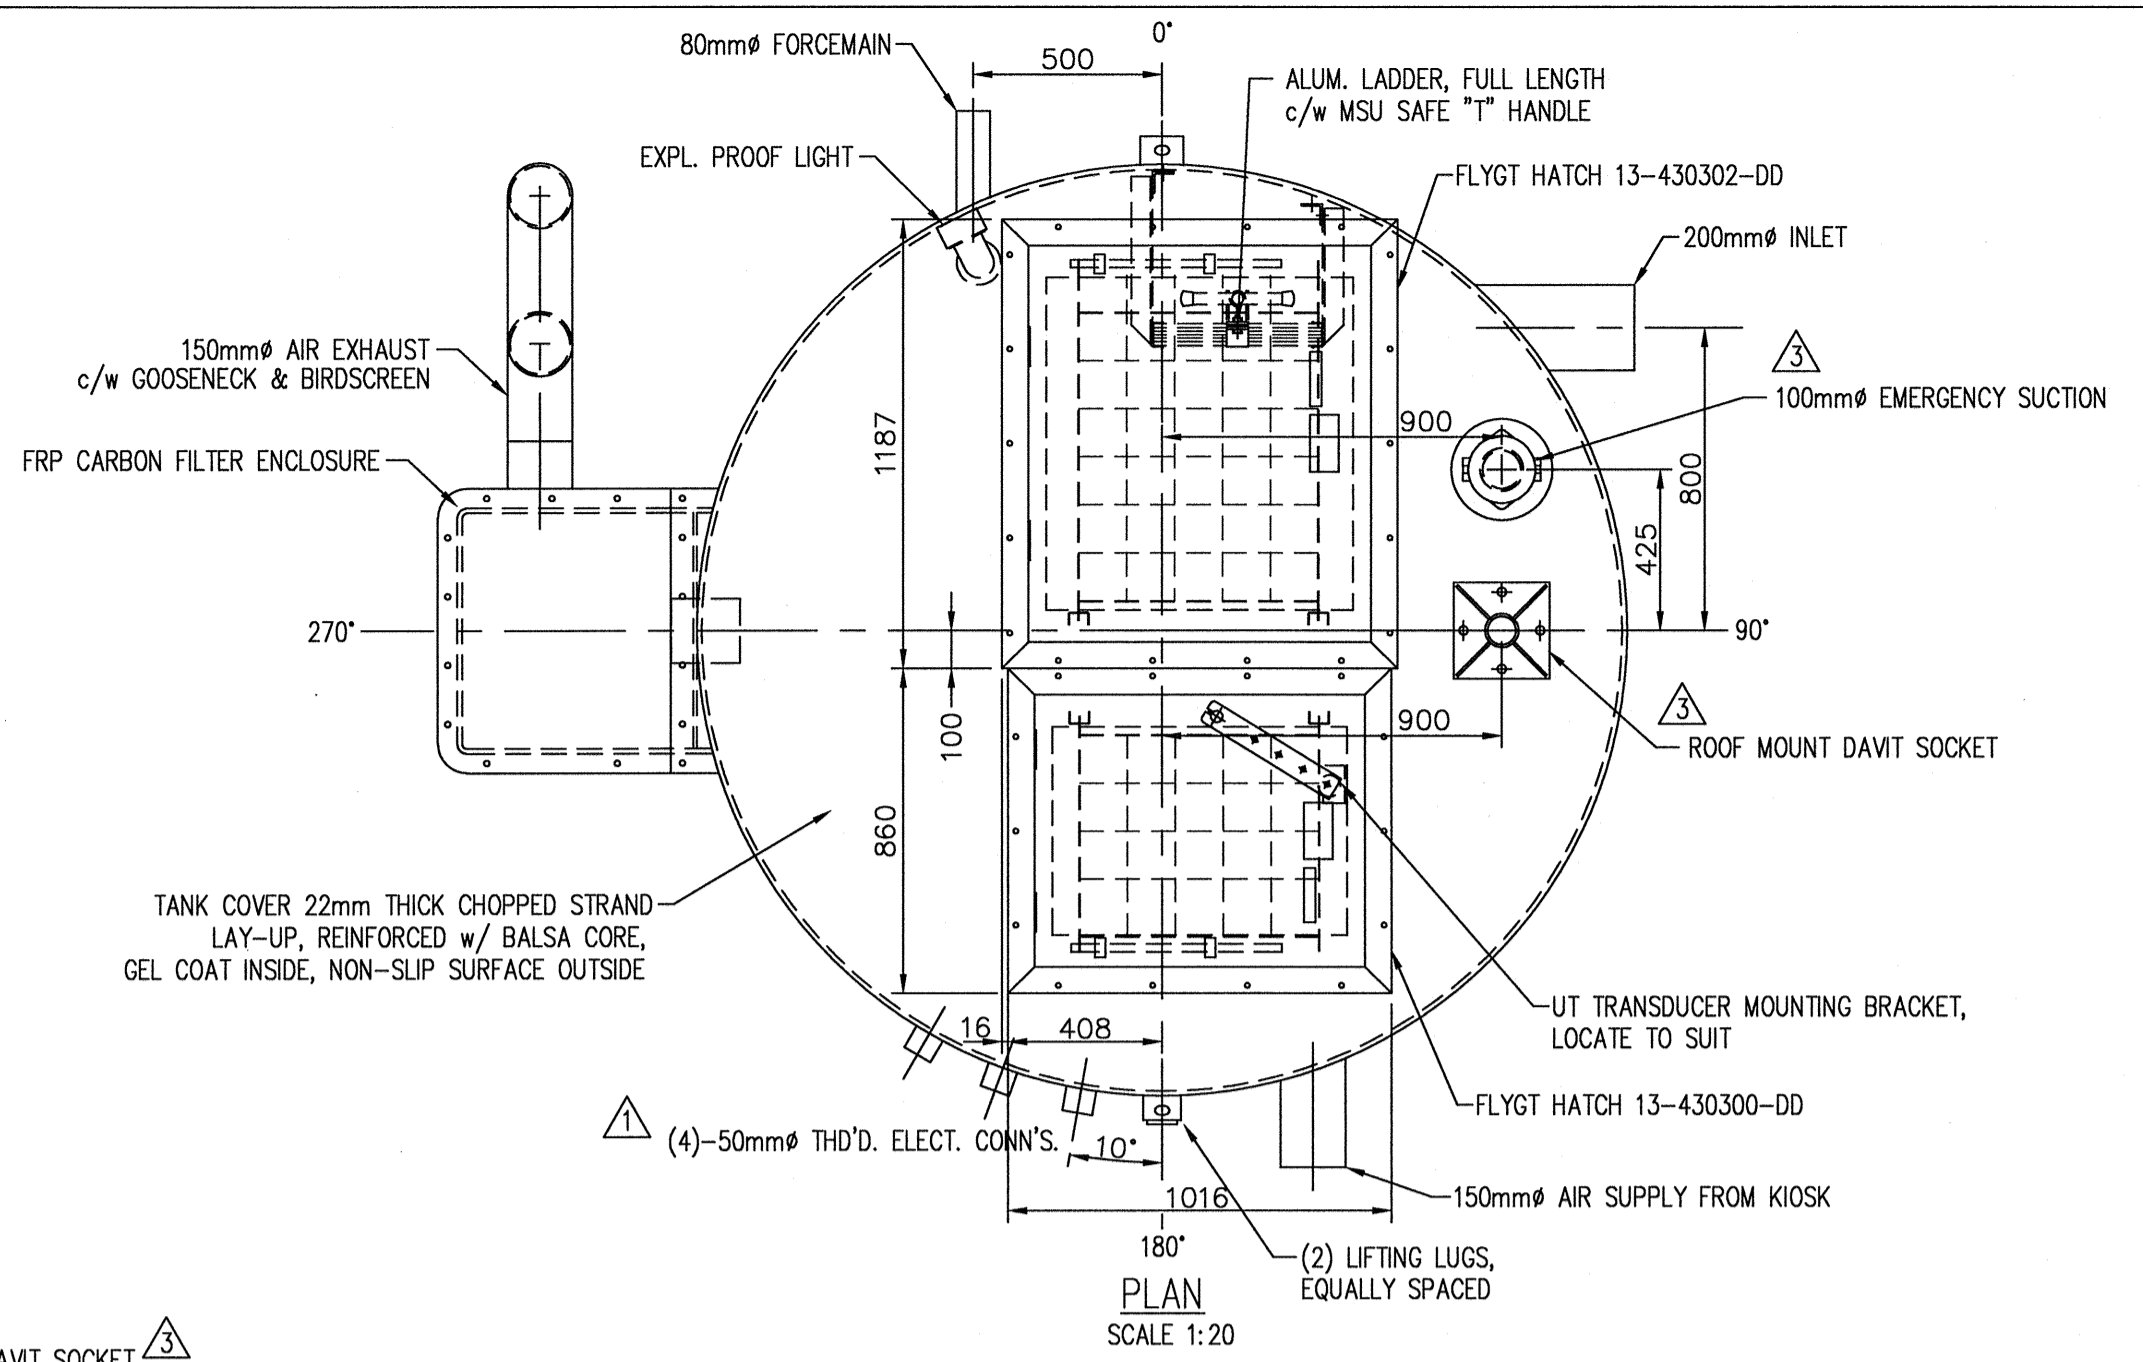

PLAN SCALE 1:20

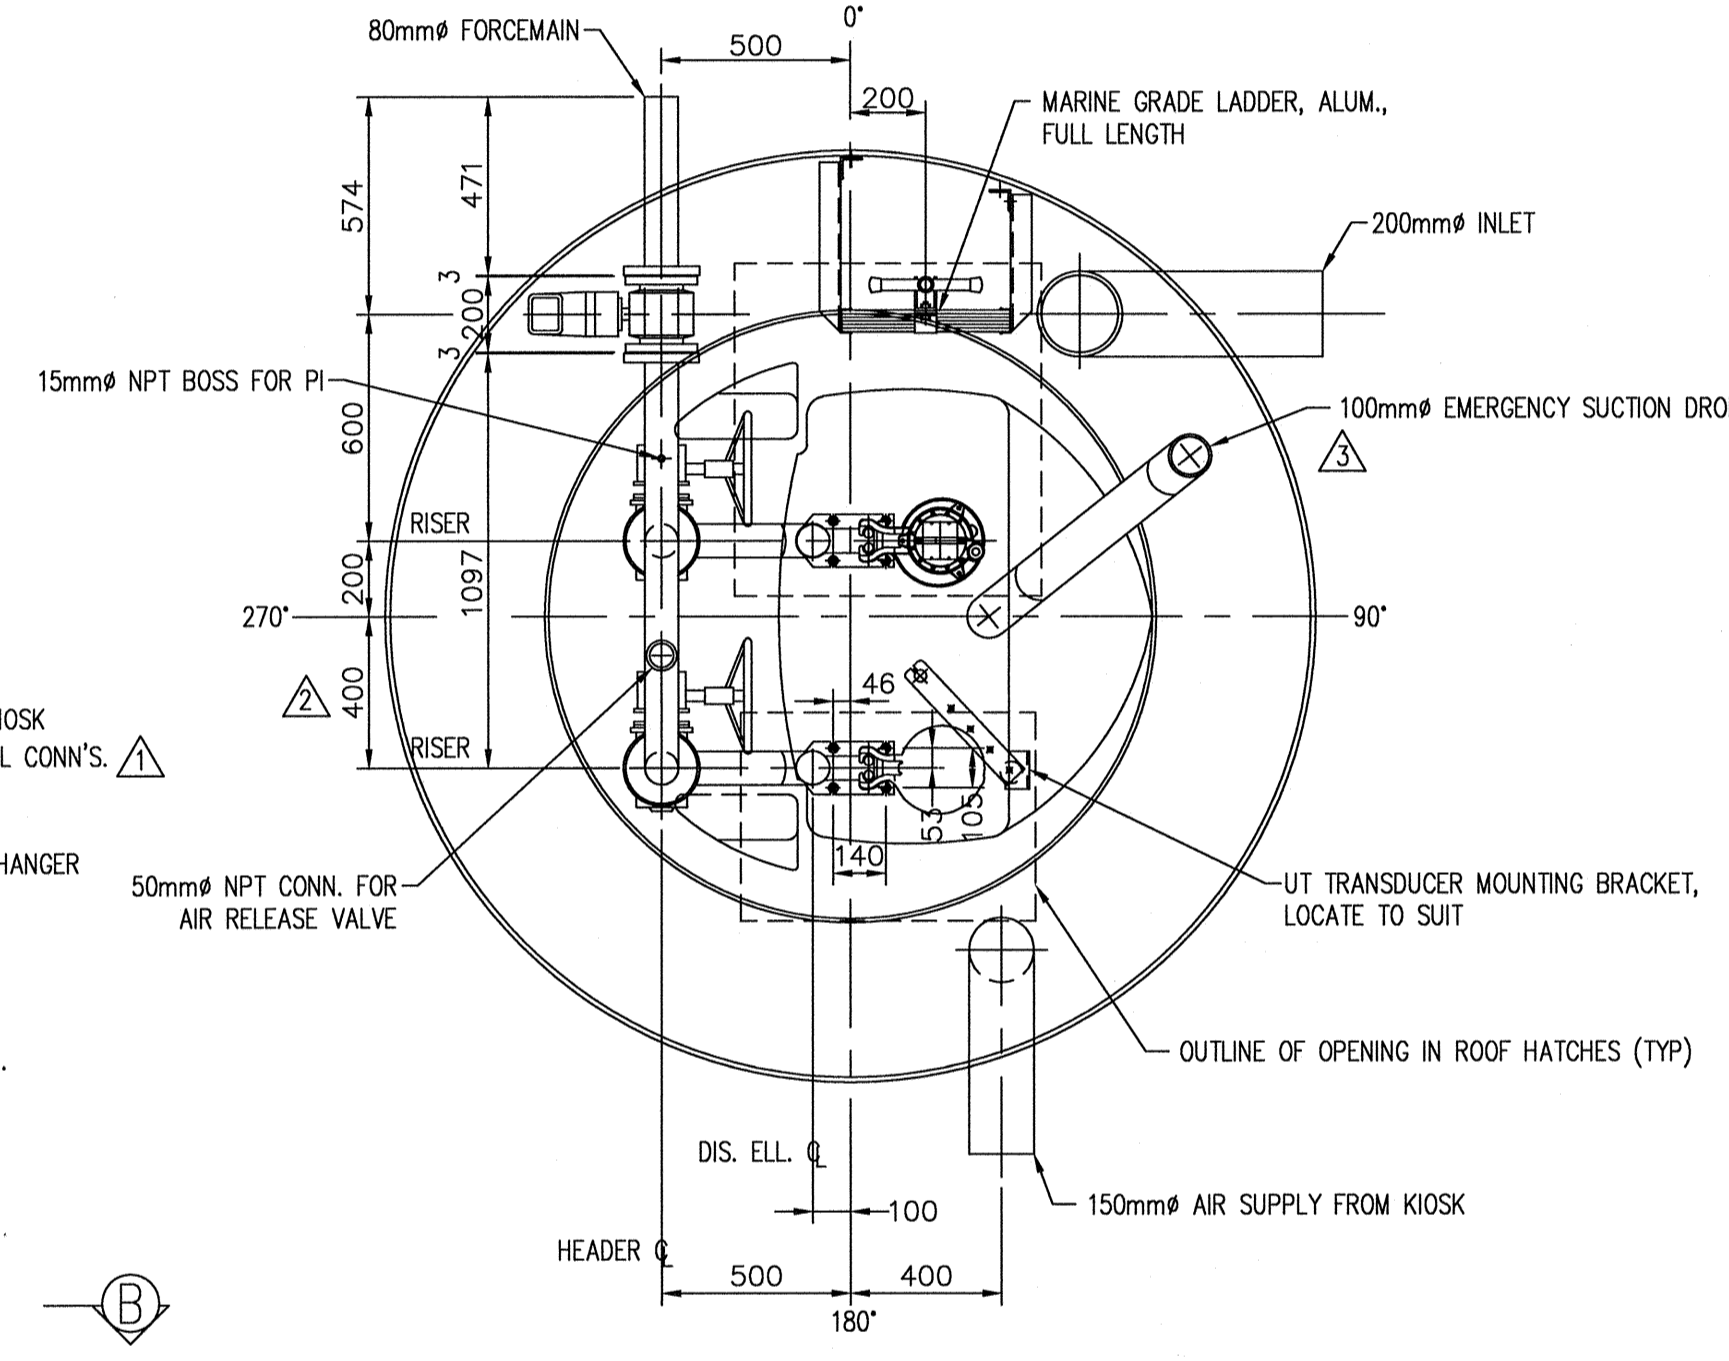


SECTION 'A-A' - PUMPS LAYOUT SCALE 1:20

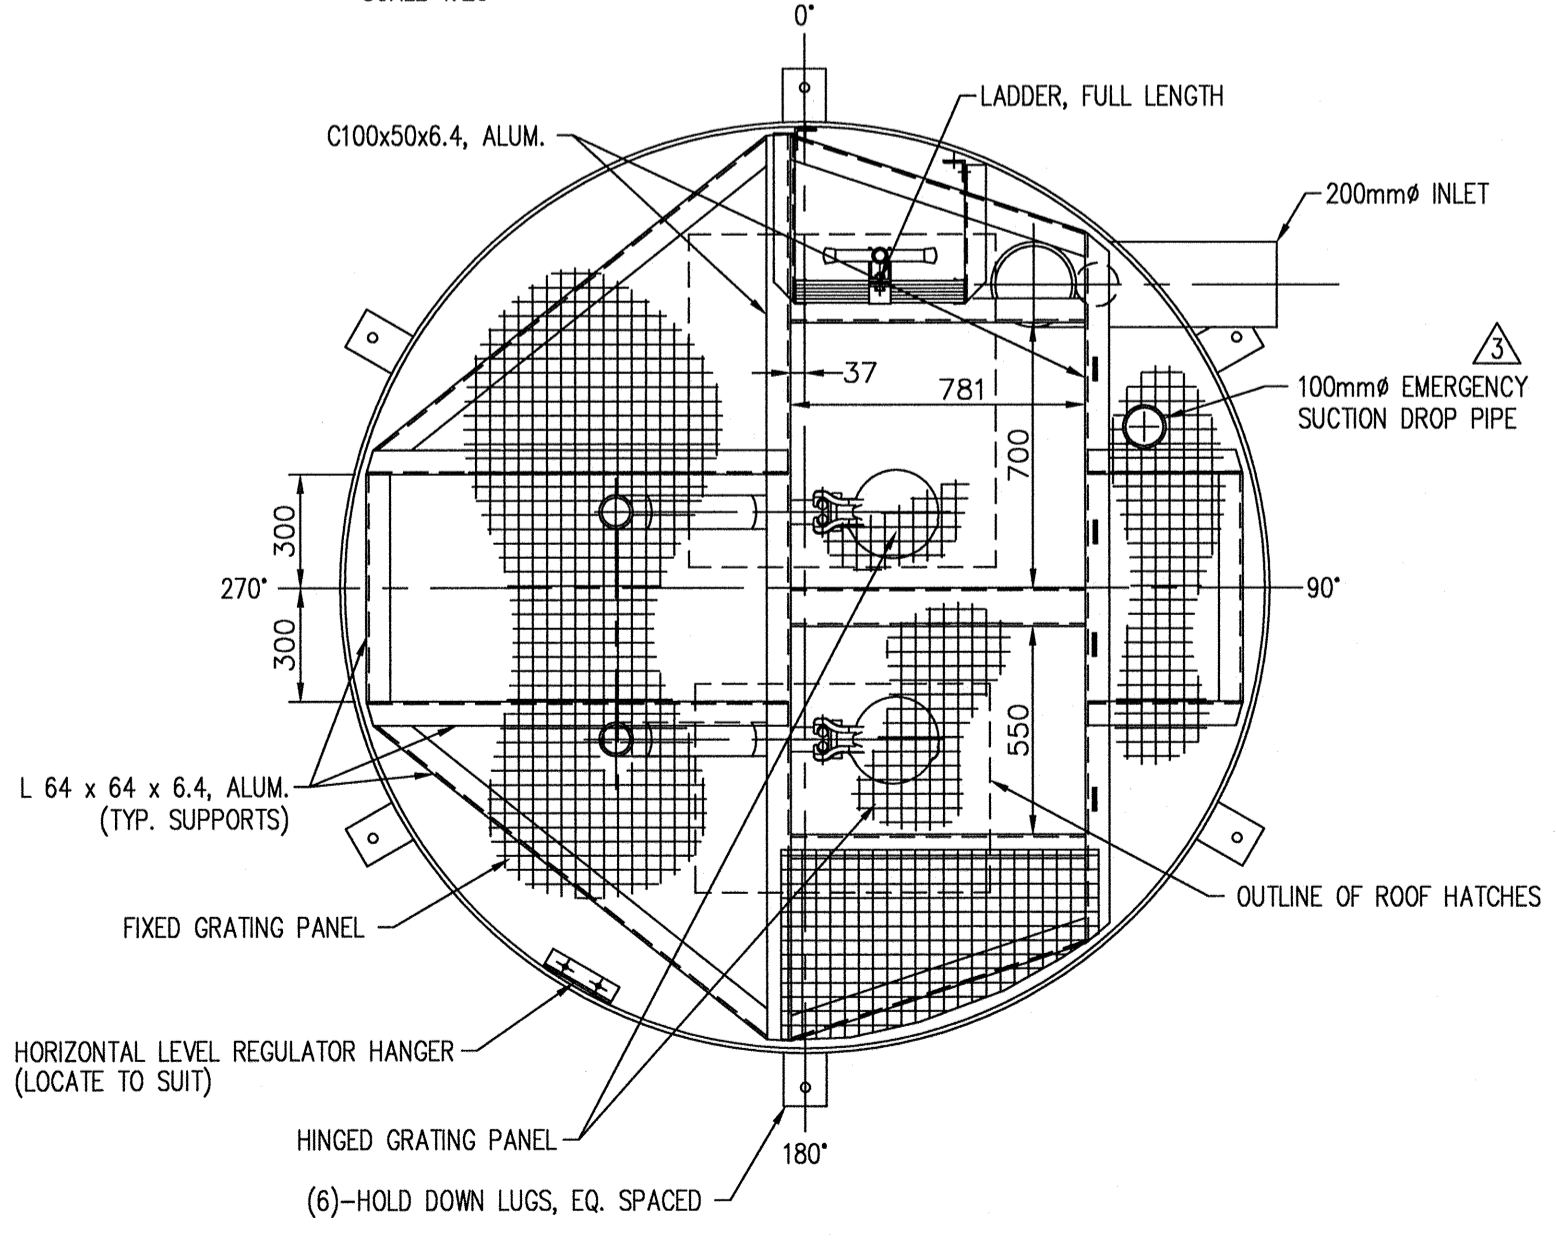


SECTION 'B-B' - PLATFORM LAYOUT SCALE 1:20


NOTES:
1. ALL GRATING PANELS TO BE 38 x 38 x 38 HIGH FRP
2. ALL SUPPORTS TO BE ALUMINUM

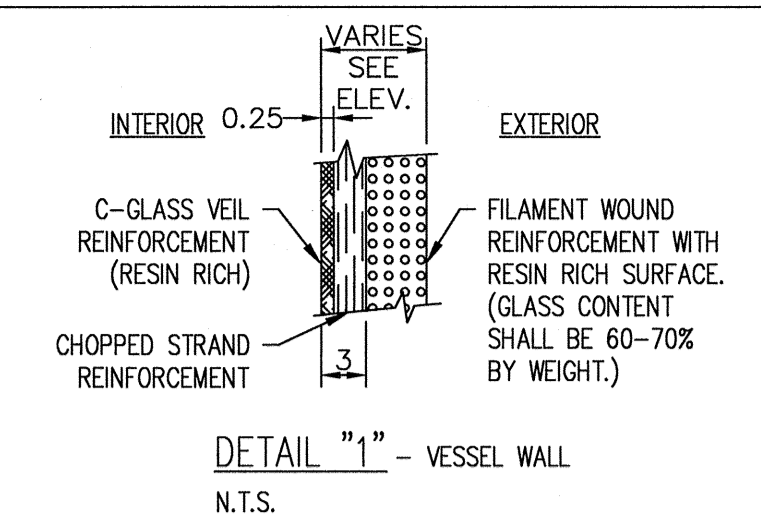


DETAIL '1' - VESSEL WALL N.T.S.

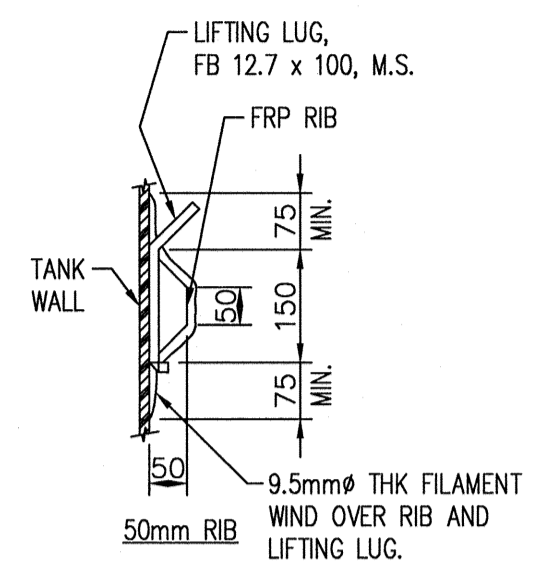


DETAIL '2' - LIFTING LUG SCALE 1:10

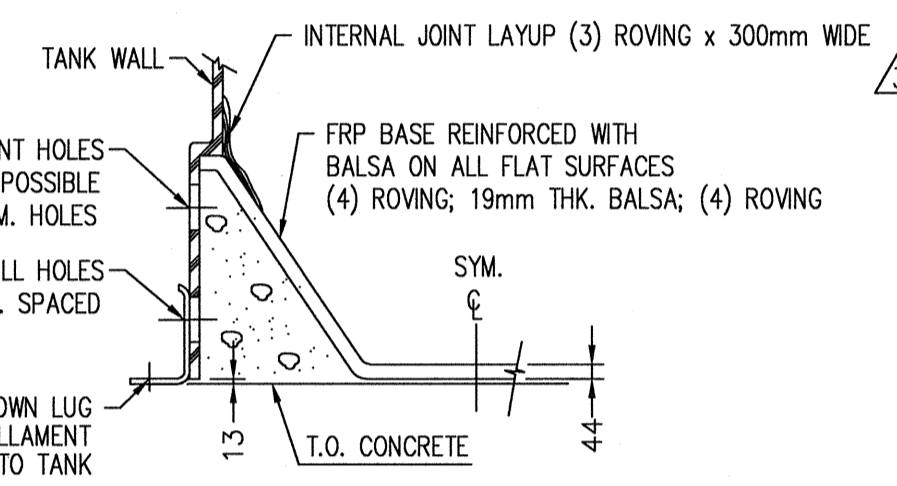

DETAIL '3' - BOTTOM BASE N.T.S.

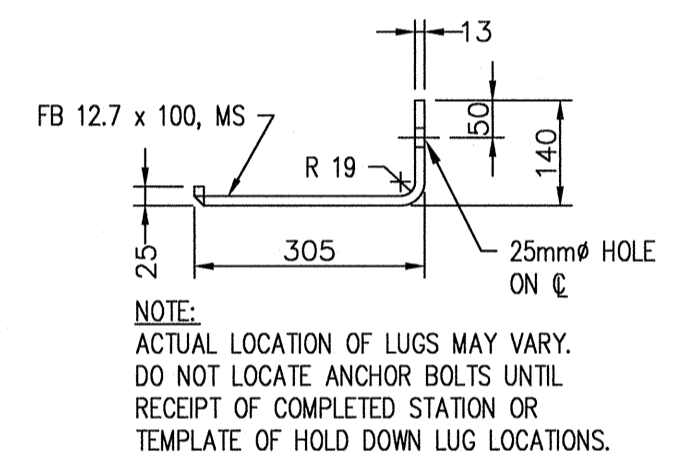

DETAIL '4' - HOLD DOWN LUG SCALE 1:10

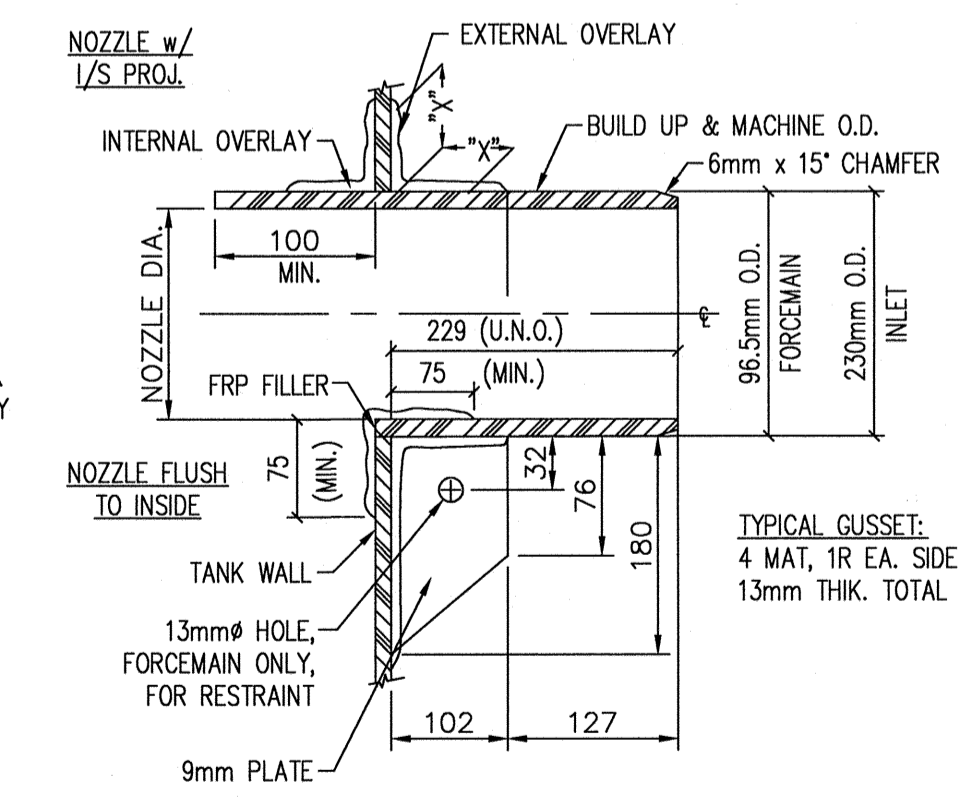

NOZZLE NOTES
A MINIMUM OF 2 LAYERS OF WOVEN ROVING IS REQUIRED FOR NOZZLE PORTION OF OVERLAY. TANK PORTION OF OVERLAY SHALL BE SAME THICKNESS AS TANK WALL DIMENSION 'X' SHALL BE GREATER THAN ONE HALF THE NOZZLE DIAMETER. INTERNAL OVERLAY TO HAVE A MINIMUM OF 2 LAYERS MATT. FRP REINFORCING MATERIAL TO BE CUT TO A SHAPE TO ENSURE A SMOOTH LAMINATE.
O.D.'s REPRESENT THICKNESSES REQUIRED FOR ADEQUATE NOZZLE STRENGTH. TO BE CONNECTED TO EXTERIOR PIPING WITH A ROBAR TRANSITION COUPLER OR EQUAL.

DETAIL '5' - TYPICAL NOZZLE, MACHINED N.T.S.

BILL OF MATERIALS

QTY	DESCRIPTION	BY
6	HOLD DOWN LUGS, EPOXY COATED MS	
2	LIFTING LUGS, EPOXY COATED MS	
1	MARINE GRADE SAFETY LADDER, ALUMINUM, FULL LENGTH c/w MSU SAFE 'T' HANDLE	
1	200mm INLET, FRP, MACHINED c/w INTERNAL TEE & DROP PIPE	
1	80mm FORCEMAIN, FRP, MACHINED c/w (2)-80mm RISERS, VAN x FL; (2)-80mm THD' NIPPLE; (2)-80mm-150# THD' FLG, CS; (2)-80mm 45° ELL, FRP; (1)-80mm LR 90° ELL, FLx FRP; (1)-80mm STR. TEE, FRP; (4)-80mm-150# FF FLG, FRP; (1)-15mm NPT BOSS FOR P.I.; (1)-50mm NPT CONN. FOR AIR RELEASE	
1	100mm EMERGENCY SUCTION, FRP, c/w DROP PIPE & 100mm CAMLOCK FITTING	
1	150mm AIR SUPPLY, FRP, c/w DROP PIPE	
1	150mm AIR EXHAUST, FRP c/w CARBON FILTER ENCLOSURE (FILTER MEDIA BY OTHERS)	
4	50mm THD'D. ELECTRICAL CONNECTION	
8	12mm PUMP BASE BOLTS, 304 SS	
4	20mm GUIDE BARS, GALV.	
1	INTERMEDIATE PLATFORM, c/w ALUMINUM SUPPORT MEMBERS & FRP GRATING PANELS	
1	UT TRANSDUCER MOUNTING BRACKET, ALUM.	
1	EXPLOSION PROOF LIGHT, COOPER CROUSE-HINDS HAZGUARD EXACTA MODEL IPEH, WALL MOUNT, 150W, 120V/60Hz, CLEAR GLASS GLOBE, SS GUARD	
1	FLYGT ALUMINUM ACCESS HATCH, 13-430302-DD, GAS ASSIST (BY FLYGT)	
1	FLYGT ALUMINUM ACCESS HATCH, 13-430300-DD, GAS ASSIST (BY FLYGT)	
2	UPPER GUIDE BAR SUPPORTS (BY FLYGT)	
2	PUMP CP 3057 HT DN80 c/w DISCHARGE ELBOW FOR T.O.P. BASE (BY FLYGT)	
2	80mm FLG'D. SINKING BALL CHECK VALVE, HDL 5087 (BY FLYGT)	
2	80mm FLG'D PLUG VALVE, VALMATIC CAMCENTRIC, 5808N (BY FLYGT)	
1	HORIZONTAL LEVEL REGULATOR HANGER & (2) EXM BULBS (BY FLYGT)	
1	AIR RELEASE VALVE c/w ISO VALVE (BY FLYGT)	
1	80mm FLG'D MAGFLOW METER, SIEMENS SITRANS FM3 5100W OR EQUAL (BY FLYGT)	
1	PRESSURE GAUGE & STOP COCK (BY FLYGT)	
1	ROOF MOUNT LIFTING DAVIT SOCKET (810mm REACH) (BY FLYGT)	
6	22mm ANCHOR BOLTS, MS (BY OTHERS)	

FABRICATION DESIGN STANDARDS

1. FLYGT SPECIFICATION GE-1008-04, REVISION MAY 2002
2. AMEC 4S-10.01 MANUFACTURE AND INSTALLATION FOR FRP STRUCTURES
3. AMEC 4S-10.02 FRP PRESSURE PIPE, FITTINGS AND FLANGES

GENERAL NOTES

1. WINDING ANGLE - 75°
2. TANK WALL - VARIES, SEE ELEVATION VIEW
3. LINER - C-GLASS VEIL AND (2)-1 1/2 oz. MATT
4. RESIN - ISOPHTHALIC
5. EXTERIOR (ABOVE GRADE) TO HAVE DARK GREEN GELCOAT
6. INTERIOR FINISH: WHITE ISOPHTHALIC NPG GELCOAT
7. DIMENSIONS ARE IN MILLIMETERS U.N.O.
8. SHIPPING WEIGHT: 3045 kg (6700 LBS)


INSTALLATION PROCEDURES

- THE FOLLOWING RECOMMENDATIONS ARE BASED ON FLYGT EXPERIENCE AND ARE IN NO WAY MEANT TO REPLACE THE ENGINEERS INSTRUCTIONS OR SPECIFICATIONS AND MUST BE USED IN CONJUNCTION WITH THE EXISTING AND ANTICIPATED CONDITIONS AT THE JOBSITE.
1. USE THE LIFTING LUGS PROVIDED FOR VERTICAL HANDLING.
 2. USE SLINGS AROUND THE MAIN TANK FOR HORIZONTAL HANDLING.
 3. ENSURE UNIT IS STANDING VERTICAL ON CONCRETE PAD.
 4. BOLT UNIT FIRMLY AND SQUARELY IN PLACE, SHIM WHERE NECESSARY.
 5. FILL ANNULUS BETWEEN THE TANK SHELL AND OUTSIDE OF THE "T.O.P." SUMP WITH CONCRETE. AT THE SAME TIME ENCASE LOWER RIB IN CONCRETE TO A MINIMUM HEIGHT OF 150mm ABOVE RIB TO PROVIDE ANCHORAGE. REBAR TO CONNECT SECOND POUR TO CONCRETE BASE PAD.
 6. WHEN EXTERNAL VALVES ARE MOUNTED, SUPPORT PIPING CONNECTIONS DIRECT TO CONCRETE PAD.
 7. MAINTAIN A DRY SITE UNTIL BACKFILLING OPERATIONS COMMENCE.
 8. USE A GOOD QUALITY SCREENING OR SAND AS BACKFILL MATERIAL TO 90% COMPACTION.
 9. PLACE THE BACKFILL IN EQUAL INCREMENTS NOT EXCEEDING 300mm THICK AROUND THE STATION TO PREVENT UNBALANCED LOADS BEING IMPOSED DURING BACKFILLING OPERATIONS. PROGRESSIVELY TAMP BACKFILL AROUND STATION TO FULL HEIGHT TO REDUCE SETTLEMENT TO AN ABSOLUTE MINIMUM.

REV	DATE	DESCRIPTION	BY
4	2012/04/03	PLAN OF RECORD	
3	2011/07/29	CHANGED DAVIT SOCKET; MOVED EMERGENCY SUCTION ON ROOF	LMc
2	2011/07/27	PUMP RELOCATION	LMc
1	2011/07/15	ADDED (1) ELECTRICAL CONNECTION	LMc
0	2011/06/21	ISSUED FOR APPROVAL	LMc

TOLERANCES (U.N.O.)

LINEAR	ANGULAR
X ± 1.5	X.X ± 1/2°

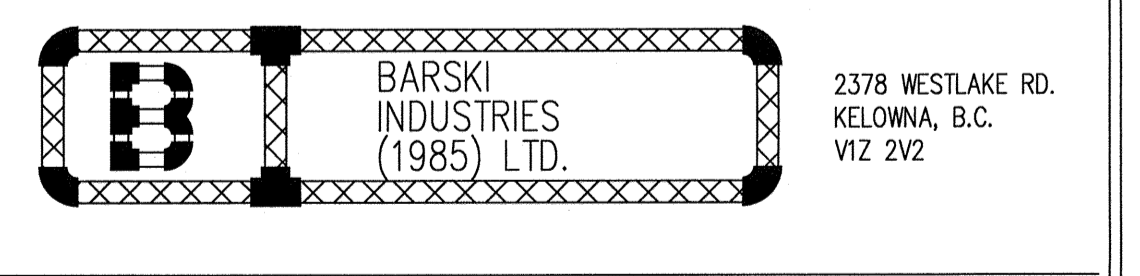

NOTICE: THIS DRAWING HAS NOT BEEN PUBLISHED AND IS THE SOLE PROPERTY OF BARKSI INDUSTRIES (1985) LTD. AND IS LOANED TO THE BORROWER FOR HIS CONFIDENTIAL USE ONLY, AND IN CONSIDERATION OF THE LOAN OF THIS DRAWING, THE BORROWER PROMISES AND AGREES TO RETURN IT UPON REQUEST AND AGREES THAT IT SHALL NOT BE REPRODUCED, COPIED, LENT OR OTHERWISE DISPOSED OF DIRECTLY OR INDIRECTLY, NOR USED FOR ANY PURPOSE OTHER THAN THAT FOR WHICH IT WAS FURNISHED.

CLIENT	ENGINEER
ITT W&W COQUITLAM, B.C.	STANTEC CONSULTING LTD.
PROJECT: GLENROSA SEWER - PHASE 3 GLENGARRY ROAD SANITARY LIFT STATION	
TITLE: 2438.4mm I.D. GLENGARRY ROAD LIFT STATION	
ENG BY: LMc	DATE: 2011/06/15
CAD BY: LMc	DATE: 2011/06/15
APP BY:	DATE:
ISSUED BY:	DATE:
CAD FILE: GLENGARRY	PROJECT:
SCALE: AS SHOWN	PROJECT:
DRAWING NUMBER	PROJECT:
11-121	PROJECT:




PERFORMANCE CURVE

PRODUCT	TYPE
CP3057.181	HT

DATE	PROJECT	CURVE NO	ISSUE
2011-06-13	GLENGARY LS 2	53-266-00-0164	2

MOTOR COS PHI	1/4-LOAD	3/4-LOAD	1/2-LOAD	MOTOR SHAFT POWER	2.3	hp	IMPELLER DIAMETER			
MOTOR EFFICIENCY	0.87	0.81	0.70	STARTING CURRENT ...	17	A	104 mm			
GEAR EFFICIENCY	—	—	—	RATED CURRENT ...	3.8	A	MOTORTYPE	STATOR	REV	
COMMENTS NEVACLOG	INLET/OUTLET			RATED SPEED	2700	rpm	13-08-2BB	01Y	10	
	-75 mm			TOT.MOM.OF INERTIA ...	—		FREQ.	PHASES	VOLTAGE	POLES
	IMP. THROUGHLET			NO. OF BLADES	1		50 Hz	3	400 V	2
	48 mm						GEARTYPE		RATIO	
						—		—		

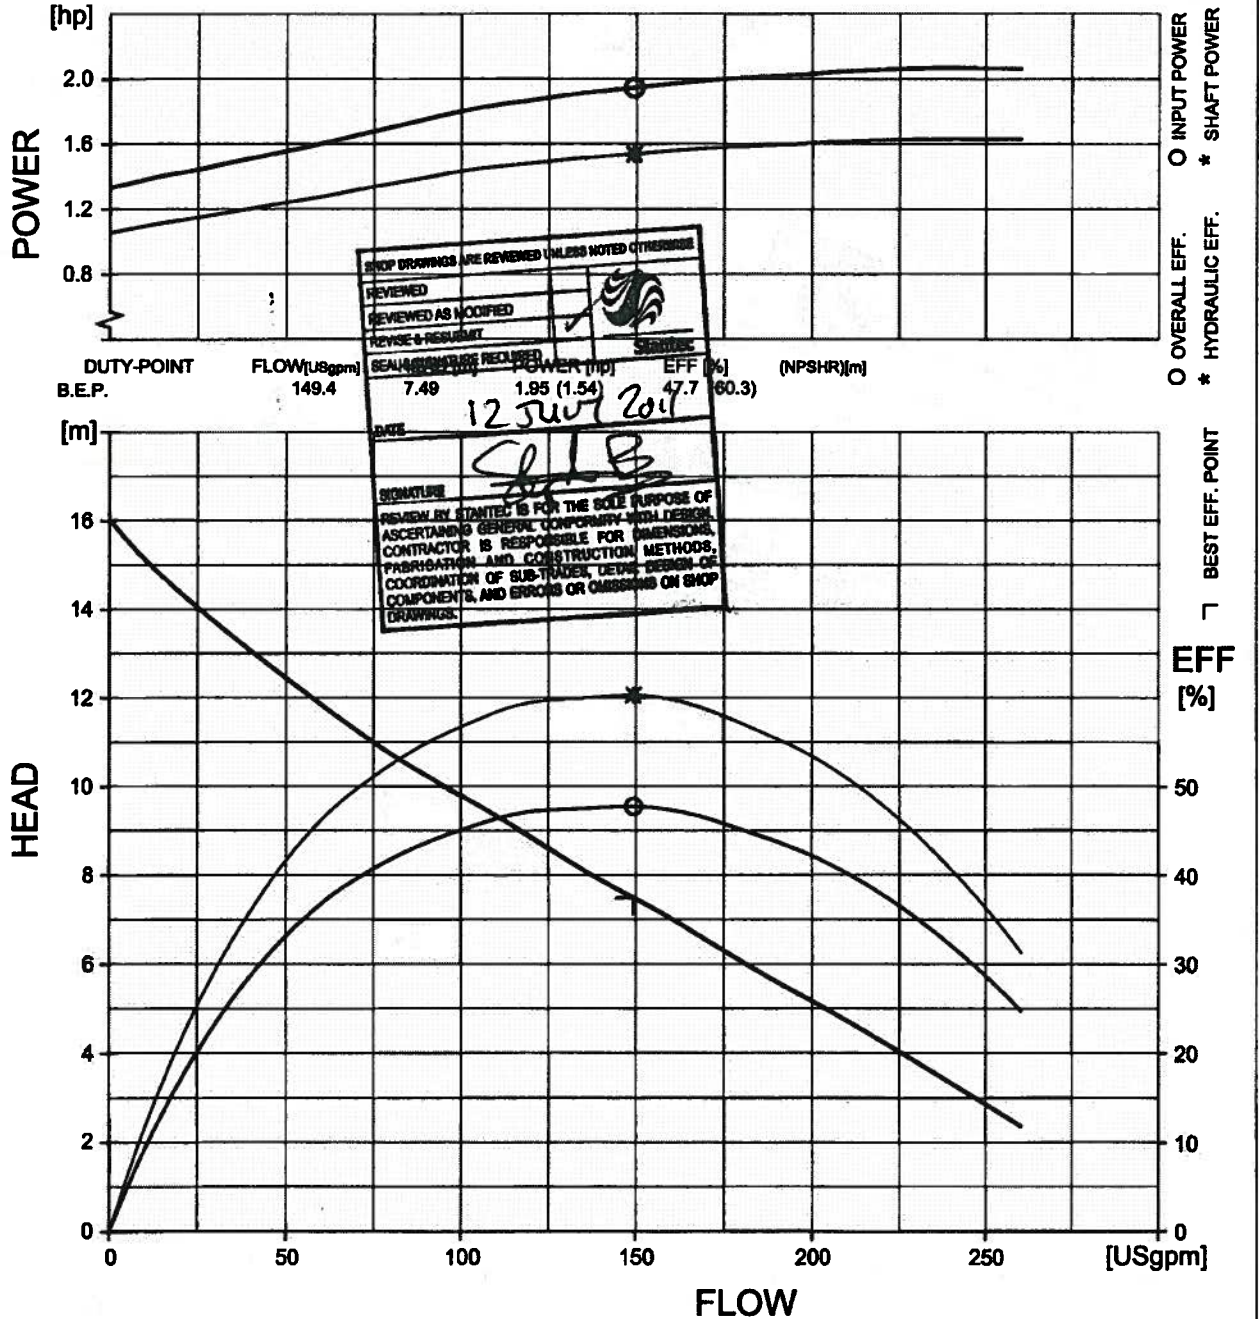

FLYPS3.1.6.6 (20090313)

Performance with clear water and rating data at 40 °C





District of West Kelowna

Sanitary Lift Station Evaluation

Station: Whitworth LS 3
Reviewed By: Jim Kentel

Year Constructed: 2000
Year Upgraded:

Matrix Rating			
(10 - highest rating)	Civil	31	
(1 - lowest rating)	Process Mechanical	149	
	Electrical Instrumentation	104	
	Total Station Rating	284	(max. rating 370 points)



Civil:**Matrix
Rating**

Parking Area:	_____	n/a
Drainage:	Good	10
Influent sewer:	Gravity 200	10
Site access:	Good	10
Water service:	No	1
		31





Process Mechanical:

Station type:	FRP 2.44m diameter	n/a
Number of pumps:	2	n/a
Pump Redundancy:	Yes	n/a
Pump Manufacturer / Type:	FLYGT Grinder	5
MP Pump Model:	3102HT	n/a
Rated Capacity:	4.0L/S @ 35.7m TDH	n/a
Capacity Confirmation:	_____	n/a
Forcemain pipe type / diameter:	PVC SDR26/100	10
Header pipe type / diameter:	75	18
Check valve type / diameter:	Sinking Ball HDL/75	18
Isolation valve type / diameter:	CI Plug Valve /75	18
Piping Condition:	_____	8
Emergency pumpout connection:	Yes/100	10
Pressure gauges:	No	1
Inlet bar screen:	No	1
Wetwell condition:	Good	8
Access Hatches:	MSU type M	10
Ladder / Platform:	Yes/FRP Grating	10
Wetwell benching:	Yes	10
Odour Control:	No	1
Ventilation:	Yes	10
Water washdown:	_____	1
Confined Space Entry Requirements	Davit	10
		149





Electrical / Instrumentation:

Matrix
Rating

Service Type	V / A / Phase / Wire	n/a
Pump 1 :	HP 6.0	n/a
	Volts/600 Rpm 3475	n/a
	FLA 5.7A	n/a
Starting Current	44.0A	n/a
Pump 2 :	HP 6.0	n/a
	Volts/600 Rpm 3475	n/a
	FLA 5.7A	n/a
Starting Current	44.0A	n/a
Alarm Functions:	Yes	10
		n/a
		n/a
		n/a
Receptacle	Yes	10
Interior Lighting:	Yes	10
Exterior Lighting:		1
SCADA / Telemetry:		5
Main Breaker:		10
Control Panel:		10
Lighting Panel:		10
Flowmeter:	No	1
Grounding:		10
Surge Protection:		10
UPS:	Yes	10
PLC:		1
Level Control:	FLYGT Bulbs Milltronics	5
Standby Generator:	No	1
		104
Comments:		

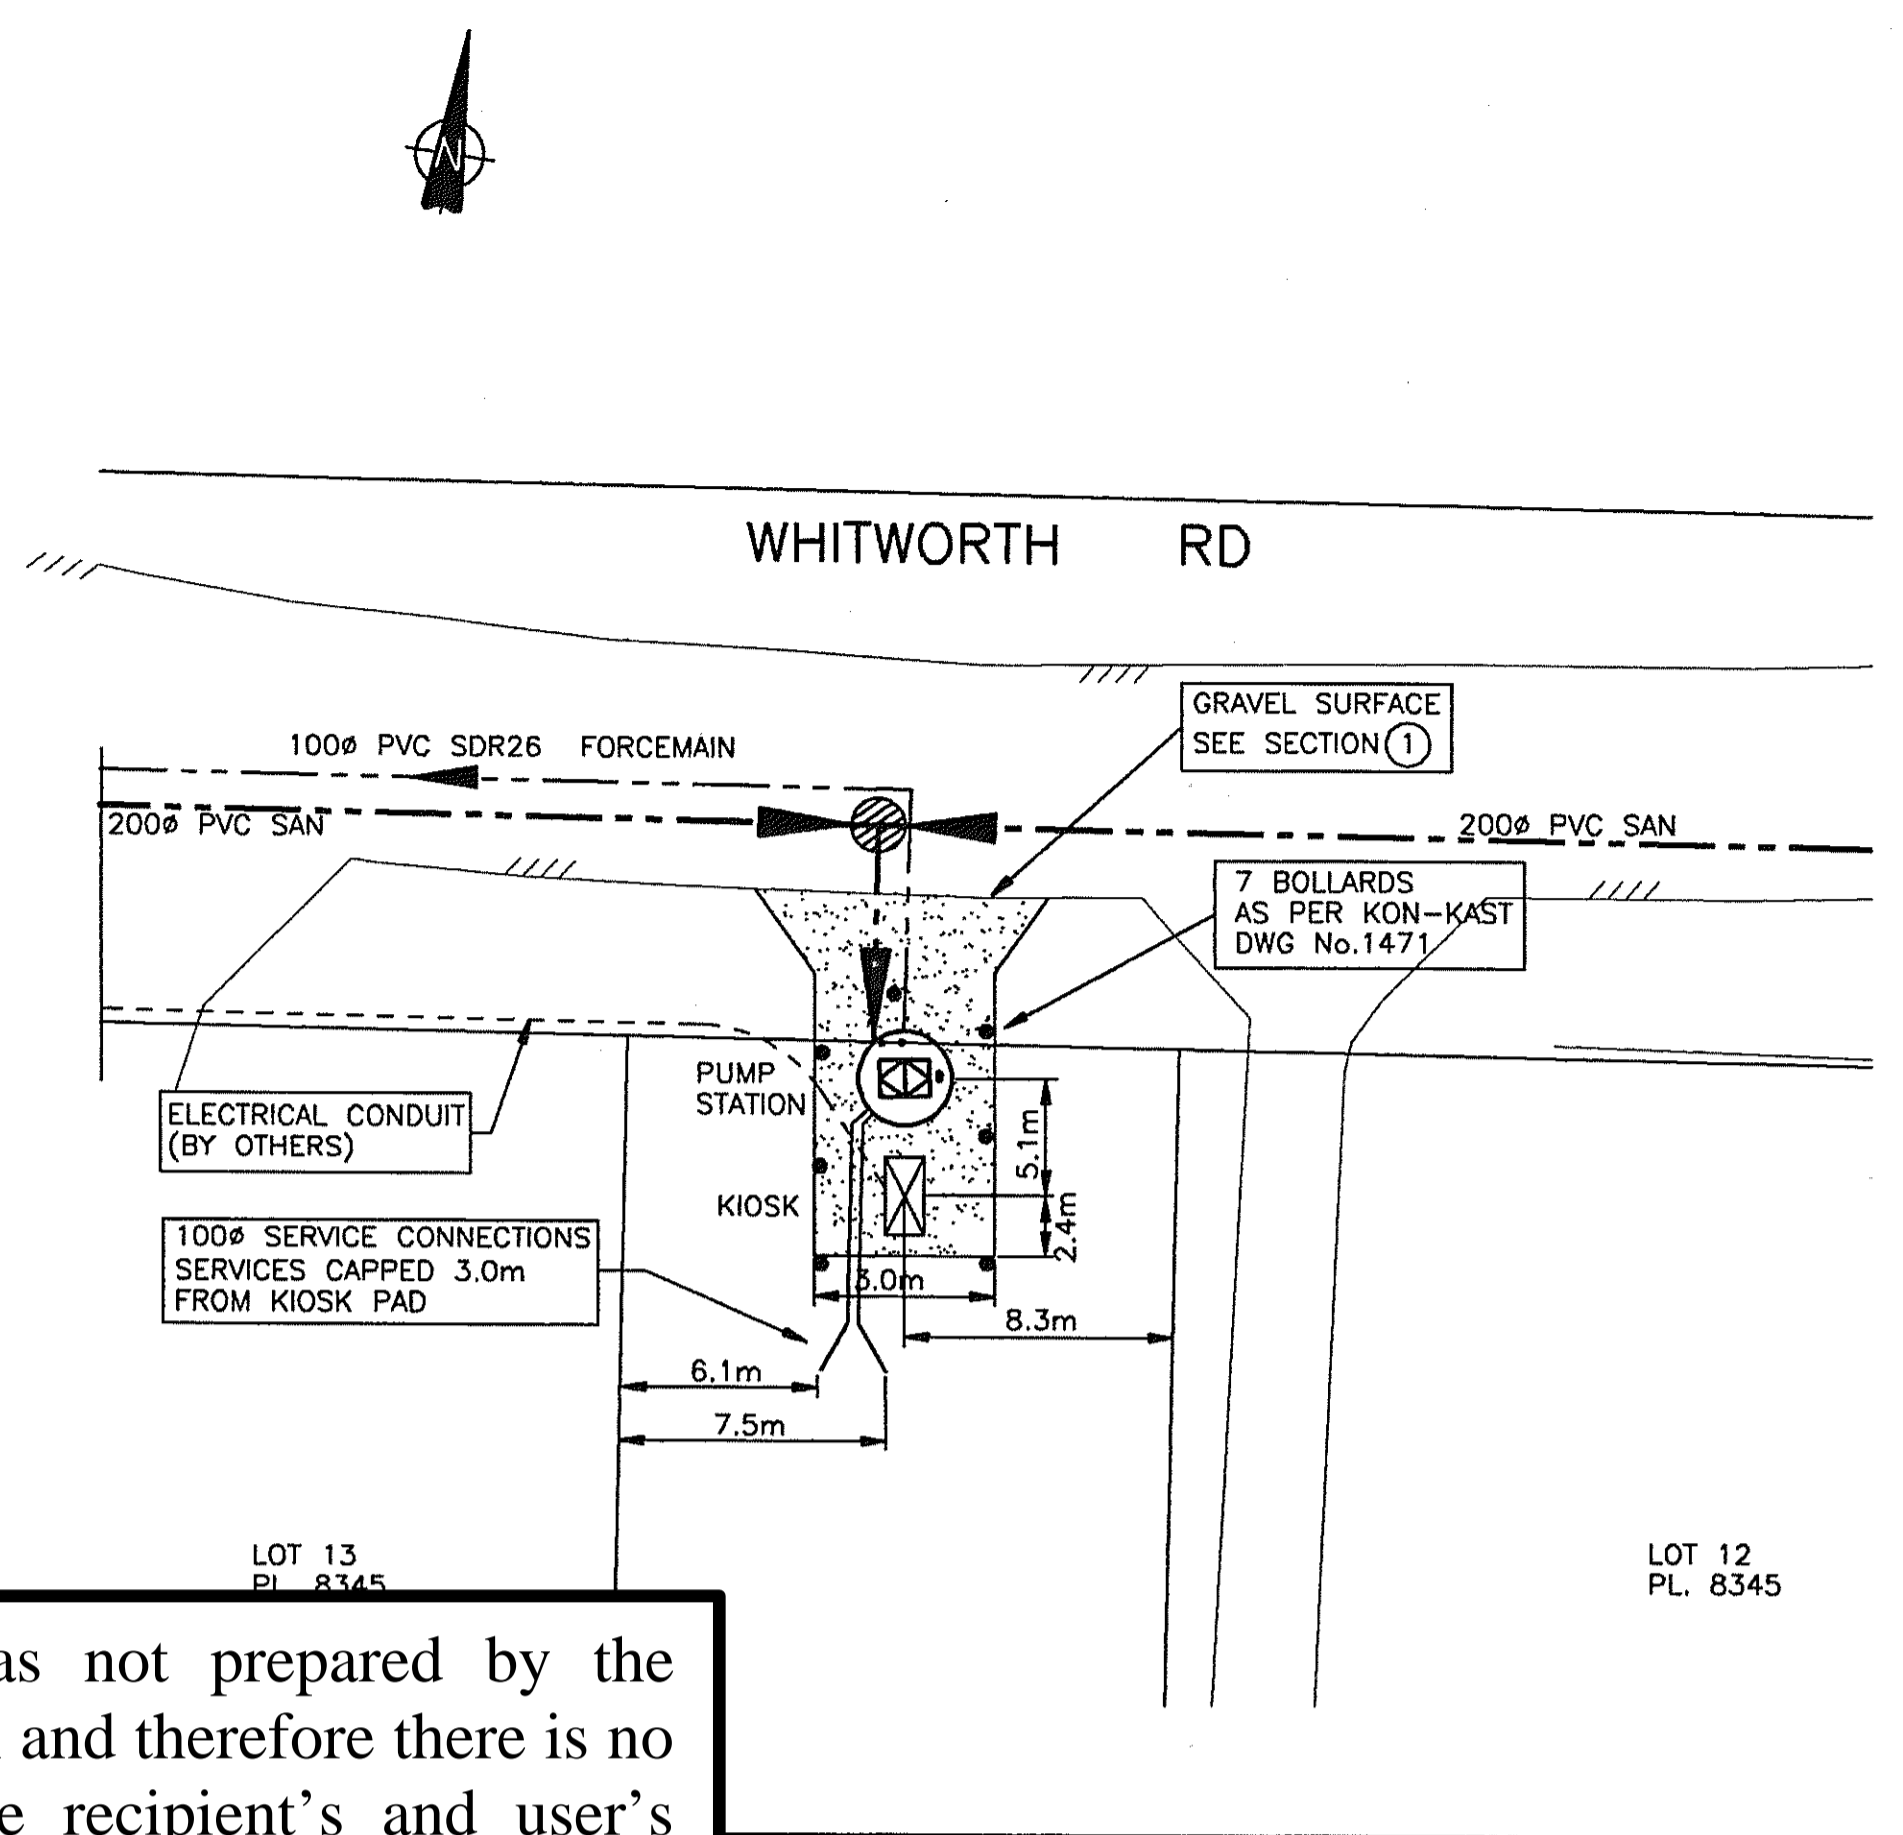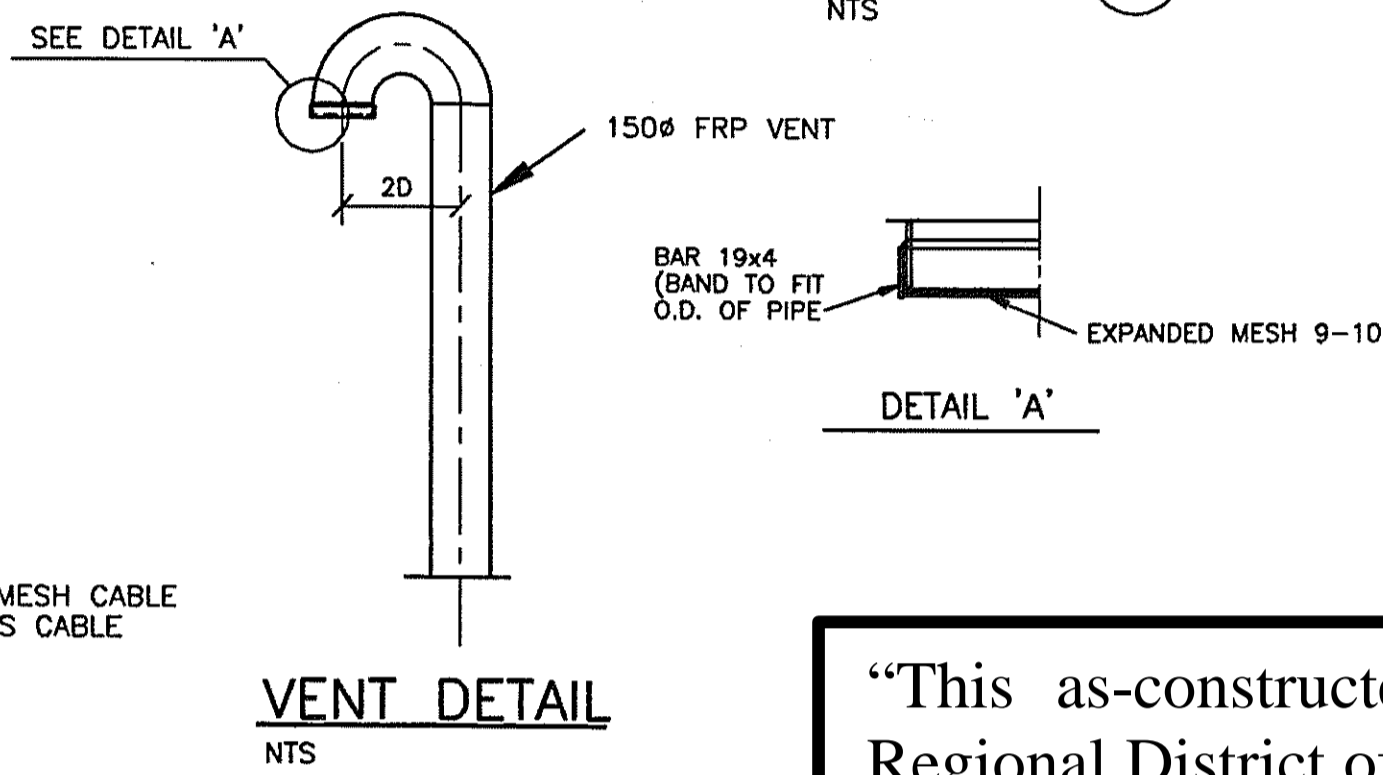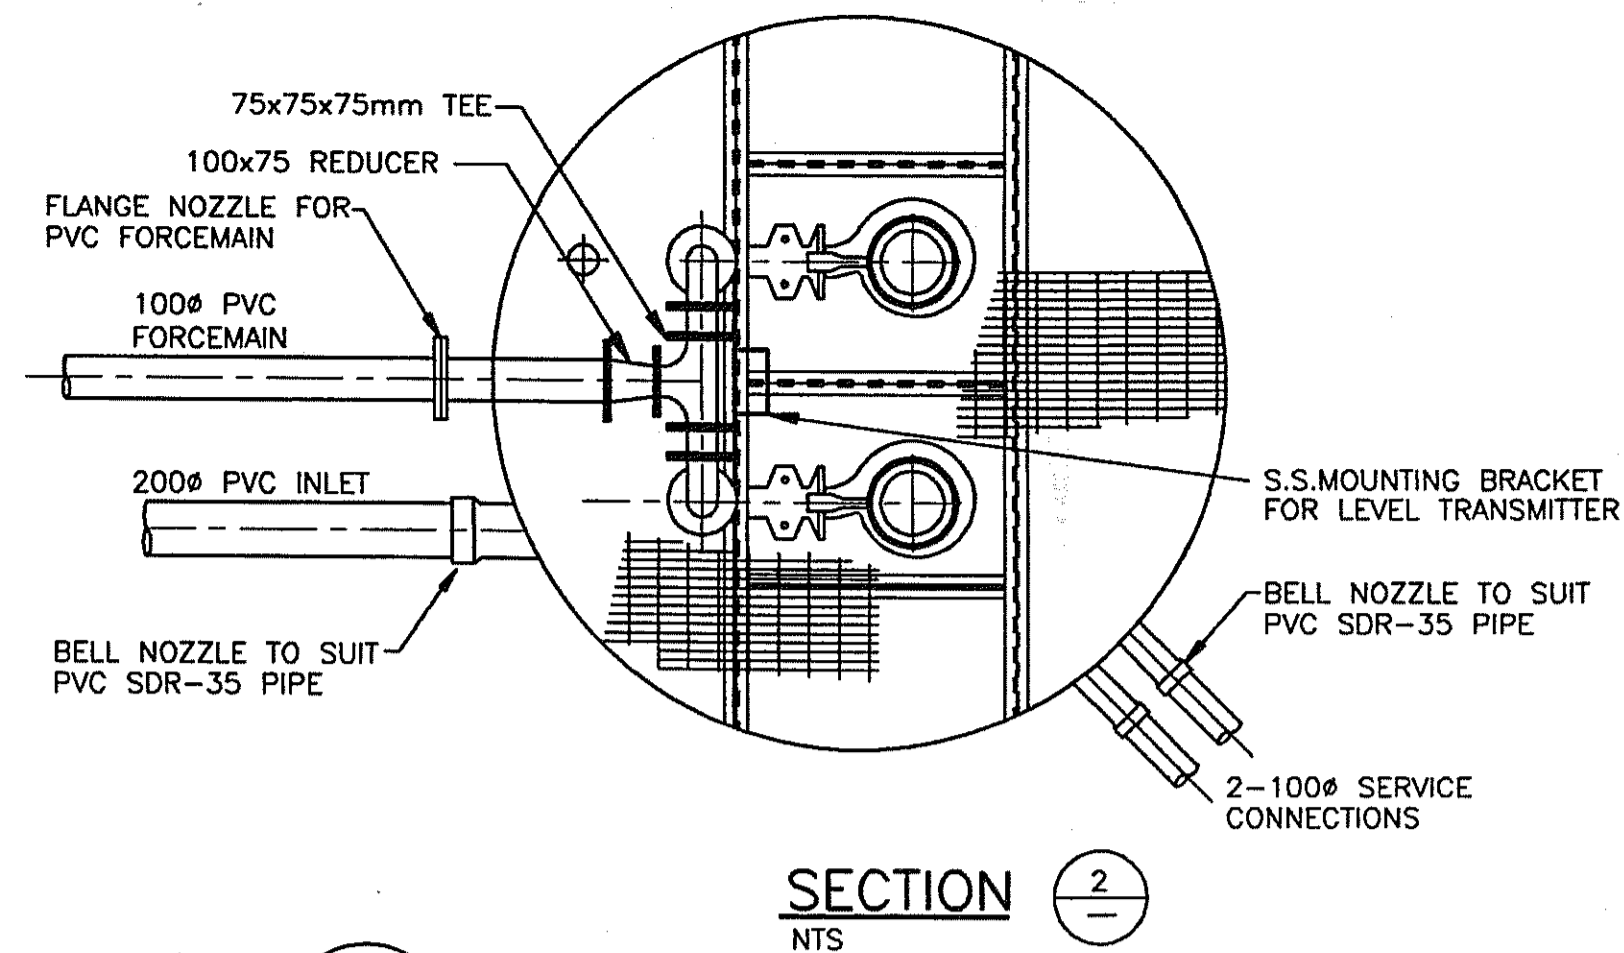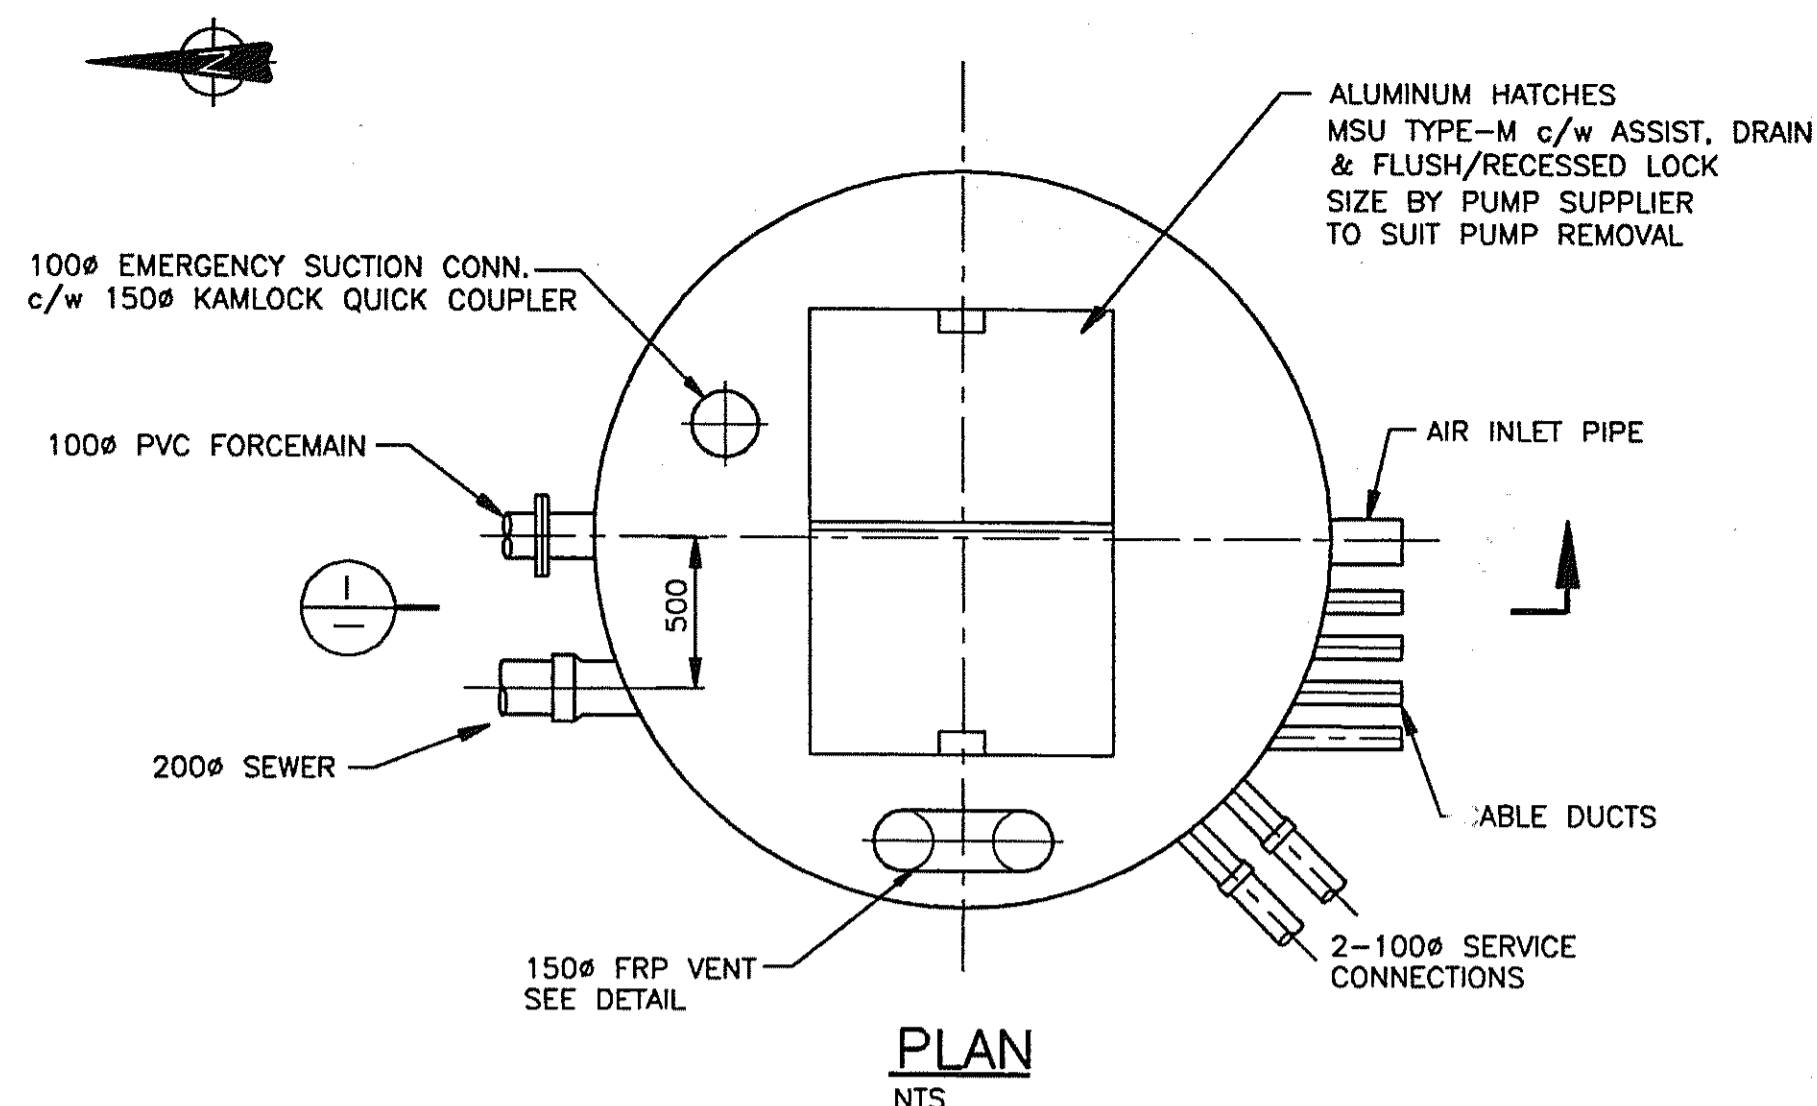


"This as-constructed information was not prepared by the Regional District of Central Okanagan and therefore there is no guarantee of its accuracy. It is the recipient's and user's responsibility to confirm the accuracy of this as-constructed information before proceeding with any work that may be affected by this as-constructed information."

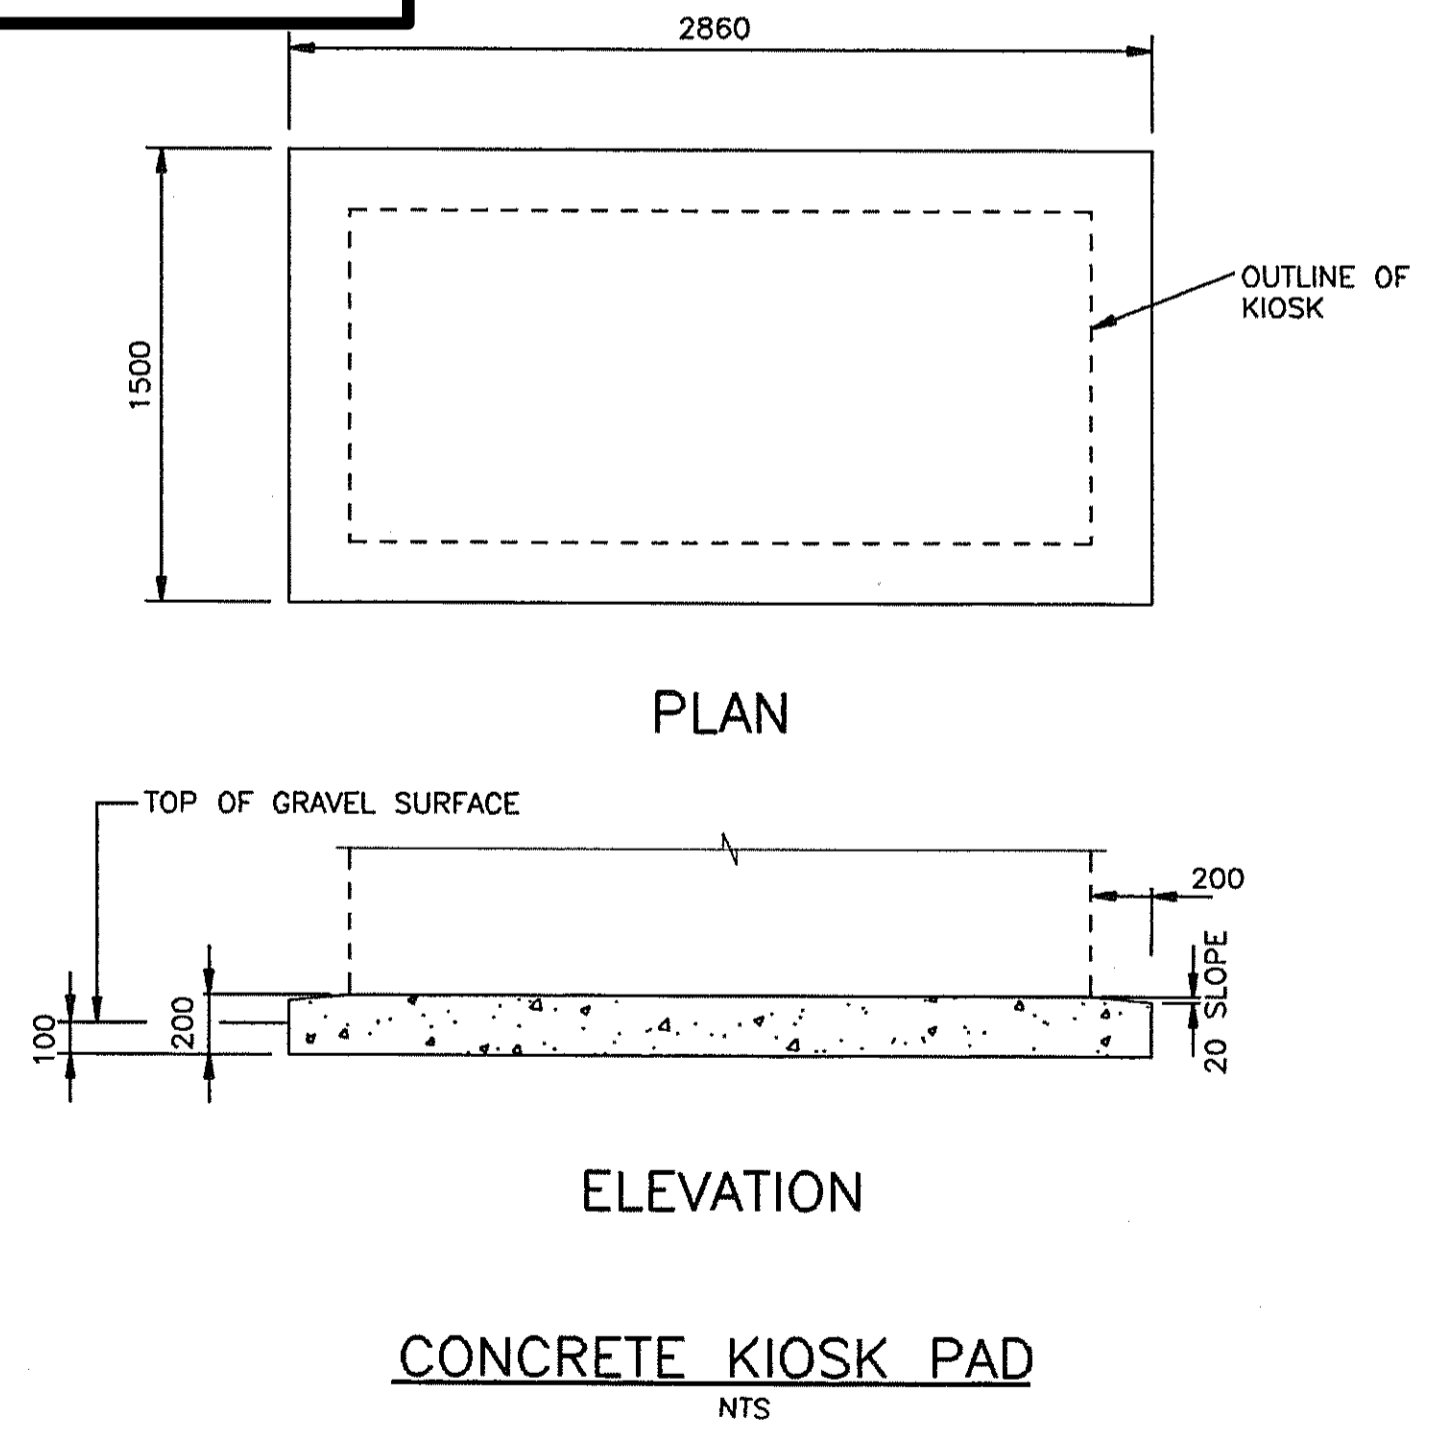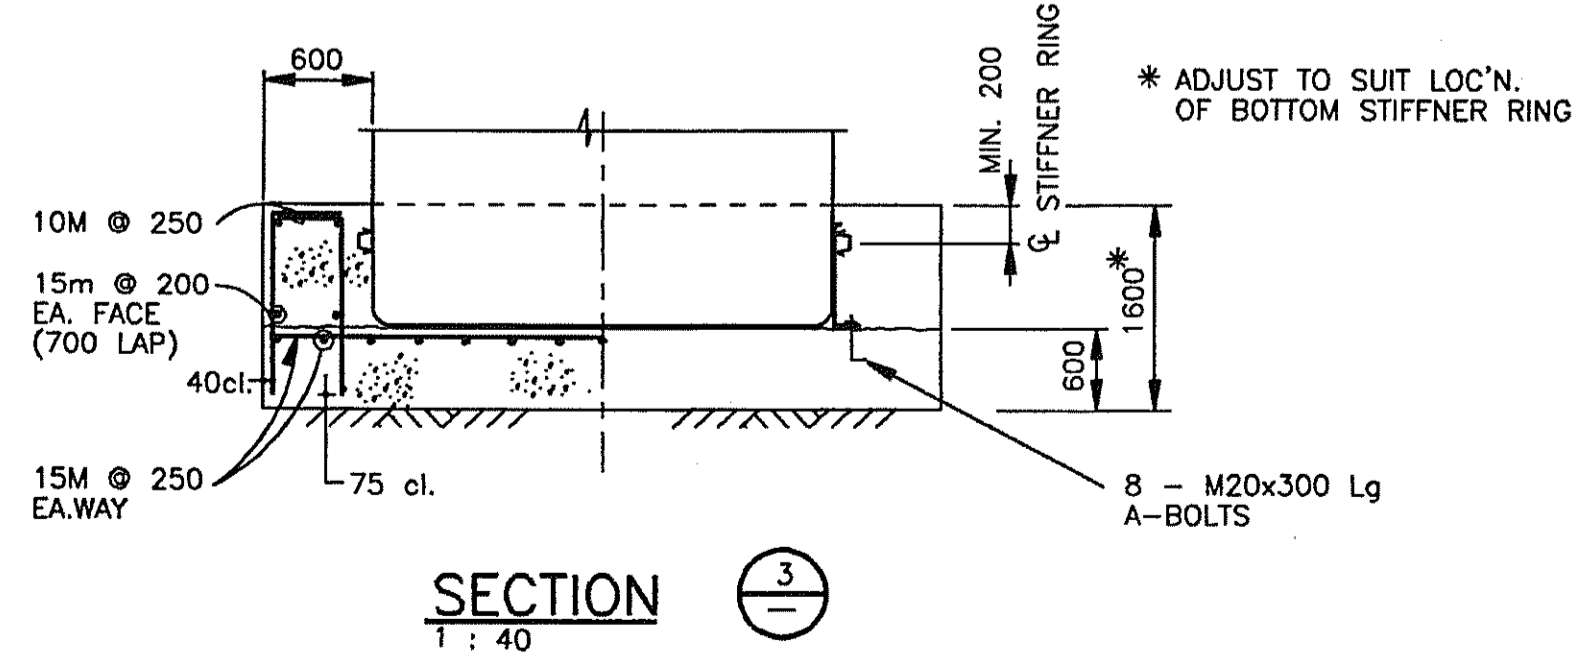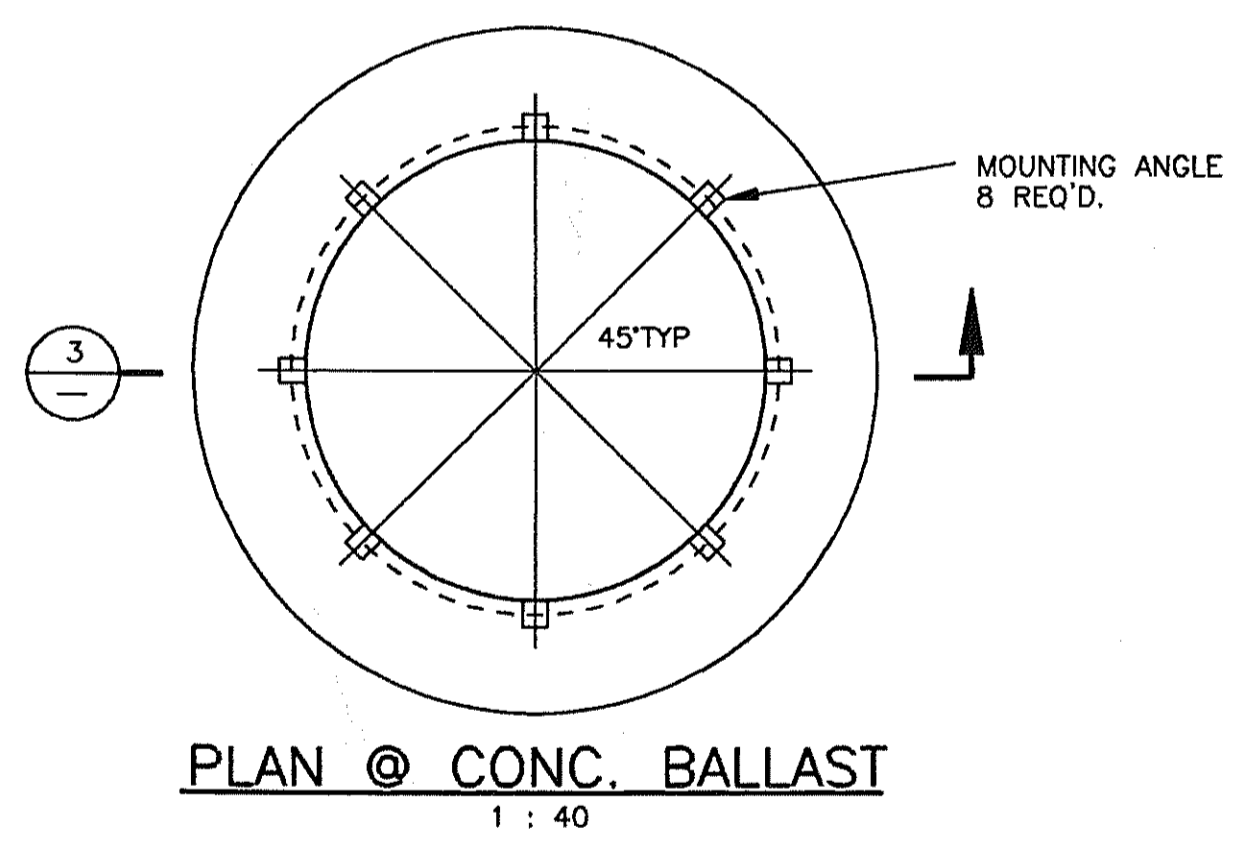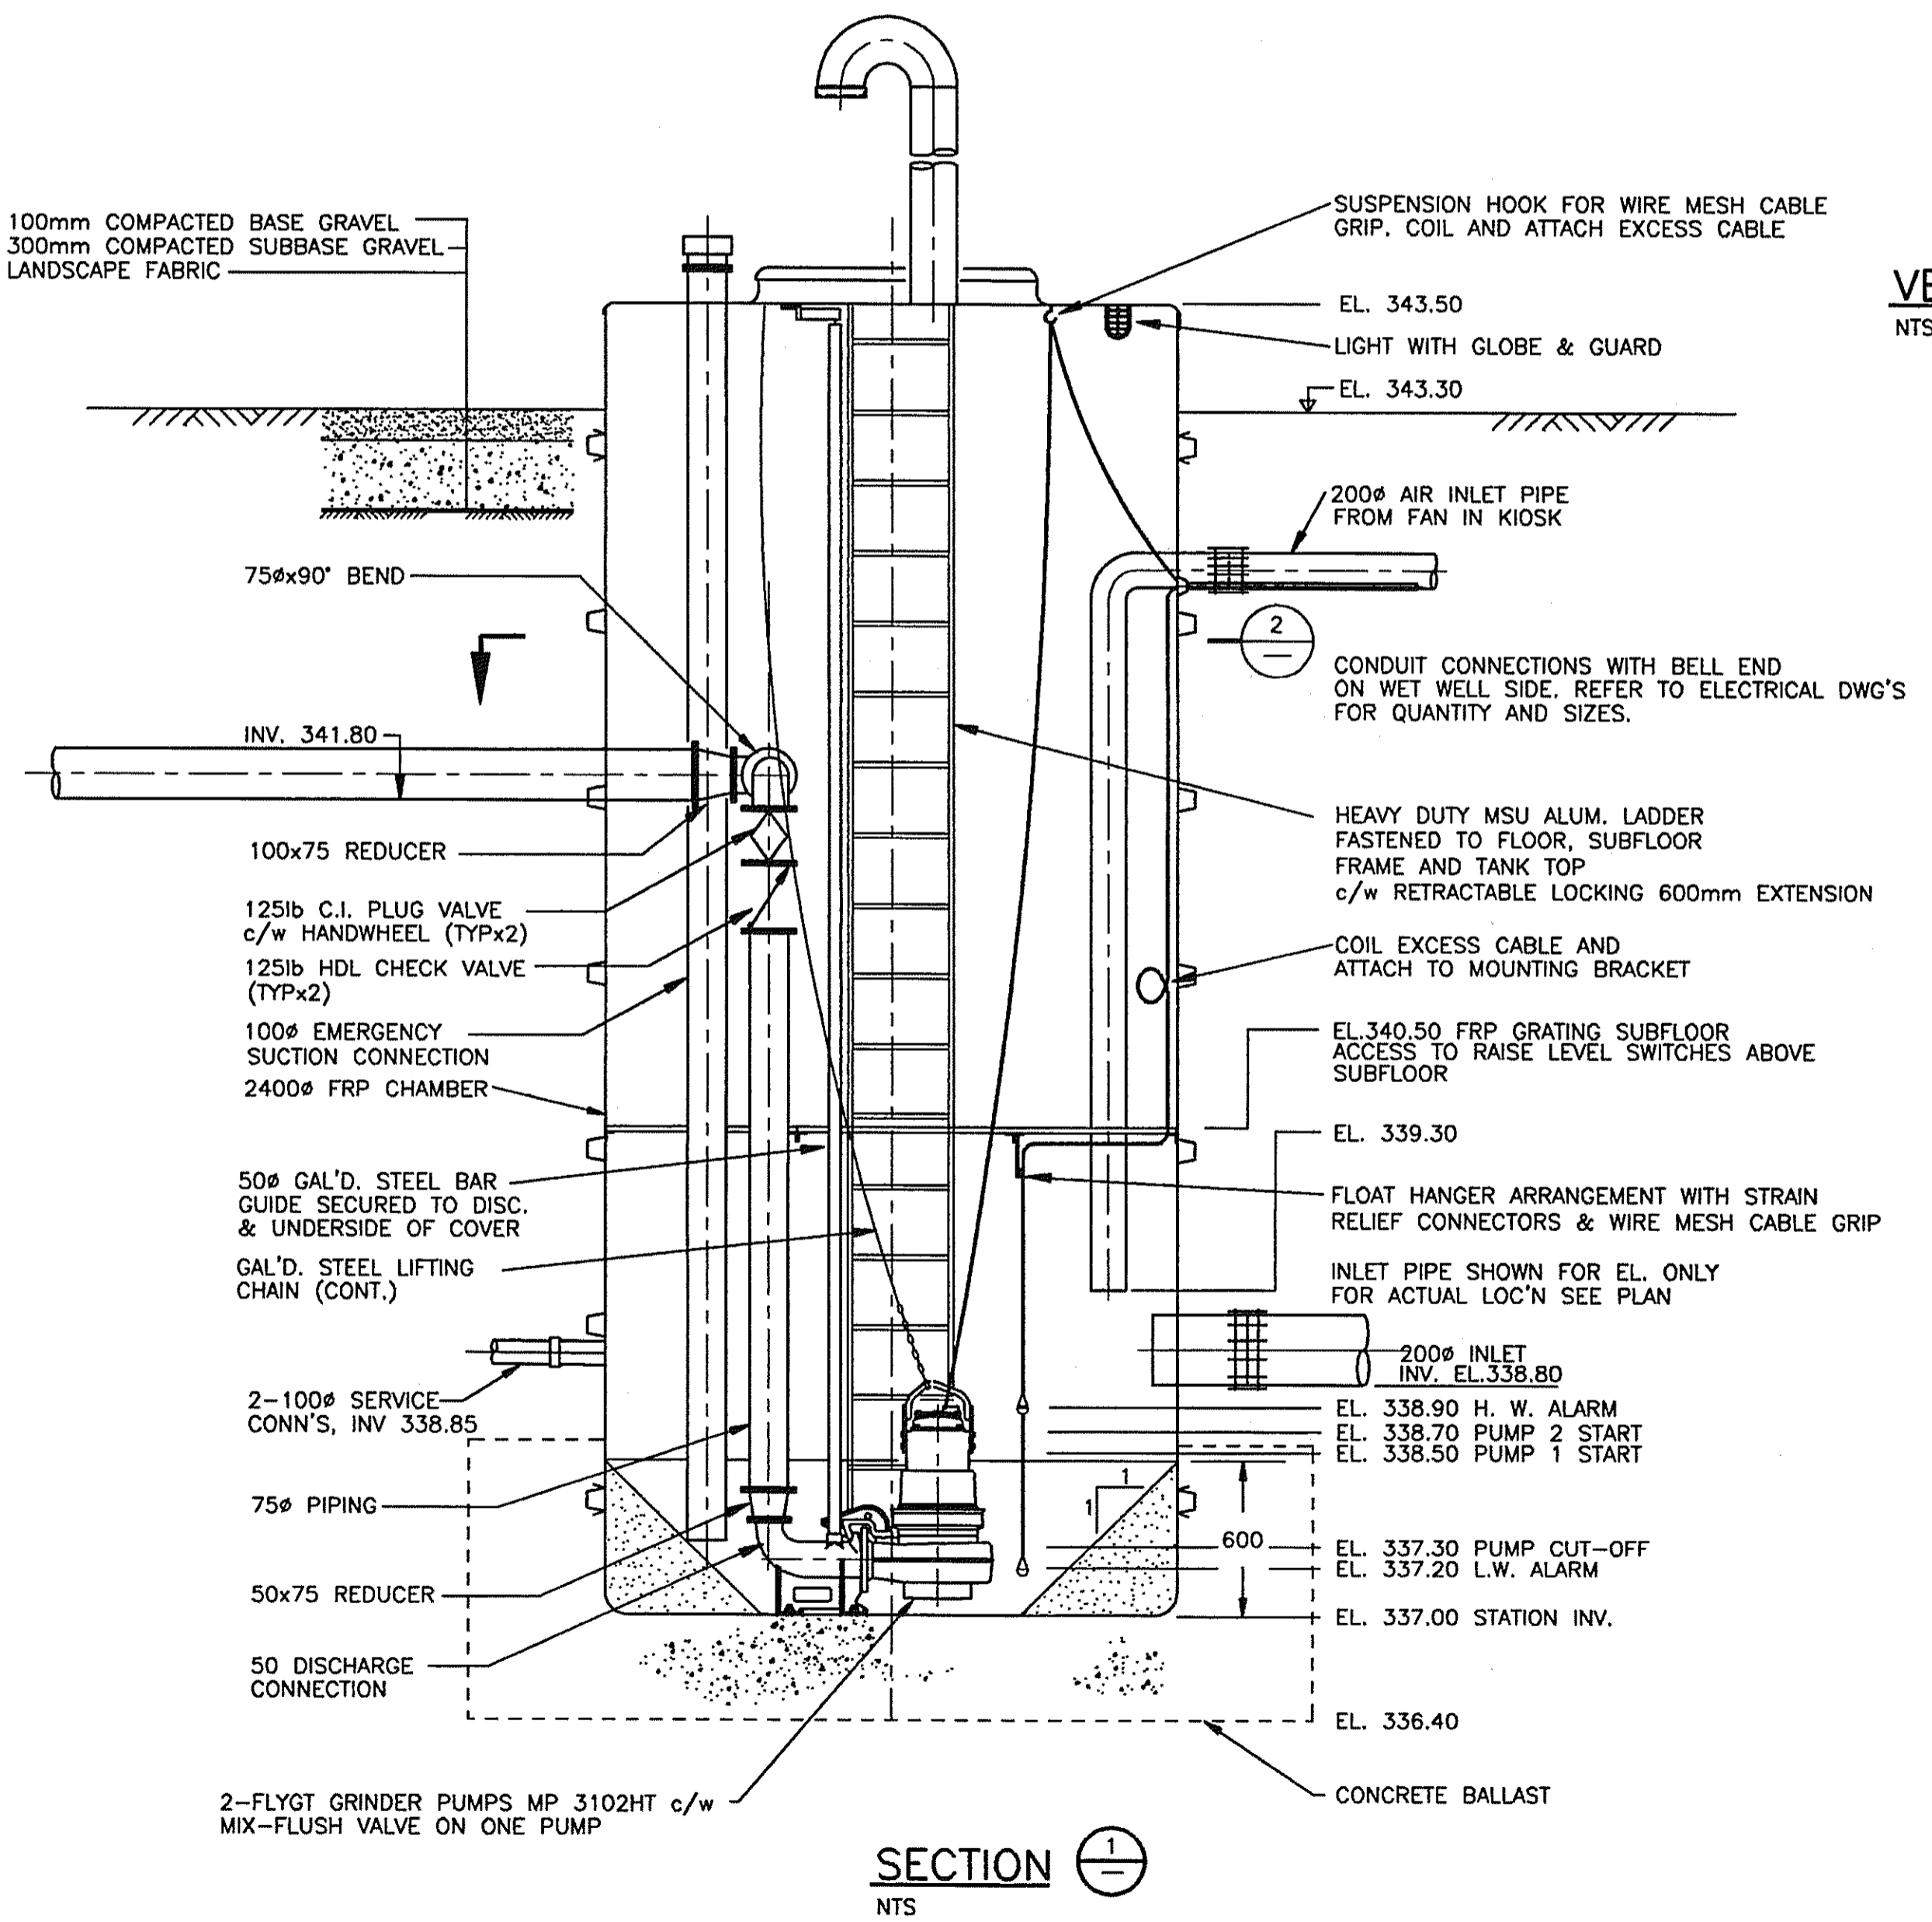

NOTE:
FOR CONDUIT CONFIGURATION AND KIOSK PAD BLOCKOUT LOCATIONS REFER TO INTERIOR INSTRUMENT TECH SERVICES LTD. DRAWING WHT-E-106

LEGEND	
WATER	—
SAN	—
STORM	—
GAS	—
UGTEL	—
UGLEEC	—
CENTER	—
HYDRANT	+
MANHOLE	○
CATCH BASIN	□
POWER POLE	PP
LAMP STANDARD	LS

No.	Date	By	Revision	Ch'd
6	15.05.00		RECORD DRAWING	
5	MAR16/00		RE-ISSUED FOR CONSTRUCTION	
4	FEB11/00		ISSUED FOR CONSTRUCTION	
3	NOV17/99		REISSUED FOR BID	
2	DEC.2/98		ISSUED FOR BID	
1	JUL'97		ISSUED FOR APPROVAL	

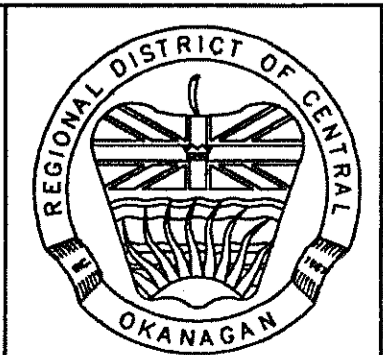

Drawn	
Design	AA
Approved	
Date	APR' 1997
Scale	H= 1:500 V= 1:50

REGIONAL DISTRICT CENTRAL OKANAGAN
WESTSIDE SANITARY SEWER PROJECT
WHITWORTH ROAD
SEWAGE PUMP STATION DETAILS

Drawing No.	2621-3-107R
Rev.No	6



PERFORMANCE CURVE

PRODUCT
MP3102.170
TYPE
HT

DATE
2013-08-27



PROJECT
WHITWORTH LS 3

CURVE NO
63-263-00-5260

ISSUE
6

	1/1-LOAD	3/4-LOAD	1/2-LOAD	MOTOR SHAFT POWER	6	hp
MOTOR COS PHI	0.93	0.91	0.87	STARTING CURRENT ...	44	A
MOTOR EFFICIENCY	80.5 %	80.5 %	78.5 %	RATED CURRENT ...	5.7	A
GEAR EFFICIENCY	---	---	---	RATED SPEED	3475	rpm
COMMENTS	INLET/OUTLET			TOT.MOM.OF INERTIA ...	---	
	- / 40 mm			NO. OF BLADES	6	
	IMP. THROUGHLET					

IMPELLER DIAMETER 155 mm		
MOTORTYPE 18-10-2AL	STATOR 52D	REV 11
FREQ. 60 Hz	PHASES 3	VOLTAGE 600 V
GEARTYPE ---		RATIO ---

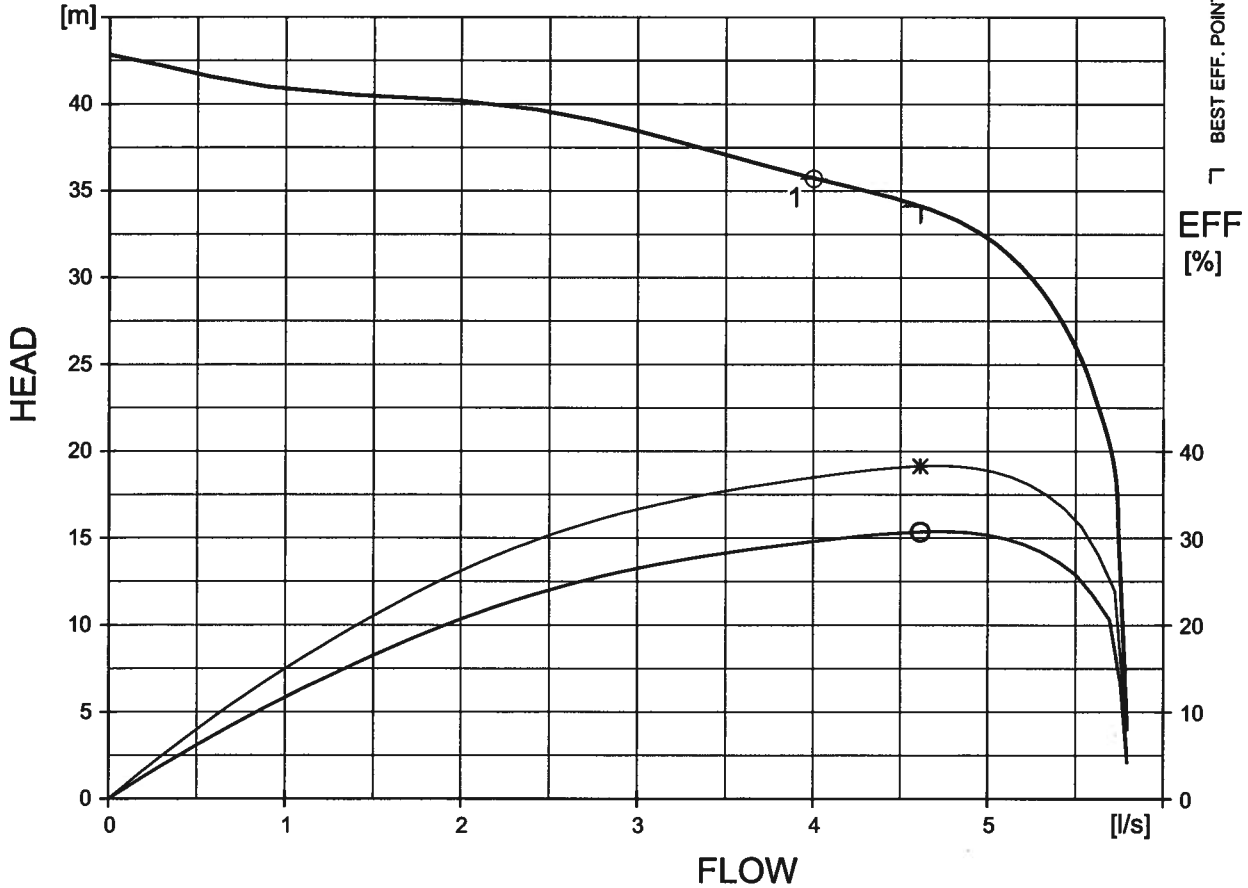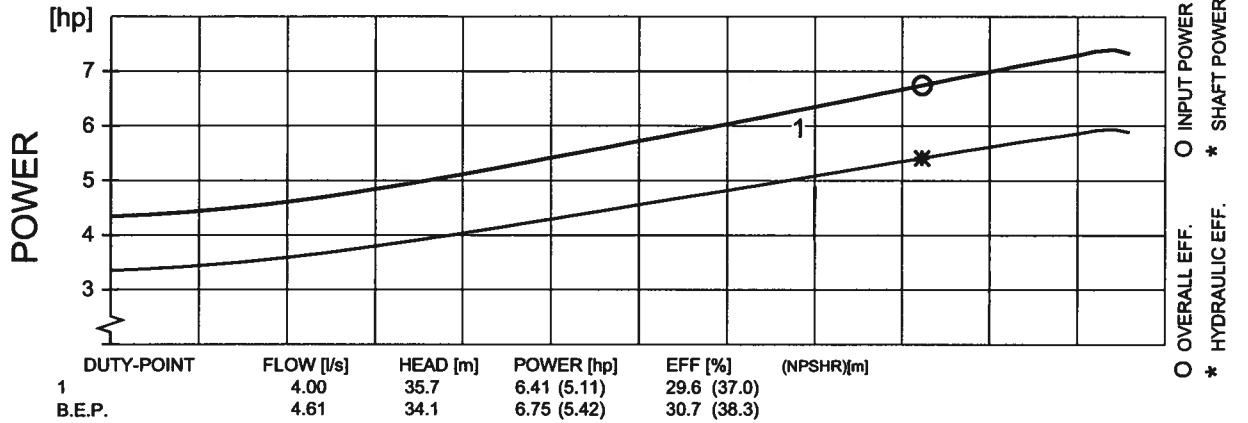

FLYPS3.1.5.7 (20060531)

Performance with clear water and rating data at 40 °C




District of West Kelowna

Sanitary Lift Station Evaluation

Station: Pineridge LS4
Reviewed By: Jim Kentel

Year Constructed: 8/1/2010
Year Upgraded:

Matrix Rating			
(10 - highest rating)	Civil	40	
(1 - lowest rating)	Process Mechanical	151	
	Electrical Instrumentation	141	
	Total Station Rating	332	(max. rating 370 points)

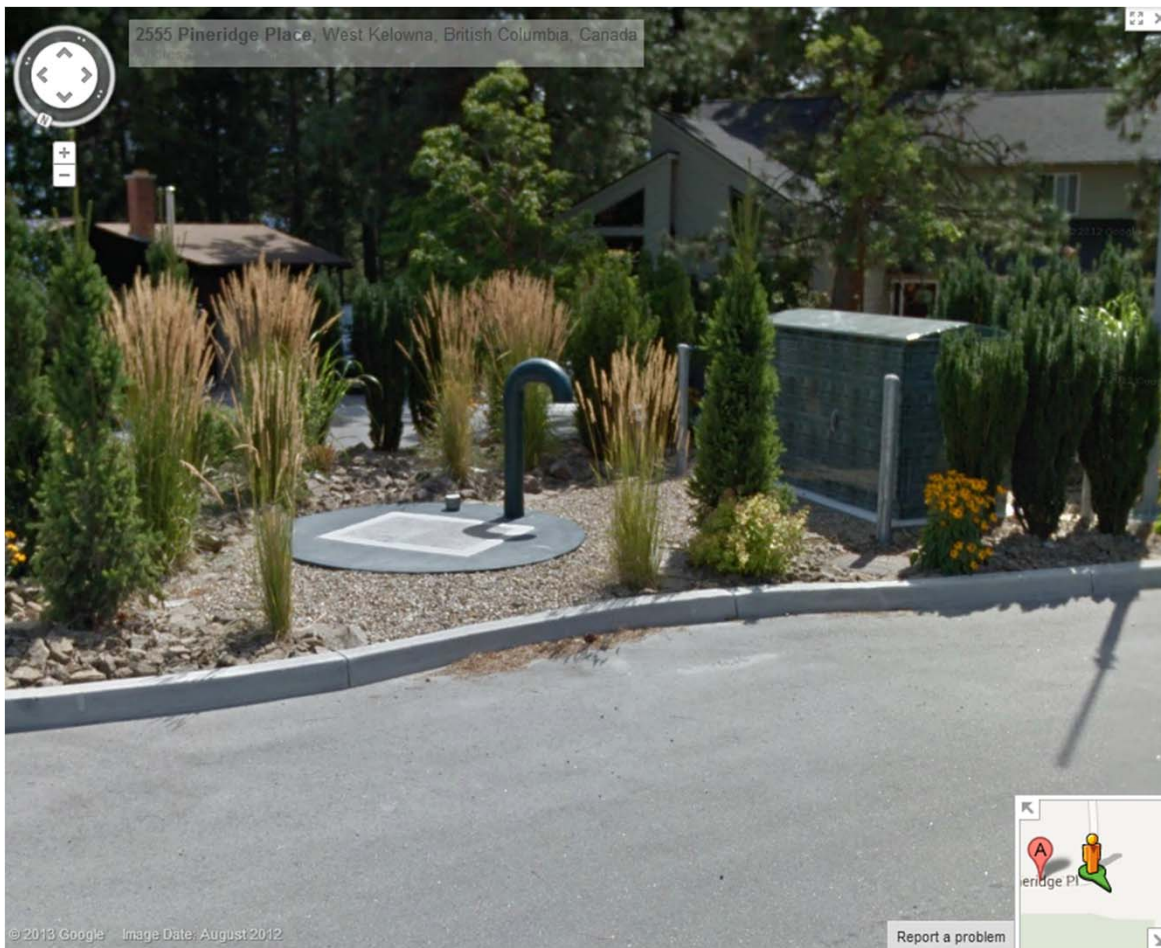

Civil:Matrix
Rating

Parking Area:	_____	n/a
Drainage:	Good	10
Influent sewer:	Gravity 200	10
Site access:	Landscaped boulevard	10
Water service:	Yes	10
		40

Process Mechanical:

Station type:	FRP 2.44m diameter	n/a
Number of pumps:	2	n/a
Pump Redundancy:	Yes Engineered pumps	n/a
Pump Manufacturer / Type:	Myers	9
Pump Model:	3VX20M4-21-50	n/a
Rated Capacity:	4.7 L/S @ 9.1m TDH	n/a
Capacity Confirmation:	_____	n/a
Discharge pipe type / diameter:	PVC Senes 160/75	10
Header pipe type / diameter:	Sch 40 Steel Epoxy Coated /75	10
Check valve type / diameter:	C1 swing flomatic 745/75	10
Isolation valve type / diameter:	Plug Valve homestead /75	10
Piping Condition:	Good	10
Emergency pumpout connection:	Yes	10
Pressure gauges:	Yes	10
Inlet bar screen:	No	1
Wetwell condition:	Good	10
Access Hatches:	Alum	10
Ladder / Platform:	Alum/FRP	10
Wetwell benching:	Yes/FRP	10
Odour Control:	No	1
Ventilation:	Yes	10
Water washdown:	Yes	10
Confined Space Entry Requirements	Davit	10
		151

Electrical / Instrumentation:

Matrix
Rating

Service Type	V / A / Phase / Wire	n/a
Pump 1 :	HP 2	n/a
	Volts 230 Rpm 1750	n/a
	FLA	n/a
	Starting Current	n/a
Pump 2 :	HP 2	n/a
	Volts 230 Rpm 1750	n/a
	FLA	n/a
	Starting Current	n/a
Alarm Functions:	Yes	10
		n/a
		n/a
		n/a
Receptacle	Yes	10
Interior Lighting:	Yes	10
Exterior Lighting:	Yes	10
SCADA / Telemetry:	Yes	10
Main Breaker:	100A	10
Control Panel:	Yes	10
Lighting Panel:	Yes	10
Flowmeter:	Siemens Sitrans FM3 3100W	10
Grounding:	Yes	10
Surge Protection:	Yes	10
UPS:	Yes	10
PLC:	Yes	10
Level Control:	Yes Milltronics/Bulbs	10
Standby Generator:	No	1
		141
Comments:	New Station	







NUMBER	DESCRIPTION
10-314	DISTRICT OF WEST KELOWNA PINERIDGE PLACE

EQUIPMENT SPECIFICATION

ITEM	QTY.	DESCRIPTION
1.	1	FIBERGLASS PREFABRICATED TANK, 2438mm DIA X 6400mm DEEP WITH FRP ROOF AND ALUMINUM HATCH COVER AND ANTI-FLOATATION FLANGE (DIMENSIONS AS SHOWN)
2.	2	MYERS MODEL 3V20M4-21-50, 1.49 kW (2 HP) SOLIDS HANDLING SEWAGE PUMP, 230/1/60Hz WITH A CAPACITY OF 4.7 L/S (75 USGPM) AT 9.14m (30') TDH AT 1750 RPM WITH 15.24m (50') LONG POWER & CONTROL CABLES (PUMPS SHIPPED LOOSE)
3.	2	MYERS MODEL 3RA33 LIFT-OUT RAIL ASSEMBLY WITH 75mm FLANGED DISCHARGE ELBOW
4.	5	75mm SCH 40 STEEL SLIP-ON WELD FLANGE, CLASS 150
5.	5	75mm SCH 40 STEEL SCH 40 STEEL DISCHARGE PIPE, BLAST CLEANED, COAL TAR EPOXY COATED
6.	2	75mm ROMAC MODEL RFCA RESTRAINED FLANGED COUPLING ADAPTOR WITH STAINLESS STEEL TRIM
7.	2	75mm FLOMATIC MODEL 745, CAST IRON, FLANGED, SWING CHECK VALVE
8.	2	75mm HOMETEAD SERIES 120 ECCENTRIC PLUG VALVE, CAST IRON, FLANGED WITH LEVER OPERATOR
9.	2	75mm SCH 40 STEEL WELD NECK FLANGE, CLASS 150
10.	3	75mm SCH 40 STEEL SHORT RADIUS 90° ELBOW, WELD FITTING
11.	1	75mm SCH 40 STEEL STRAIGHT TEE, WELD FITTING
12.	1	PRESSURE GAUGE, 0-30 INCH LIQUID FILLED WITH 100mm STAINLESS STEEL CASE, STAINLESS STEEL DIAPHRAGM SEAL & 15mm WELDOLET, NIPPLE AND BRASS BALL VALVE, THREADED (PRESSURE GAUGE SHIPPED LOOSE)
13.	1	FLOMATIC MODEL SEWER - WITH PRESSURE SEWAGE AIR RELEASE VALVE WITH BACKLASH ATTACHMENTS AND 25mm PVC PIPE AND FITTINGS TO BELOW PLATFORM ELEVATION (SHIPPED LOOSE)
14.	1	75mm SENEYS STRAWS FLOW METER MODEL FM3 MAG 3100W WITH REMOTE MOUNTED TOTALIZER AND 20m OF CABLE. FLOW METER RATED FOR CLASS 1, DIVISION 2 LOCATIONS
15.	1	75mm ALUMINUM CAM-LOCK FITTING, PART F - ADAPTOR MALE THREAD
16.	1	75mm ALUMINUM CAM-LOCK FITTING, PART DC - DUST CAP
17.	4	38mm SCH 40 GALVANIZED STEEL GUIDE RAIL PIPES
18.	2	MYERS TRAYS UPPER GUIDE RAIL SUPPORT WITH CHAIN HOOK AND 75mm SPACER
19.	1	150mm SCH 40 PVC 90° ELBOW
20.	1	150mm SCH 40 PVC PIPE
21.	1	100mm PVC MALE ADAPTOR
22.	1	100mm SCH 40 PVC PIPE
23.	1	200mm SDR35 PVC TEE
24.	1	200mm SDR 35 PVC PIPE
25.	1	150mm DIA PVC TRANSDUCER STILLING TUBE WITH REMOVABLE CAP AND STAINLESS STEEL SUPPORT CLAMP (TRANSDUCER SUPPLIED BY CONTRACTOR)
26.	1	FEATHERLITE SERIES 4000 EXTRA-HEAVY DUTY ALUMINUM LADDER
27.	2	STAINLESS STEEL RETRACTABLE HAND GRAB ASSEMBLY
28.	1	150mm FIBERGLASS 180° RETURN EXHAUST VENT WITH BIRD SCREEN
29.	1	SEPTAFLIGHT MODEL LW150HR-HAZ, 150 WATT EXPLOSION PROOF LIGHT WITH MOUNTING BRACKET AND WITH 9.1m (30') LONG POWER CORD
30.	1	EXPLOSION PROOF LIMIT SWITCH WITH CORD AND JUNCTION BOX
31.	1	USF FABRICATION MODEL AFD300 36 X 45 ALUMINUM HATCH COVER. FOR DETAILS SEE DRAWING 10-314-H1

GENERAL NOTES:

- FIBERGLASS TANK TO BE A CROSS STRAND MOLDED FIBERGLASS BASIN WITH TRAPEZOIDAL RIBS FABRICATED WITH 100% PREMIUM RESIN AND GLASS-FIBRE REINFORCEMENT. NO SAND FILLERS. ALL CUT EDGES SHALL BE COATED WITH RESIN SO THAT NO GLASS FIBRES ARE EXPOSED AND ALL VOIDS FILLED. INTERIOR TO BE WHITE. EXTERIOR TOP 0.6m (2') TO BE DARK GREEN WITH U.V. INHIBITORS. ALL WALL PENETRATIONS FOR BRACKETS AND COUPLINGS TO BE FIBERGLASS OVER TO PROVIDE A LEAK PROOF SEAL.
- THE FIBERGLASS TANK SHALL BE DESIGNED AND CONSTRUCTED TO WITHSTAND OR EXCEED WALL COLLAPSE AND BUCKLING AT FULL DEPTH OF EXTERNAL HYDROSTATIC FORCES WITH A 3:1 SAFETY FACTOR, BASED ON THE FOLLOWING LOADING CONDITIONS:
 - a. UNIT WEIGHT OF WATER IS 62.4 lbs. PER CUBIC FOOT
 - b. SATURATED SOIL UNIT WEIGHT OF 120 lbs. PER CUBIC FOOT
 - c. MODULUS OF SOIL REACTION OF 700 lbs. PER SQUARE INCH
- THE FIBERGLASS TANK SHALL BE TESTED BY THE MANUFACTURER TO A BARCOL HARDNESS OF AT LEAST 80% OF THE RESIN MANUFACTURER'S SPECIFIC HARDNESS FOR FULLY CURED RESIN. THE FOLLOWING FORTINITY MEASURE MATERIALS PROPERTIES SHALL BE USED IN ANALYSIS FOR FIBERGLASS COMPOSITE IN THE FIBERGLASS TANK:
 - a. TENSILE MODULUS 900,000 psi
 - b. FLEXURAL MODULUS 800,000 psi
 - c. TENSILE STRENGTH 10,000 psi
 - d. COMPRESSIVE STRENGTH 20,000 psi
 - e. POISSON'S RATIO 0.3
- ALL F.R.P. WORK SHALL MEET OR EXCEED:
 - CM/CSB - 41 GP-22
 - A.S.I.M. - DB33
 - A.S.I.M. - 03753
- NOZZLES TO BE LOCATED AS SHOWN ON THIS DRAWING. NOZZLES SHALL BE FRP PIPE ATTACHED BY FIBERGLASS ROVING TO THE OUTER SHELL.
- THE CONTRACTOR SHALL BE RESPONSIBLE FOR THE SUPPLY AND INSTALLATION OF FLEXIBLE TRANSITION CONNECTIONS TO THE PUMP STATION NOZZLES. THIS CONNECTION MUST BE SUITABLE TO COMPENSATE FOR STRESSES IMPOSED ON THE CONNECTION CAUSED BY GROUND SETTLEMENT, COMPACTION AND ANY OTHER EXTERNAL FORCES.
- ALL PIPING AND OTHER ATTACHMENTS SHALL BE INSTALLED IN SUCH A WAY TO PREVENT STRESSES BEING INDUCED ON THE TANK.
- PIPING TO BE SCH 40 STEEL, BLAST CLEANED TO SSPC-SP-10, AND COATED WITH COAL TAR EPOXY TO ANNA STANDARDS, BY EPS.
- ALL NUTS, BOLTS AND WASHERS TO BE 300 SERIES STAINLESS STEEL.
- ELEVATIONS ARE LISTED IN METERS.
- PUMPS, SEWAGE AIR RELEASE VALVE ASSEMBLY AND PRESSURE GAUGE SHIPPED LOOSE FOR INSTALLATION, ON SITE, BY THE CONTRACTOR.
- THE SUPPLIER RESERVES THE RIGHT TO OBSERVE THE TANK INSTALLATION.
- ALL ELECTRICAL WORK TO BE CARRIED OUT BY THE CONTRACTOR, INCLUDING THE INSTALLATION OF THE PUMPS AND THE SUPPLY AND INSTALLATION OF ANY ELECTRICAL CONDUITS AND COUPLINGS, FLOAT SWITCHES, ULTRASONIC TRANSDUCER, THE WIRING OF THE EXPLOSION PROOF LIGHT AND LIMIT SWITCH AND THE SUPPLY AND INSTALLATION OF ALL CONTROLS INCLUDING THE PUMP CONTROL WIRING.
- ALL COUPLINGS, CONNECTIONS AND PIPING EXTERIOR TO THE TANK WALL TO BE SUPPLIED AND INSTALLED BY THE CONTRACTOR.
- ALL PAD LOCKS TO BE SUPPLIED BY THE CONTRACTOR.
- REINFORCED CONCRETE SUPPORT BASE AND ANCHORING SYSTEM FOR THE PUMP STATION TO BE SUPPLIED AND FULLY INSTALLED BY THE CONTRACTOR. FOR DETAILS, SEE DRAWINGS AND SPECIFICATIONS BY THE PROJECT ENGINEER.
- THE MANUFACTURER RESERVES THE RIGHT TO MODIFY THE DESIGN AT ANY TIME WITHOUT PRIOR NOTICE.
- FORDOMAN TRANSIENT PRESSURE ANALYSIS BY OTHERS.
- NO ASSESSMENT HAS BEEN MADE OF GROUND CONDITIONS OR SUITABILITY OF THE SITE FOR THE CONSTRUCTION OF THE PUMP STATION SHOWN ON THIS DRAWING. IT IS THE RESPONSIBILITY OF THE OWNER AND HIS AGENTS TO ASSESS THE GROUND CONDITIONS AND TO SPECIFY THE WORK REQUIRED FOR EXCAVATION, BACKFILLING AND STABILITY.
- SOILS ENGINEERING TO BE SUPPLIED BY OTHERS. PUMP STATION CONCRETE BASE AND BACKFILL SHALL BE DESIGNED BY OTHERS TO RESIST FLOATION.
- FOR TANK INSTALLATION INSTRUCTIONS AND BACKFILL GUIDELINES SEE DOCUMENTS BY KERRYS CORPORATION.
- FOR ADDITIONAL INFORMATION CONCERNING THIS PUMP STATION INCLUDING INSTALLATION AND CONSTRUCTION NOTES, PUMP STATION LOCATION, SITE AND GRADING PLANS, SEE DRAWINGS AND SPECIFICATIONS BY PROJECT ENGINEER.

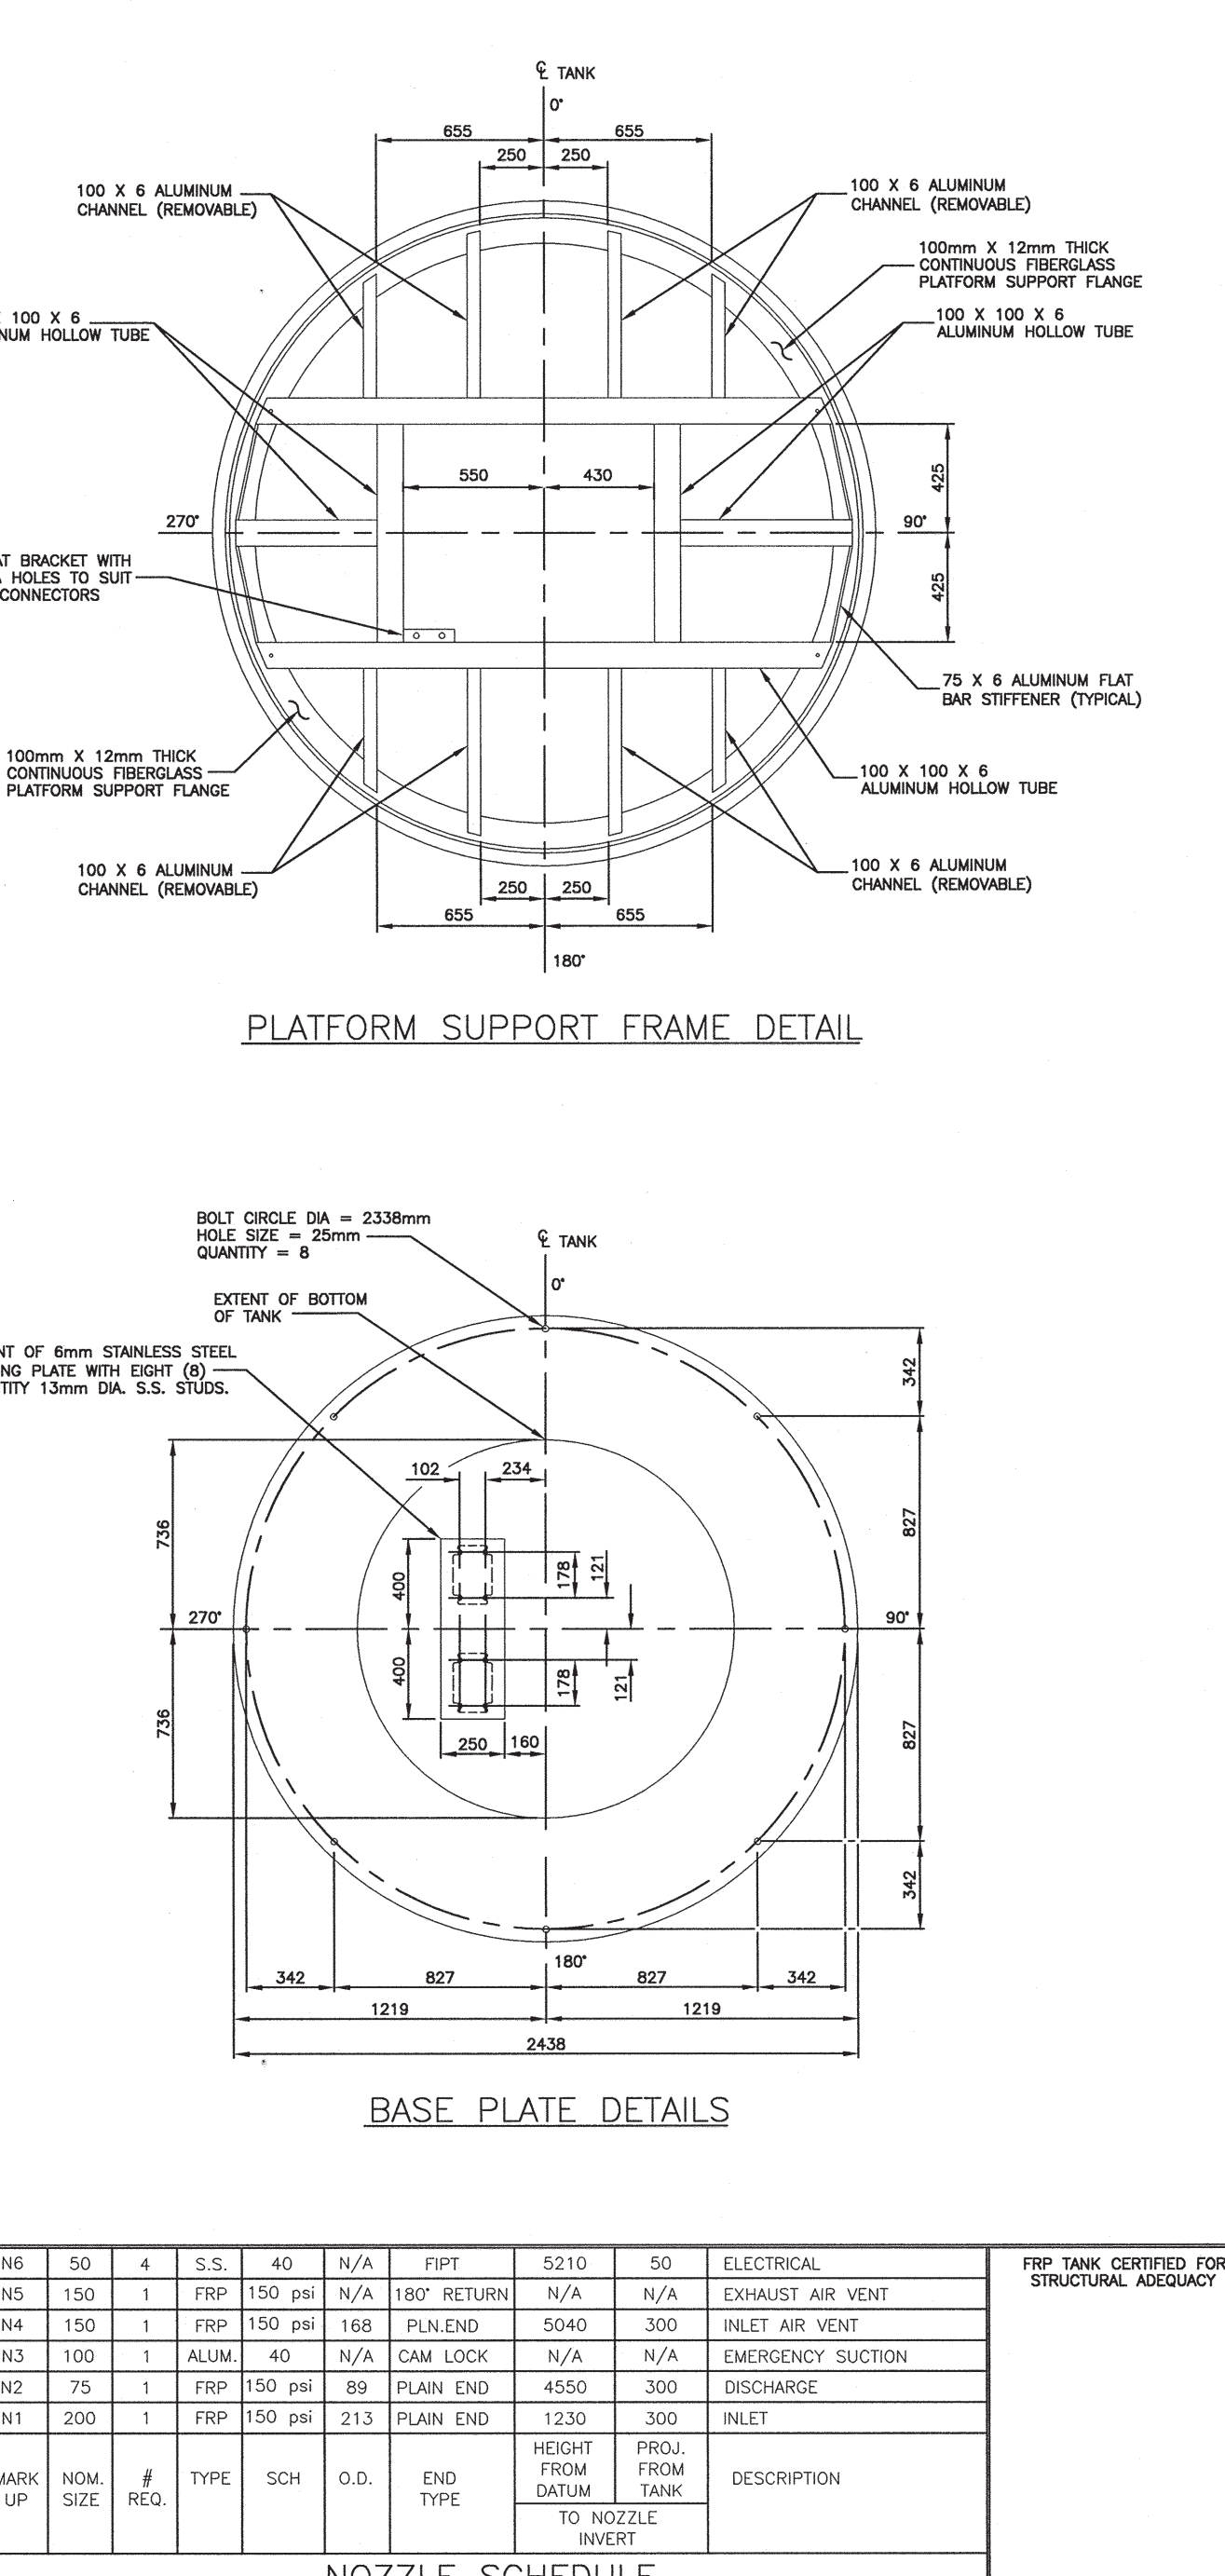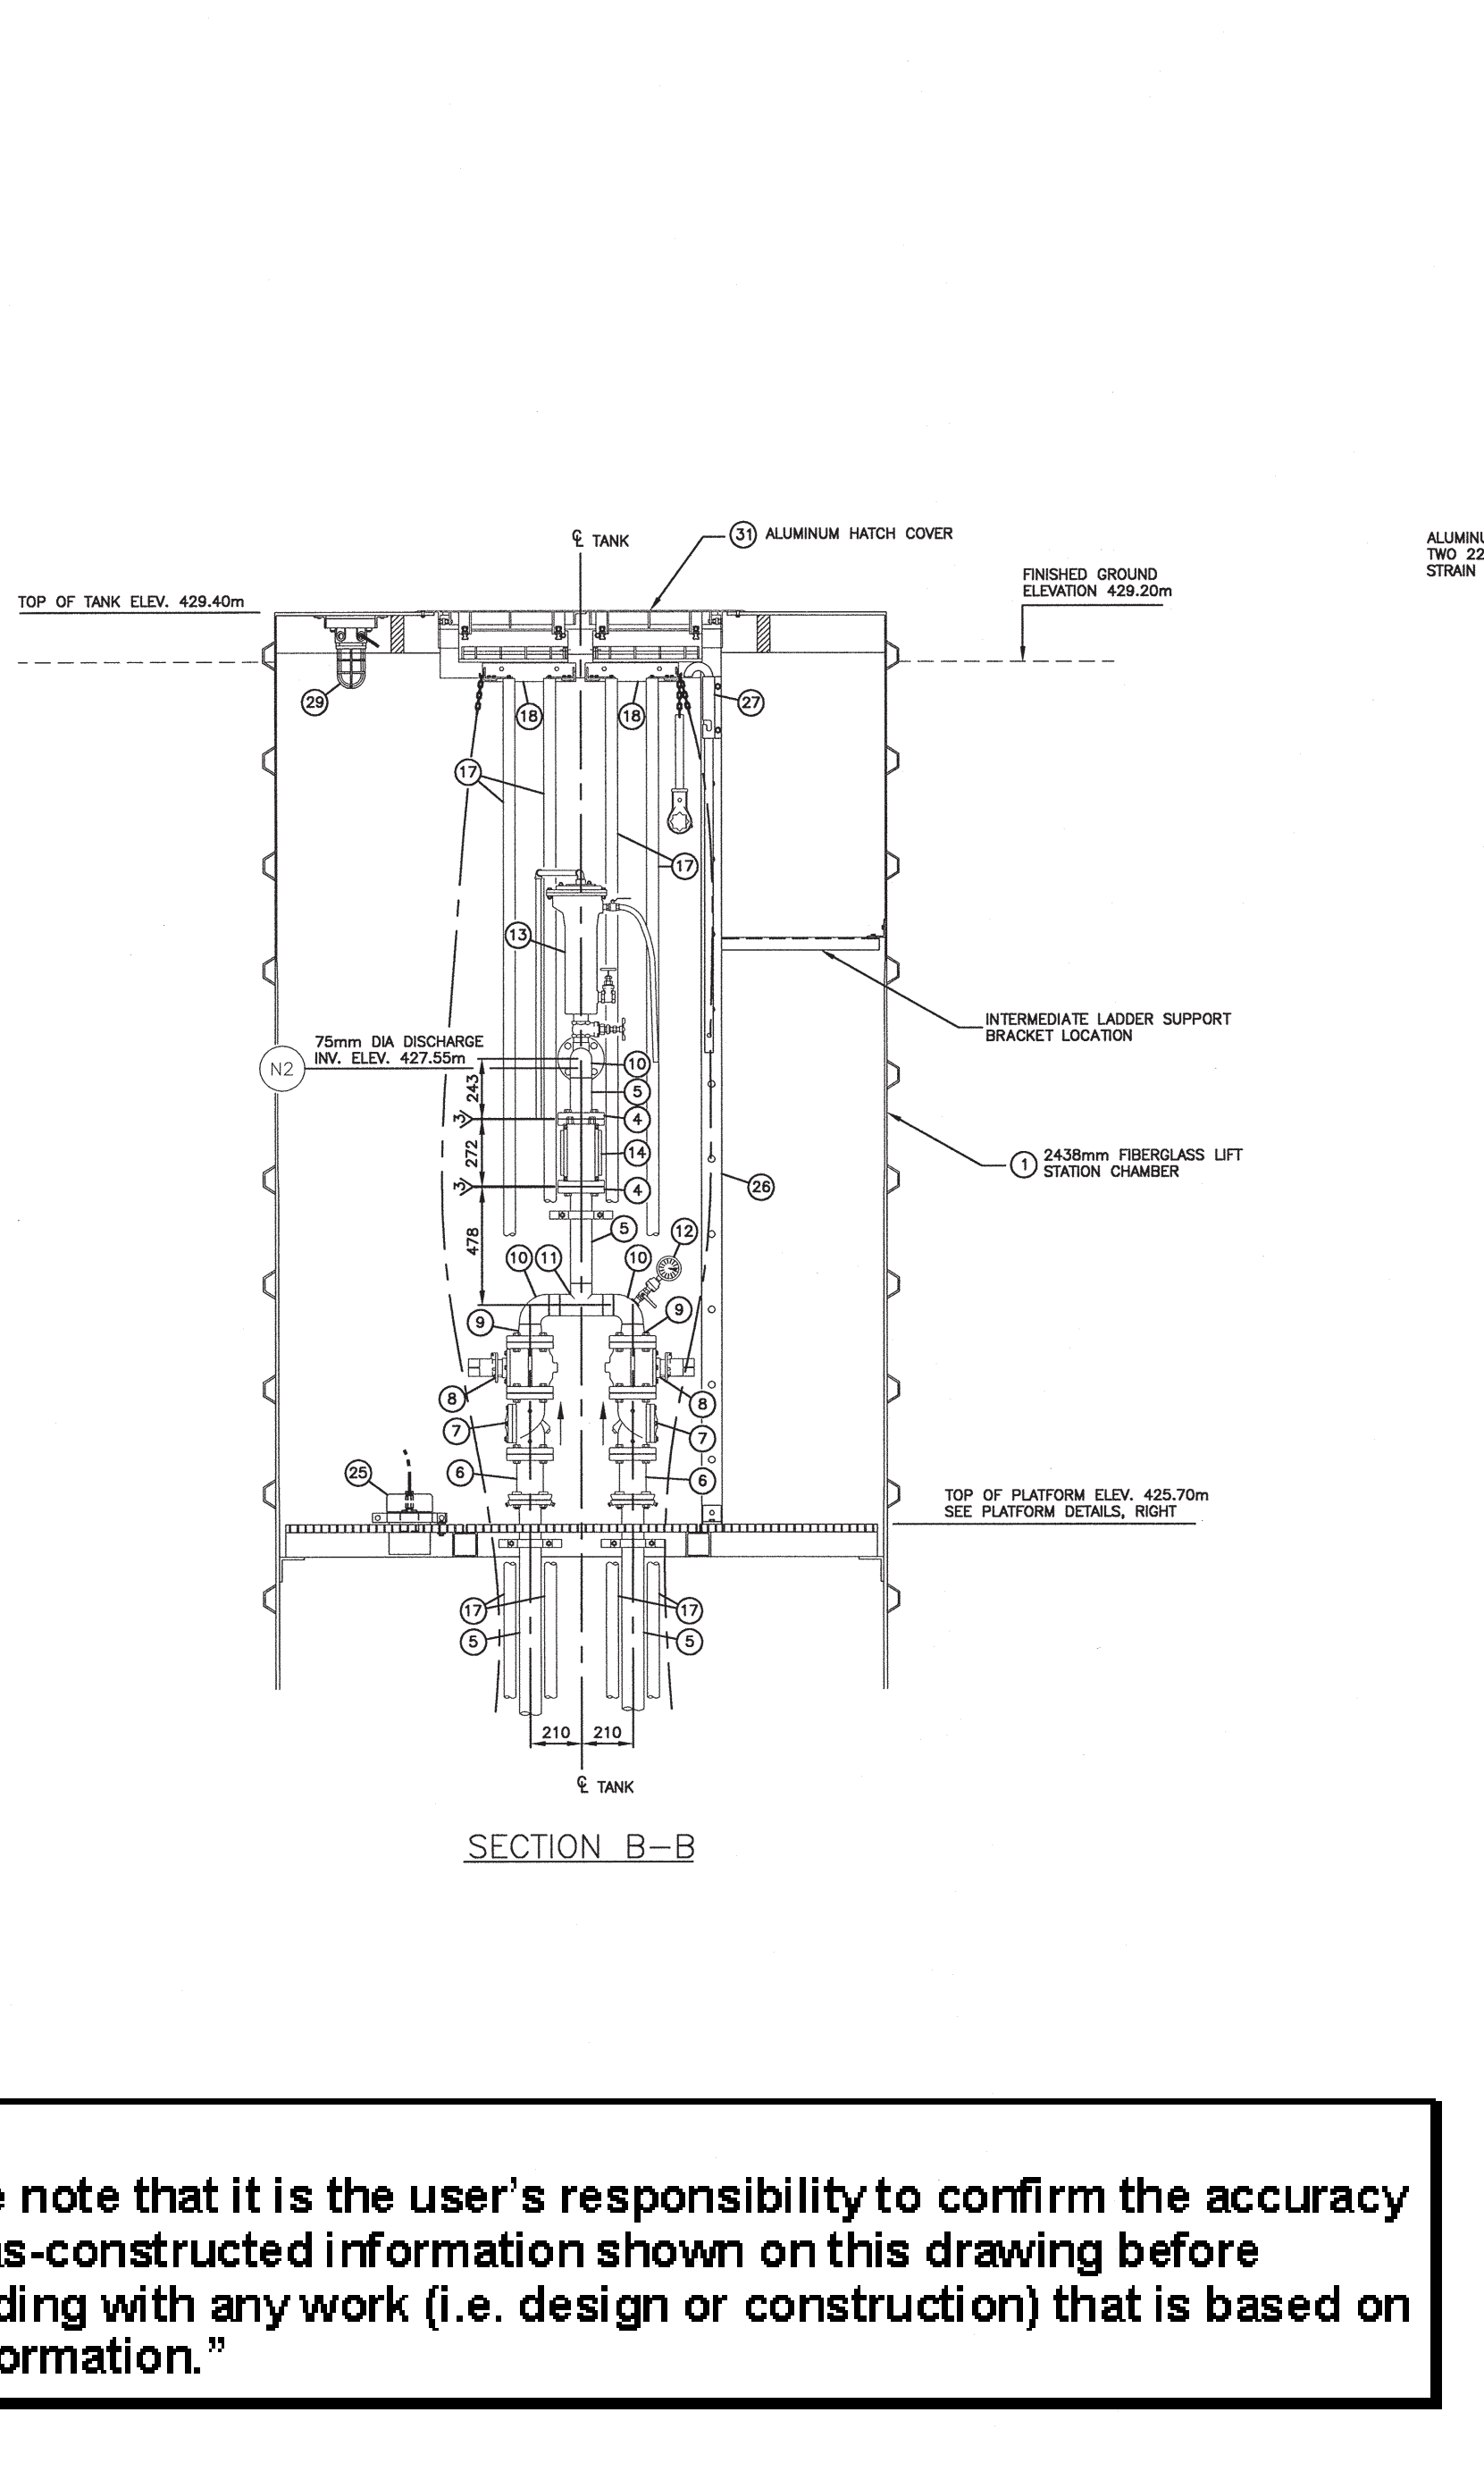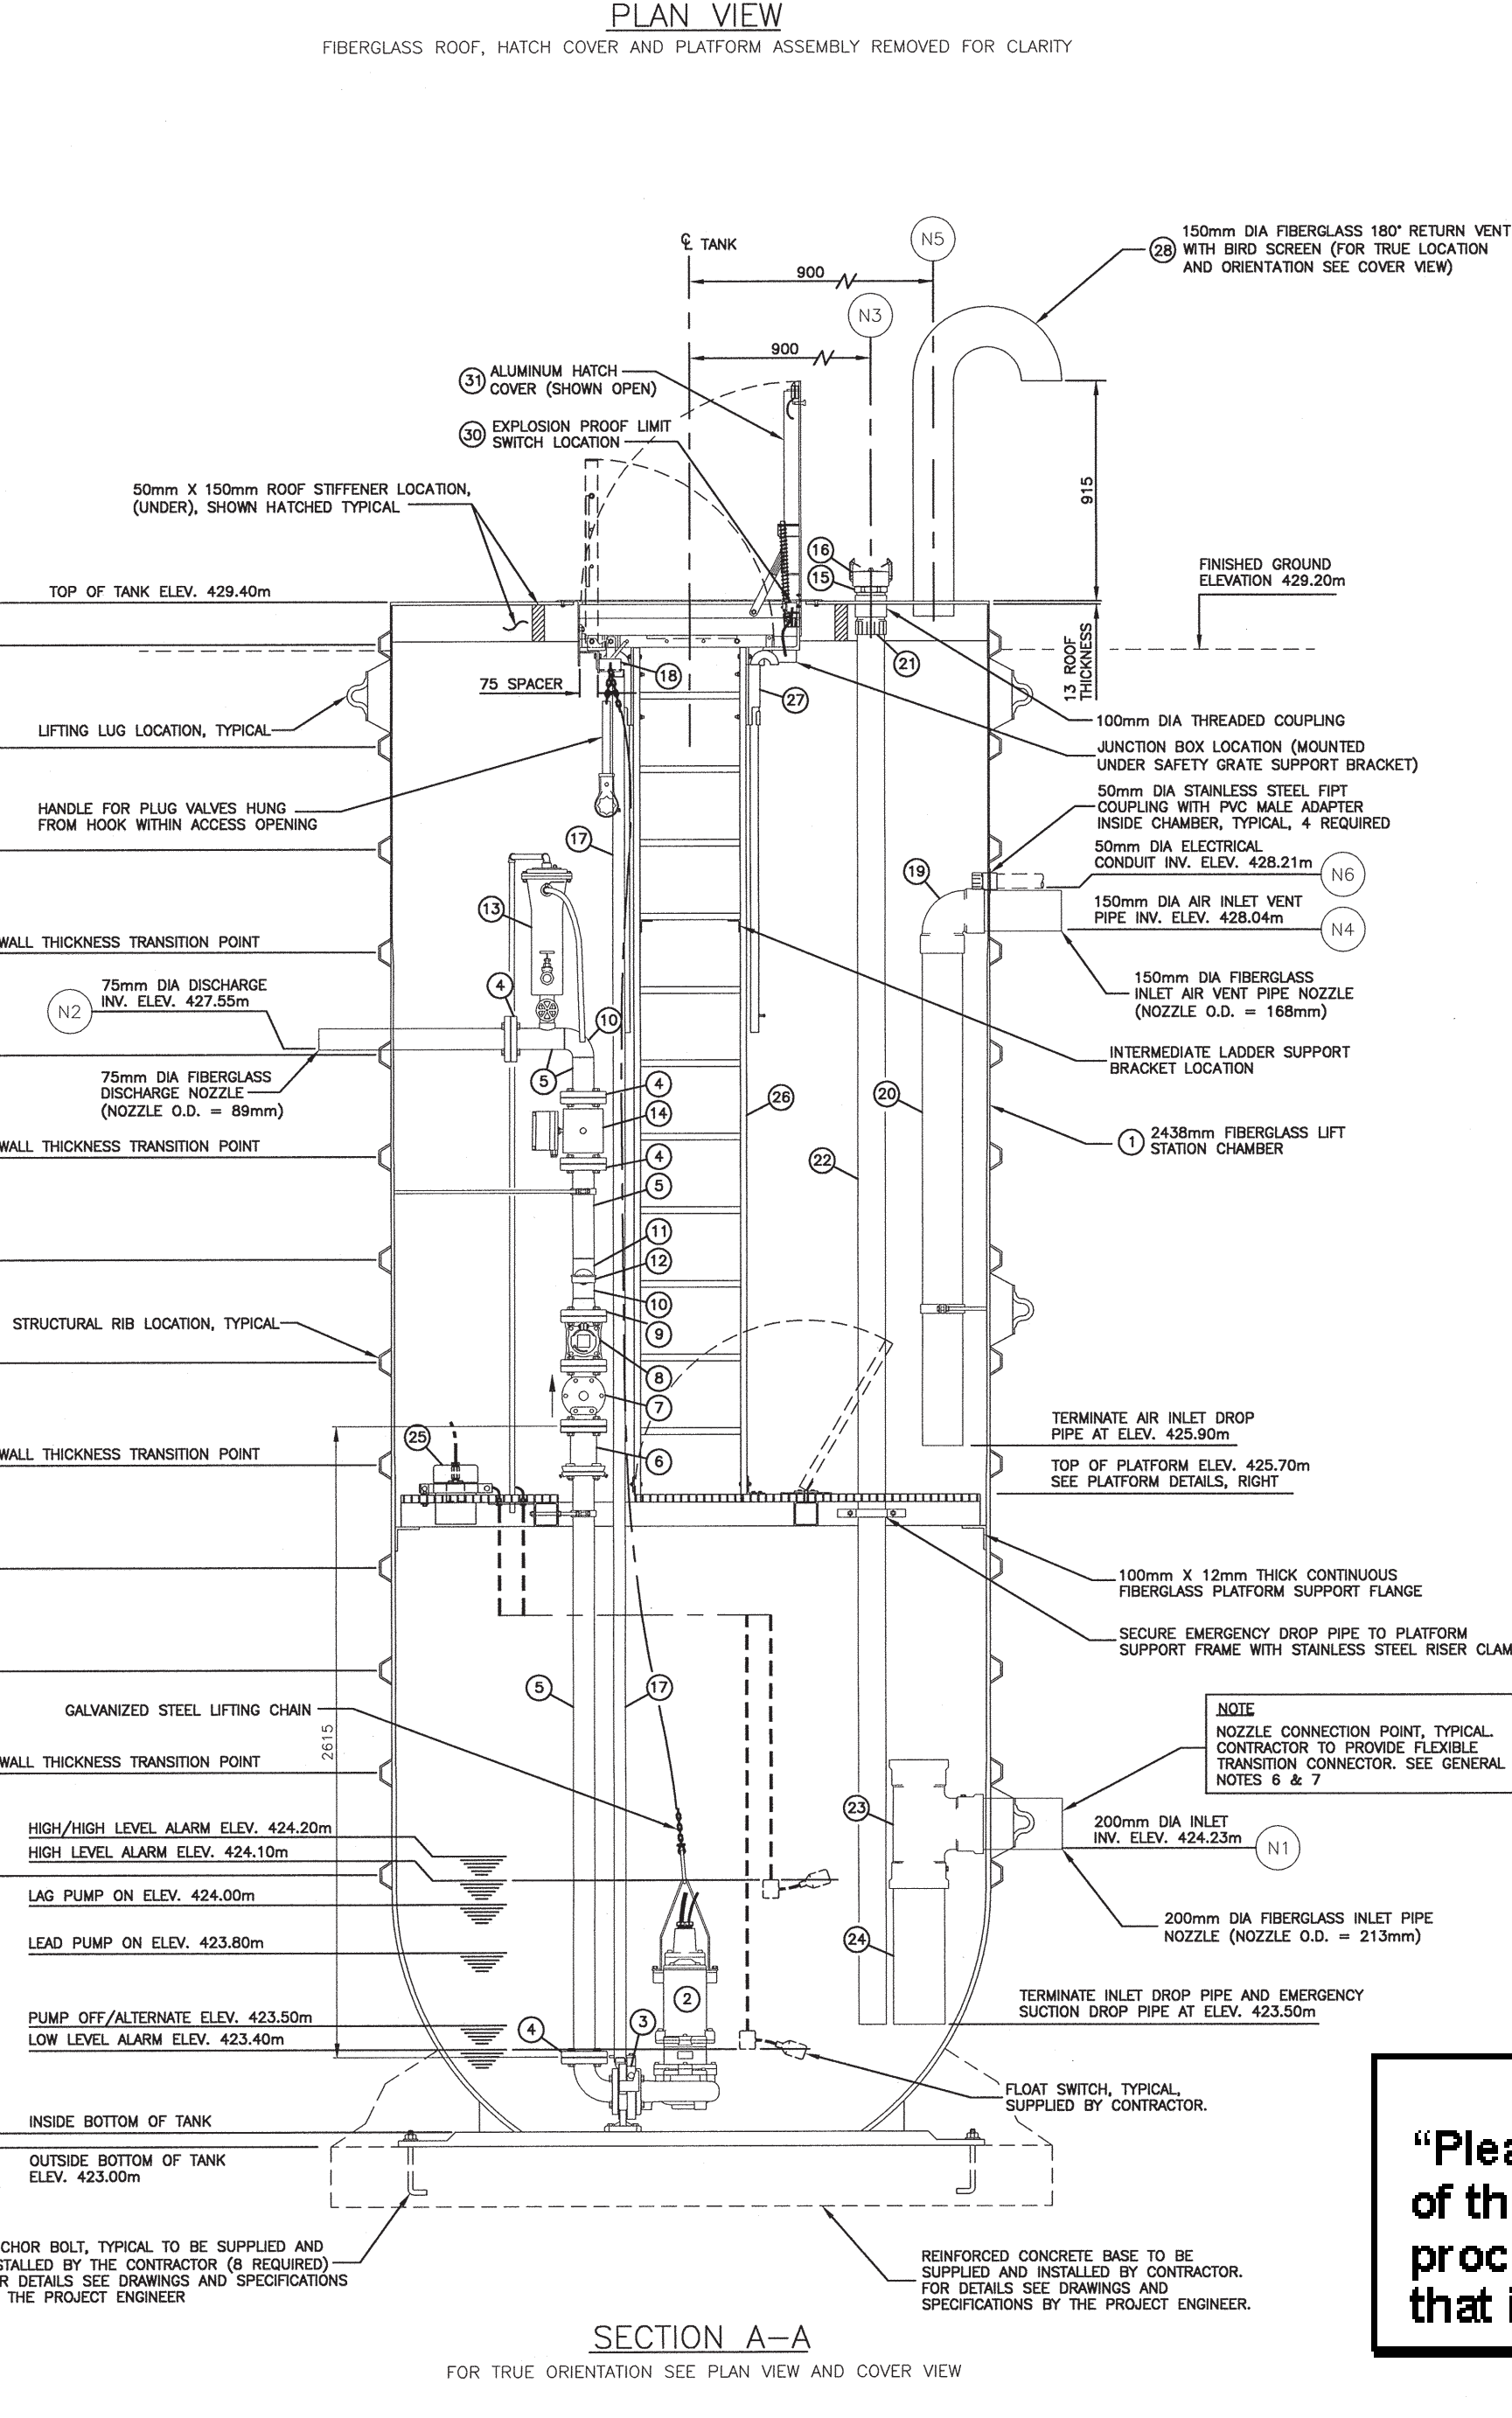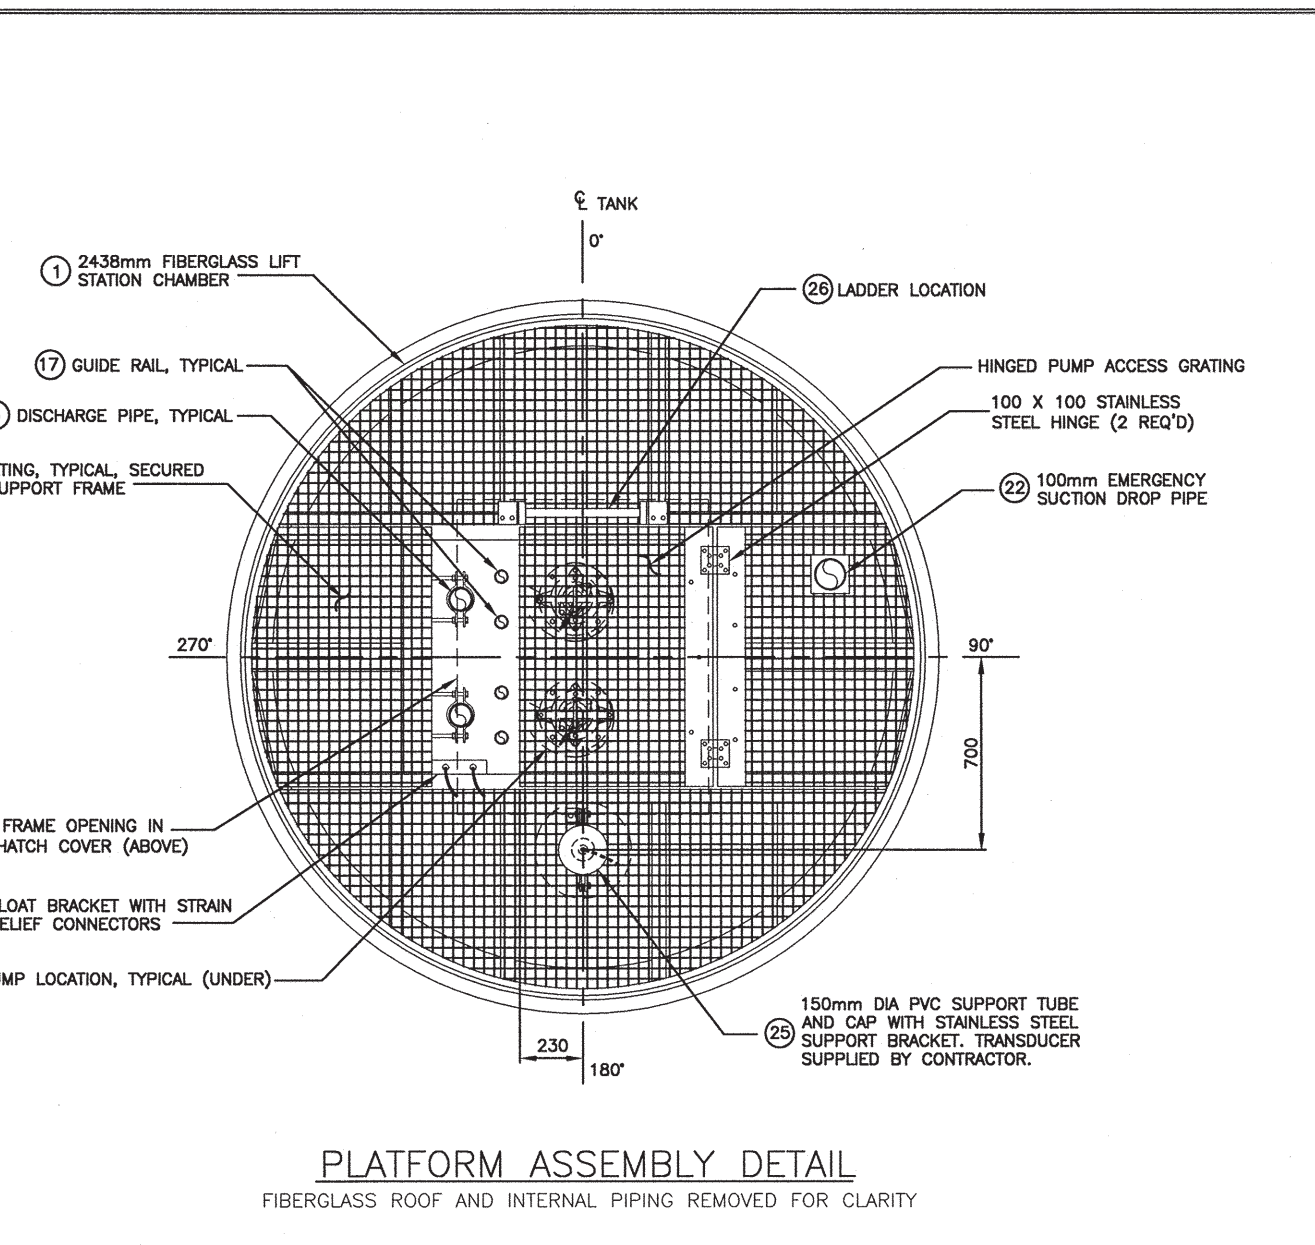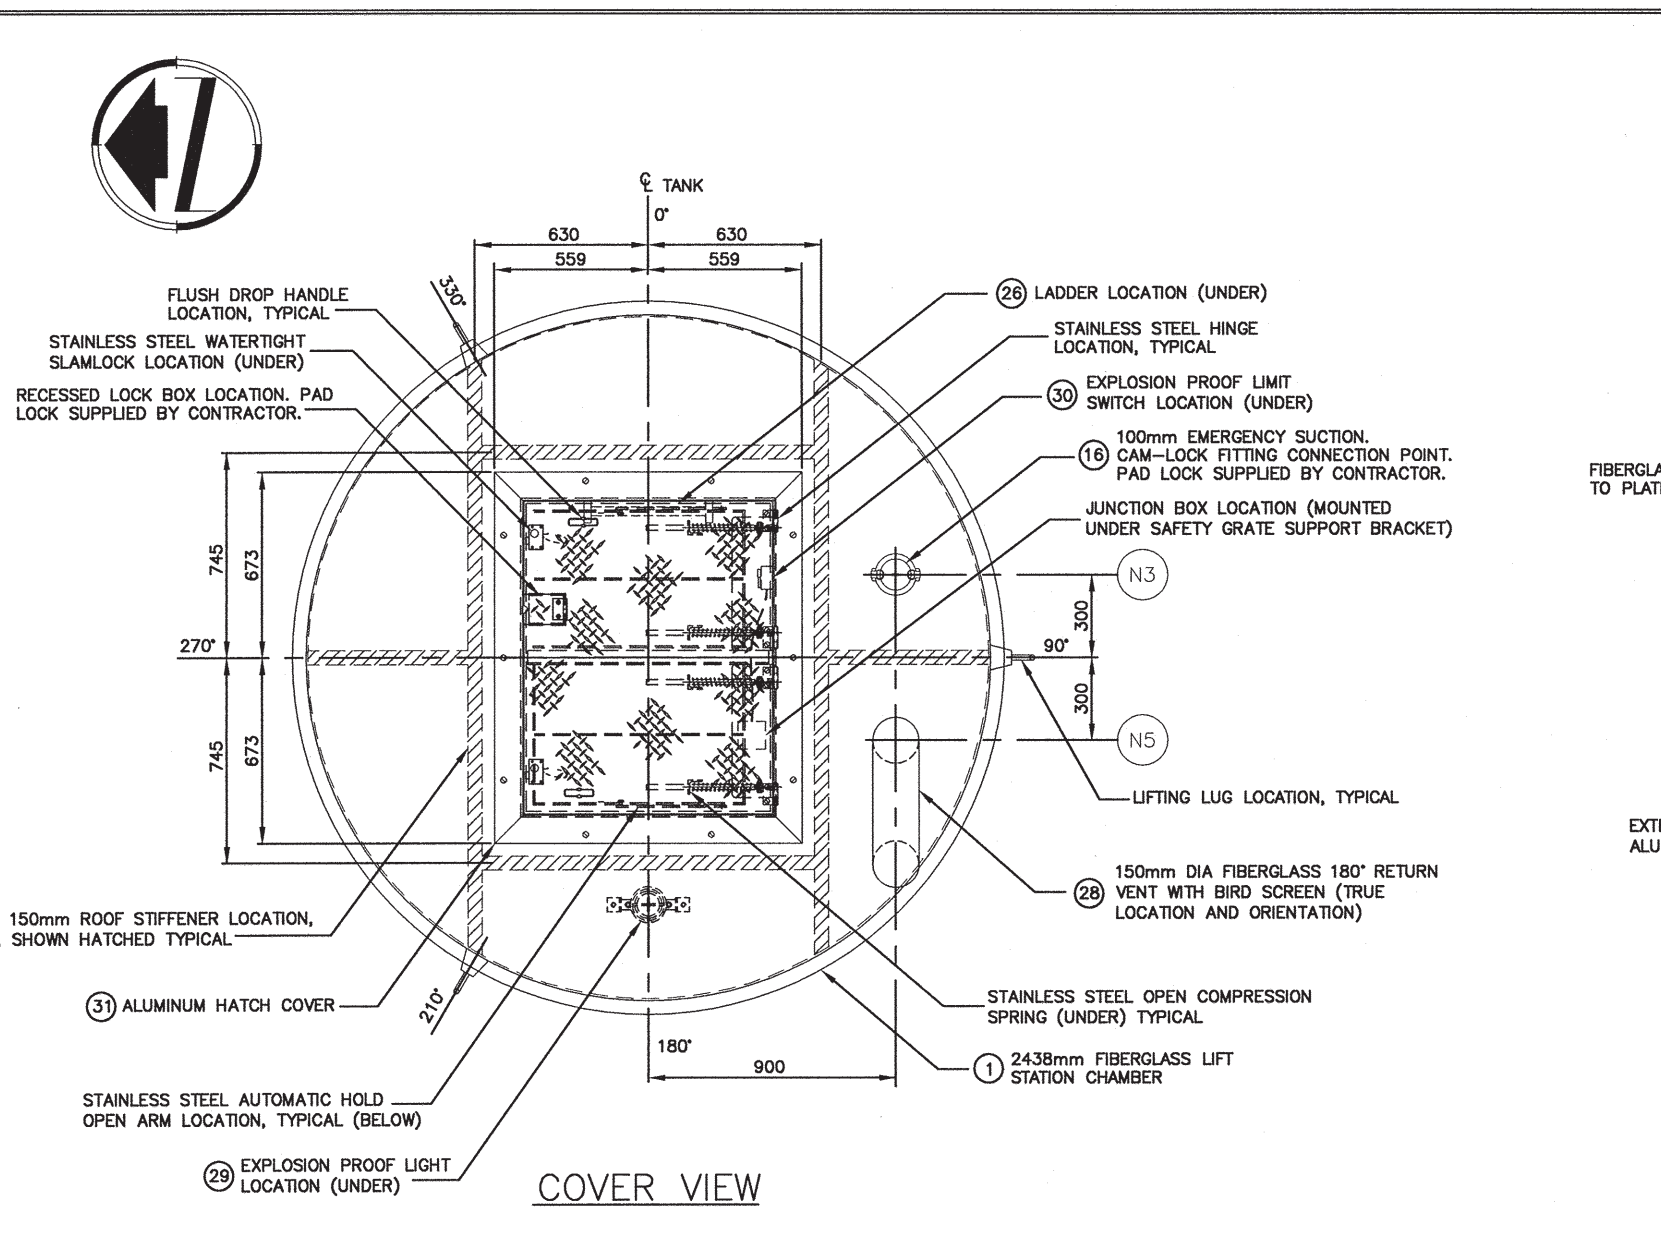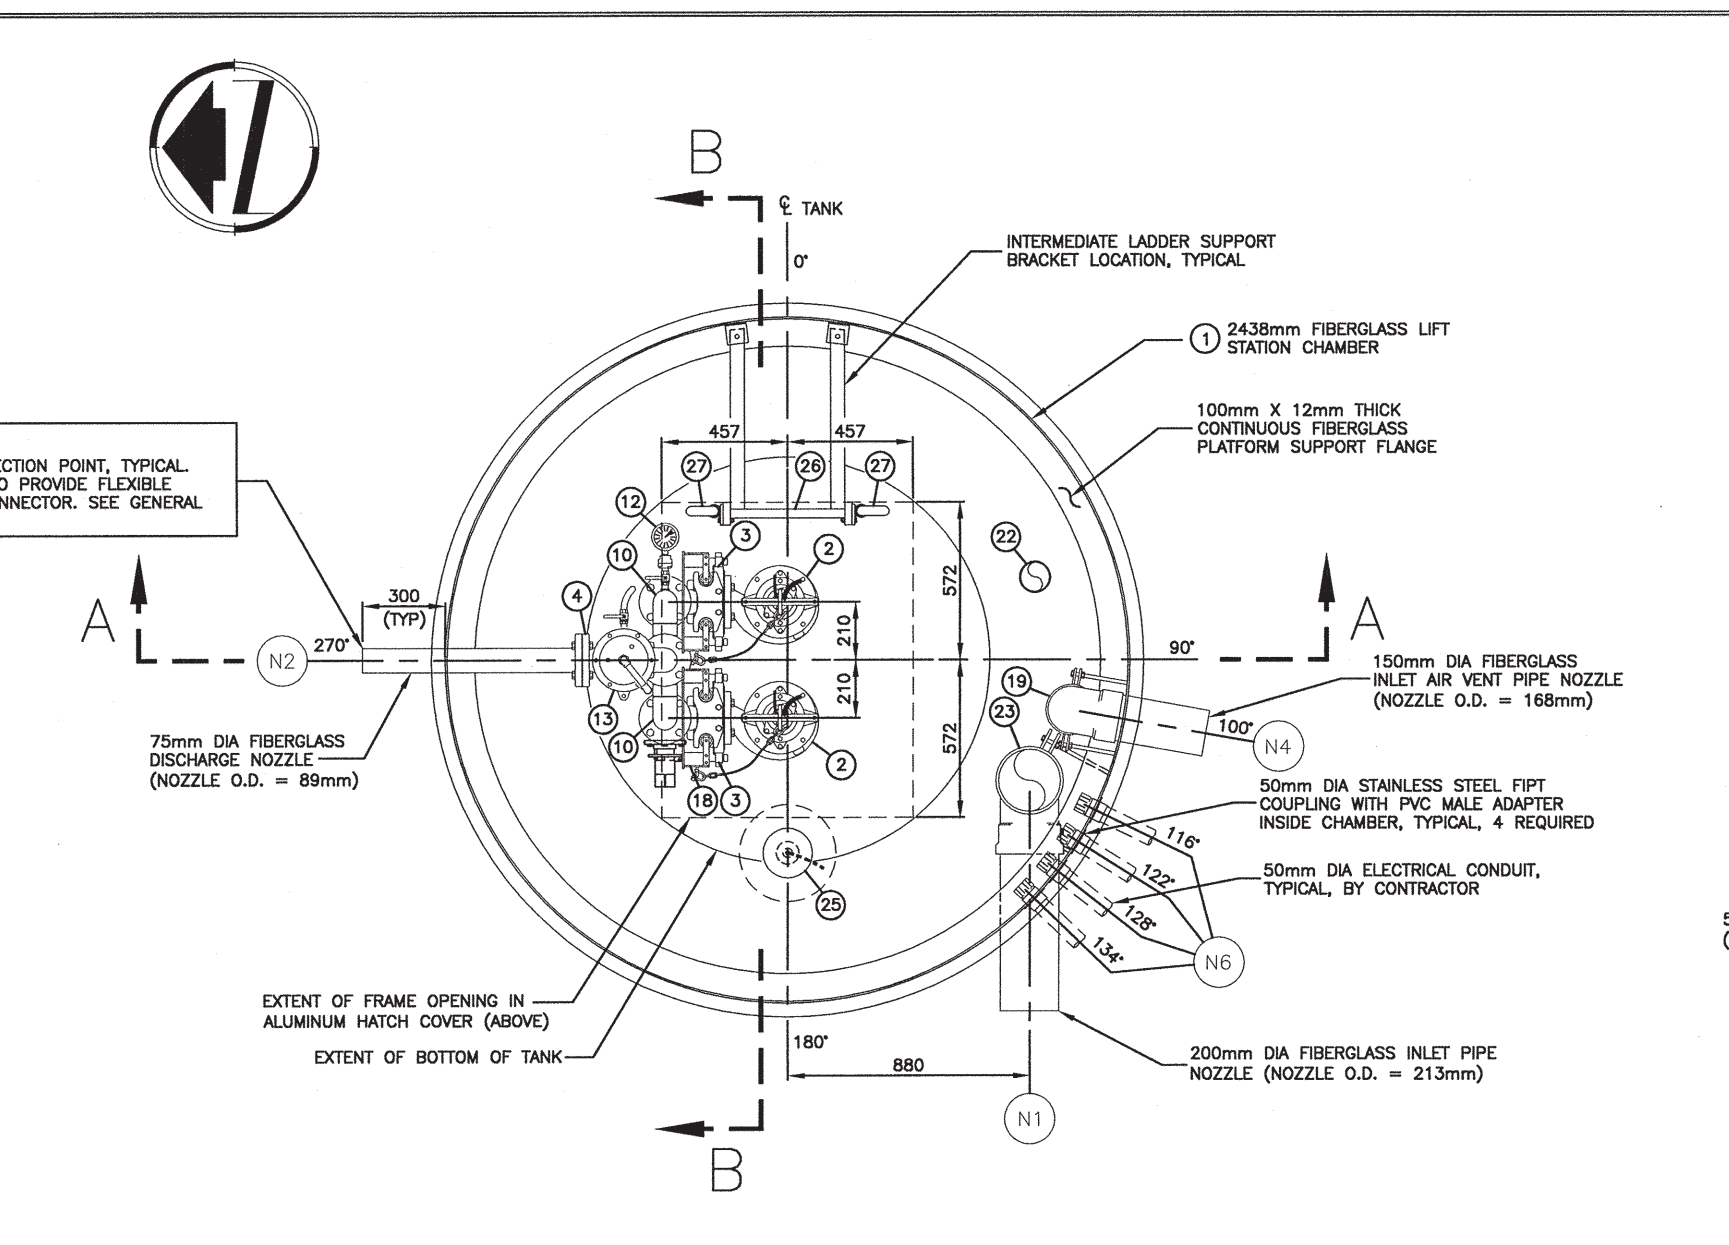

NOZZLE SCHEDULE

MARK UP	NOZ. SIZE	# REQ.	TYPE	SCH.	O.D.	END TYPE	HEIGHT FROM DATUM TO NOZZLE INVERT	DESCRIPTION
N6	50	4	S.S.	40	N/A	FIPT	5210	50 ELECTRICAL
N5	150	1	FRP	150	psi	N/A	180° RETURN	N/A EXHAUST AIR VENT
N4	150	1	FRP	150	psi	168	PLN.END	5040 300 INLET AIR VENT
N3	100	1	ALUM.	40	N/A	CAM LOCK	N/A	N/A EMERGENCY SUCTION
N2	75	1	FRP	150	psi	89	PLAIN END	4550 300 DISCHARGE
N1	200	1	FRP	150	psi	213	PLAIN END	1230 300 INLET



2	25/08/10	AS BUILT							
1	30/06/10	AS ISSUED FOR APPROVAL							
ISSUE NO.	D/M/Y DATE	DESCRIPTION	DR	CH	APP				
DISTRICT OF WEST KELOWNA PINERIDGE PLACE SEWAGE LIFT STATION									
SCALE	1:25	APPROVED BY	DRAWN						
DATE	JUNE/10		PROJECT						
GENERAL ARRANGEMENT									
engineered pump systems ltd. 10-314-M1									

"Please note that it is the user's responsibility to confirm the accuracy of the as-constructed information shown on this drawing before proceeding with any work (i.e. design or construction) that is based on that information."

MYERS ALTERNATIVE INSTALLED

FLYGT		PERFORMANCE CURVE			PRODUCT CP3045.181	TYPE HT	
DATE 2010-02-22	PROJECT Pineridge DWK 75mm FM <i>LS4</i>				CURVE NO 63-252-00-3164	ISSUE 1	
MOTOR COS PHI	1/1-LOAD 0.84	3/4-LOAD 0.77	1/2-LOAD 0.65	MOTOR SHAFT POWER	IMPELLER DIAMETER 90 mm		
MOTOR EFFICIENCY	77.5 %	77.5 %	74.0 %	STARTING CURRENT ...	15	A	MOTORTYPE
GEAR EFFICIENCY	---	---	---	RATED CURRENT ...	2.0	A	12-08-2BB
COMMENTS	INLET/OUTLET			RATED SPEED	3390	rpm	STATOR
NEVACLOG	- / 50 mm			TOT.MOM.OF INERTIA ...	---	---	05Y
	IMP. THROUGHLET			NO. OF BLADES	1		REV 10
	44 mm						FREQ.
							60 Hz
							PHASES
							3
							VOLTAGE
							600 V
							POLES
							2
							GEARTYPE

							RATIO

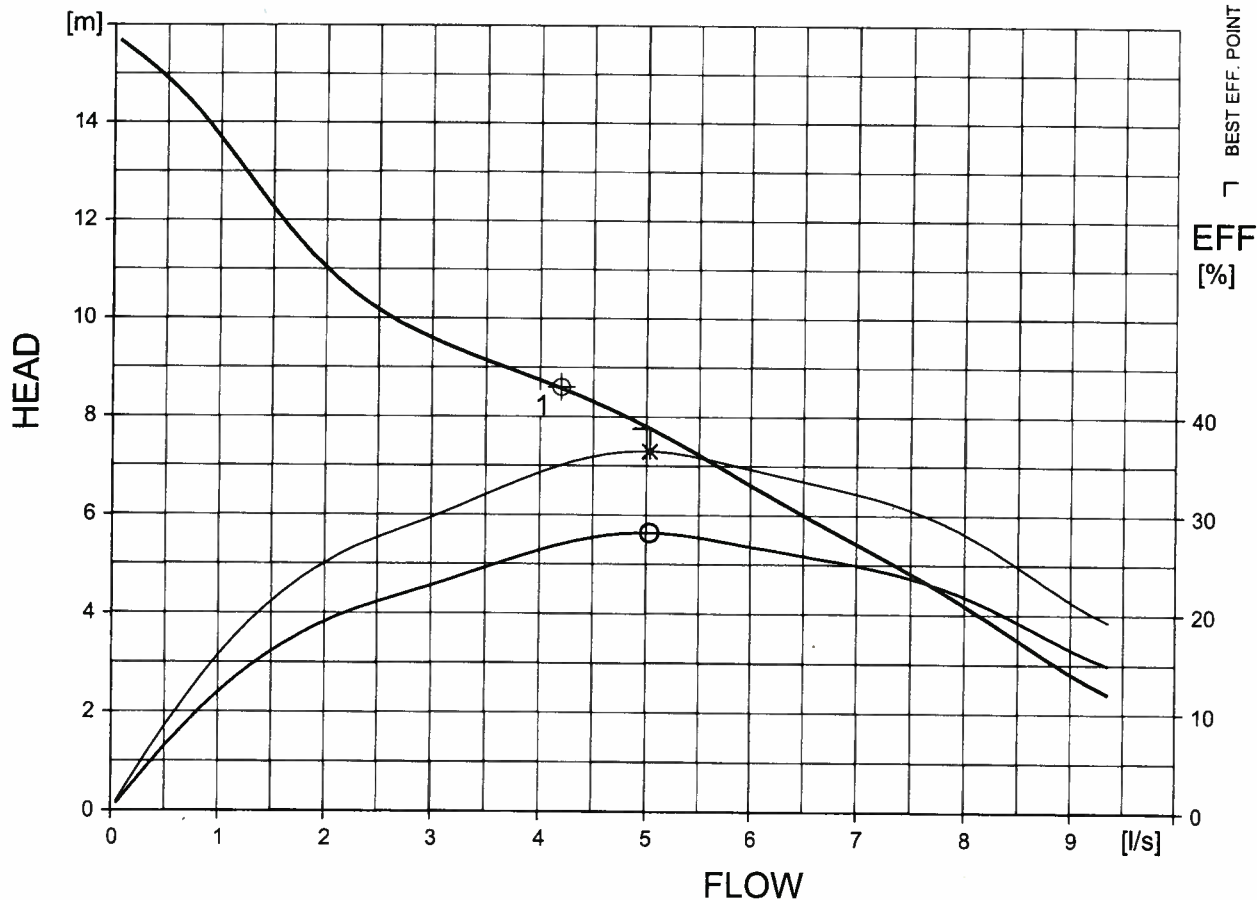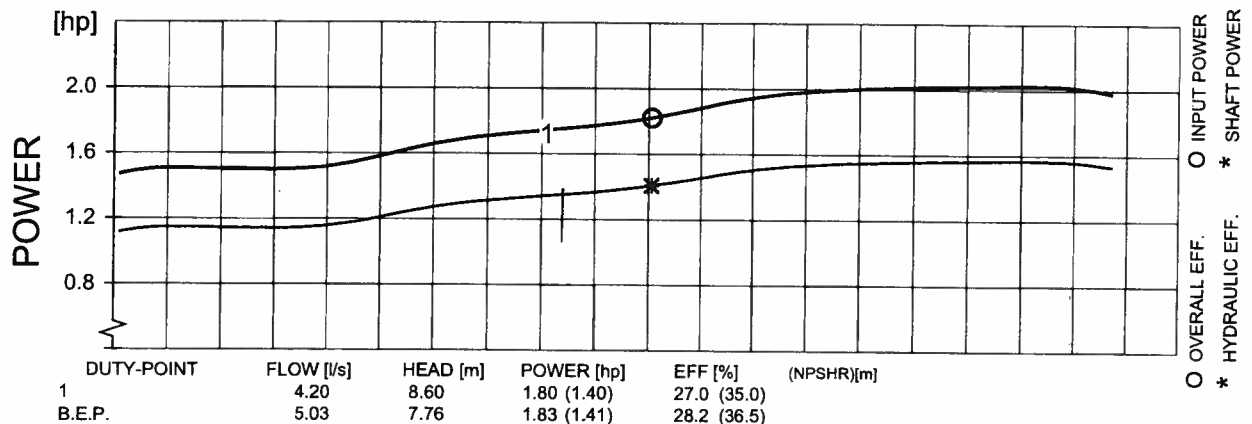

FLYPS3.1.5.7 (20060531)

Performance with clear water and rating data at 40 °C



CURVE



engineered pump systems ltd.

1635 INDUSTRIAL AVENUE, PORT COQUITLAM, BC V3C 6M9

PHONE: (604) 552-7900

FAX: (604) 552-7901

TOLL FREE: 1-800-668-4533

E-MAIL: epsl@telus.net

TO:

DATE:

May 10, 2010

QUOTATION NO:

10-314

ATTENTION:

REFERENCE:

District of West Kelowna
Pineridge Sanitary Sewer
Lift Station
"Myers Pump Alternate"

WE ARE PLEASED TO QUOTE AS FOLLOWS:-

QUANTITY	DESCRIPTION	UNIT PRICE	PRICE
1	<p><i>We are pleased to propose the following equipment as an alternate to the specified system for installation by others.</i></p> <p><u>General:</u> Factory built, wet well mounted, two (2) pump automatic underground pump station model EPS96.252.AF3V. The pump station chamber shall be fiberglass construction furnished in one (1) main section, 2.4 meters diameter, 6.4 meters deep. The pump station will be furnished with pumps, lift-out slide rail, piping, valves, ladder and platform landing.</p> <p><u>Pumps – Two (2) Required:</u> Pumps to be Myers model 3VX20M4-21-50 heavy duty cast iron submersible solids handling type sewage pumps factory tested, each with a capacity of 3.4 LPS (54 USGPM) against a total dynamic head of 8.2 meters (27 ft.) operating at a maximum speed of 1750 RPM. Pump motors to be 2 HP, 230 volt, single phase, 60 cycle, supplied with 50 ft. power and control cable. Pump motors to be CSA listed for Class 1, Division 1, Hazardous locations and supplied with heat sensor and seal leak features.</p> <p><u>Pump Slide Rail:</u> Each pump shall be assembled complete with a lift-out slide rail system. Each rail system shall include a 75mm (3") flanged cast iron discharge assembly, upper and lower guide rail supports, pump carrier and galvanized pump lifting chains. Four (4) lengths 38mm (1 1/2") galvanized steel guide rails shall be factory installed.</p> <p><u>Piping and Valves:</u> A 75mm (3") cast iron swing check valve Flomatic Flow Flex model 745 and a 75mm (3") plug valve with lever operator shall be factory installed on the discharge of each pump.</p> <p style="text-align: right;">.../2</p>		

Piping and Valves continued...

Piping shall be schedule 40 steel, fabricated to suit the installation. Two (2) 75mm (3") discharge risers shall be furnished for connection to a common 3" discharge. Header supplied with 12mm (1/2") gauge coupling, ball valve and 4" ENFM liquid filled pressure gauge with stainless steel diaphragm seal and 2" coupling, ball valve and Flomatic Sewair – mini air release valve with back flush attachments. Flange adapters shall be installed at each check valve for ease of service. After fabrication all piping to be blast cleaned and epoxy coated to AWWA standards. All nuts, bolts and washers to be 300 Series stainless steel. Discharge nozzles shall terminate with plain ends. A 4" PVC emergency suction line with camlock fitting and drop pipe shall be installed with stainless steel support clamps.

Fiberglass Chamber:

The pump chamber shall be spray and chop FRP construction, manufactured in accordance with ASTM D883, ASTM-D3753 and CGS41.GP.22 standards for underground fiberglass tanks. The chamber shall be furnished in one (1) main section, 2.4 meters diameter, 6.4 meters deep. The tank sidewall shall be reinforced with sufficient structural ribs to withstand loading. The bottom shall have a reinforced fiberglass anti-floatation flange on the exterior and cone type benching on the interior. An aluminum platform landing with hinged pump access hatches shall be installed at an intermediate elevation. An aluminum ladder to ANSI and CSA standards shall be installed terminating at the platform level. Two (2) stainless steel retractable hand grabs shall be provided.

Inlets, discharge, vent and electrical nozzles shall be furnished where necessary. To include 1-200mm (8") inlet, 1-75mm (3") discharge, 4-50mm (2") electrical and 1-150mm (6") FRP roof mounted vent. A float and transducer support shall be factory installed. An FRP station roof shall be furnished with double leaf retrofit type aluminum hatch with hatch stay, oversized recessed lockbox, stainless steel compression spring lift assist, slamlock, hinged safety grate, and upper rail supports. An explosion proof 100w light fixture shall be roof mounted inside the wet well.

Fiberglass tank structural design drawings to be certified by a Professional Engineer registered in B.C.

Flow Meter

A Siemens Sitrans Flow Meter model FM3 MAG 5100W shall be supplied with remote totalizer and 20m of cable. Flow meter rated Class 1, Division 2 locations.

2

Myers seal leak heat sensor alarm control units. Supplied loose for panel mounting by others.



District of West Kelowna

Sanitary Lift Station Evaluation

Station: Hitchner-Jennens LS 5
Inspection By: Jim Kentel

Year Constructed: 5/1/2000
Year Upgraded:

Matrix Rating			
(10 - highest rating)	Civil	40	
(1 - lowest rating)	Process Mechanical	150	
	Electrical Instrumentation	104	
	Total Station Rating	294	(max. rating 370 points)



Civil:Matrix
Rating

Parking Area:	_____	n/a
Drainage:	Good	10
Influent sewer:	Gravity 200 PVC	10
Site access:	Good	10
Water service:	Yes Yard Hydrant	10
		40









Process Mechanical:Matrix
Rating

Station type:	Submersible FRP 2.44m tank	n/a
Number of pumps:	2	n/a
Pump Redundancy:	Yes	n/a
Pump Manufacturer / Type:	FLYGT Grinder	10
Pump Model:	MP3102 LT	n/a
Rated Capacity:	_____	n/a
Capacity Confirmation:	_____	n/a
Forcemain pipe type / diameter:	PVC/100	10
Header pipe type / diameter:	75 FRP	10
Check valve type / diameter:	HDL / 75	10
Isolation valve type / diameter:	CI Plug Valve/75	10
Piping Condition:	Good	8
Emergency pumpout connection:	Yes	10
Pressure gauges:	No	1
Inlet bar screen:	No	1
Wetwell condition:	Good	10
Access Hatches:	Alum MSU	10
Ladder / Platform:	Alum/FRP	10
Wetwell benching:	Yes FRP	10
Odour Control:	Yes chemical feed from May to June by RDCO	10
Ventilation:	Yes	10
Water washdown:	Yes	10
Confined Space Entry Requirements	Davit	10
		150

Electrical / Instrumentation:

Matrix
Rating

Service Type	V / A / Phase / Wire	n/a
Pump 1 :	HP 6.0	n/a
	Volts 600 Rpm 3500	n/a
	FLA 5.7A	n/a
Starting Current	44.0A	n/a
Pump 2 :	HP 6.0	n/a
	Volts 600 Rpm 3500	n/a
	FLA 5.7A	n/a
Starting Current	44.0A	n/a
Alarm Functions:	Yes	10
		n/a
		n/a
		n/a
Receptacle	Yes	10
Interior Lighting:	Yes	10
Exterior Lighting:	No	1
SCADA / Telemetry:		5
Main Breaker:		10
Control Panel:	Yes	10
Lighting Panel:	Yes	10
Flowmeter:	No	1
Grounding:	Yes	10
Surge Protection:	Yes	10
UPS:	Yes	10
PLC:	Yes	1
Level Control:	Yes Milltronic bulb	5
Standby Generator:	No	1
		104
Comments:		

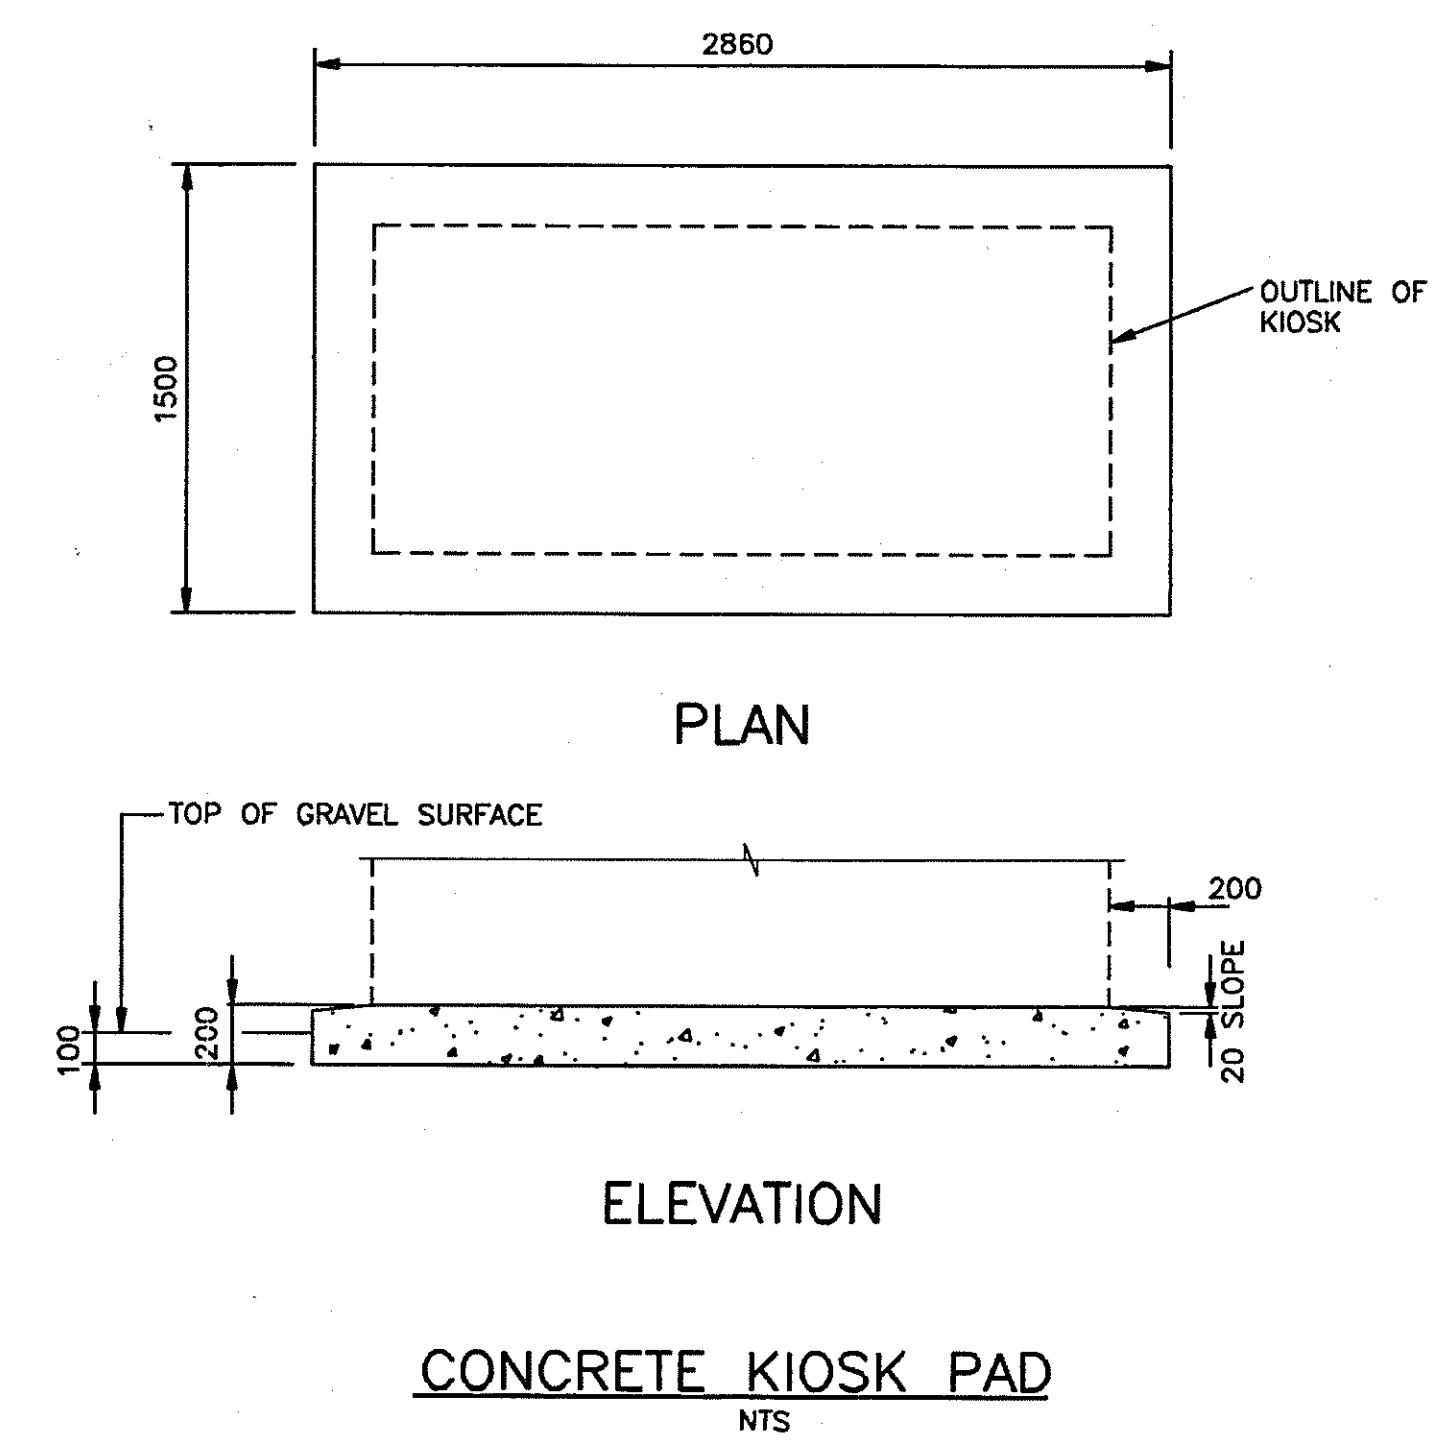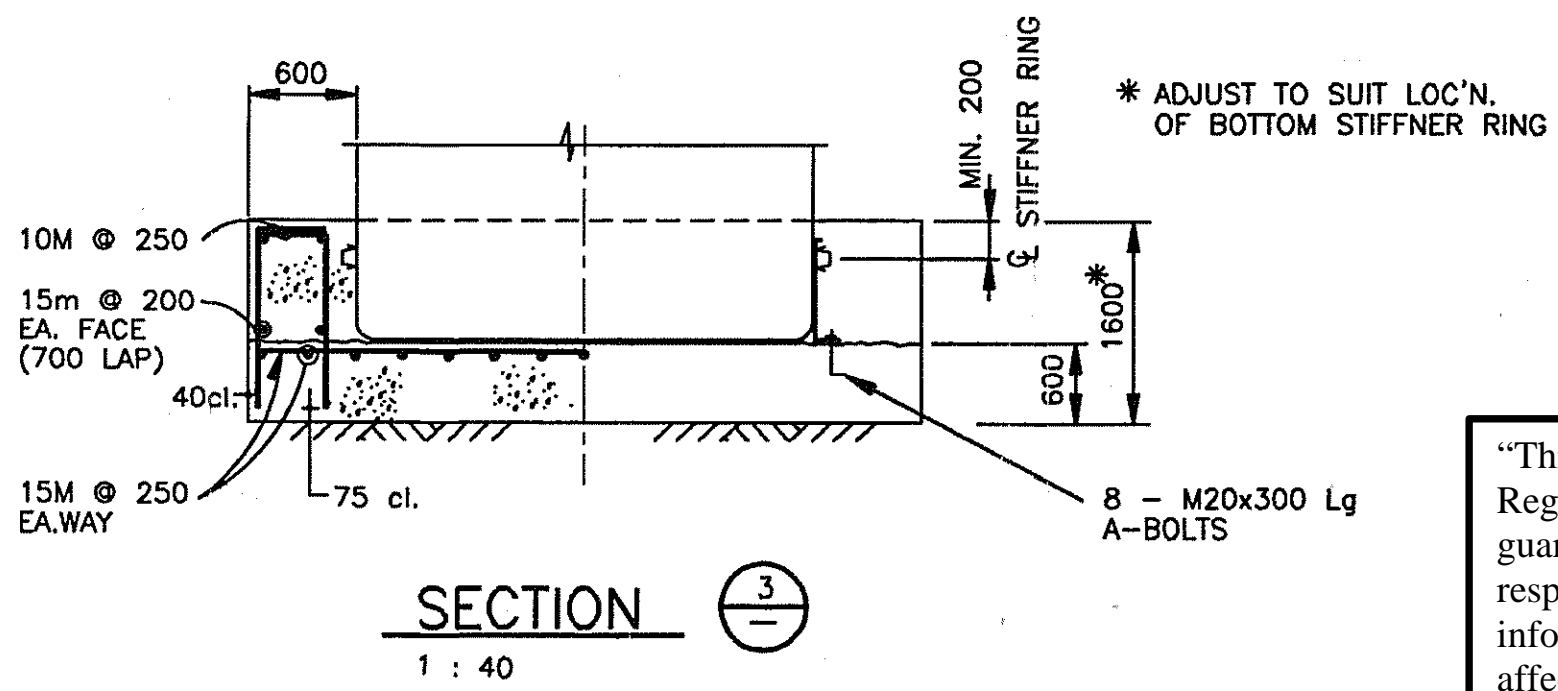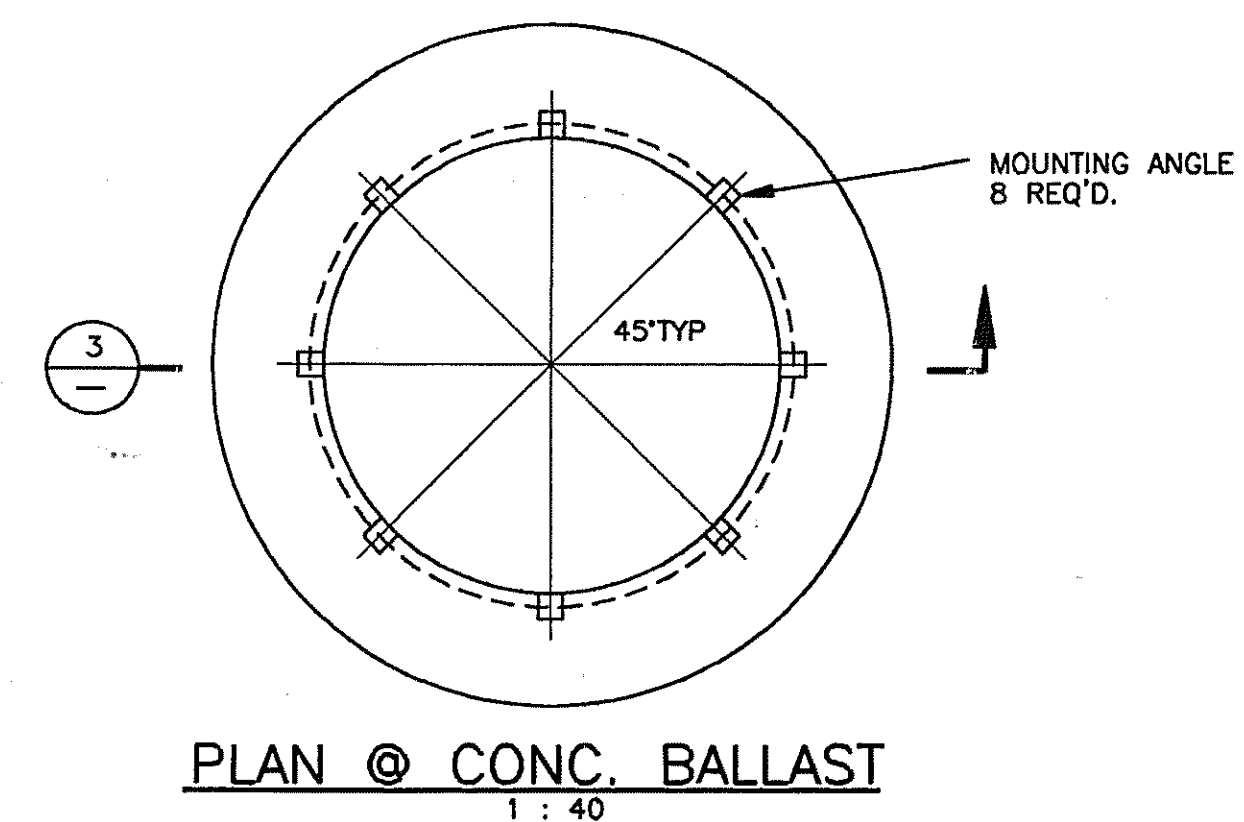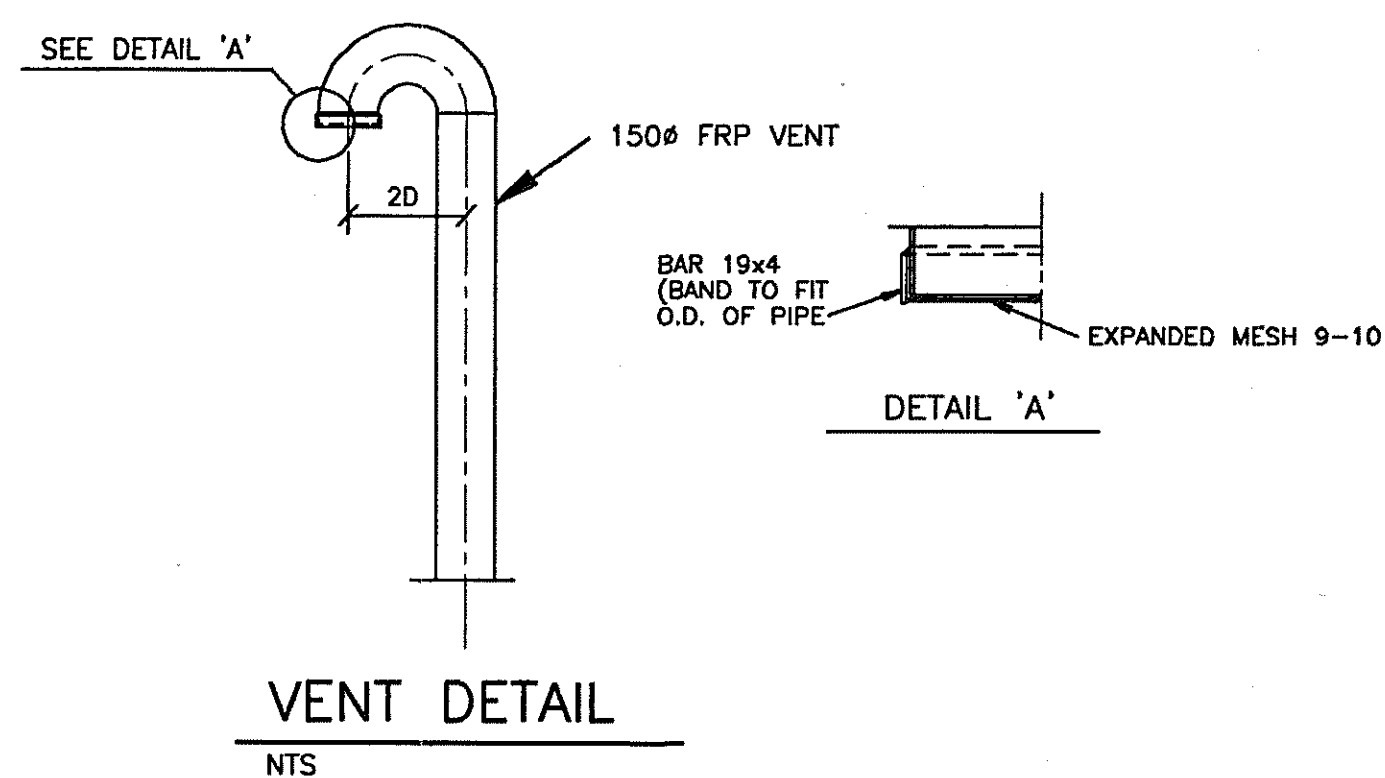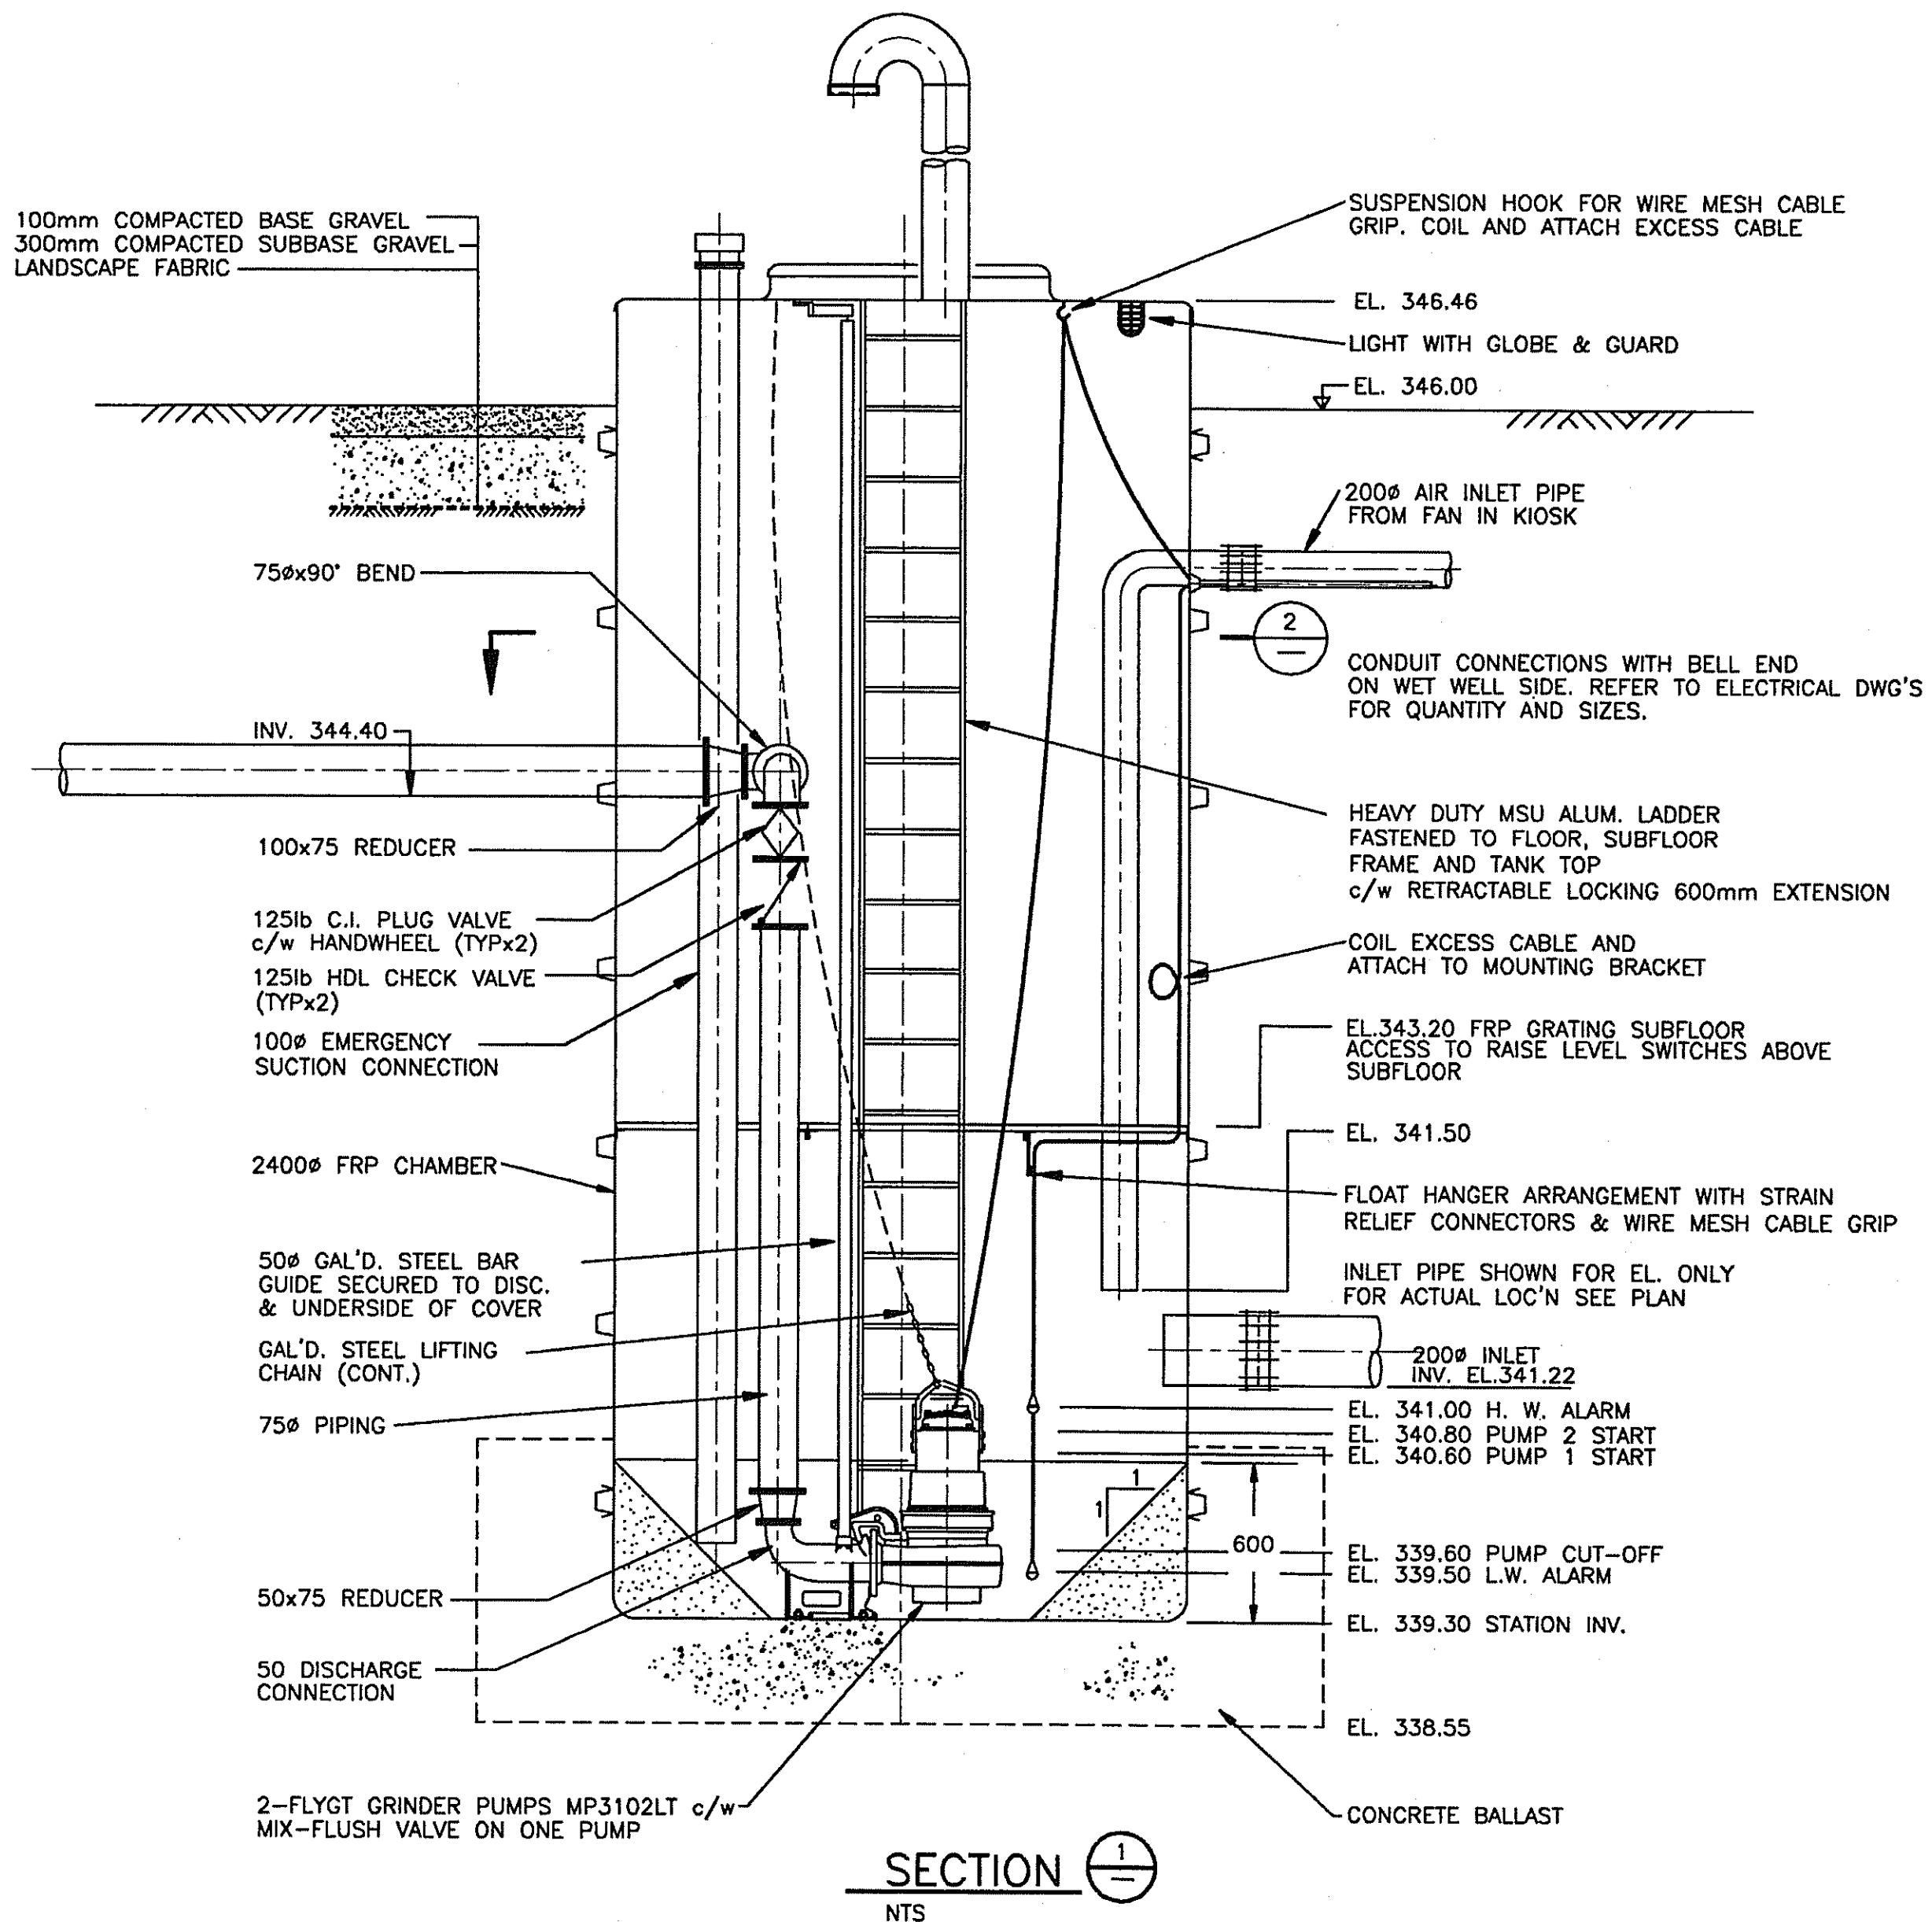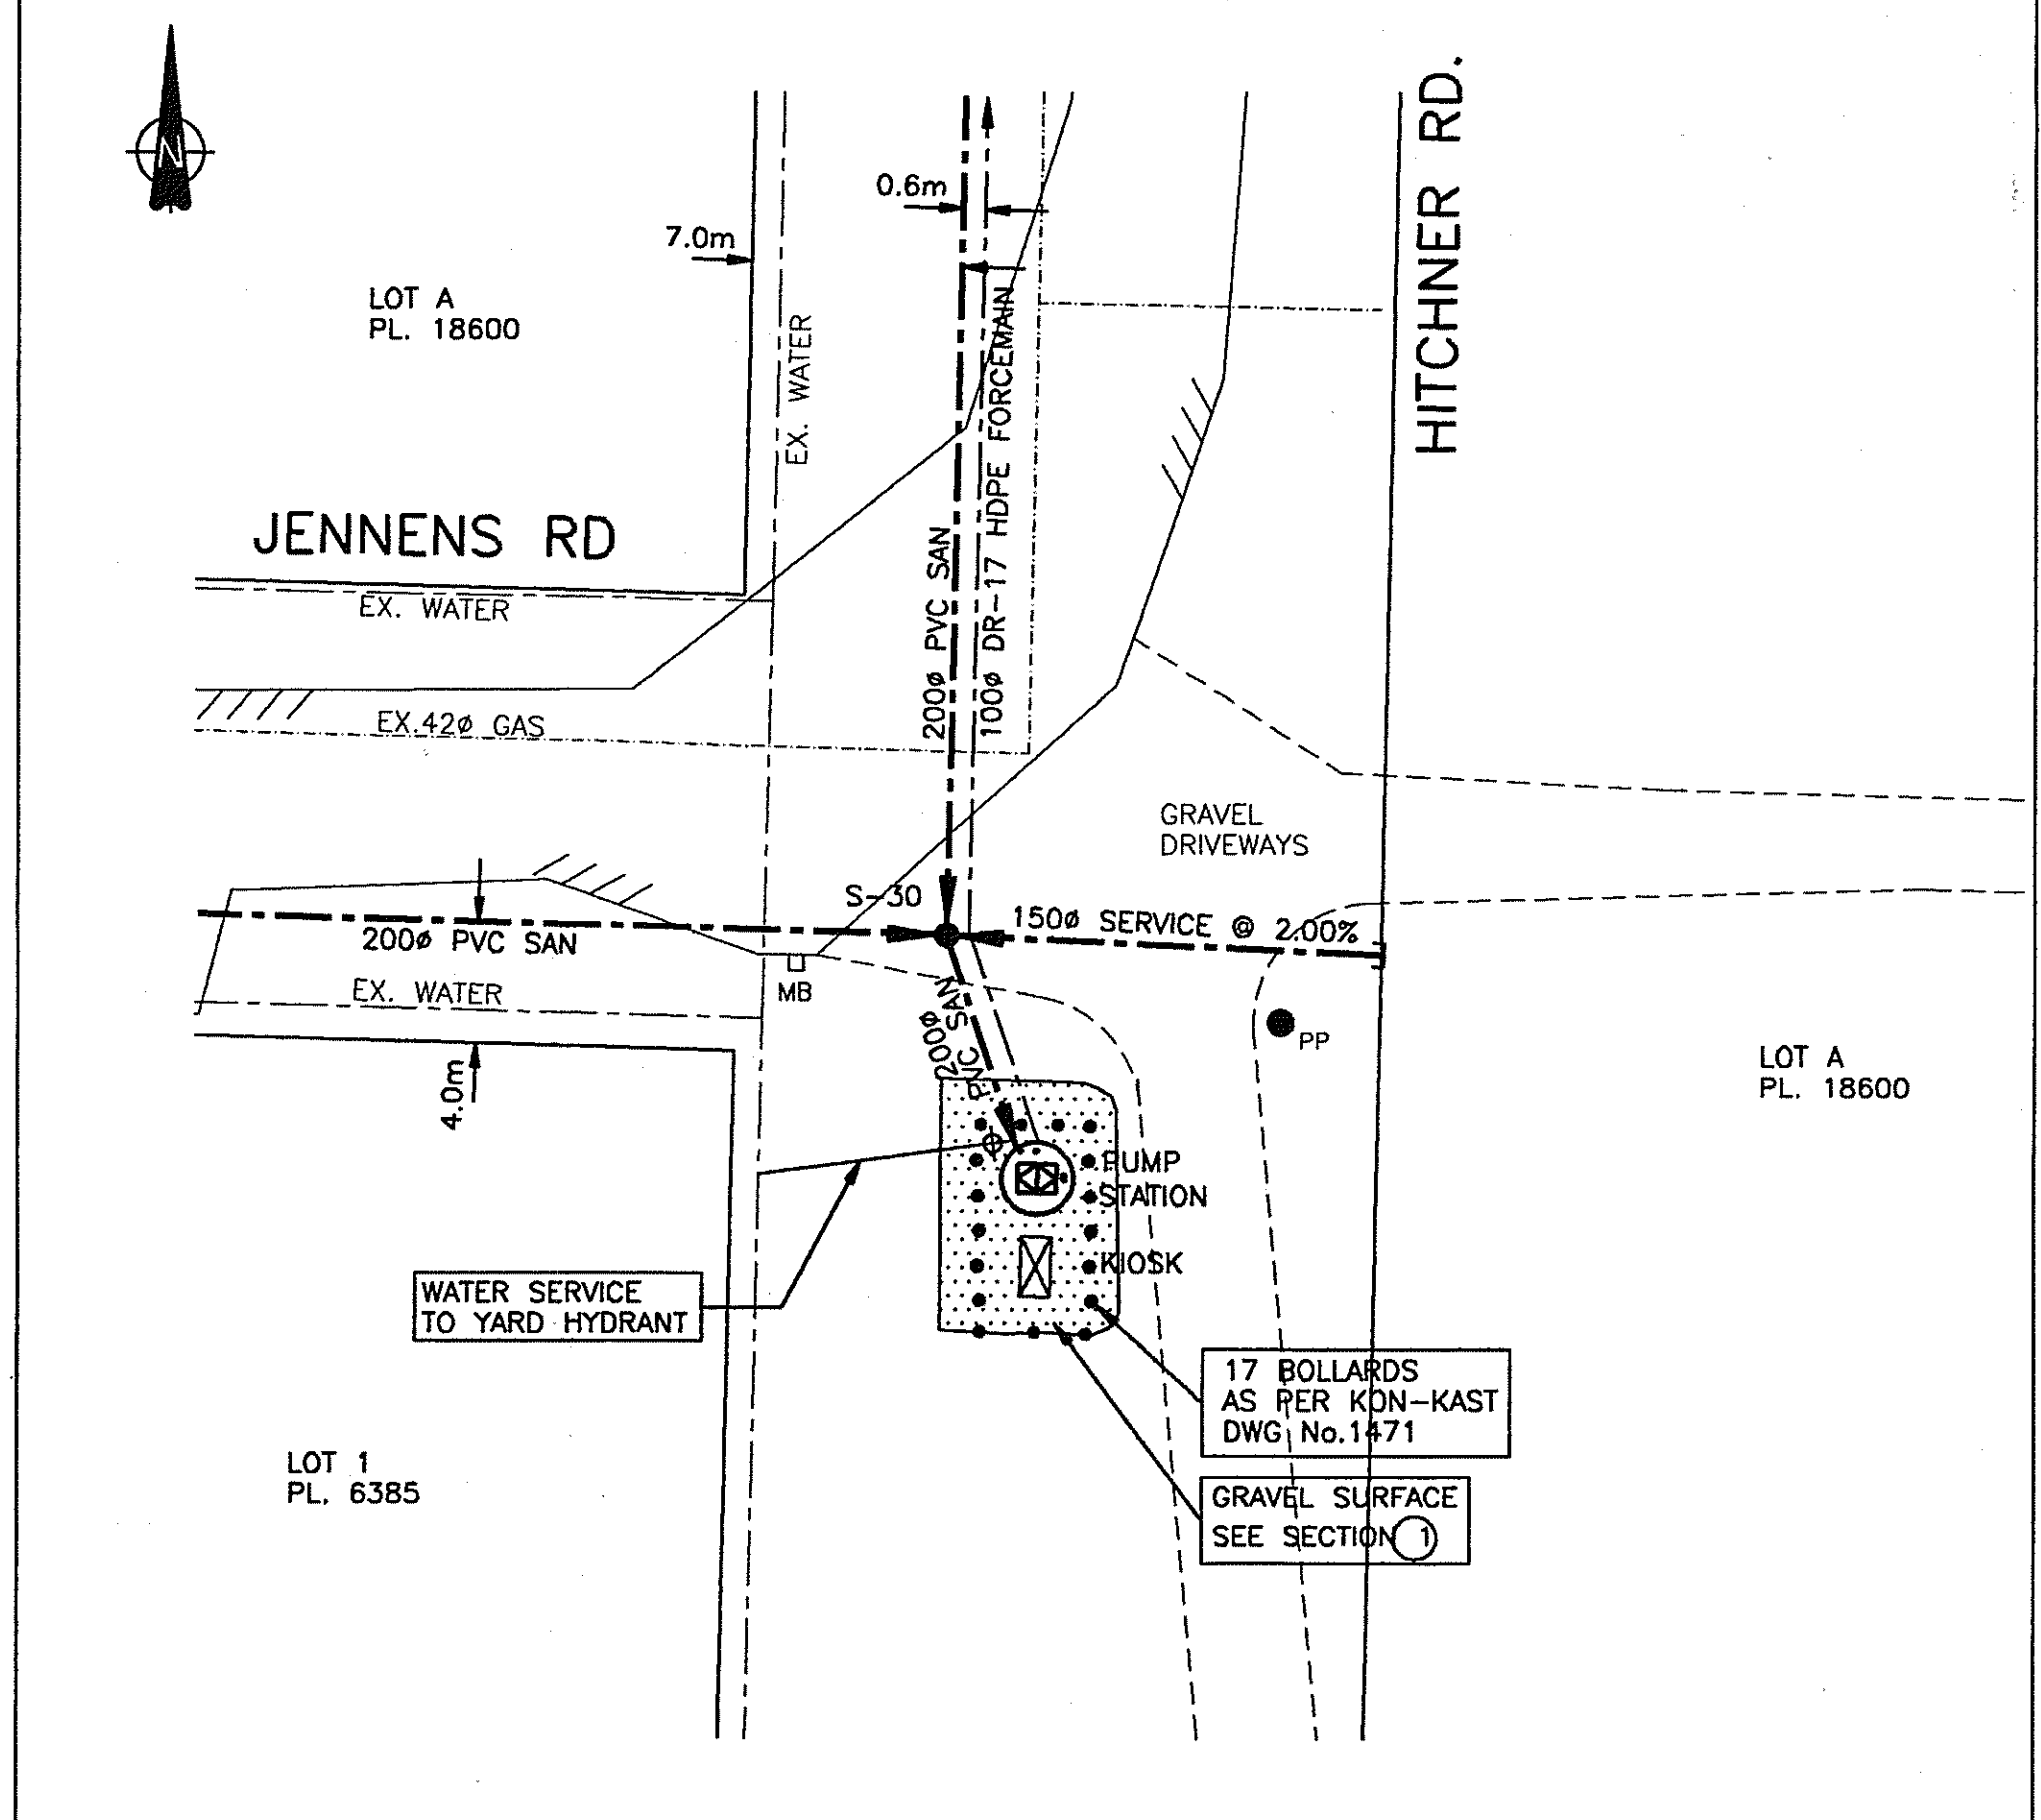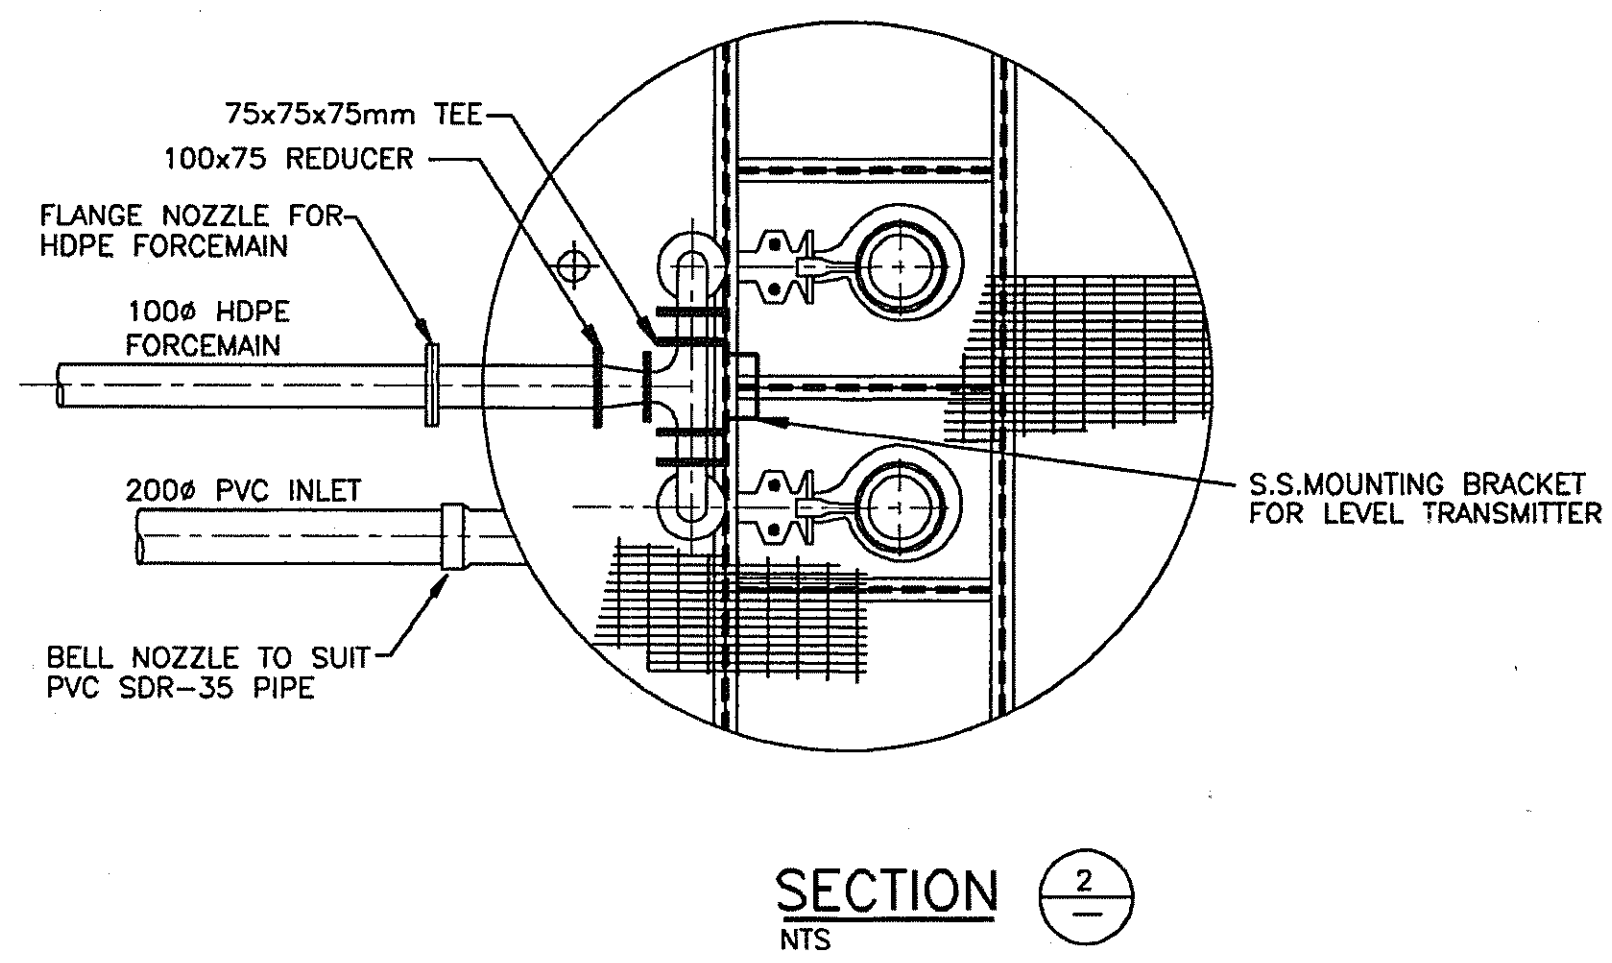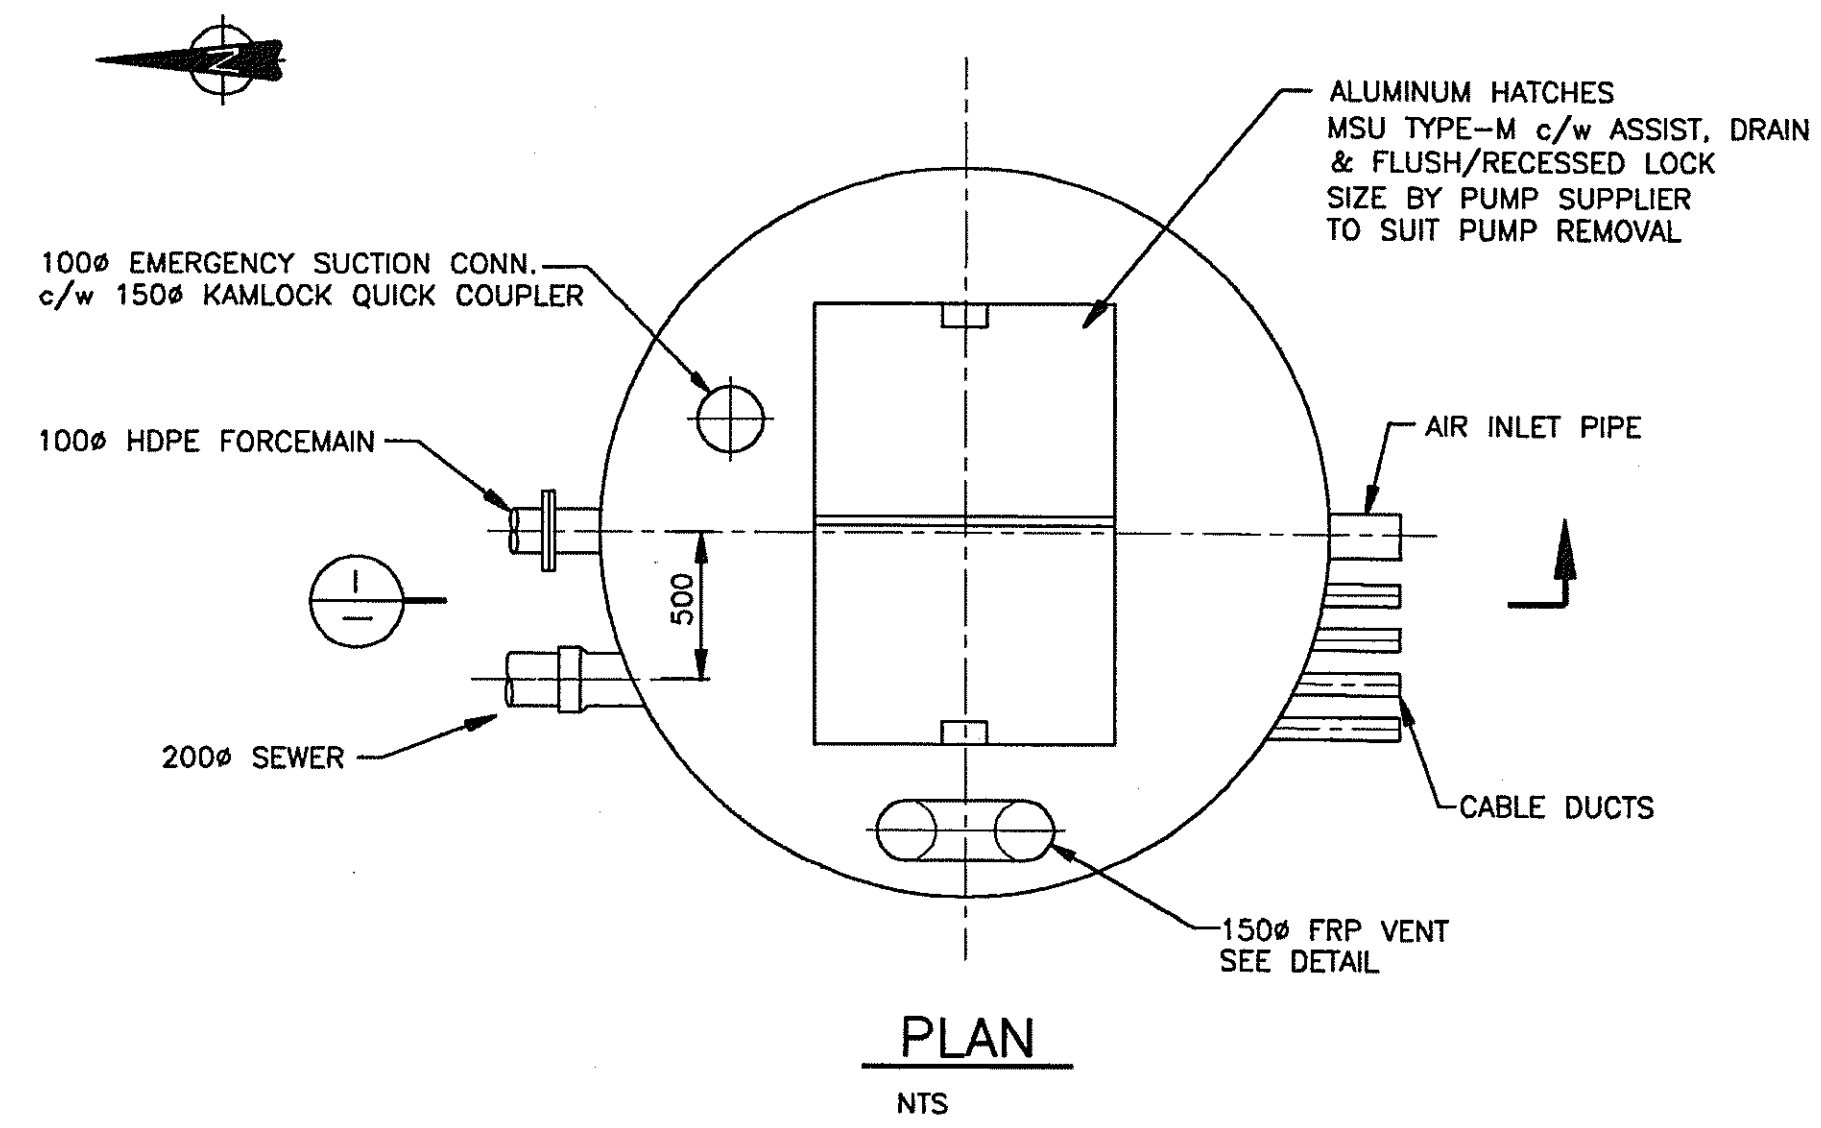


"This as-constructed information was not prepared by the Regional District of Central Okanagan and therefore there is no guarantee of its accuracy. It is the recipient's and user's responsibility to confirm the accuracy of this as-constructed information before proceeding with any work that may be affected by this as-constructed information."

NOTE: FOR CONDUIT CONFIGURATION AND KIOSK PAD BLOCKOUT LOCATIONS REFER TO INTERIOR INSTRUMENT TECH SERVICES LTD. DRAWING HIT-E-106


WATER	_____
SAN	_____
STORM	_____
GAS	_____
UGTEL	_____
UGELEC	_____
CENTER	_____

HYDRANT	+
MANHOLE	○
CATCH BASIN	□
POWER POLE	• PP
LAMP STANDARD	□ LS

No.	Date	By	Revision	Ch'd
4	15.05.00		RECORD DRAWING	
3	31/01/00		ISSUED FOR CONSTRUCTION	
2	DEC.2/98		ISSUED FOR BID	
1	JUL'97		ISSUED FOR APPROVAL	

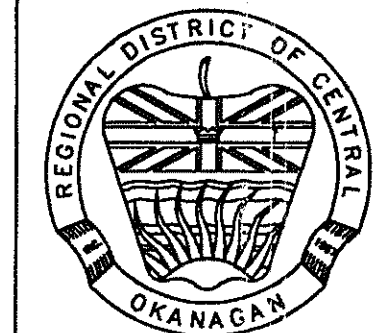

Drawn	KR
Design	AA
Approved	
Date	APR' 1997
Scale	H= 1:500 V= 1:50

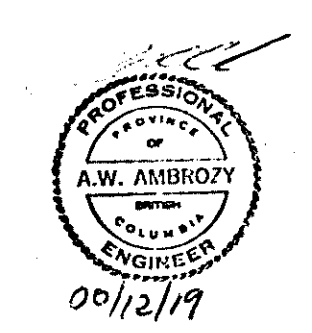

REGIONAL DISTRICT CENTRAL OKANAGAN
WESTSIDE SANITARY SEWER PROJECT
JENNENS & HITCHNER ROADS
SEWAGE PUMP STATION DETAILS

Drawing No.	2621-R-105
Rev.No.	4





PERFORMANCE CURVE

PRODUCT	MP3102.170	TYPE	LT
---------	------------	------	----

DATE	2013-10-25	PROJECT	HITCHNER - JENNENS LS 5	CURVE NO	63-212-00-5210	ISSUE	6
------	------------	---------	-------------------------	----------	----------------	-------	---

MOTOR COS PHI	0.93	0.91	0.87	MOTOR SHAFT POWER	6	hp	IMPELLER DIAMETER			
MOTOR EFFICIENCY	80.5 %	80.5 %	78.5 %	STARTING CURRENT ...	44	A	149 mm			
GEAR EFFICIENCY	—	—	—	RATED CURRENT ...	5.7	A	MOTORTYPE	STATOR	REV	
COMMENTS				RATED SPEED	3475	rpm	18-10-2AL	52D	11	
				TOT.MOM.OF INERTIA ...	---		FREQ.	PHASES	VOLTAGE	POLES
				NO. OF BLADES	6		60 Hz	3	600 V	2
							GEARTYPE	RATIO		
							---	---		

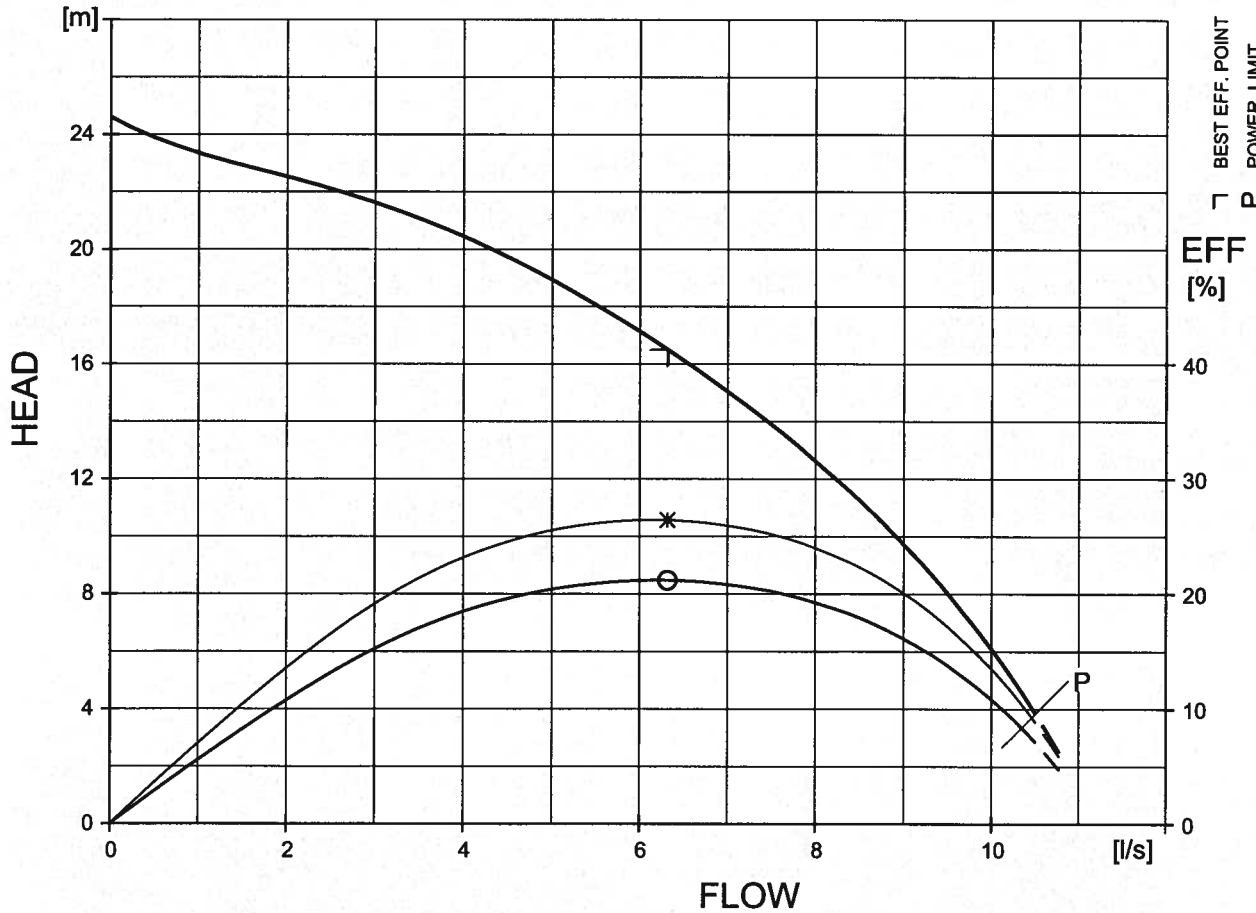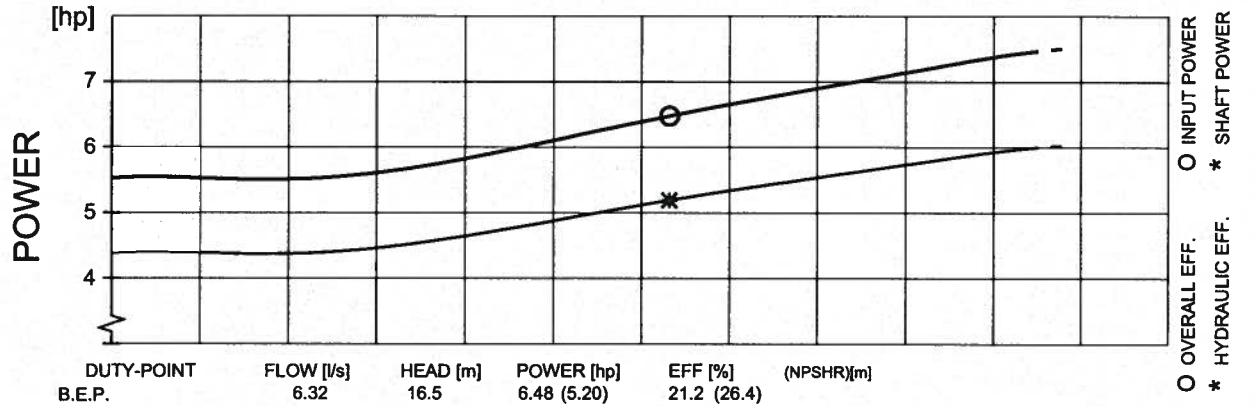

FLYPS3.1.5.7 (20060531)

Performance with clear water and rating data at 40 °C



CURVE



District of West Kelowna

Sanitary Lift Station Evaluation

Station: Newport Road LS 6
Inspection By: Jim Kentel

Year Constructed: 1993
Year Upgraded:

Matrix Rating		
(10 - highest rating)	Civil	5
(1 - lowest rating)	Process Mechanical	20
	Electrical Instrumentation	25
	Total Station Rating	50 (max. rating 370 points)

Civil:

Matrix
Rating

Parking Area:	_____	n/a
Drainage:	_____	1
Influent sewer:	_____	1
Site access:	_____	1
Water service:	_____	1
Gas service:	_____	1

Process Mechanical:

Matrix
Rating



Station type:	_____	n/a
Number of pumps:	_____	n/a
Pump Redundancy:	_____	n/a
Pump Manufacturer / Type:	_____	1
Pump Model:	_____	n/a
Rated Capacity:	_____	n/a
Capacity Confirmation:	_____	n/a
Discharge pipe type / diameter:	_____	1
Header pipe type / diameter:	_____	1
Check valve type / diameter:	_____	1
Isolation valve type / diameter:	_____	1
Piping Condition:	_____	1
Emergency pumpout connection:	_____	1
Pressure gauges:	_____	1
Inlet bar screen:	_____	1
Wetwell condition:	_____	1
Access Hatches:	_____	1
Ladder / Platform:	_____	1
Wetwell benching:	_____	1
Odour Control:	_____	1
Ventilation:	_____	1
Humidity Control / Dehumidification:	_____	1
Grease / Debris Accumulation:	_____	1
Water washdown:	_____	1
Sump pump:	_____	1
Confined Space Entry Requirements	_____	1

Electrical / Instrumentation:

Matrix
Rating

Service Type	V / A / Phase / Wire	1
Pump 1 :	HP	1
	Volts Rpm	n/a
	FLA	n/a
	Starter	n/a
Pump 2 :	HP	1
	Volts Rpm	n/a
	FLA	n/a
	Starter	n/a
Pump 3 :	HP	1
	Volts Rpm	n/a
	FLA	n/a
	Starter	n/a
Control Voltage:		1
Control System:		1
		n/a
Alarm Functions:		1
		n/a
		n/a
		n/a
Receptacles:		1
Interior Lighting:		1
Exterior Lighting:		1
SCADA / Telemetry:		1
Main Breaker:		1
Metering:		1
MCC:		1
Control Panel:		1
Lighting Panel:		1
Flowmeter:		1
Ampmeters:		1
TVSS:		1
Grounding:		1
Lighting Protection:		1
UPS:		1
PLC:		1
Level Control:		1
Standby Generator:		1
Comments:		

LOT A
PLAN 32445

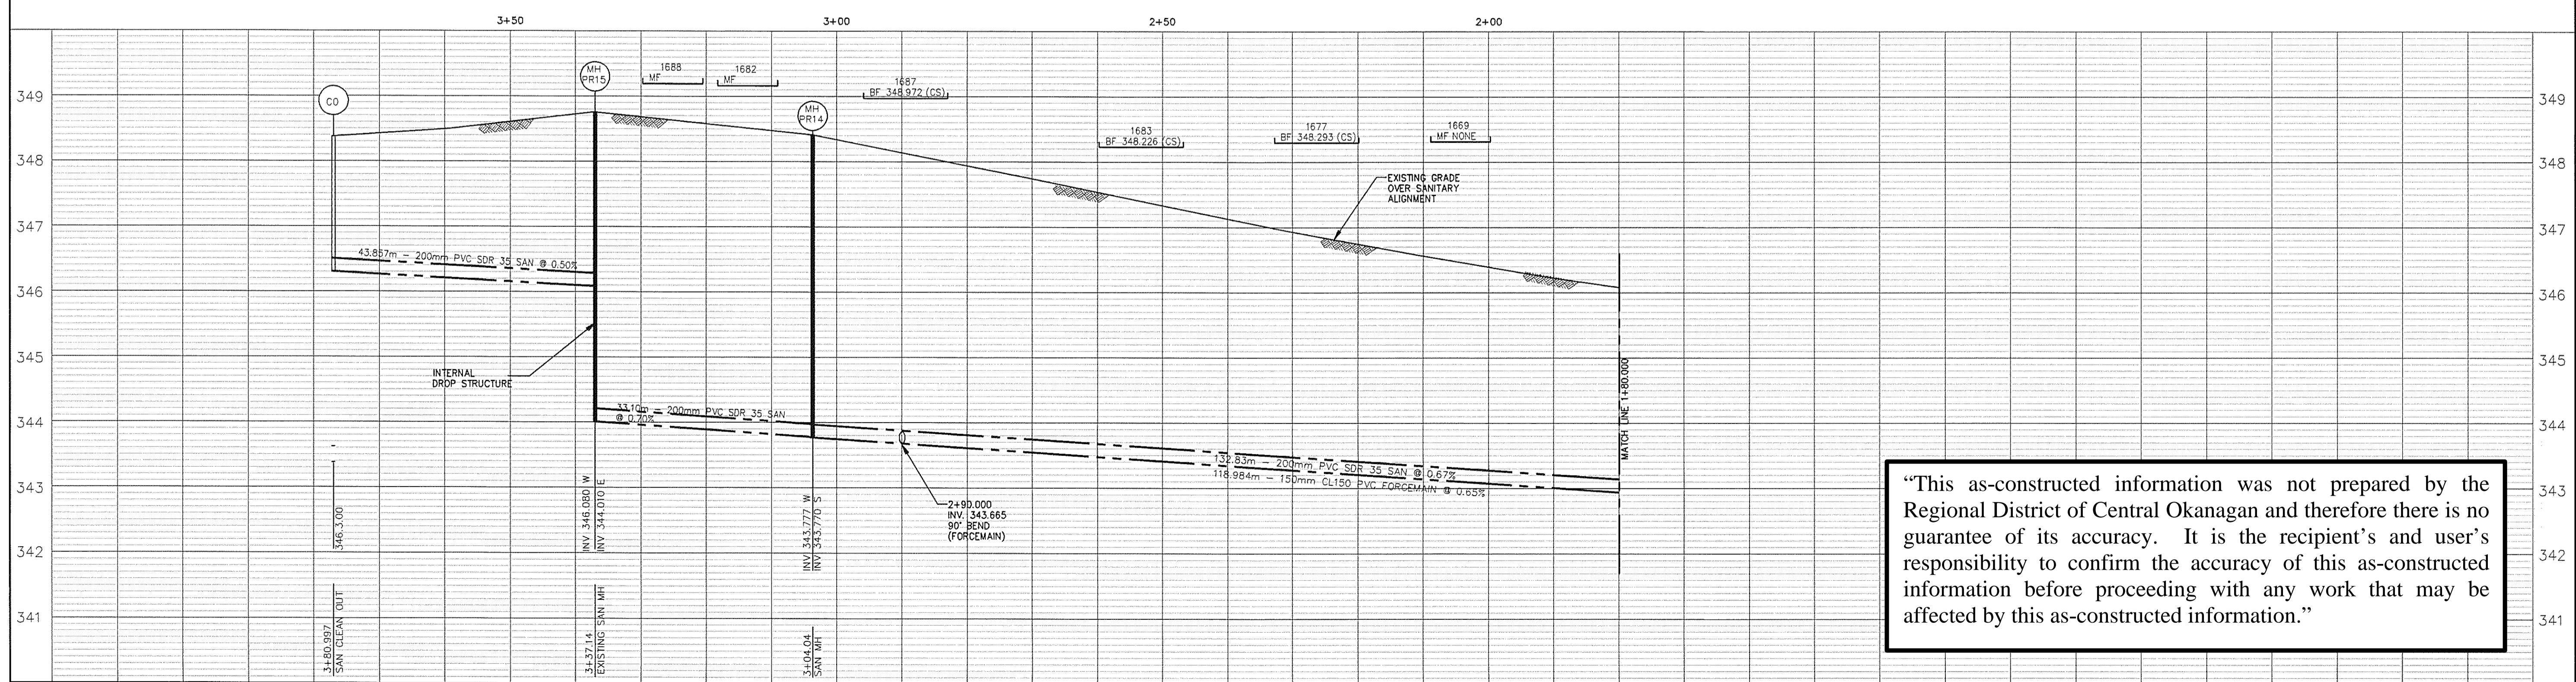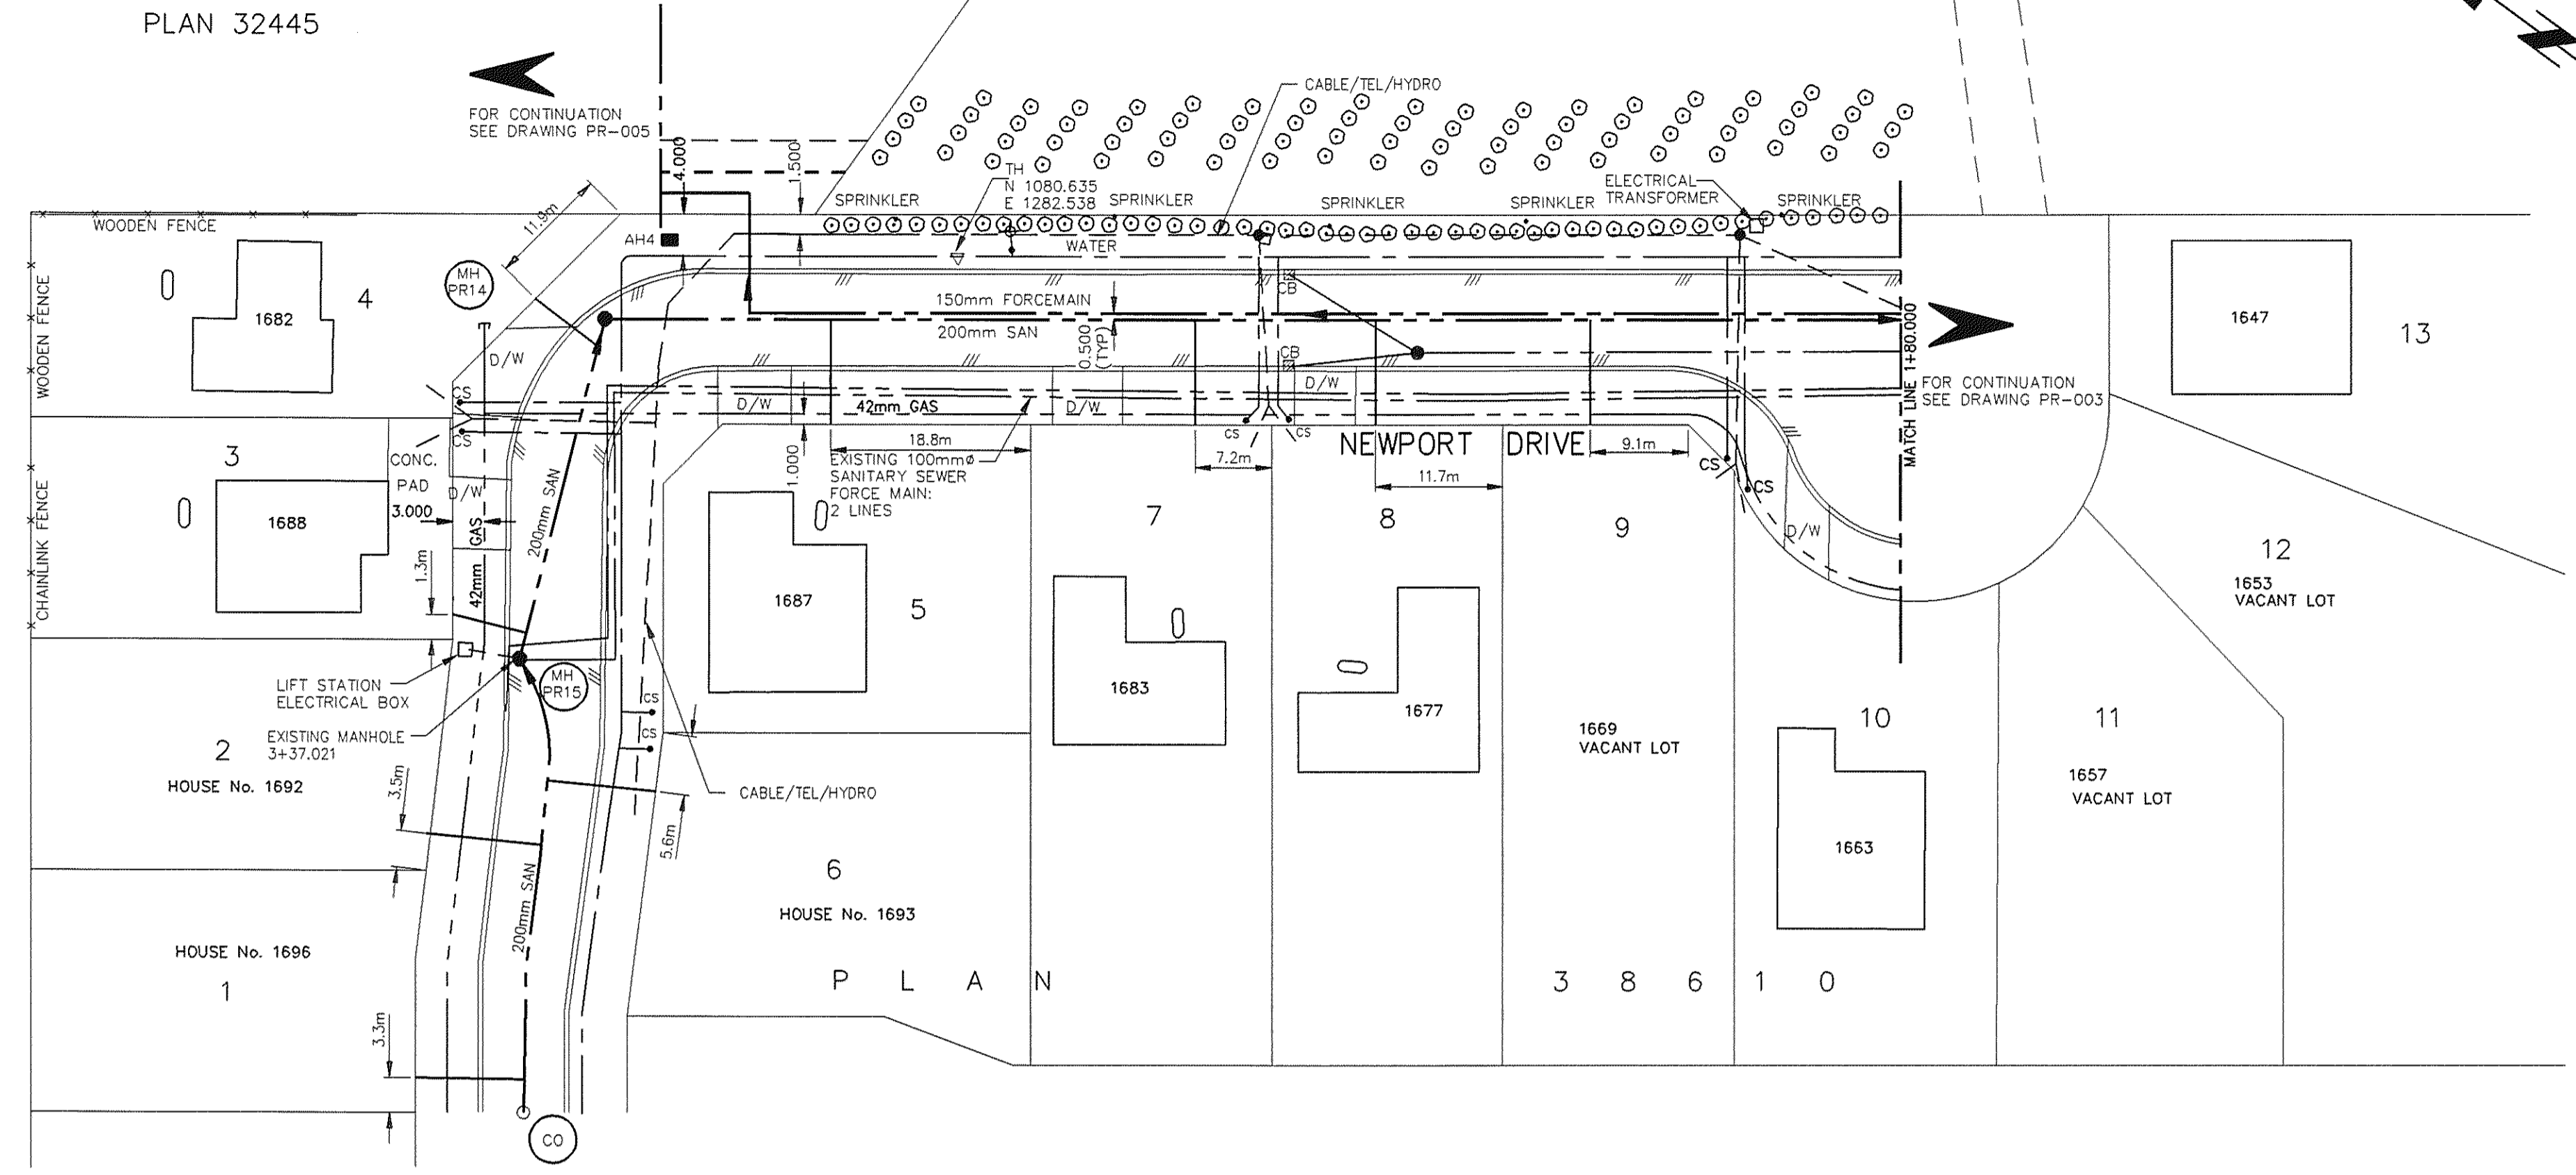

"This as-constructed information was not prepared by the Regional District of Central Okanagan and therefore there is no guarantee of its accuracy. It is the recipient's and user's responsibility to confirm the accuracy of this as-constructed information before proceeding with any work that may be affected by this as-constructed information."

Legend	
Water	--- ---
San. Sewer/Forcemain	--- ---
Storm Sewer	--- ---
Gas	--- ---
U.G. Telephone	--- ---
Cable T.V.	--- ---
U.G. Electrical	--- ---
Prop. San. Service	--- ---
Proposed Sewer	--- ---
Edge of Asphalt	--- ---
Ex. Ground Profile	--- ---
Known Septic Tank	○
Assumed Septic Tank	⊗
Auger Hole	■ AH 12
Lamp Standard	□ L.S.
Catch Basin	□ C.B.
Proposed M.H.	○
Trees	○
Ditch	--- ---
Gravel/Concrete/Asphalt	G/C/A
Power Pole	⊕
Water Service	--- ---
Hydrant	⊕
Culvert	--- ---
Walls	--- ---
Traverse Hub	⊕
Control Man.	⊕
Max. service elev. at PL	7.78 (81) 0

No.	Date	By	Revision
E	JULY/93	DOC	AS-CONSTRUCTED
D	NOV./92	JR	FOR CONSTRUCTION
C	DEC 26 1992	JR	RE-ISSUED FOR TENDER
B	FEB. 19/92	JR	ISSUED FOR TENDER
A	FEB. 17/92	HWB	ISSUED FOR APPROVAL

USL urban systems ltd.
consulting planners and engineers

Drawn	WWB	REGIONAL DISTRICT OF CENTRAL OKANAGAN ENGINEERING DEPARTMENT	Division SANITARY SEWER	
Design	KGO/WWB		File: 1117902.2	
Approved	KGO	PRITCHARD DRIVE SEWER SYSTEM NEWPORT DRIVE STA. 1+80.000 TO 3+37.021	Drawing No.	Rev. No.
Date	JAN. 28/92		PR-004	E
Scale	1:500 HORIZ. 1:50 VERT.			



District of West Kelowna

Sanitary Lift Station Evaluation

Station: Pritchard Drive LS 7
Inspection By: Jim Kentel

Year Constructed: 4/1/1993
Year Upgraded:

Matrix Rating		
(10 - highest rating)	Civil	29
(1 - lowest rating)	Process Mechanical	123
	Electrical Instrumentation	108
	Total Station Rating	260 (max. rating 370 points)



Civil:Matrix
Rating

Parking Area:	_____	n/a
Drainage:	_____	10
Influent sewer:	PVC 200 Gravity	10
Site access:	in park behind fence	8
Water service:	No	1

		29


Process Mechanical:Matrix
Rating

Station type:	FRP 2.4m diameter	n/a
Number of pumps:	2	n/a
Pump Redundancy:	Yes	n/a
Pump Manufacturer / Type:	FLYGT	10
Pump Model:	CP3127 HT Imp. 483	n/a
Rated Capacity:	15L/S @ 20m TDH	n/a
Capacity Confirmation:	_____	n/a
Discharge pipe type / diameter:	PVC 150	10
Header pipe type / diameter:	FRP 100	10
Check valve type / diameter:	FLYGT Ball HDL/100	10
Isolation valve type / diameter:	Dezurik Plug Valve / 100	10
Piping Condition:	Good	8
Emergency pumpout connection:	No	1
Pressure gauges:	Yes	10
Inlet bar screen:	No	1
Wetwell condition:	Good	10
Access Hatches:	Alum	10
Ladder / Platform:	Alum/FRP	10
Wetwell benching:	Yes	10
Odour Control:	No	1
Ventilation:	Heater/Blower	10
Water washdown:	No	1
Confined Space Entry Requirements	No	1
		123

Electrical / Instrumentation:

Matrix
Rating


Service Type	V / A / Phase / Wire	n/a
Pump 1 :	HP 10	n/a
	Volts 600 Rpm 1735	n/a
	FLA 9.7A	n/a
Starting Current	55.0A	n/a
Pump 2 :	HP 10	n/a
	Volts 600 Rpm 1735	n/a
	FLA 9.7A	n/a
Starting Current	55.0A	n/a
Alarm Functions:		5
	Level only	n/a
		n/a
		n/a
Receptacle	Yes	10
Interior Lighting:	Yes	10
Exterior Lighting:	No	1
SCADA / Telemetry:		5
Main Breaker:		10
Control Panel:		10
Lighting Panel:		10
Flowmeter:	Fisher&Porter no	10
Grounding:		10
Surge Protection:		10
UPS:		10
PLC:		1
Level Control:	FLYGT Bulb	5
Standby Generator:	No	1
		108
Comments:		

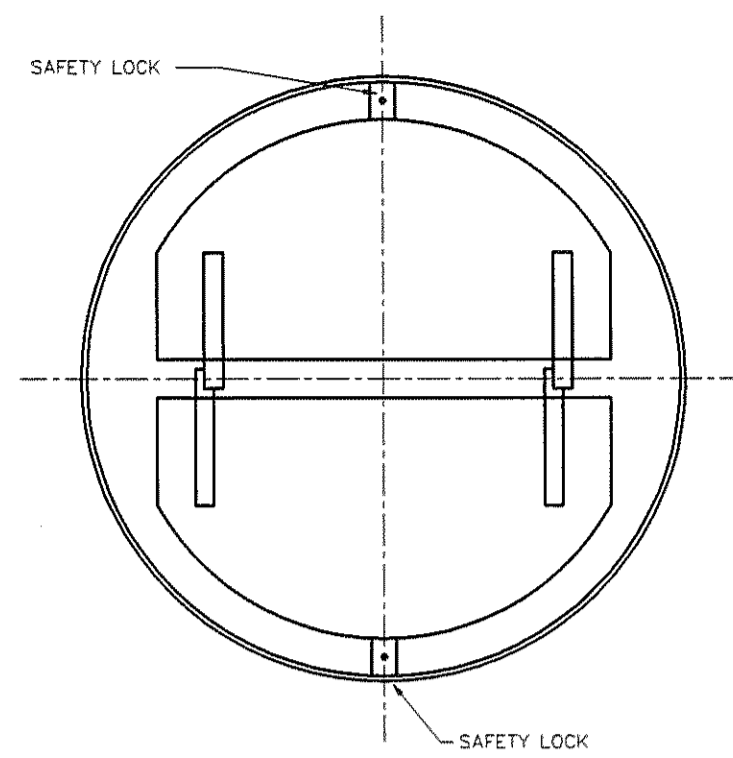


HATCH-PLAN
SCALE 1 : 30

BILL OF MATERIALS		
ITEM	DESCRIPTION	No. REQ'D.
1	FLYGT PUMP MODEL - C 312HT IMP. 483 c/w 100mm 125# ANSI FLANGE OR EQUAL	2 *
2	FLYGT HDL BALL CHECK VALVE	2
3	DEZURIK PLUG VALVE 100mm c/w LEVER	2
4	100mm FRP TEE	1
5	100mm FRP 90° BEND WITH FLANGE	2
6	150mm Fx F GATE VALVE c/w VALVE BOX	1
7	100 x 150mm Hx F INCREASER	2
8	213mm O.D. FRP INLET PIPE WITH MACHINED END	1
9	122mm O.D. FRP OUTLET PIPE WITH MACHINED END	1
10	100mm Ø EXHAUST VENT PIPE	1
11	150mm Ø INLET AIRDUCT	1
12	ALUMINUM LADDER	1
13	FAN	1
14	FLYGT BULB CONTROL SYSTEM	1
15	100mm Ø PRESSURE GAUGE c/w ISOLATING VALVE	1
16	VALMATIC MODEL 48 50mm Ø NPT AIR RELEASE VALVE	1
17	150mm Hx F 45° BEND	1
18	150mm Hx H 45° BEND	1
19	200mm PVC WYE	1
20	MAG FLOW METER	1


* ONE PUMP MUST BE SUPPLIED WITH HYDRAULIC FLUSH VALVE.

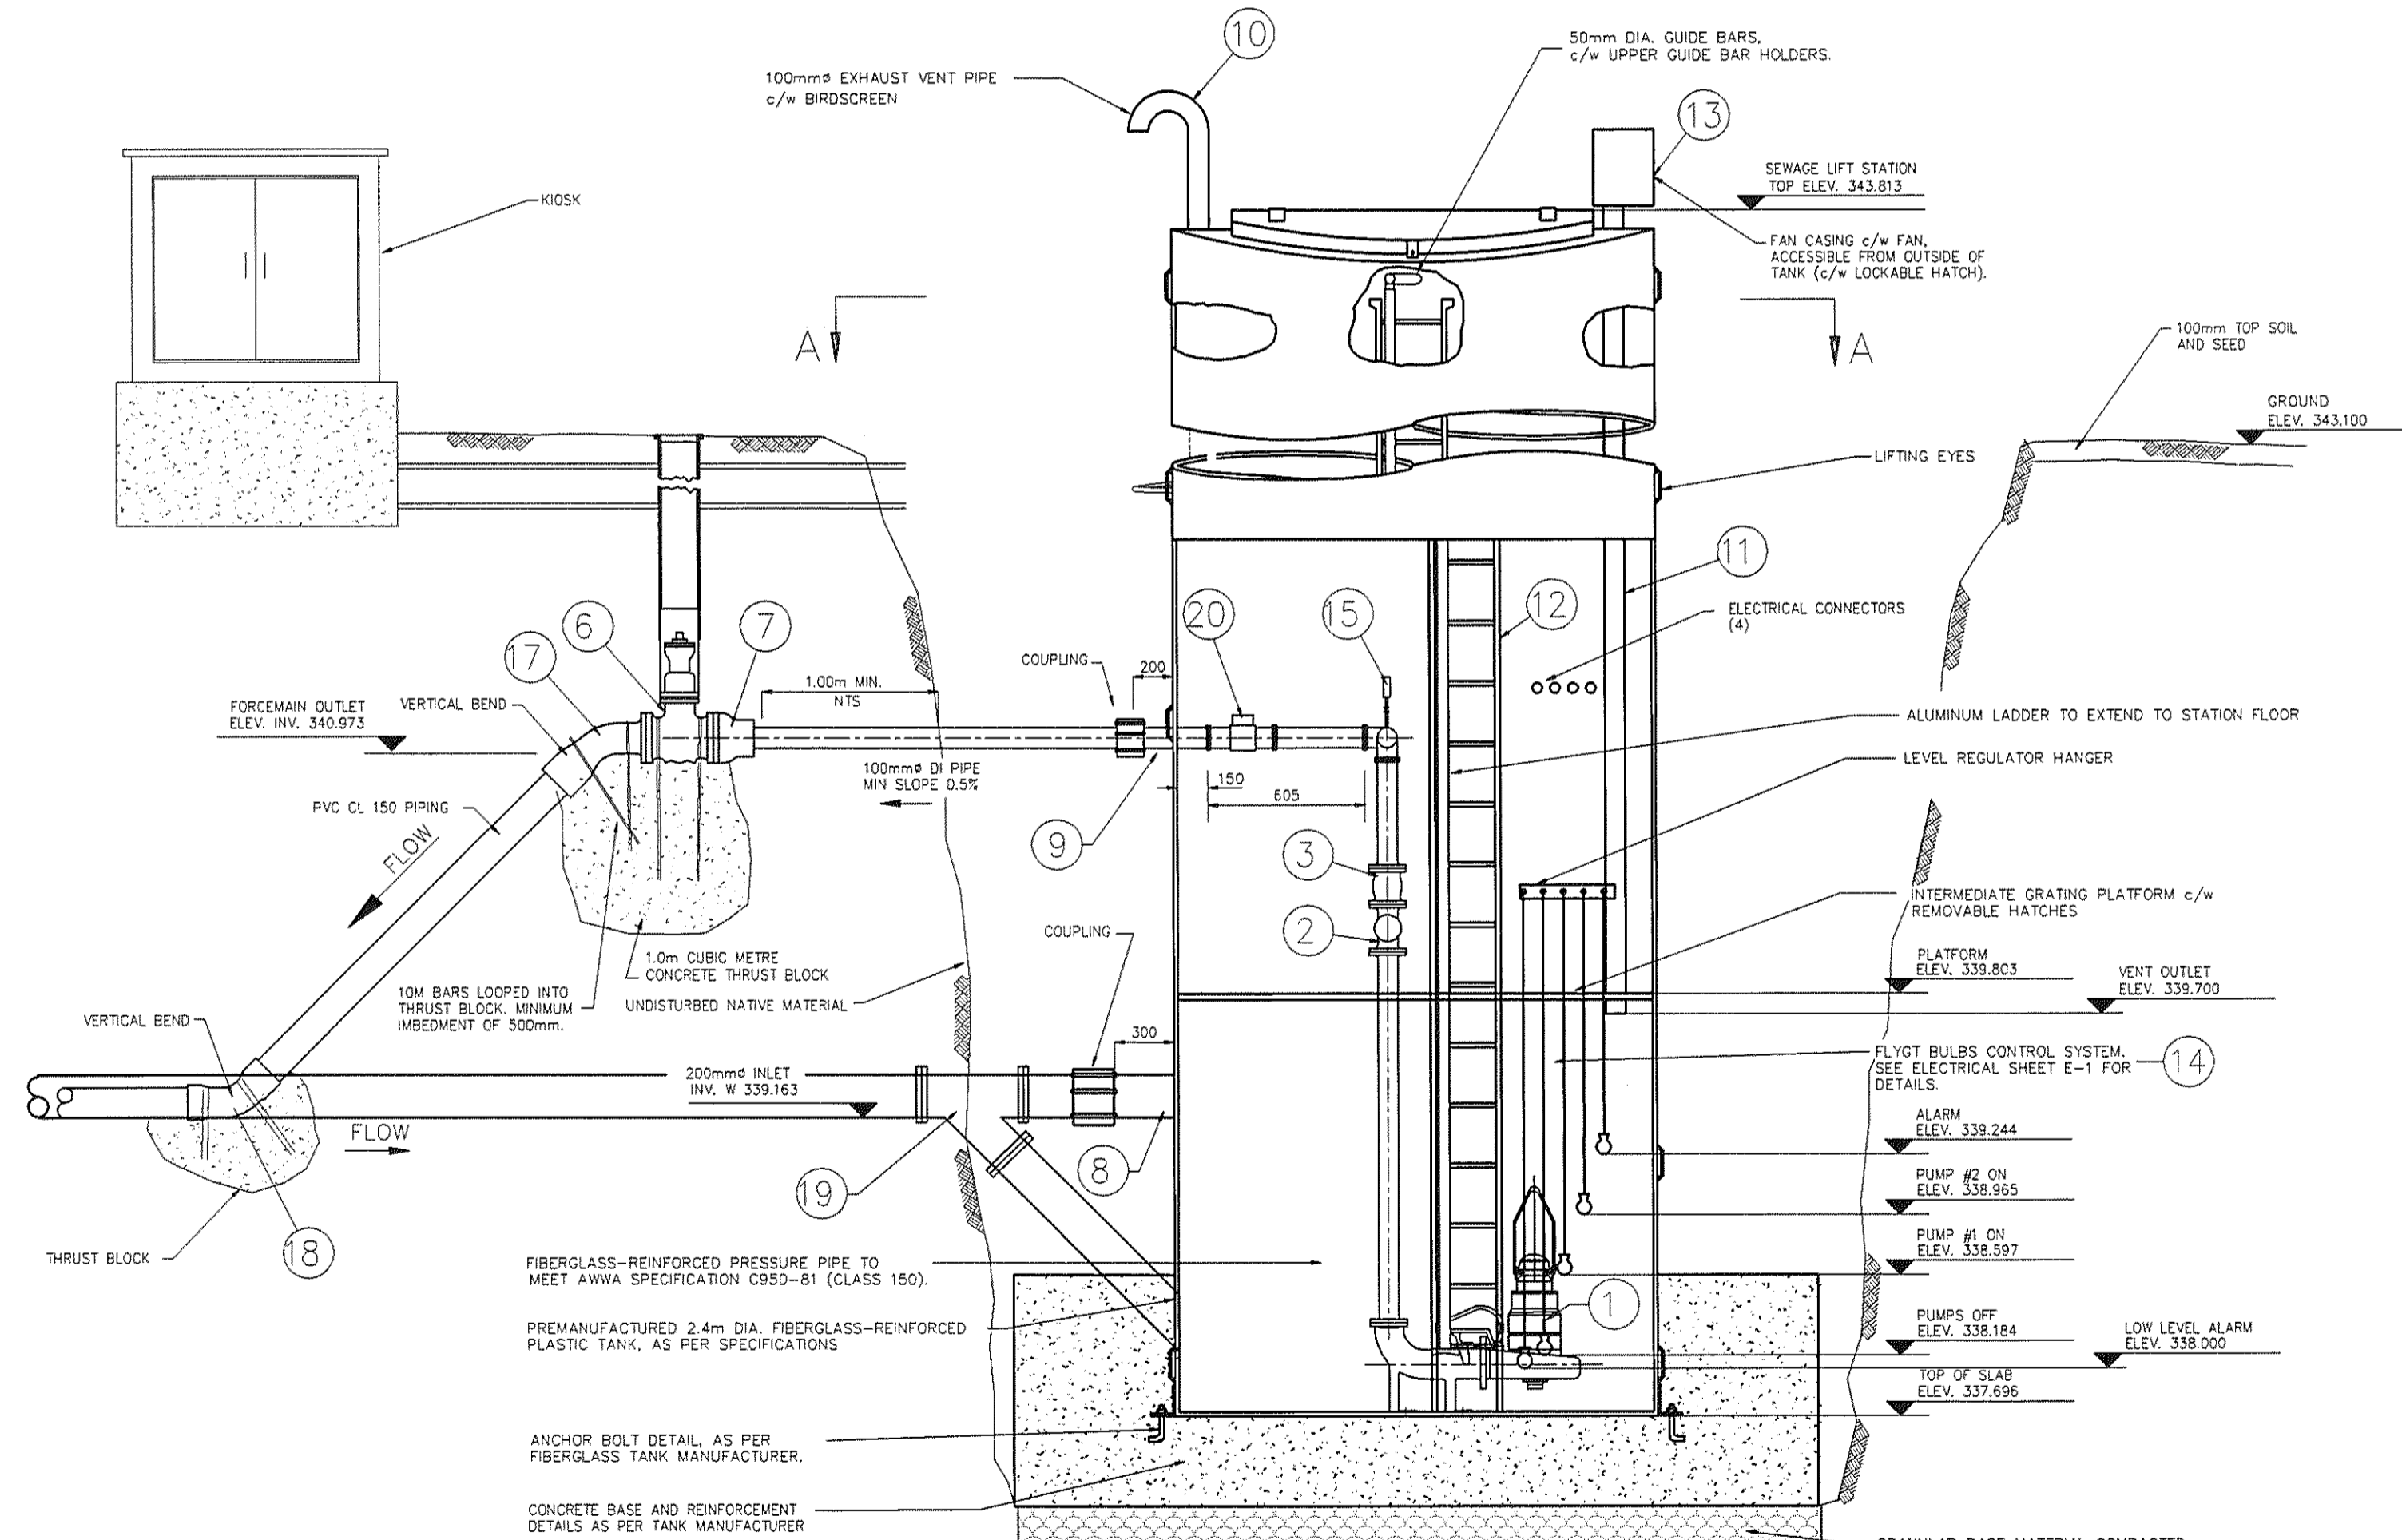

PUMPING CHAMBER
ELEVATION
SCALE 1 : 30

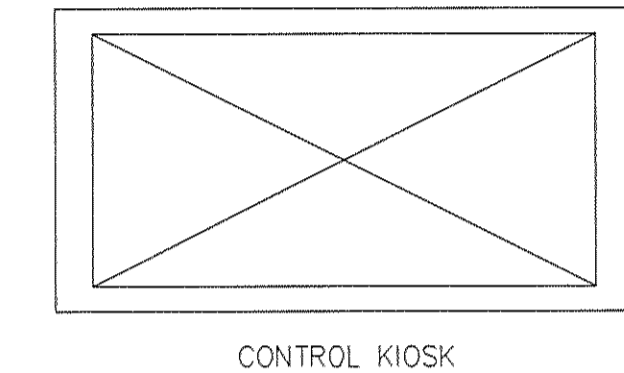

CONTROL KIOSK

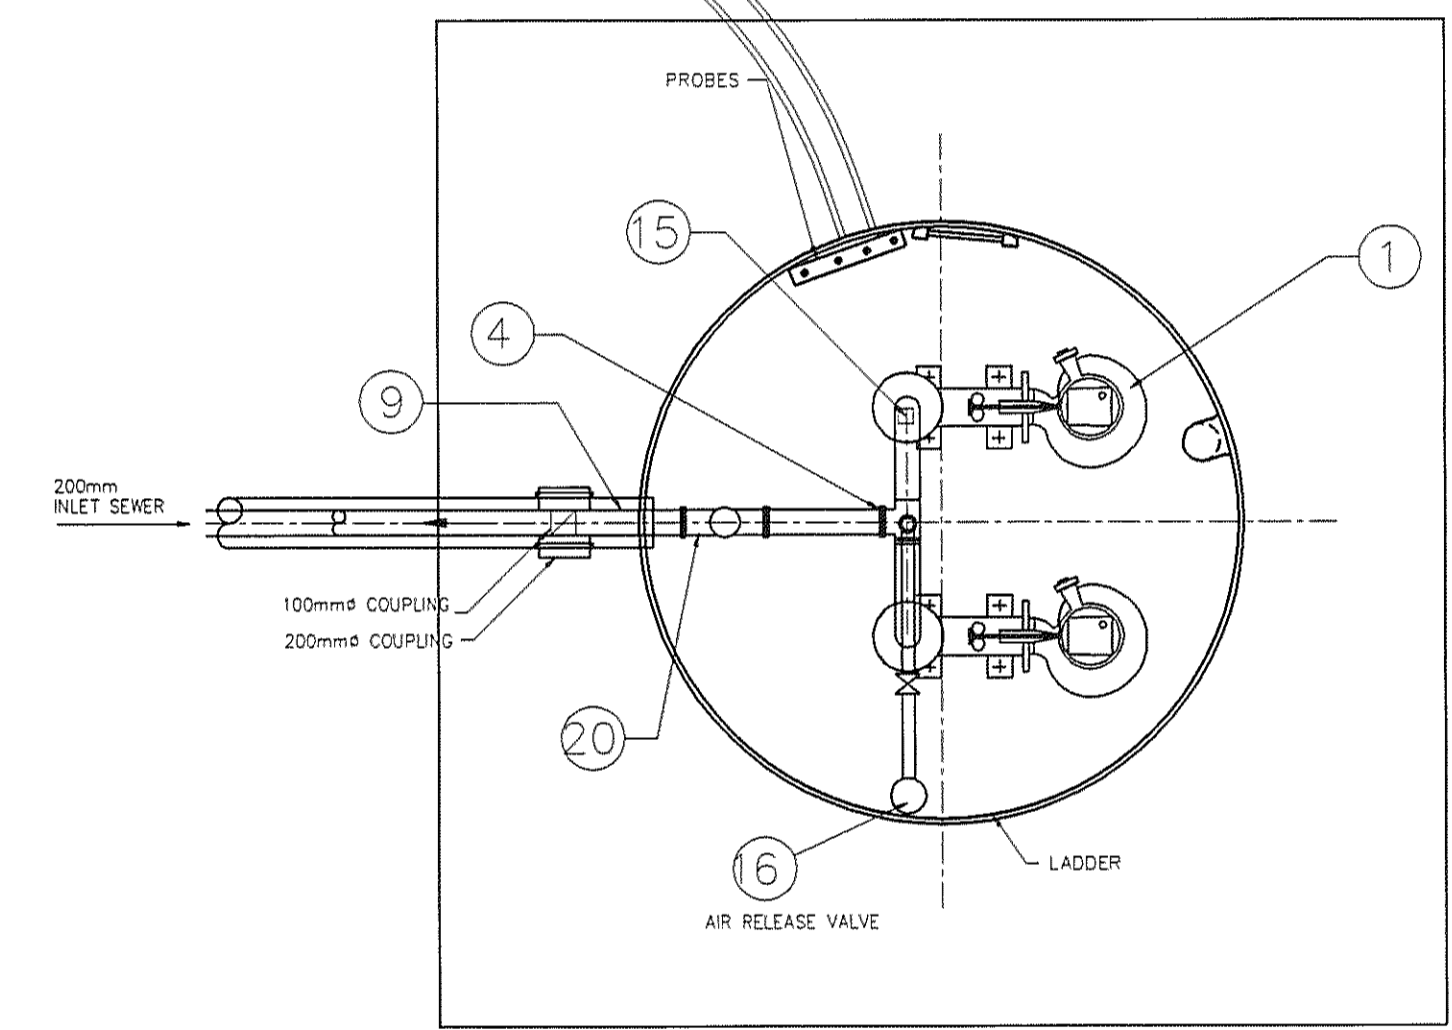

SECTION A-A
SCALE 1 : 30

PUMP SPECIFICATIONS :
THE PUMPS ARE FLYGT MODEL C 3127 HT IMPELLER #483 ELECTRIC SUBMERSIBLE SEWAGE PUMPS.

DESIGN CRITERIA :
MAXIMUM SEWAGE FLOWS : 15 lps.
TOTAL FLOW :
USING A PEAKING FACTOR OF 2.84 AND A 24 HOUR TIME PERIOD
MAXIMUM FLOW = 15.5 lps.
TOTAL PUMP HEAD : (m) STATIC HEAD = 15
MAXIMUM PIPING LOSS = 5
TOTAL HEAD = 20

MAXIMUM PUMP CYCLE TIME = 4.0 MINUTES = 15 STARTS PER HOUR

"This as-constructed information was not prepared by the Regional District of Central Okanagan and therefore there is no guarantee of its accuracy. It is the recipient's and user's responsibility to confirm the accuracy of this as-constructed information before proceeding with any work that may be affected by this as-constructed information."

NOTES :

- FOR SITE LOCATION DETAILS SEE SHEET PR001.
- ALL FLANGE CONNECTIONS SHALL BE TO ANSI CLASS 125 STANDARDS.
- FOR DETAILED SPECIFICATIONS SEE CONTRACT DOCUMENTS.

Legend		Legend		Legend	
Water	---	UG. Electrical	---	AUGER HOLE	■ AH 12
San. Sewer	---	Prop. San. Service	---	Lamp Standard	□ L.S.
Storm Sewer	---	Proposed Sewer	---	Catch Basin	□ C.B.
Gas	---	Edge of Asphalt	---	Proposed M.H.	● P.M.H.
U.G. Telephone	---	Ex. Ground Profile	---	Trees	○ T
Cable T.V.	---	Known Septic Tank	○	Ditch	---
		Assumed Septic Tank	⊗	Gravel/Concrete/Asphalt	G/C/A

No.	Date	By	Revision	Ch'ko
E	JULY/93	DOC	AS CONSTRUCTED	DP
D	NOV. 17/92	DOC	FOR CONSTRUCTION	KGO
C	OCT. 26/92	JR	RE-ISSUED FOR TENDER	KGO
B	FEB. 19/92	JR	ISSUED FOR TENDER	KGO
A	FEB. 17/92	RH	ISSUED FOR APPROVAL	KGO



Drawn	RH	REGIONAL DISTRICT OF CENTRAL OKANAGAN ENGINEERING DEPARTMENT	Division SANITARY SEWER		
Design	KGO		File: 1117902.2		
Approved	KGO		PRITCHARD DRIVE SEWER SYSTEM MAIN SEWAGE LIFT STATION	Drawing No.	Rev. No.
Date	FEB. /92			L-007	E
Scale	AS SHOWN				



PERFORMANCE CURVE

PRODUCT: CP3127.180
TYPE: HT

DATE: 92-12-09

PROJECT: PRITCHARD DRIVE LS 7

CURVE NO: 63-483-00-3755
ISSUE: 3


	1/1-LOAD	3/4-LOAD	1/2-LOAD
MOTOR COS FI	---	---	---
MOTOR EFFICIENCY	---	---	---
GEAR EFFICIENCY	---	---	---

MAX POWER 8.69 KW
 STARTING CURRENT ... ---- A
 RATED CURRENT000 A
 SPEED 1740 RPM
 TOT. MOM. OF INERTIA ... ---- KG#M²
 NO. OF BLADES 1


IMPELLER DIAMETER: ---- MM
 MOTOR TYPE: ---- STATOR REV: ----
 FREQ: 60 HZ PHASES: 3 VOLTAGE: 460 V POLES: 4
 GEAR TYPE: ---- RATIO: ----

COMMENTS: NEVA CLOG

INLET/OUTLET: ----/100 MM
 IMP. THROUGHLET: 76 MM

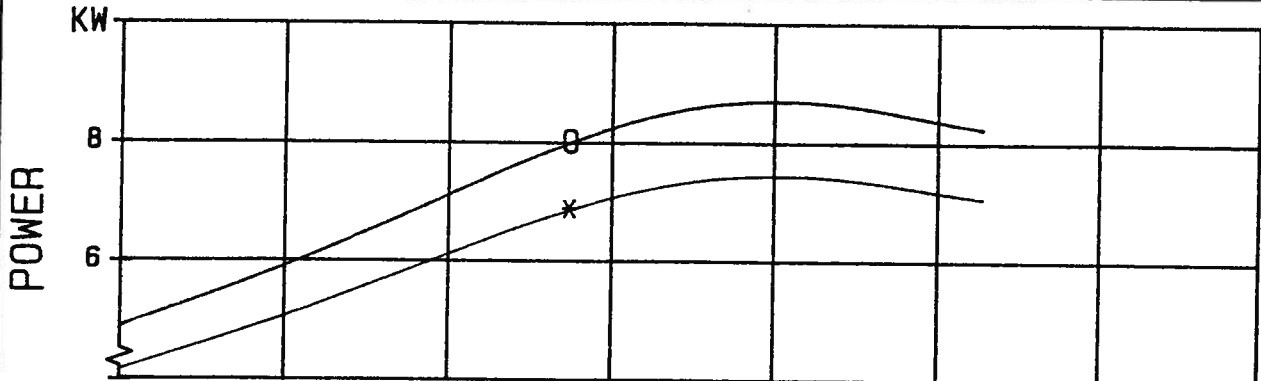

DUTY-POINTS:	FLOW (L/S)	HEAD (M)	POWER (KW)	EFF (%)	NPSH (M)	GUARANTY
BEP:	27.7	15.6	8.01 (6.87)	52.7 (61.4)	32.2	---
1.	15.5	20.0	---	---	---	---

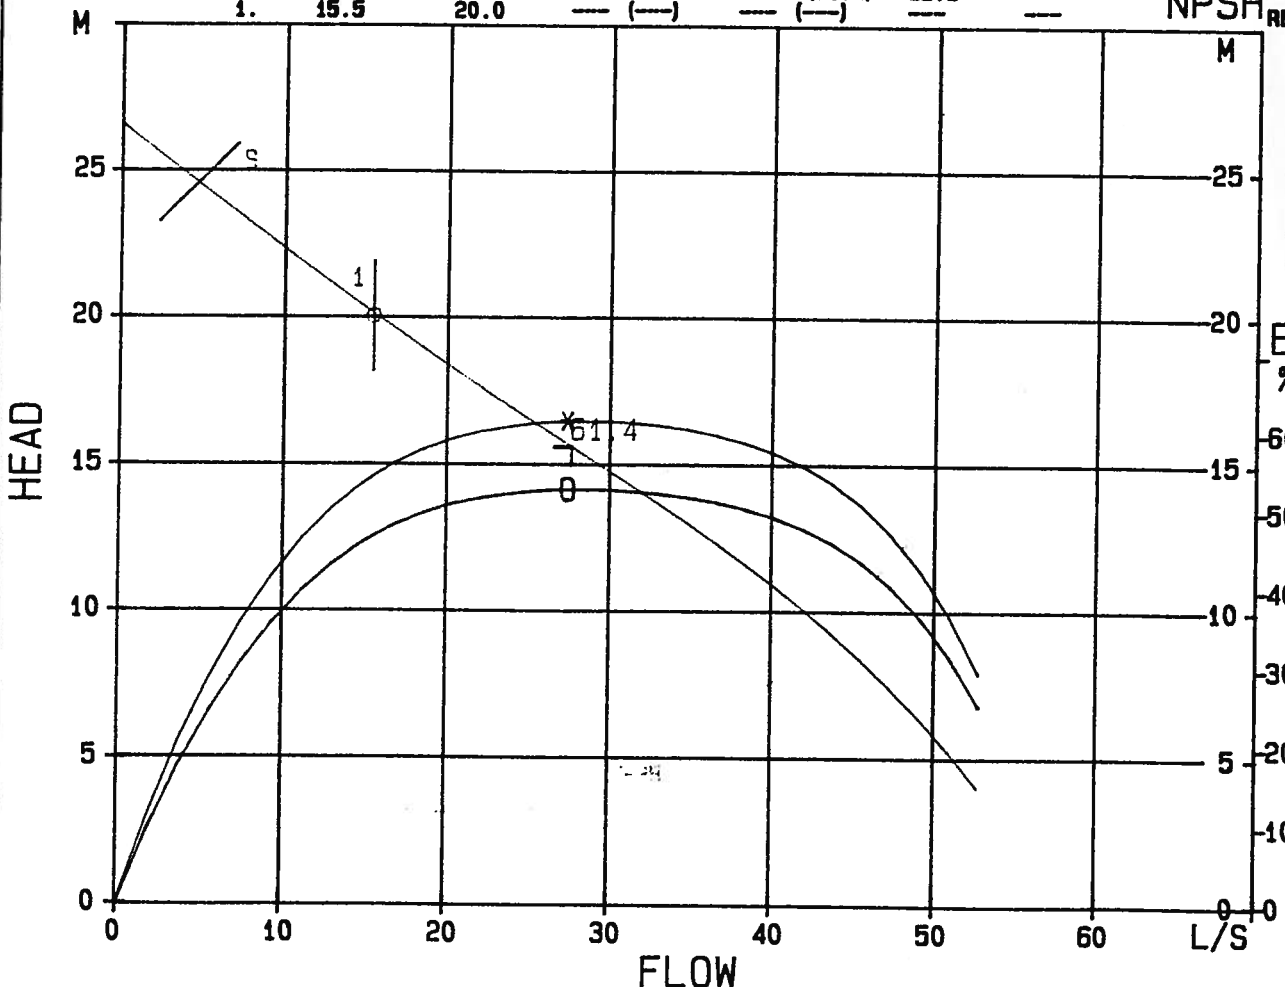

0 INPUT POWER
 * IMP. SHAFT POWER
 0 OVERALL EFF.
 * HYDRAULIC EFF.
 C CAVITATION

0 DUTY POINT
 * BEST EFF. POINT

S: RISK FOR SEDIMENTATION AT VELOCITY BELOW 0.6 M/S (STANDARD DIAM. 100 MM)

CURVES SHOW PERFORMANCE WITH CLEAR WATER



HI-CURVE



District of West Kelowna

Sanitary Lift Station Evaluation

Station: Green Bay LS 8
Inspection By: Jim Kentel

Year Constructed: 7/1/1992
Year Upgraded:

Matrix Rating			
(10 - highest rating)	Civil	62	
(1 - lowest rating)	Process Mechanical	105	
	Electrical Instrumentation	112	
	Total Station Rating	279	(max. rating 370 points)



Civil:Matrix
Rating

Parking Area:	_____	n/a
Drainage:	_____	10
Influent sewer:	_____	10
Site access:	_____	10
Water service:	_____	1
		31

Process Mechanical:Matrix
Rating


Station type:	FRP 2.4m diameter	n/a
Number of pumps:	2	n/a
Pump Redundancy:	Yes	n/a
Pump Manufacturer / Type:	FLYGT	10
Pump Model:	CP 3152 HT Imp 454	n/a
Rated Capacity:	50 L/S @ 20.1 TDH	n/a
Capacity Confirmation:	_____	n/a
Discharge pipe type / diameter:	PVC/150	10
Header pipe type / diameter:	50 FRP	10
Check valve type / diameter:	Weight&Lever /150	8
Isolation valve type / diameter:	Dezurik /150	10
Piping Condition:	Good	6
Emergency pumpout connection:	No	1
Pressure gauges:	_____	1
Inlet bar screen:	No	1
Wetwell condition:	_____	10
Access Hatches:	_____	10
Ladder / Platform:	Yes	10
Wetwell benching:	_____	10
Odour Control:	No	1
Ventilation:	Goose Neck Only	5
Water washdown:	_____	1
Confined Space Entry Requirements	_____	1
		105

Electrical / Instrumentation:

Matrix
Rating



Service Type	V / A / Phase / Wire	n/a
Pump 1 :	HP 20.0	n/a
	Volts 600 Rpm 1755	n/a
	FLA 20.0A	n/a
Starting Current	121.0A	n/a
Pump 2 :	HP 14.9 KW	n/a
	Volts 600 Rpm 1755	n/a
	FLA 20.0A	n/a
Starting Current	121.0A	n/a
Alarm Functions:		5
		n/a
		n/a
		n/a
Receptacles:		10
Interior Lighting:		10
Exterior Lighting:		1
SCADA / Telemetry:		5
Main Breaker:		10
Control Panel:		10
Lighting Panel:		10
Flowmeter:	Fischer and Porter IOD14658	10
Grounding:		10
Surge Protection:		10
UPS:		10
PLC:	Yes	5
Level Control:	FLYGT Bulbs	5
Standby Generator:		1
		112
Comments:		

"This as-constructed information was not prepared by the Regional District of Central Okanagan and therefore there is no guarantee of its accuracy. It is the recipient's and user's responsibility to confirm the accuracy of this as-constructed information before proceeding with any work that may be affected by this as-constructed information."

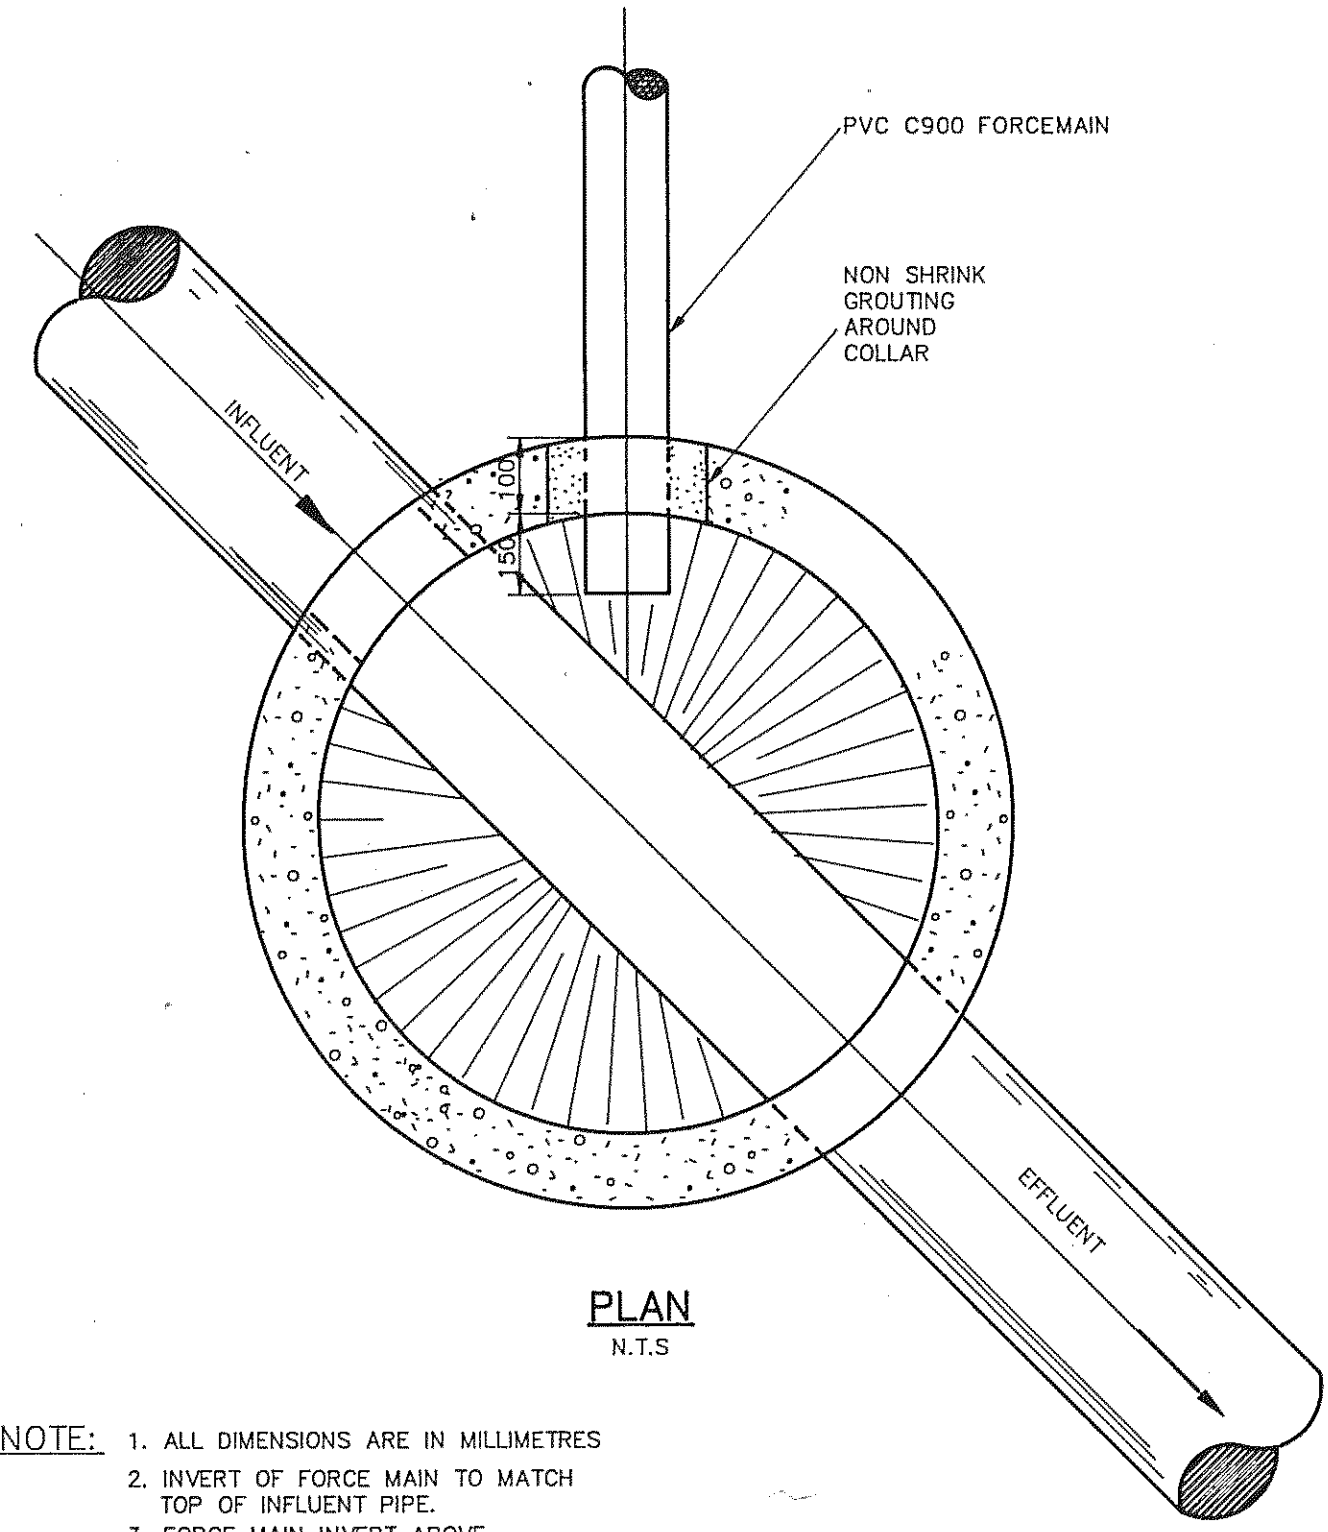

- NOTE:**
1. ALL DIMENSIONS ARE IN MILLIMETRES
 2. INVERT OF FORCE MAIN TO MATCH TOP OF INFLUENT PIPE
 3. FORCE MAIN INVERT ABOVE BENCHING OF MANHOLE


SPECIAL FITTING (FORCEMAIN) DETAIL

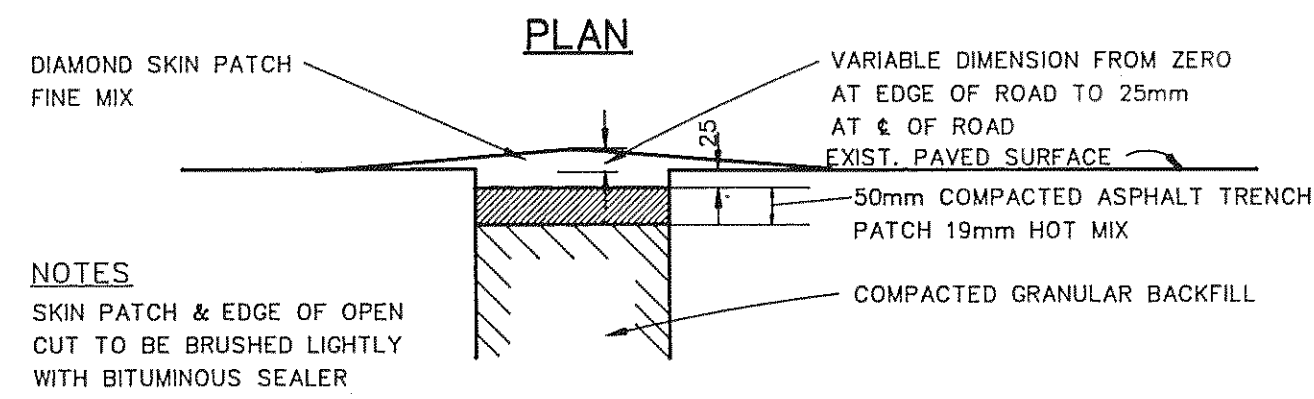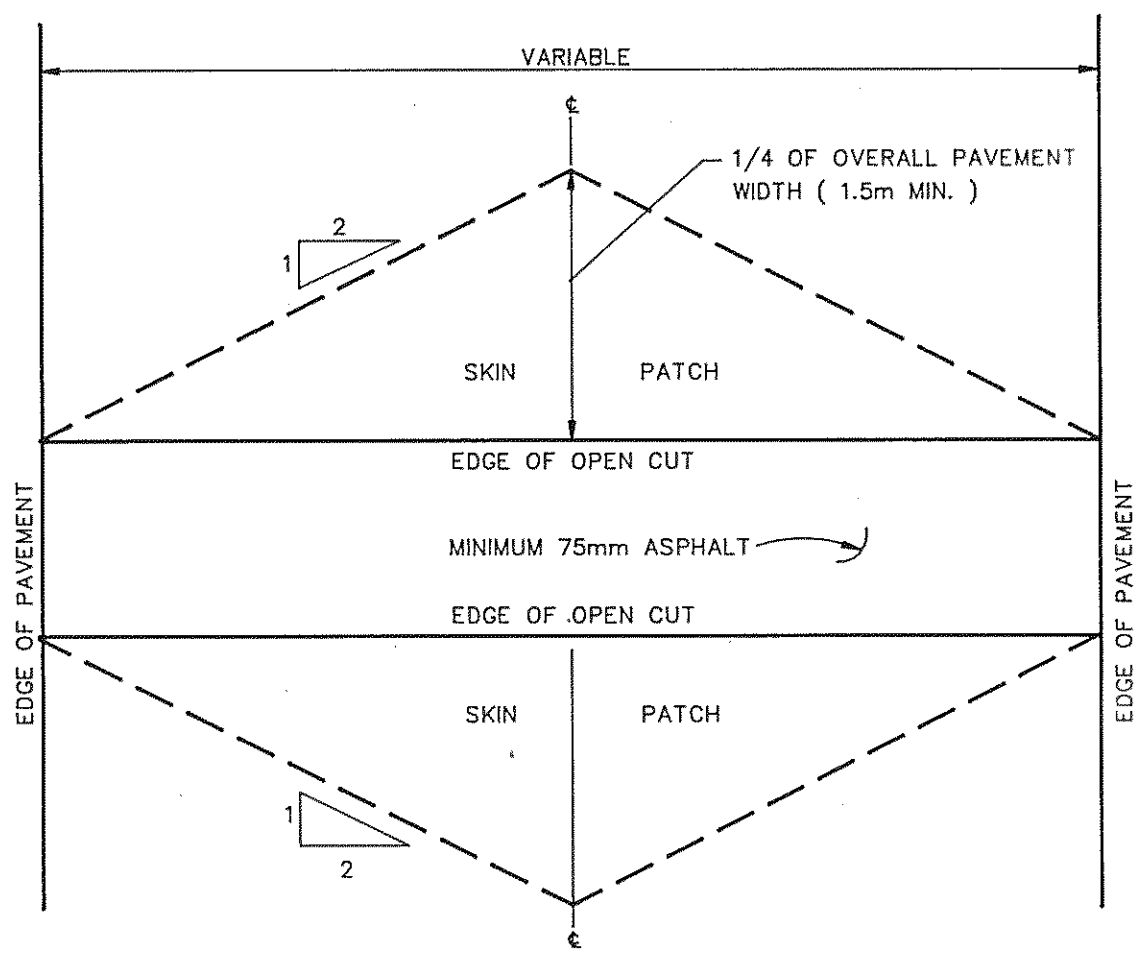

TYPICAL DIAMOND PATCH


INSPECTION CHAMBER

- NOTE:**
1. INSPECTION CHAMBERS INSTALLED IN DRIVEWAYS SHALL BE PROTECTED BY 450 x 450 x 75 CONCRETE PAD COMPLETE WITH LIFTING LUG.
 2. PROVIDE 200 Ø PVC RISERS AS REQUIRED.
 3. FOR INSTALLATION IN EARTH, DELETE PRECAST CONCRETE PAD AND RUN 50mm SOD OR EARTH OVER CHAMBER LID.

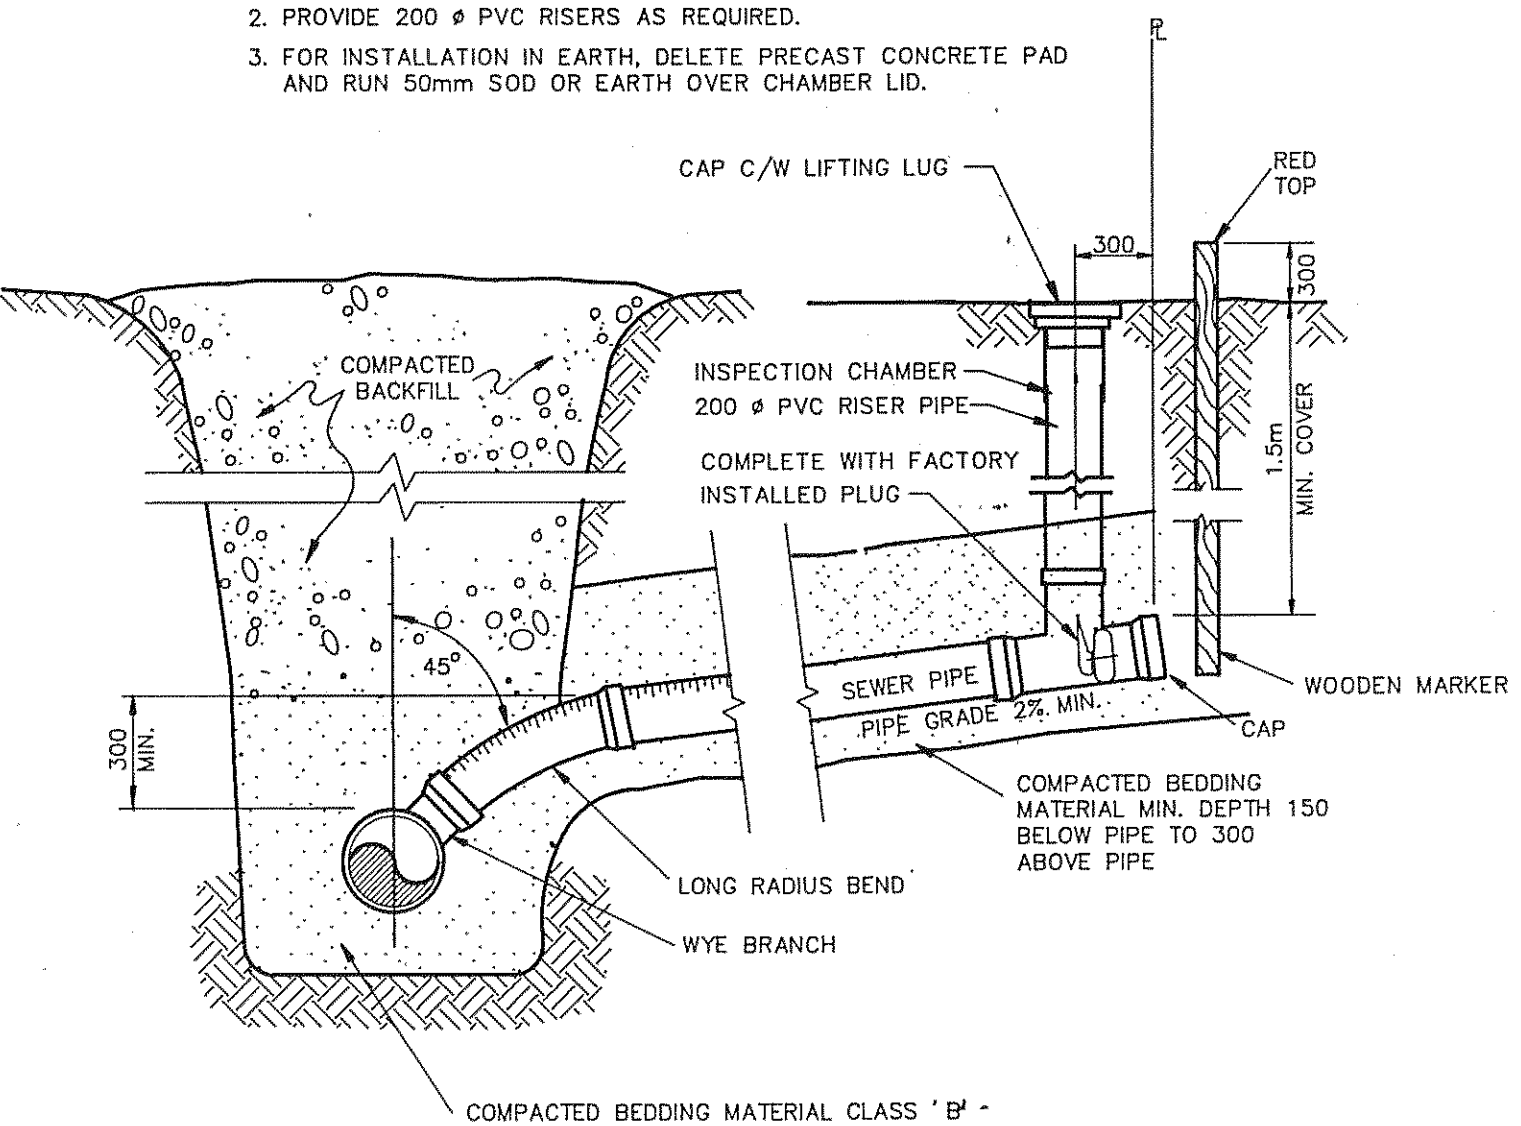



- NOTE:**
1. COMPACTION REQUIREMENTS AS PER DETAILED SPECIFICATIONS
 2. 38x90 MARKER TO EXTEND TO INVERT OF SERVICE

SANITARY SEWER SERVICE CONNECTION C/W 200 Ø INSPECTION CHAMBER

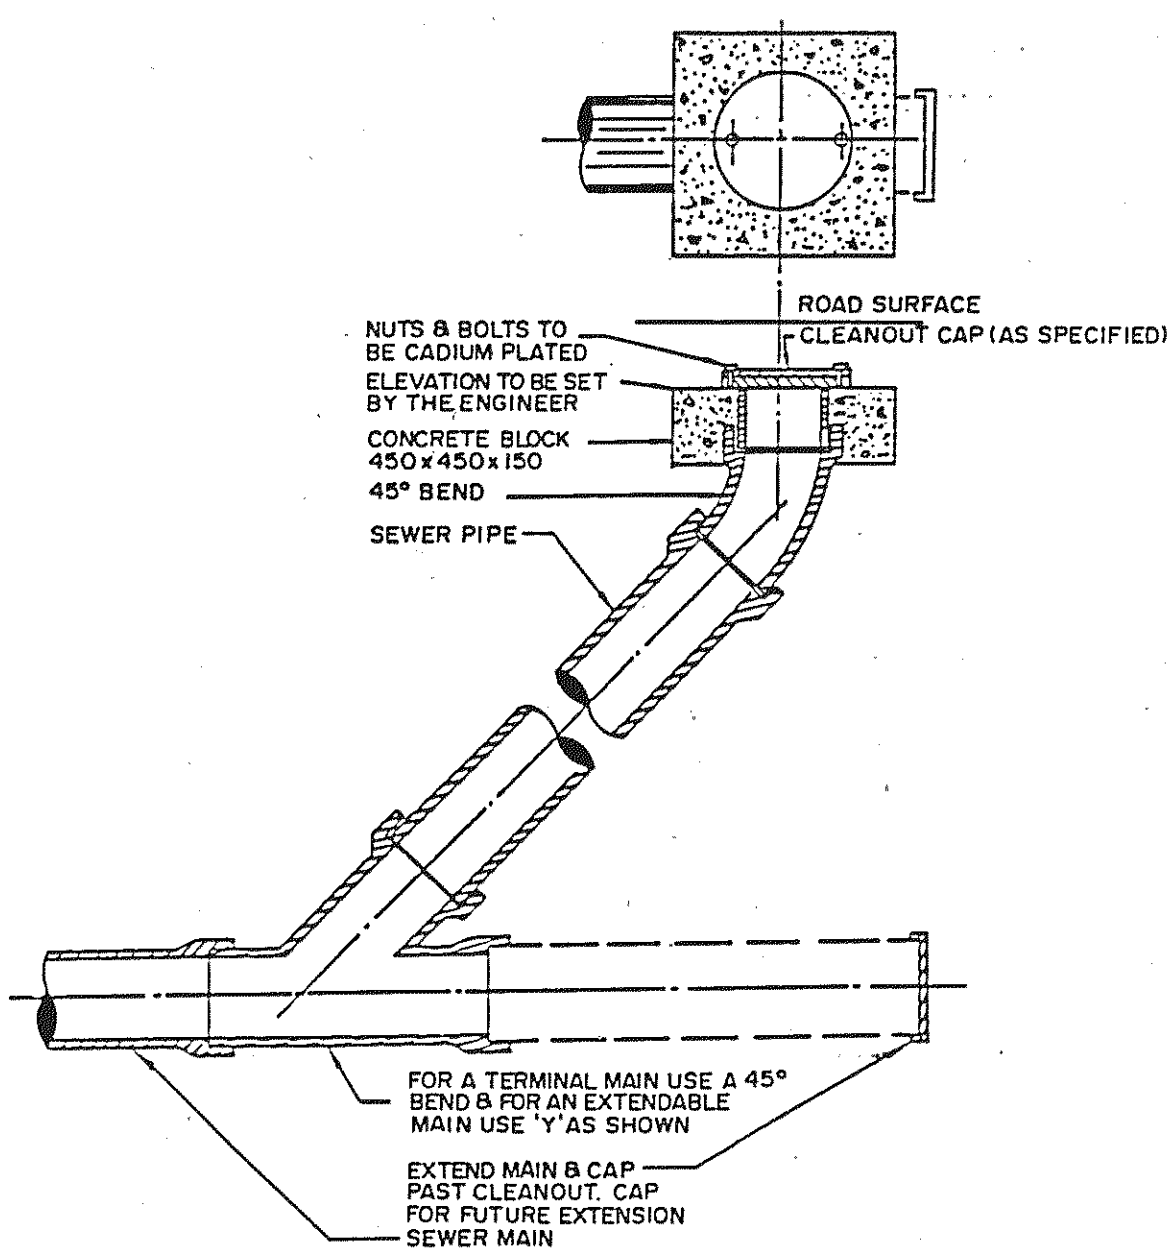

SANITARY SEWER CLEANOUT

BILL OF MATERIAL		
ITEM	QTY	DESCRIPTION
THE FOLLOWING ITEMS ARE SUPPLIED BY FLYGT		
1	2	MODEL CP 3152 FLYGT ELECTRIC SUBMERSIBLE SEWAGE PUMPS, 150mm, 20 HP, IMPELLER #454, 600/3/60
2	20m	No. 4/10 CABTIRE CABLE
3	14m	GALVANIZED LIFTING CHAIN
4	2	SHACKLES
5	2	150mm DISCHARGE CONNECTIONS
6	1	VERTICAL REGULATOR HANGER
7	4	LEVEL REGULATORS C/W 13m CABLE
8	2	UPPER GUIDE HOLDERS
9	1	LIFTING DAVIT
10	1	HOIST
11	2	150mm OUTSIDE LEVER & WEIGHT CHECK VALVE
12	2	150mm DEZURIK PLUG VALVES
13	1	FIBERGLASS TANK, 2400Ø x 5.3m LONG, C/W 150mm DUPLEX PIPING, INTERMEDIATE PLATFORM, LADDER, VENT, COMPLETE LID
THE FOLLOWING ITEMS TO BE SUPPLIED BY CONTRACTOR		
14	1	100mm MAGNETIC FLOW METER FISCHER & PORTER MOD. 1001465B
15	1	CONCRETE BASE
16	1	KIOSK AND PAD AS ELECTRICAL DRAWINGS

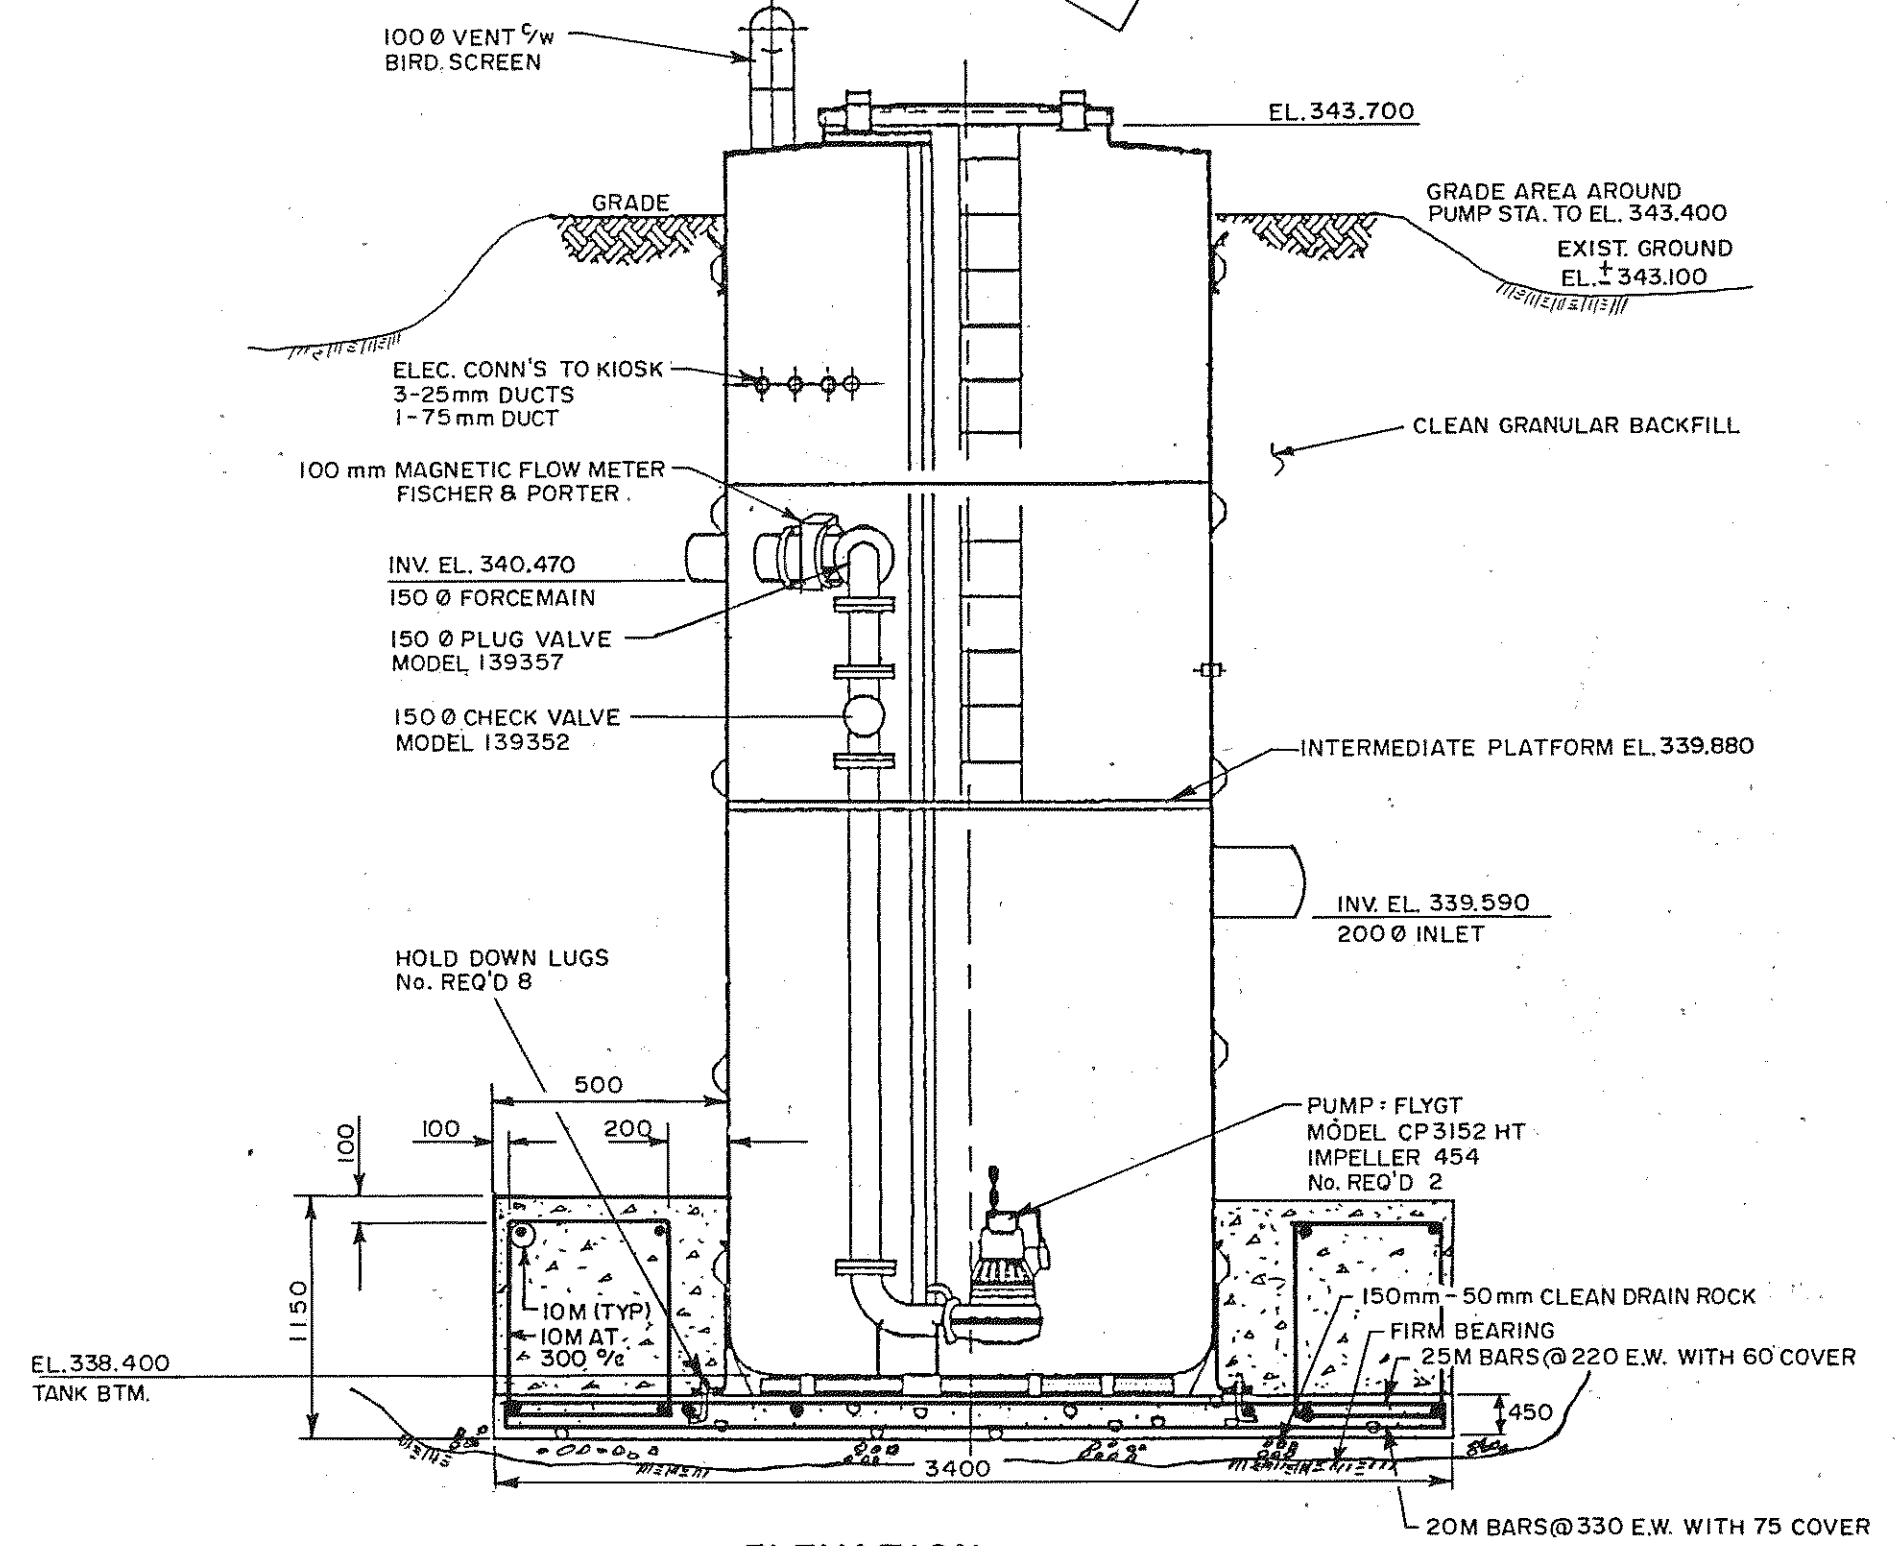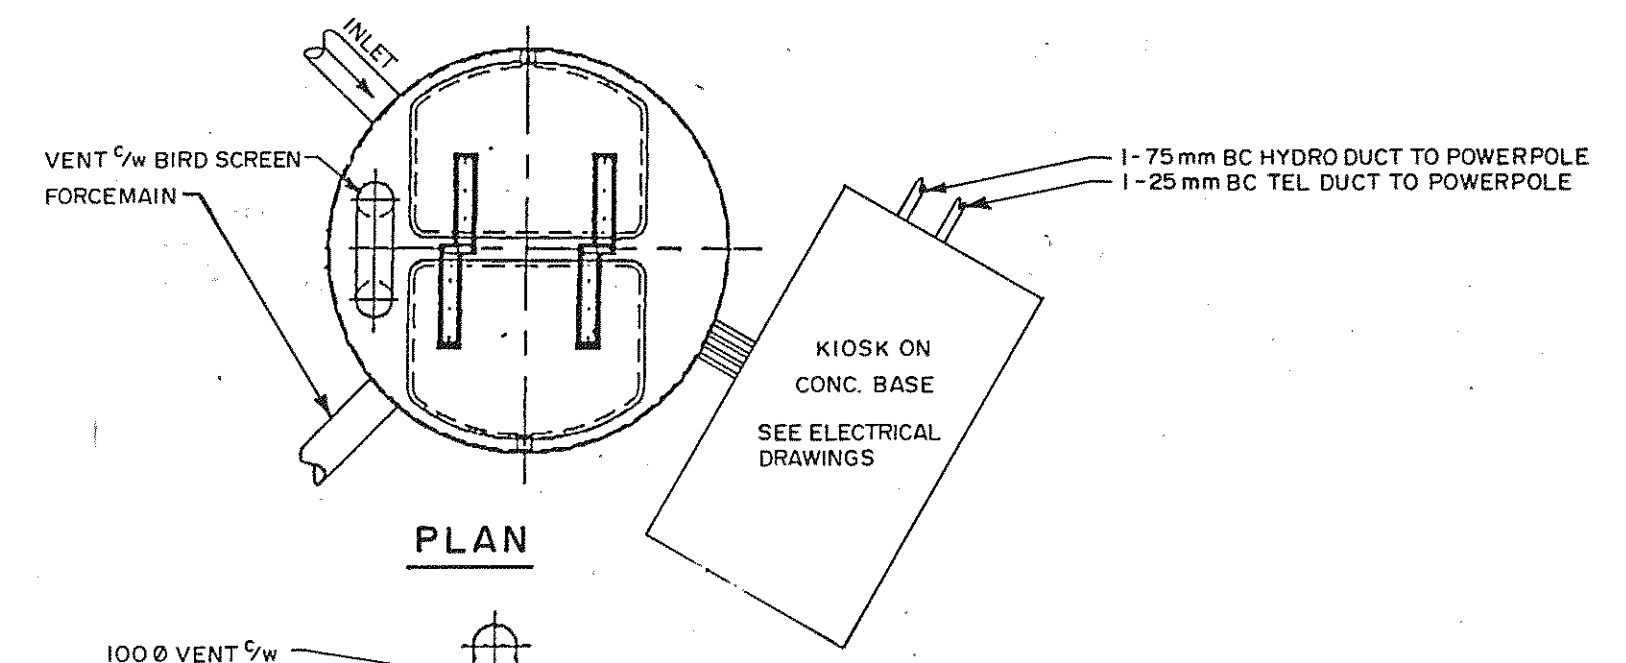

2400 Ø LIFT STATION DETAIL

NOTE:
FLOATS TO BE SET IN FIELD AFTER NUMBER OF CONNECTIONS ARE DETERMINED

REV	Y	M	D	REVISION	DESCRIPTION	DRN	SUP	DES	CHK	ENG
3	92	07	30	RECORD OF CONSTRUCTION		DEW				WT
2	92	01	13	ISSUED FOR TENDER		DEW				WT
1	91	09	25	ISSUED FOR TENDER		DEW				WT
0	91	05	31	FOR APPROVAL		DEW				WT

UMA Engineering Ltd.
Engineers & Planners

British Columbia Alberta Saskatchewan
Manitoba Ontario Yukon Territory
Northwest Territories

ENGINEER

REGIONAL DISTRICT OF CENTRAL OKANAGAN			
GREEN BAY SANITARY SEWER			
LIFT STATION AND STANDARD DETAILS			
JOB NO.	DWG. NO.	REV	
1698-026	5	3	
SCALE: NTS			

PERMIT

MIDVALLEY



PERFORMANCE CURVE

PRODUCT
CP3152.181

TYPE
HT



DATE
2013-10-25

PROJECT
GREEN BAY LS B

CURVE NO
63-454-00-5360

ISSUE
4

MOTOR COS PHI	1/1-LOAD 0.83	3/4-LOAD 0.79	1/2-LOAD 0.68	MOTOR SHAFT POWER	20	hp	IMPELLER DIAMETER 275 mm				
MOTOR EFFICIENCY	87.0 %	87.5 %	86.0 %	STARTING CURRENT ...	121	A	MOTORTYPE	STATOR	REV		
GEAR EFFICIENCY	—	—	—	RATED CURRENT ...	20	A	25-15-4AA	52D	11		
COMMENTS	INLET/OUTLET			RATED SPEED	1755	rpm	FREQ.	PHASES	VOLTAGE	POLES	
	-100 mm			TOT.MOM.OF INERTIA ...	0.24	kgm2	60 Hz	3	600 V	4	
IMP. THROUGHLET			NO. OF BLADES	1	GEARTYPE			RATIO			
76 mm						---			---		

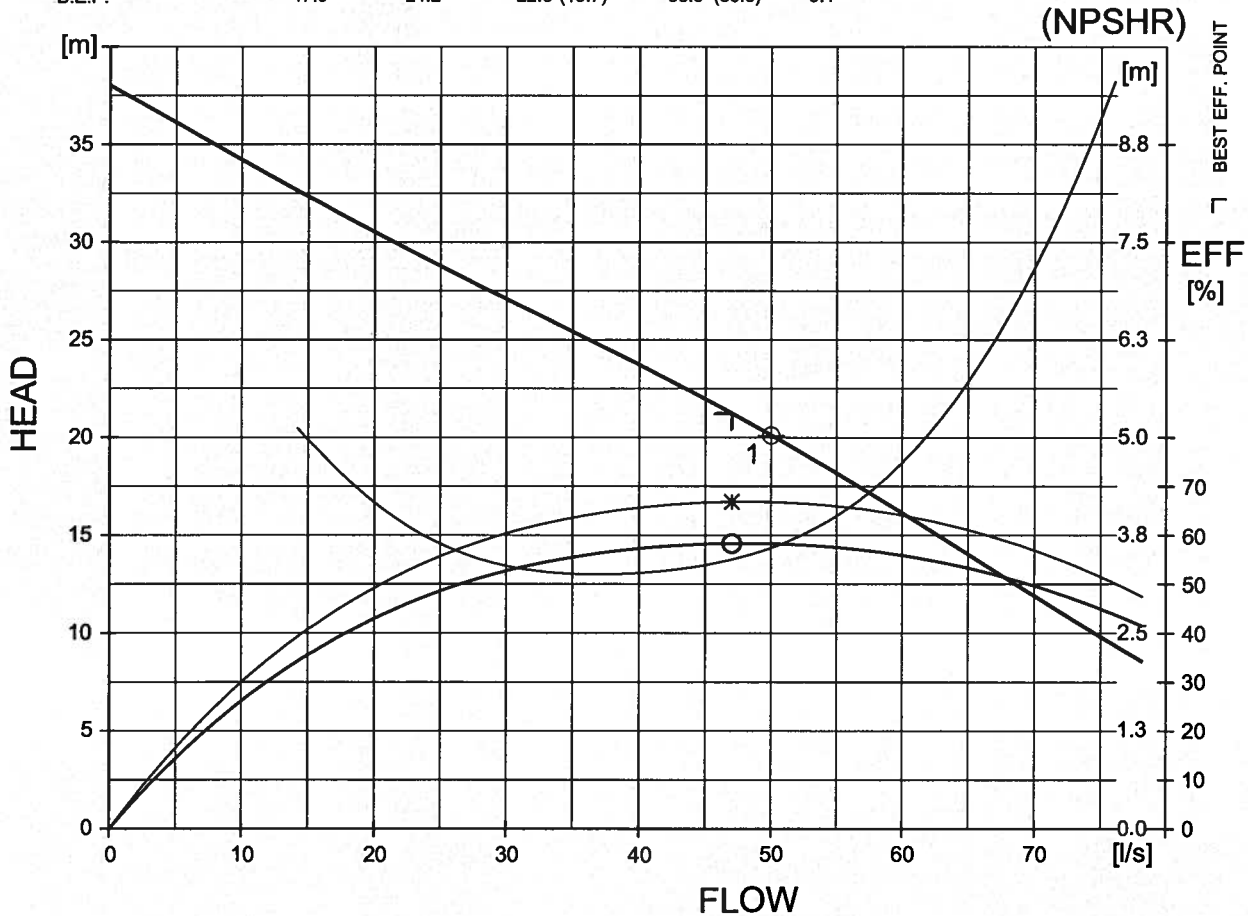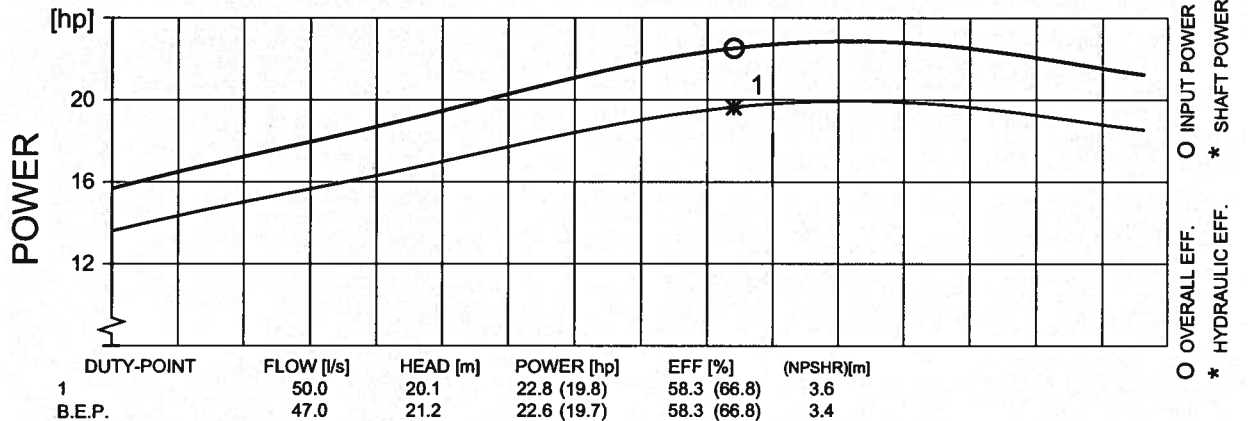

FLYPS3.1.5.7 (20060531)

(NPSHR) = (NPSH3) + margins

Performance with clear water and rating data at 40 °C



CURVE



District of West Kelowna

Sanitary Lift Station Evaluation

Station: Boucherie Road LS-9
Inspection By: Jim Kentel

Year Constructed: RDCO OPERATED
Year Upgraded:

Matrix Rating		
(10 - highest rating)	Civil	5
(1 - lowest rating)	Process Mechanical	20
	Electrical Instrumentation	25
	Total Station Rating	50 (max. rating 650 points)

Civil:

Matrix
Rating

Parking Area:	_____	n/a
Drainage:	_____	1
Influent sewer:	_____	1
Site access:	_____	1
Water service:	_____	1
Gas service:	_____	1

Process Mechanical:


Matrix
Rating

Station type:	_____	n/a
Number of pumps:	_____	n/a
Pump Redundancy:	_____	n/a
Pump Manufacturer / Type:	_____	1
Pump Model:	_____	n/a
Rated Capacity:	_____	n/a
Capacity Confirmation:	_____	n/a
Discharge pipe type / diameter:	_____	1
Header pipe type / diameter:	_____	1
Check valve type / diameter:	_____	1
Isolation valve type / diameter:	_____	1
Piping Condition:	_____	1
Emergency pumpout connection:	_____	1
Pressure gauges:	_____	1
Inlet bar screen:	_____	1
Wetwell condition:	_____	1
Access Hatches:	_____	1
Ladder / Platform:	_____	1
Wetwell benching:	_____	1
Odour Control:	_____	1
Ventilation:	_____	1
Humidity Control / Dehumidification:	_____	1
Grease / Debris Accumulation:	_____	1
Water washdown:	_____	1
Sump pump:	_____	1
Confined Space Entry Requirements	_____	1

Electrical / Instrumentation:

Matrix
Rating

Service Type	V / A / Phase / Wire	1
Pump 1 :	HP	1
	Volts Rpm	n/a
	FLA	n/a
	Starter	n/a
Pump 2 :	HP	1
	Volts Rpm	n/a
	FLA	n/a
	Starter	n/a
Pump 3 :	HP	1
	Volts Rpm	n/a
	FLA	n/a
	Starter	n/a
Control Voltage:		1
Control System:		1
		n/a
Alarm Functions:		1
		n/a
		n/a
		n/a
Receptacles:		1
Interior Lighting:		1
Exterior Lighting:		1
SCADA / Telemetry:		1
Main Breaker:		1
Metering:		1
MCC:		1
Control Panel:		1
Lighting Panel:		1
Flowmeter:		1
Ampmeters:		1
TVSS:		1
Grounding:		1
Lighting Protection:		1
UPS:		1
PLC:		1
Level Control:		1
Standby Generator:		1
Comments:		

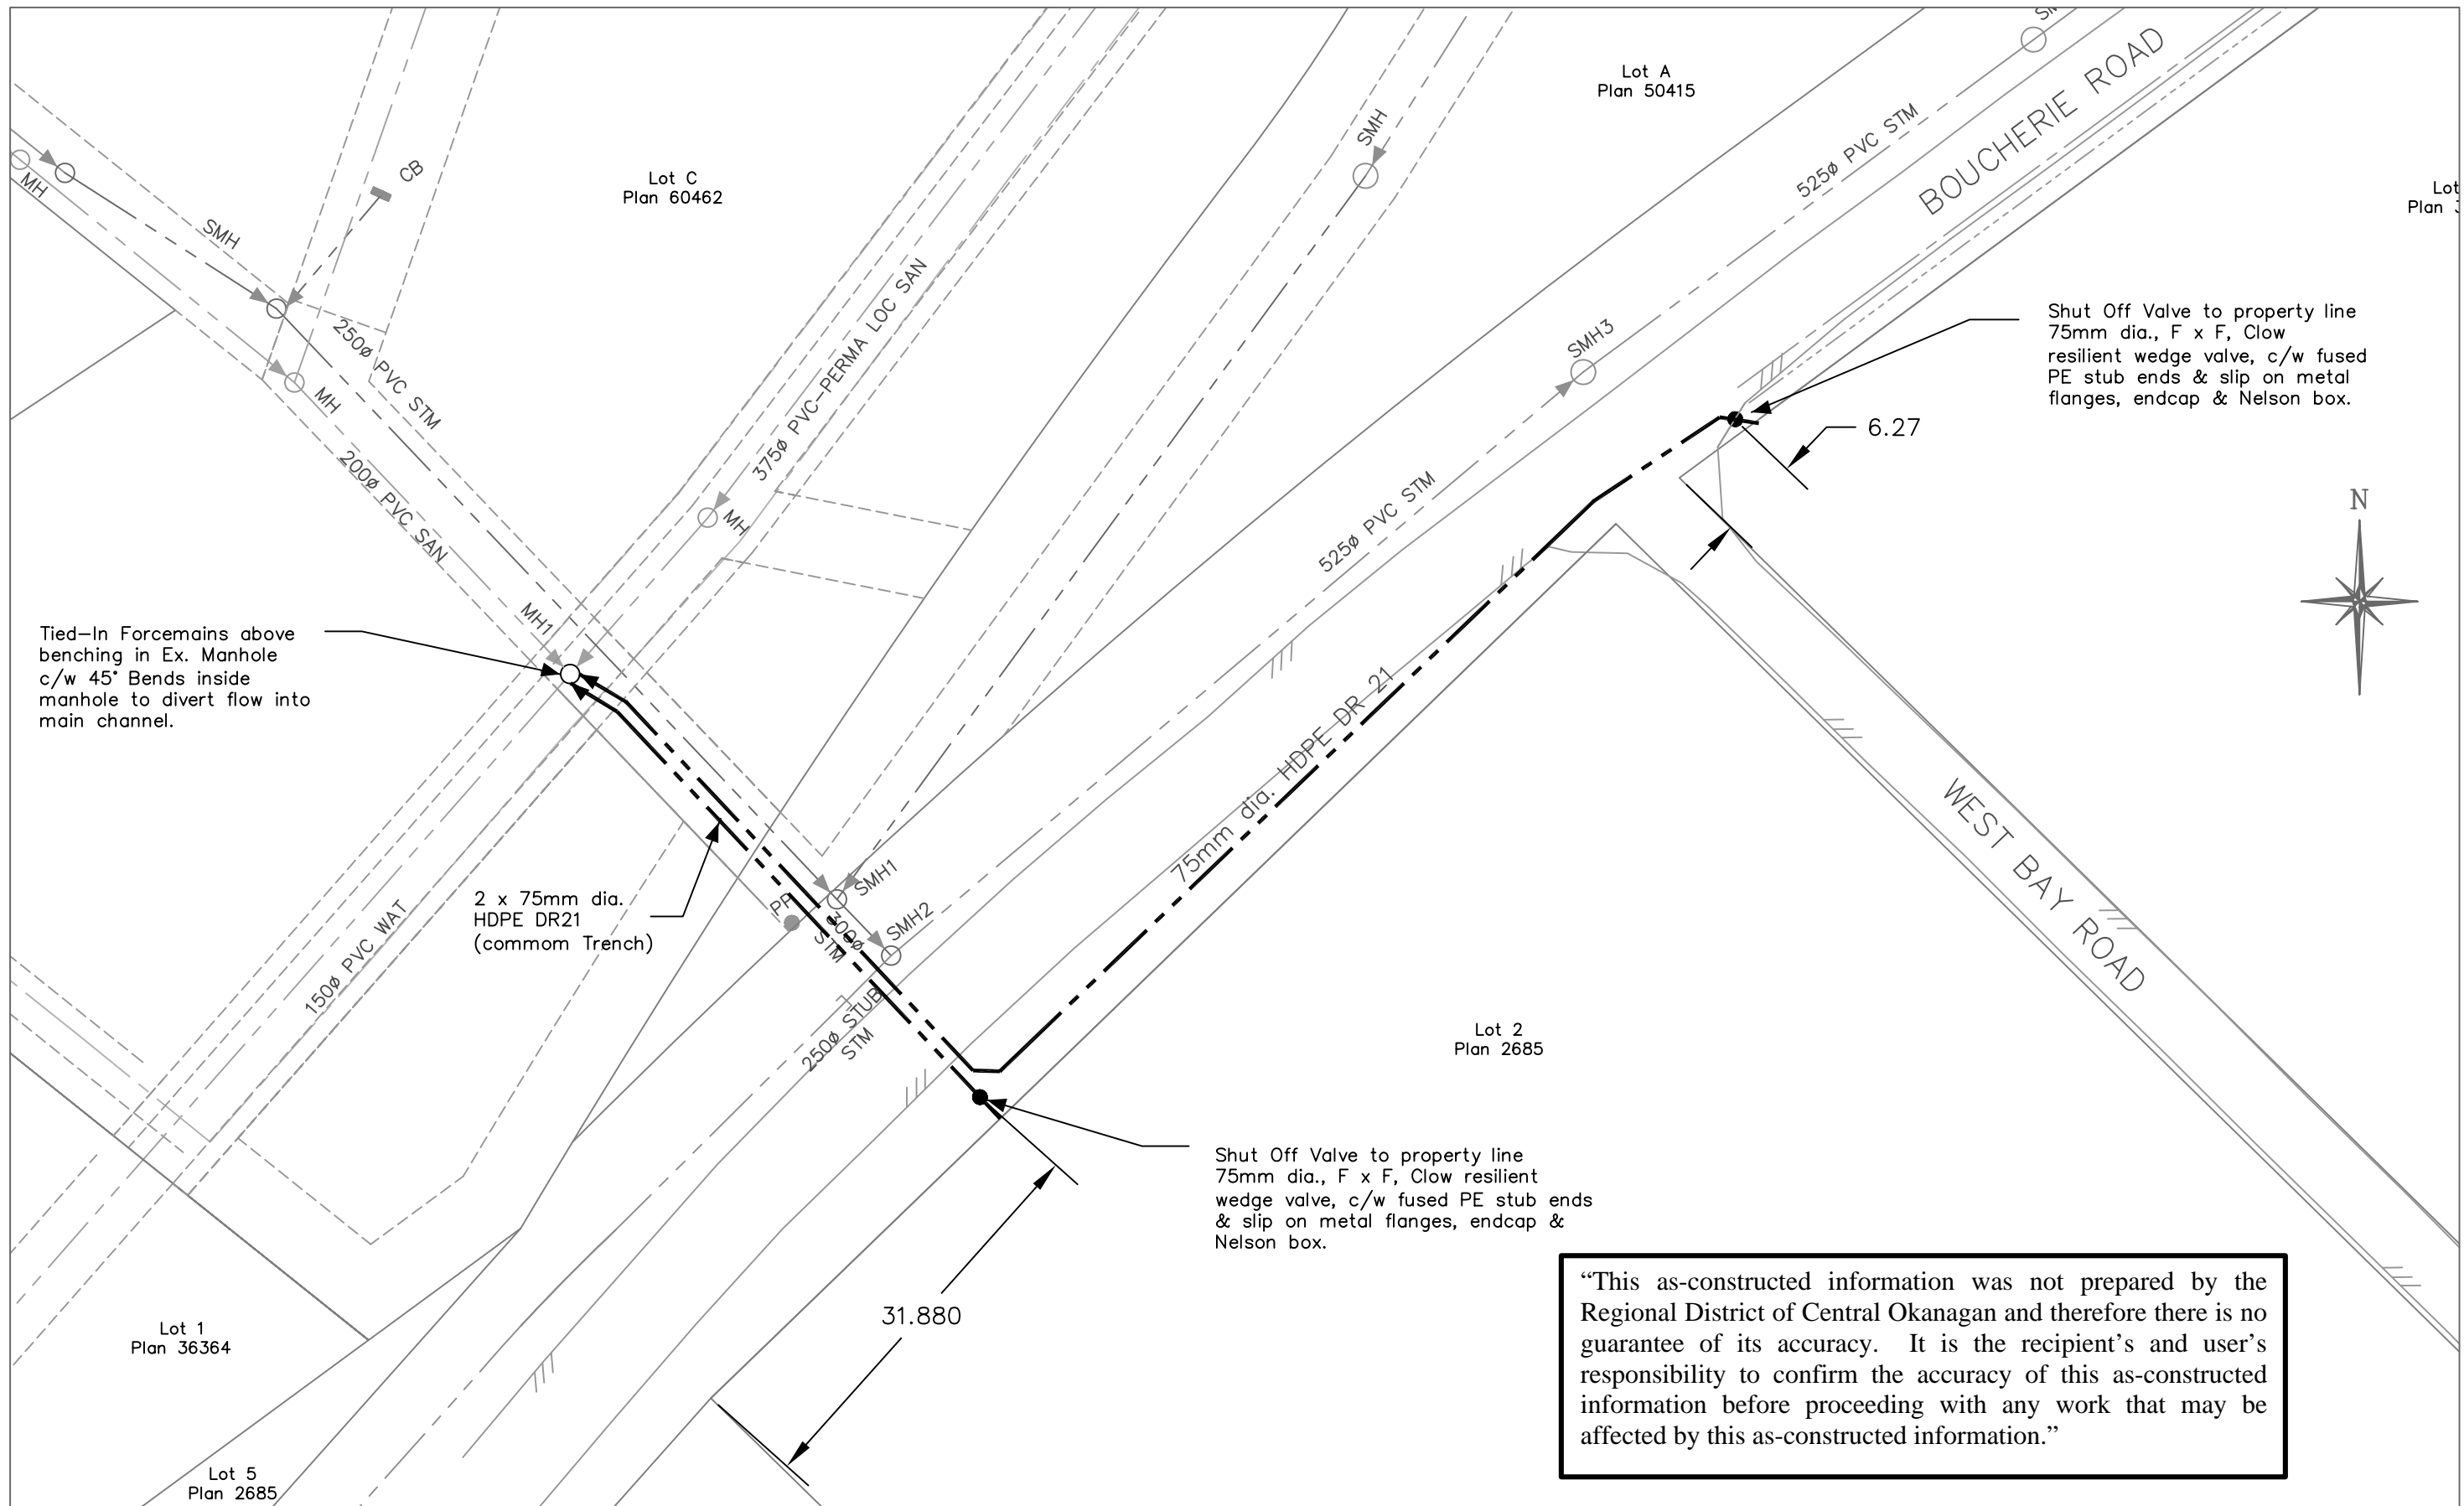

Tied-In Forcemains above benching in Ex. Manhole c/w 45° Bends inside manhole to divert flow into main channel.

2 x 75mm dia. HDPE DR21 (common Trench)

Shut Off Valve to property line 75mm dia., F x F, Clow resilient wedge valve, c/w fused PE stub ends & slip on metal flanges, endcap & Nelson box.

Shut Off Valve to property line 75mm dia., F x F, Clow resilient wedge valve, c/w fused PE stub ends & slip on metal flanges, endcap & Nelson box.

“This as-constructed information was not prepared by the Regional District of Central Okanagan and therefore there is no guarantee of its accuracy. It is the recipient’s and user’s responsibility to confirm the accuracy of this as-constructed information before proceeding with any work that may be affected by this as-constructed information.”

LEGEND CABLE TV ———— GAS ———— SAN. SEWER ———— STORM SEWER ———— U.G. ELECTRICAL ———— U.G. TELEPHONE ———— WATER ———— CAP ———— CATCH BASIN ———— ELECTRICAL BOX ———— HYDRANT ———— VALVE ———— LAMP STANDARD ———— SAN # SANITARY MH (EXISTING OR FUTURE) SAN # SANITARY MH (PROPOSED) STM # STORM MH (EXISTING OR FUTURE) STM # STORM MH (PROPOSED) TRANSFORMER ———— UTILITY JUNCTION BOX ————	1 09/09/04 V.F. AS CONSTRUCTED	No. DATE BY REVISION Chk'd No. DATE BY REVISION Chk'd	DRAWN VF DESIGN APPROVED DATE SEPT. 9, 2004 SCALE 1:500	RDCO 1430 K.L.O. Kelowna Boucherie Rd Low Pressure Forcemain RDCO File: 5340-70-646 PLAN	DRAWING NO. 01 REV. NO. 01
--	--------------------------------	---	---	---	-------------------------------



District of West Kelowna

Sanitary Lift Station Evaluation

Station: Boucherie Road LS-B LS-10
Inspection By: Jim Kentel

Year Constructed: RDCO OPERATED
Year Upgraded:

Matrix Rating				
(10 - highest rating)	Civil	5		
(1 - lowest rating)	Process Mechanical	20		
	Electrical Instrumentation	25		
	Total Station Rating	50 (max. rating 650 points)		Matrix

Civil:

Rating

Parking Area:	_____	n/a
Drainage:	_____	1
Influent sewer:	_____	1
Site access:	_____	1
Water service:	_____	1
Gas service:	_____	1

Process Mechanical:

Matrix
Rating


Station type:	_____	n/a
Number of pumps:	_____	n/a
Pump Redundancy:	_____	n/a
Pump Manufacturer / Type:	_____	1
Pump Model:	_____	n/a
Rated Capacity:	_____	n/a
Capacity Confirmation:	_____	n/a
Discharge pipe type / diameter:	_____	1
Header pipe type / diameter:	_____	1
Check valve type / diameter:	_____	1
Isolation valve type / diameter:	_____	1
Piping Condition:	_____	1
Emergency pumpout connection:	_____	1
Pressure gauges:	_____	1
Inlet bar screen:	_____	1
Wetwell condition:	_____	1
Access Hatches:	_____	1
Ladder / Platform:	_____	1
Wetwell benching:	_____	1
Odour Control:	_____	1
Ventilation:	_____	1
Humidity Control / Dehumidification:	_____	1
Grease / Debris Accumulation:	_____	1
Water washdown:	_____	1
Sump pump:	_____	1
Confined Space Entry Requirements	_____	1

Comments: _____

Electrical / Instrumentation:

Matrix
Rating

Service Type	V / A / Phase / Wire	1
Pump 1 :	HP	1
	Volts Rpm	n/a
	FLA	n/a
	Starter	n/a
Pump 2 :	HP	1
	Volts Rpm	n/a
	FLA	n/a
	Starter	n/a
Pump 3 :	HP	1
	Volts Rpm	n/a
	FLA	n/a
	Starter	n/a
Control Voltage:		1
Control System:		1
		n/a
Alarm Functions:		1
		n/a
		n/a
		n/a
Receptacles:		1
Interior Lighting:		1
Exterior Lighting:		1
SCADA / Telemetry:		1
Main Breaker:		1
Metering:		1
MCC:		1
Control Panel:		1
Lighting Panel:		1
Flowmeter:		1
Ampmeters:		1
TVSS:		1
Grounding:		1
Lighting Protection:		1
UPS:		1
PLC:		1
Level Control:		1
Standby Generator:		1
Comments:		

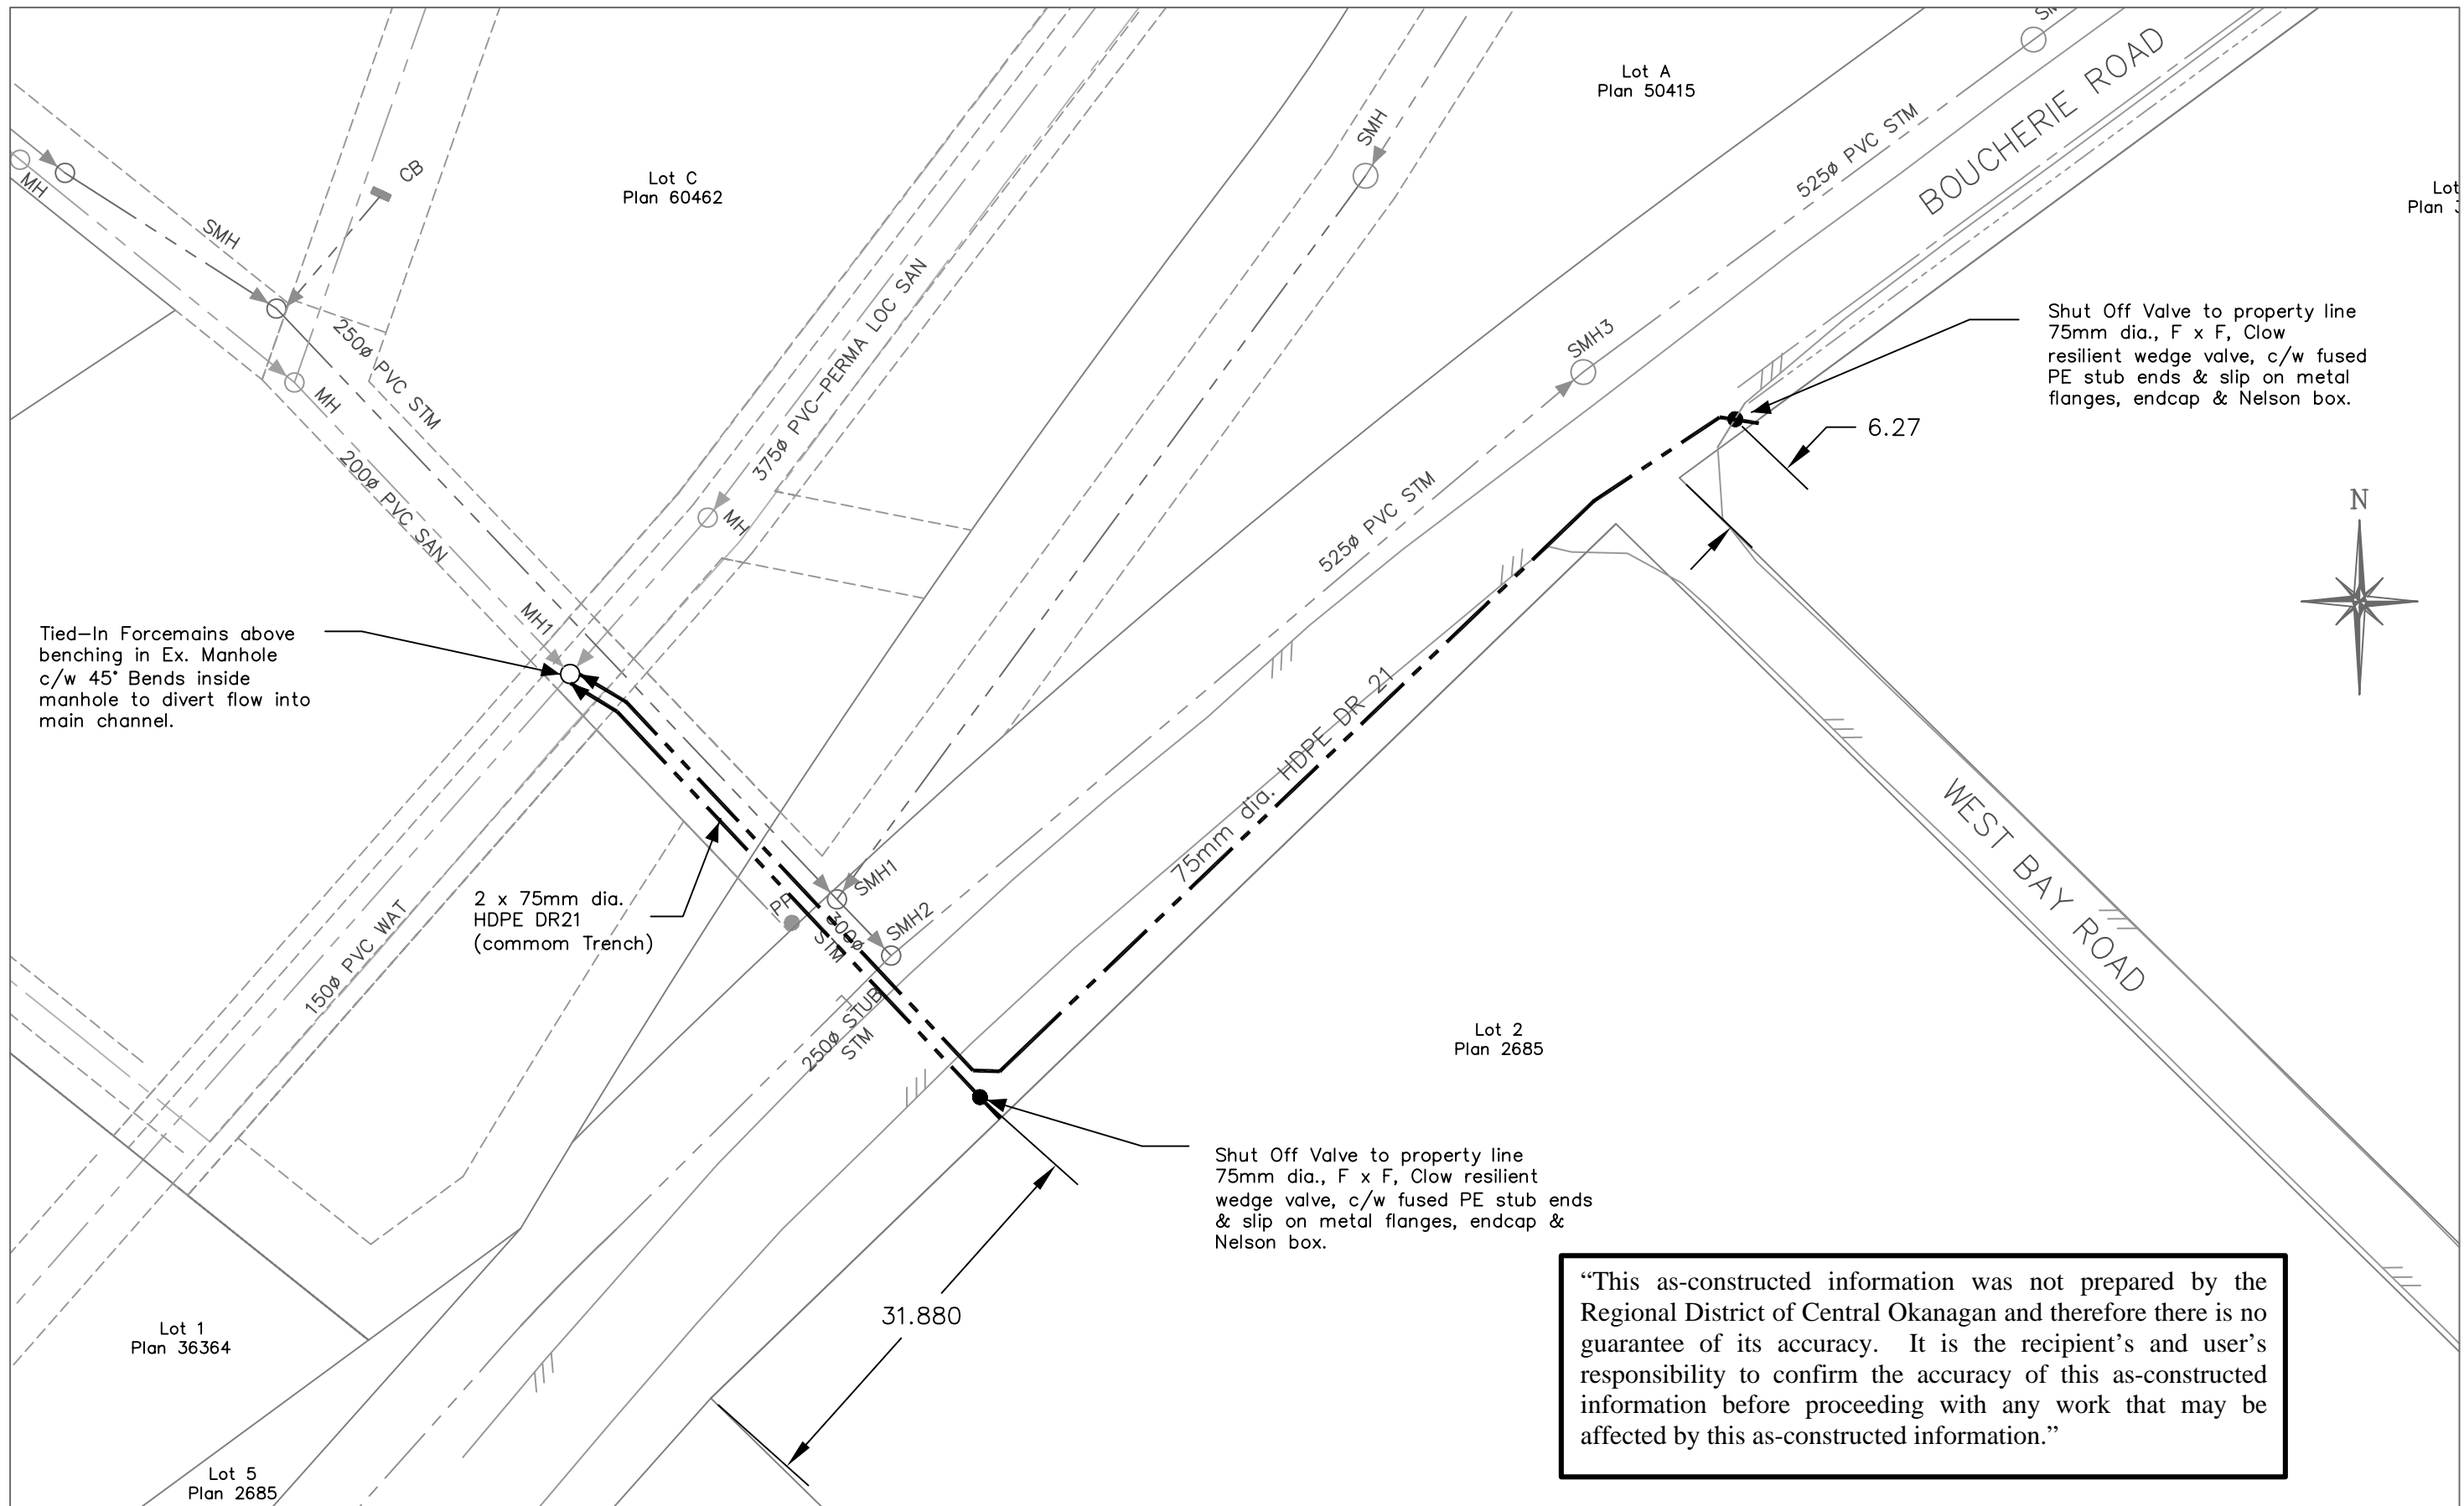

Tied-In Forcemains above benching in Ex. Manhole c/w 45° Bends inside manhole to divert flow into main channel.

2 x 75mm dia. HDPE DR21 (common Trench)

Shut Off Valve to property line 75mm dia., F x F, Clow resilient wedge valve, c/w fused PE stub ends & slip on metal flanges, endcap & Nelson box.

Shut Off Valve to property line 75mm dia., F x F, Clow resilient wedge valve, c/w fused PE stub ends & slip on metal flanges, endcap & Nelson box.

“This as-constructed information was not prepared by the Regional District of Central Okanagan and therefore there is no guarantee of its accuracy. It is the recipient’s and user’s responsibility to confirm the accuracy of this as-constructed information before proceeding with any work that may be affected by this as-constructed information.”

LEGEND CABLE TV ———— GAS ———— SAN. SEWER ———— STORM SEWER ———— U.G. ELECTRICAL ———— U.G. TELEPHONE ———— WATER ————		CAP CATCH BASIN ELECTRICAL BOX HYDRANT VALVE LAMP STANDARD	SAN # SAN # STM # STM # TRANSFORMER UTILITY JUNCTION BOX	SANITARY MH (EXISTING OR FUTURE) SANITARY MH (PROPOSED) STORM MH (EXISTING OR FUTURE) STORM MH (PROPOSED)	1 09/09/04 V.F. AS CONSTRUCTED	No. DATE BY REVISION Chk'd No. DATE BY REVISION Chk'd	H:\ADMIN\Logos\RDCO\20logo%20bw%.jpg	DRAWN VF DESIGN APPROVED DATE SEPT. 9, 2004 SCALE 1:500	RDCO 1430 K.L.O. Kelowna Boucherie Rd Low Pressure Forcemain RDCO File: 5340-70-646 PLAN	TELEPHONE FAX DRAWING NO. 01 REV. NO. 01
--	--	---	---	--	--------------------------------	---	--------------------------------------	---	--	---



District of West Kelowna

Sanitary Lift Station Evaluation

Station: Sunnyside LS 11
Inspection By: Jim Kentel

Year Constructed: 10/1/2001
Year Upgraded:

Matrix Rating		
(10 - highest rating)	Civil	31
(1 - lowest rating)	Process Mechanical	93
	Electrical Instrumentation	117
	Total Station Rating	241 (max. rating 370 points)





Civil:	<u>Matrix Rating</u>
Parking Area:	n/a
Drainage: Good	10
Influent sewer: 200 Gravity PVC	10
Site access: Good	10
Water service:	1
	31

Process Mechanical:	<u>Matrix Rating</u>
Station type: FRP 2.44m diameter	n/a
Number of pumps: 2	n/a
Pump Redundancy: Yes	n/a
Pump Manufacturer / Type: Myers	5
Pump Model:	n/a
Rated Capacity:	n/a
Capacity Confirmation:	n/a
Forcemain pipe type / diameter: HDPE / 150	8
Header pipe type / diameter: /100 FRP	8
Check valve type / diameter: FLYGT Ball HDL / 100	8
Isolation valve type / diameter: Plug Valve / 100	8
Piping Condition: Good	
Emergency pumpout connection: Yes	10
Pressure gauges:	
Inlet bar screen: No	1
Wetwell condition: Good	8
Access Hatches: Alum	8
Ladder / Platform: alum/FRP	8
Wetwell benching:	10
Odour Control: No	1
Ventilation: Yes	8
Water washdown:	1
Confined Space Entry Requirements Davit	1
	93

Electrical / Instrumentation:







Matrix
Rating

Service Type	V / A / Phase / Wire	n/a
Pump 1 :	HP 40	n/a
	Volts 600 Rpm 3475	n/a
	FLA 47.2A	n/a
Starting Current		n/a
Pump 2 :	HP 40	n/a
	Volts 600 Rpm 3475	n/a
	FLA 47.2A	n/a
Starting Current		n/a
Alarm Functions:	Yes	10
		n/a
		n/a
		n/a
Receptacle	Yes	10
Interior Lighting:	Yes	10
Exterior Lighting:	No	1
SCADA / Telemetry:	Provision	5
Main Breaker:	200A	10
Control Panel:	Yes	8
Lighting Panel:	Yes	8
Flowmeter:	Chamber yes	10
Grounding:	Yes	10
Surge Protection:	Yes	10
UPS:	Yes	8
PLC:	Yes	8
Level Control:	Milltronics/Bulb backup	8
Standby Generator:	No	1
		117
Comments:		

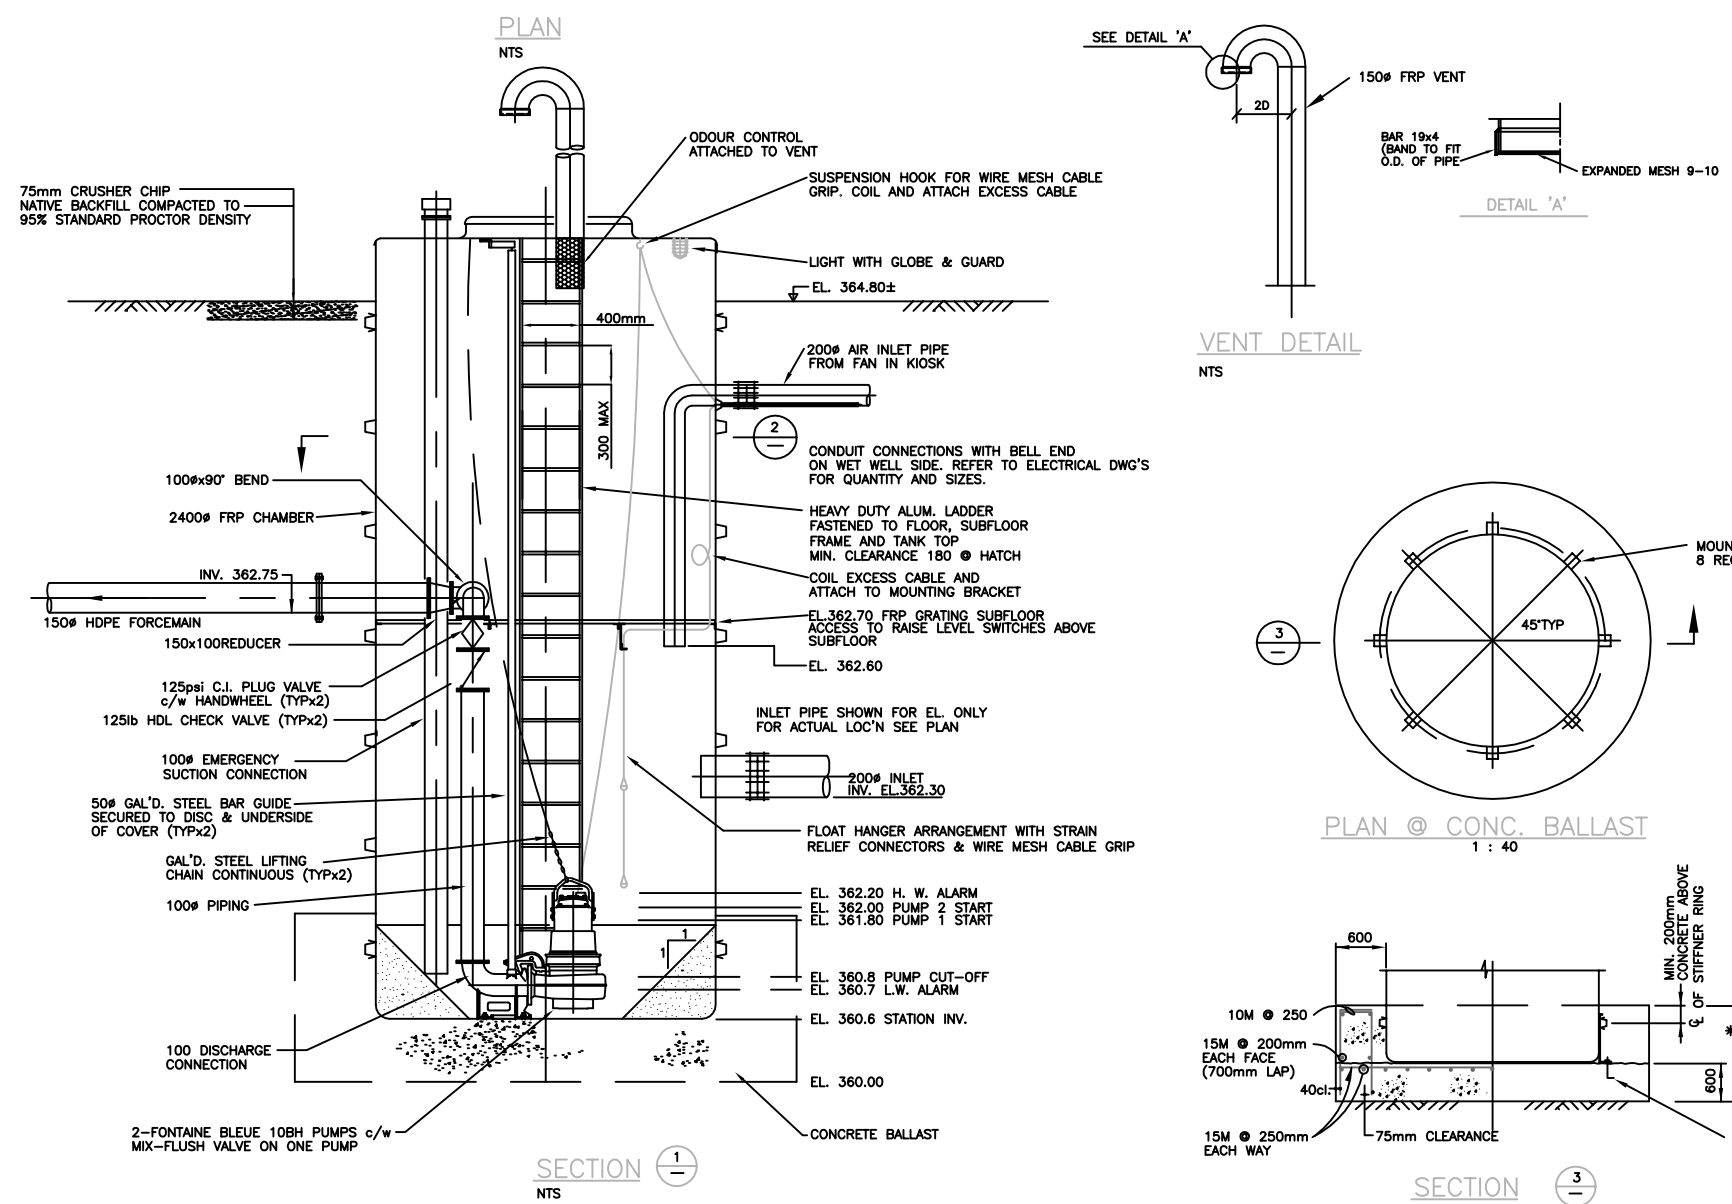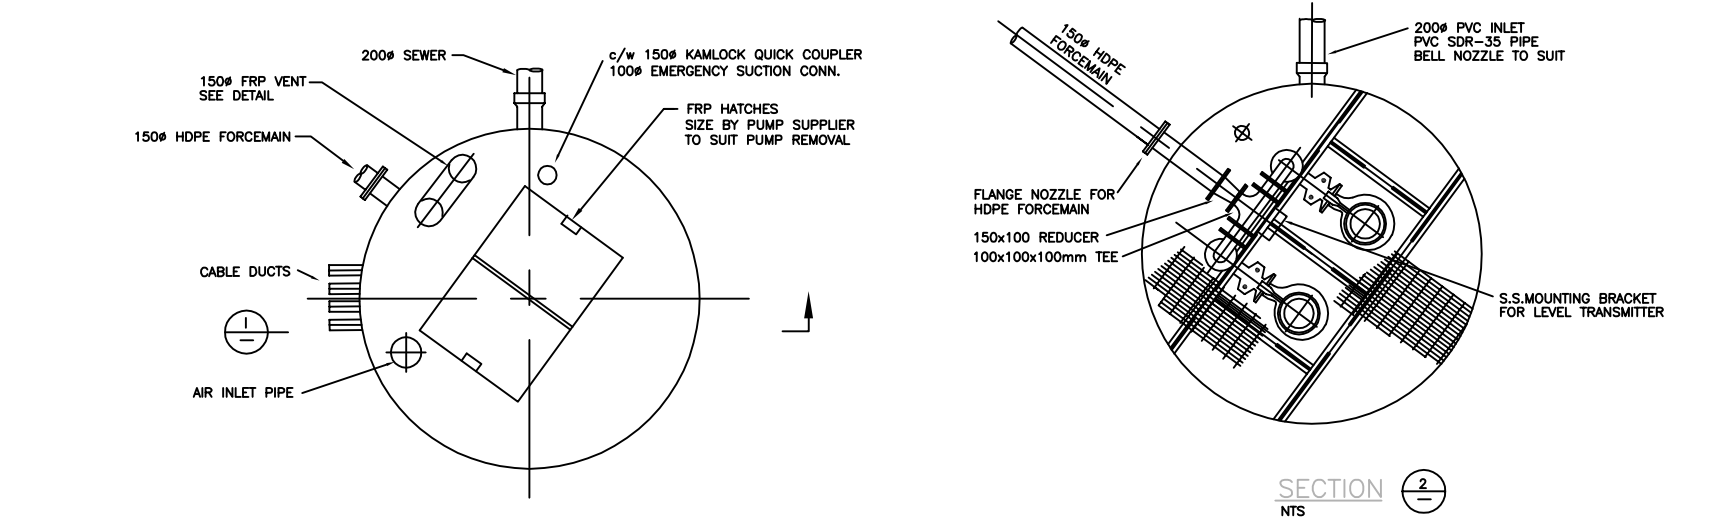

"This as-constructed information was not prepared by the Regional District of Central Okanagan and therefore there is no guarantee of its accuracy. It is the recipient's and user's responsibility to confirm the accuracy of this as-constructed information before proceeding with any work that may be affected by this as-constructed information."

No.	Date	By	Revision	Ch'd
2	12/01/01		ISSUED FOR TENDER	

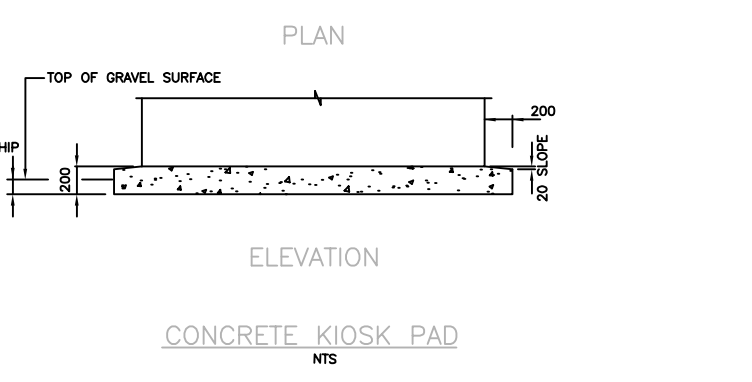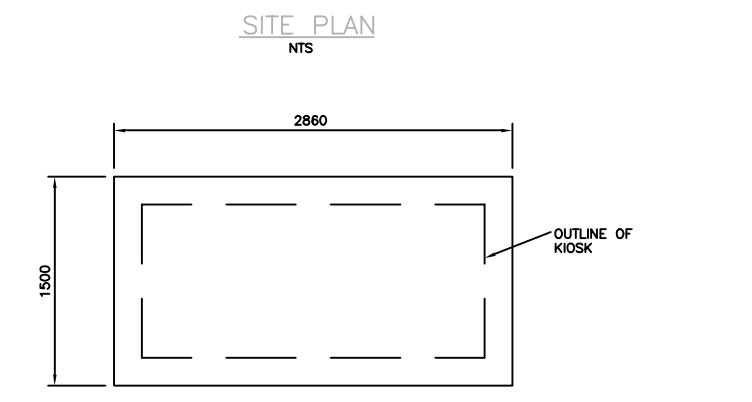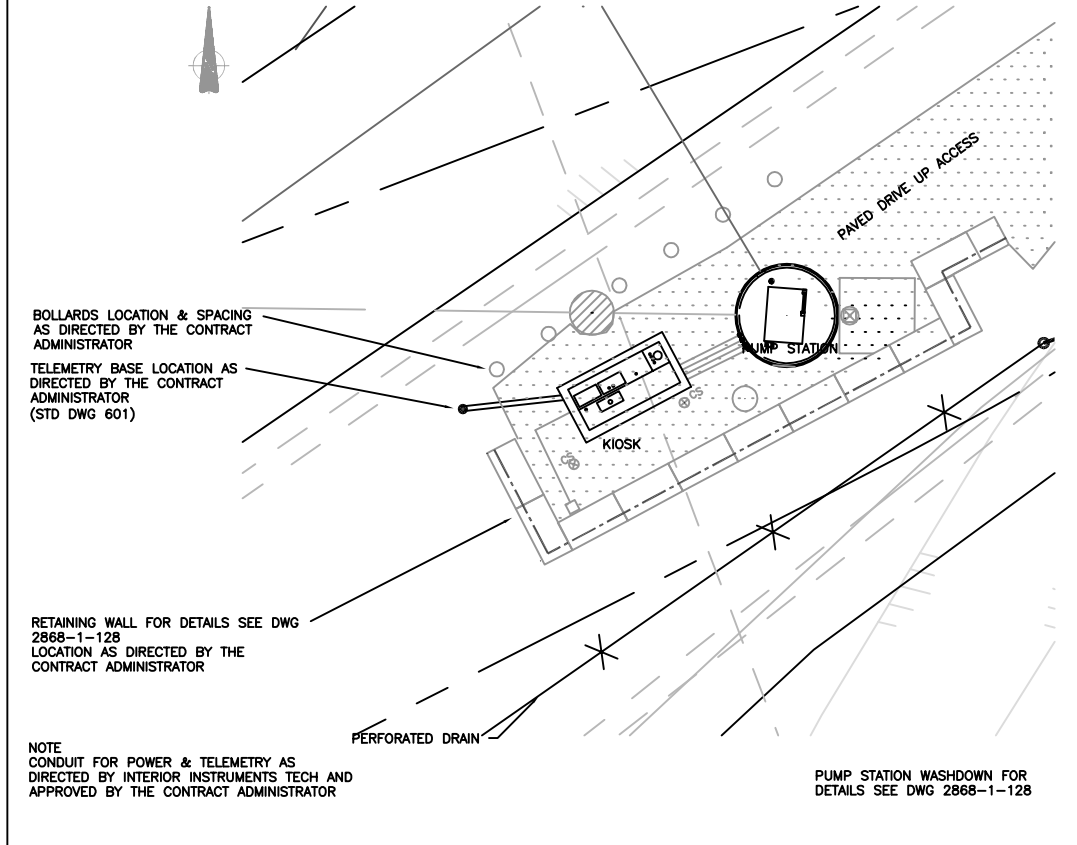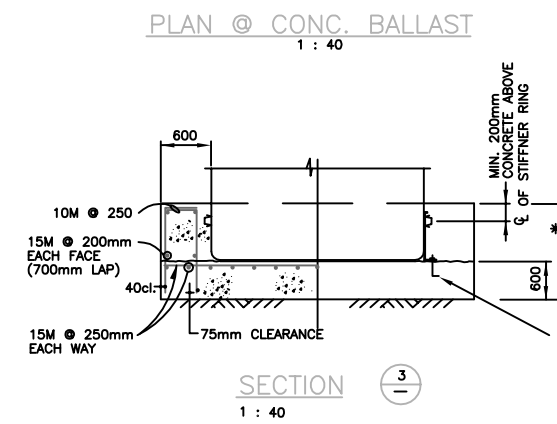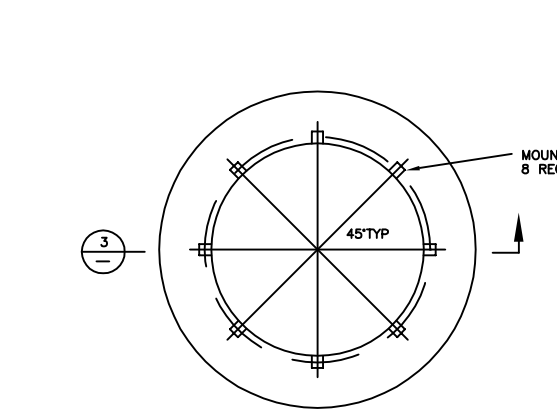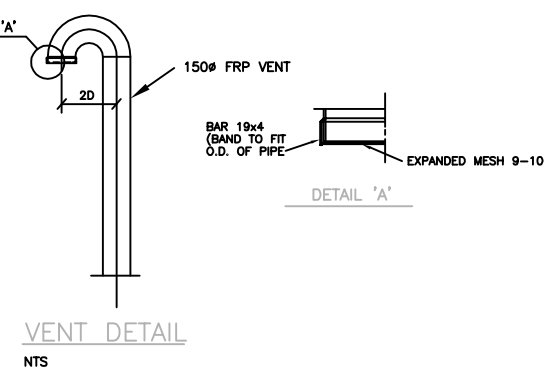

NOTE:
REFER TO ENGINEERED PUMPS DWG. 01-063-M1 FOR PUMP STATION DETAILS

ASSOCIATED ENGINEERING **AE**





Drawn KR
Design AA
Approved
Date SEPT.00
Scale AS NOTED

REGIONAL DISTRICT OF CENTRAL OKANAGAN
SUNNYSIDE SEWER PROJECT
SUNNYSIDE ROAD
SEWAGE PUMP STATION DETAILS

Drawing No.
2868-1-501
Rev.No.
0

NOTE
 ALL LOCATIONS OF EXISTING UTILITIES SHOWN ARE APPROXIMATE ONLY AND SHOULD BE CONFIRMED BY USE OF PIPE LOCATOR AND MANUAL DIGGING. ALL OR ANY EXISTING STRUCTURES NOT NECESSARILY SHOWN. ELEVATIONS ARE TO GEODETIC DATUM. ALL SERVICES 100# U.N.O.

NOTE
 CONDUIT FOR POWER & TELEMETRY AS DIRECTED BY INTERIOR INSTRUMENTS TECH AND APPROVED BY THE CONTRACT ADMINISTRATOR

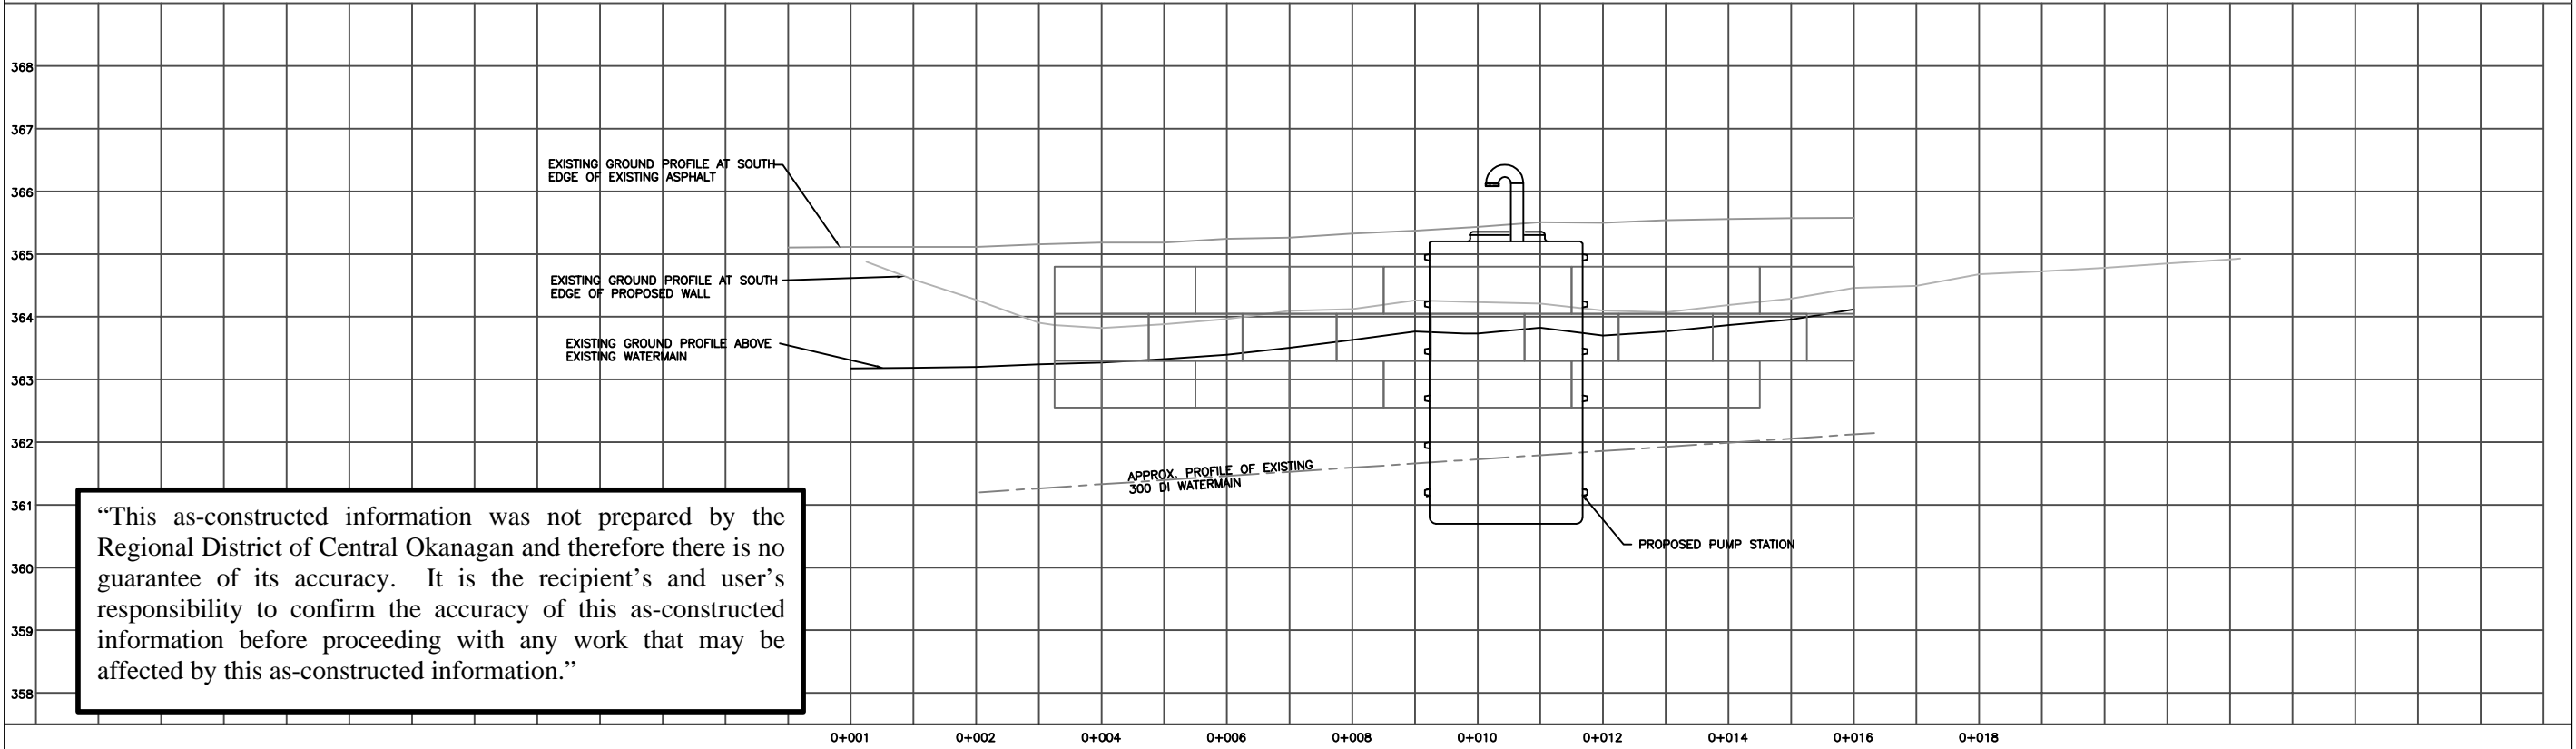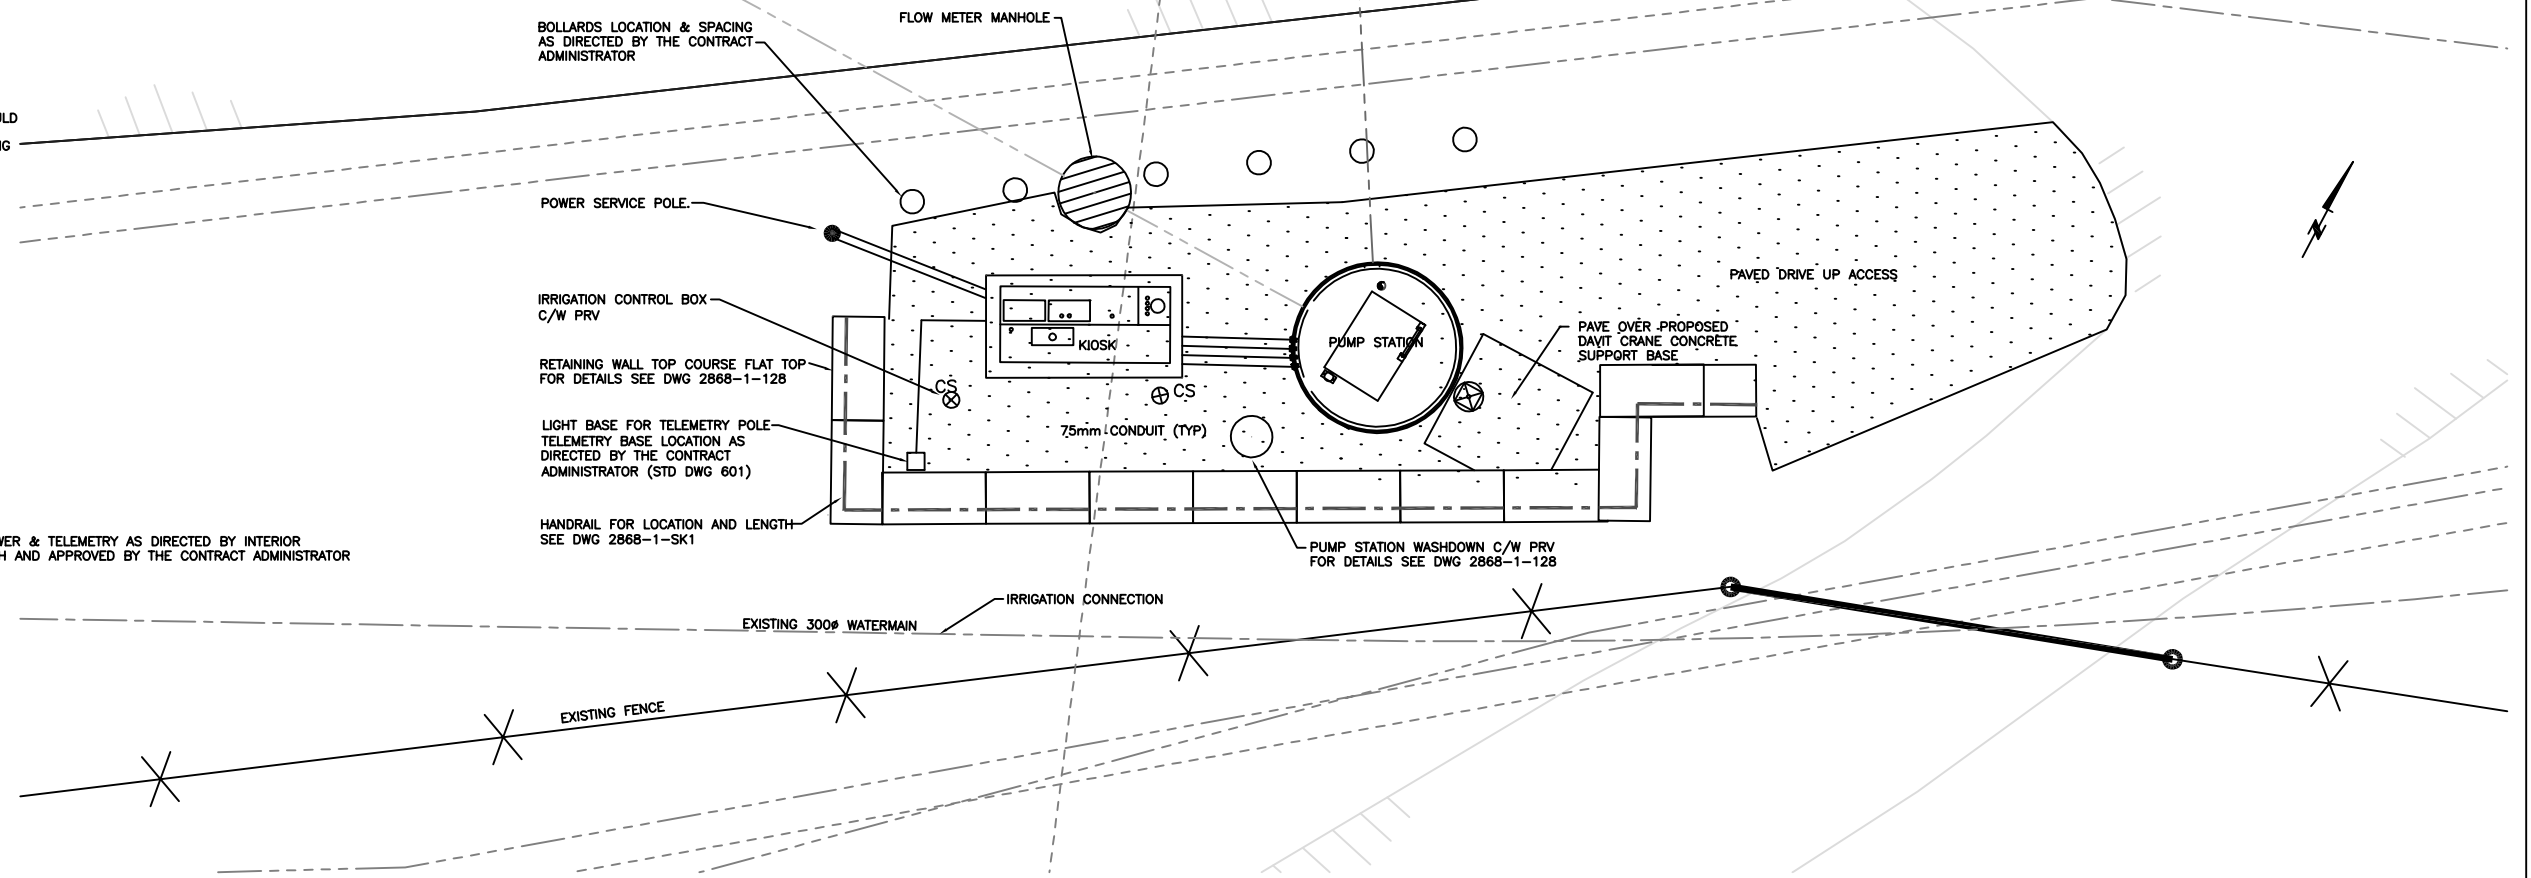

“This as-constructed information was not prepared by the Regional District of Central Okanagan and therefore there is no guarantee of its accuracy. It is the recipient’s and user’s responsibility to confirm the accuracy of this as-constructed information before proceeding with any work that may be affected by this as-constructed information.”

No.	Date	By	Revision	Ch'd
0	22/05/01		FOR APPROVAL	

No.	Date	By	Revision	Ch'd

ASSOCIATED ENGINEERING 

REGIONAL DISTRICT OF CENTRAL OKANAGAN 

Drawn	DD
Design	DD
Approved	
Date	SEPT 99
Scale	H= 1:50 V= 1:50

REGIONAL DISTRICT OF CENTRAL OKANAGAN

SUNNYSIDE SEWER PROJECT
 SUNNYSIDE ROAD PUMP STATION WALL

Drawing No.	2868-1-502
Rev.No	0



District of West Kelowna

Sanitary Lift Station Evaluation

Station: King Road LS 12
Inspection By: Jim Kentel

Year Constructed: 9/1/2006
Year Upgraded:

Matrix Rating		
(10 - highest rating)	Civil	5
(1 - lowest rating)	Process Mechanical	47
	Electrical Instrumentation	99
	Total Station Rating	151 (max. rating 370 points)



Civil:Matrix
Rating

Parking Area:	_____	n/a
Drainage:	_____	1
Influent sewer:	_____	1
Site access:	_____	1
Water service:	_____	1
Gas service:	_____	1
		<u>5</u>



Process Mechanical:Matrix
Rating

Station type:	Concrete 1.8m Manhole	n/a
Number of pumps:	2	n/a
Pump Redundancy:	Yes	n/a
Pump Manufacturer / Type:	FLYGT Submersible	1
Pump Model:	CP 3102.170	n/a
Rated Capacity:	5.5 L/S @ 17.9m TDH	n/a
Capacity Confirmation:	_____	n/a
Discharge pipe type / diameter:	PVC /50	10
Header pipe type / diameter:	Rubber Hose / 50 SS	1
Check valve type / diameter:	/50	1
Isolation valve type / diameter:	SS Ball Valve /50	1
Piping Condition:	_____	1
Emergency pumpout connection:	No flush but hose connection	1
Pressure gauges:	No	1
Inlet bar screen:	No	1
Wetwell condition:	_____	1
Access Hatches:	MH Frame	5
Ladder / Platform:	Rungs/no platform	3
Wetwell benching:	Sulplants resistant concrete	5
Odour Control:	No	1
Ventilation:	Goose Neck	3
Water washdown:	38mm Service	10
Confined Space Entry Requirements	No	1
		<u>47</u>


Electrical / Instrumentation:

Matrix
Rating

Service Type	V / A / Phase / Wire	n/a
Pump 1 :	HP 5.4	n/a
	Volts 230 Rpm	n/a
	FLA	n/a
Starting Current		n/a
Pump 2 :	HP 5.4	n/a
	Volts 230 Rpm	n/a
	FLA	n/a
Starting Current		n/a
Alarm Functions:		5
		n/a
		n/a
		n/a
Receptacle	Yes	10
Interior Lighting:	No	10
Exterior Lighting:	No	1
SCADA / Telemetry:	Yes	5
Main Breaker:		10
Control Panel:		10
Lighting Panel:		10
Flowmeter:	No	1
Grounding:		10
Surge Protection:		10
UPS:		10
PLC:		1
Level Control:	Bulbs Milltronics	5
Standby Generator:	No	1
		99
Comments:		

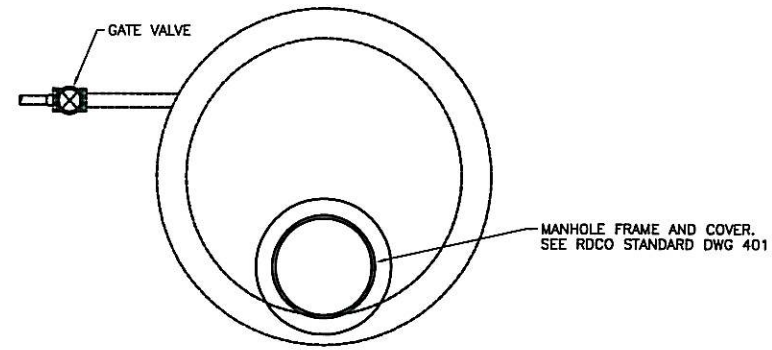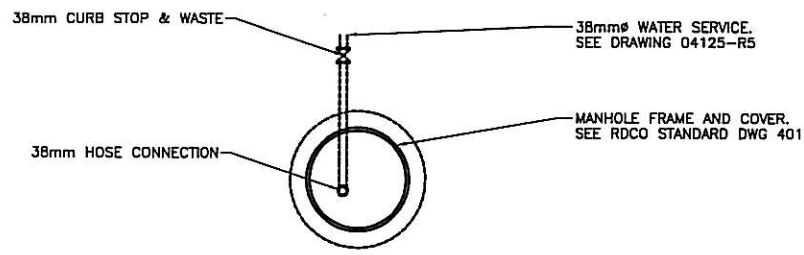

S.L.S. - TOP PLAN
SCALE: 1:25

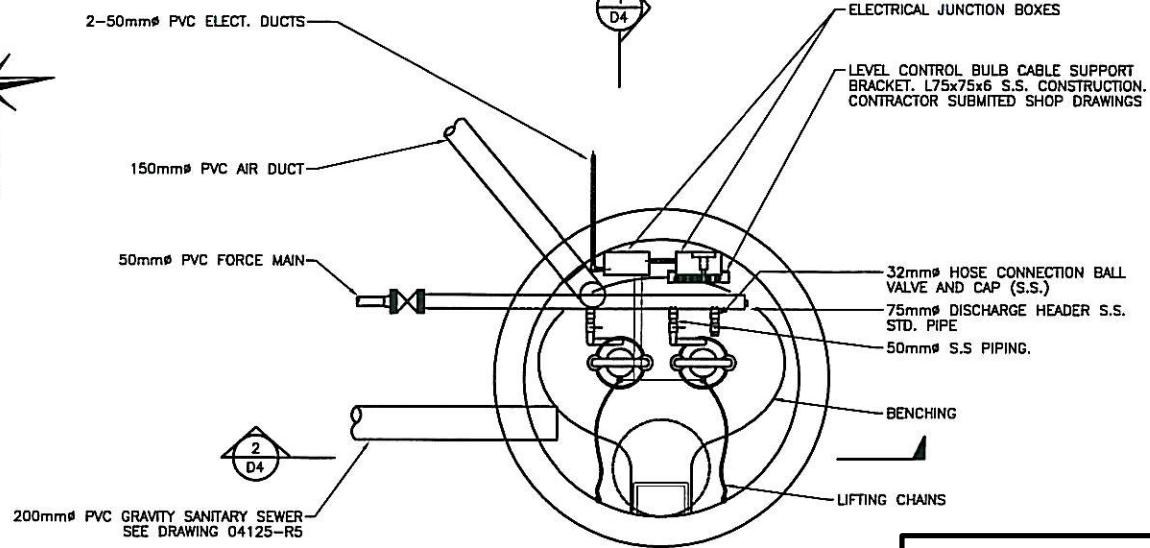


S.L.S. - WETWELL PLAN
SCALE: 1:25


NOTES:

ALL LOCATIONS OF EXISTING UTILITIES SHOWN ARE APPROXIMATE ONLY. ALL OR ANY EXISTING STRUCTURES NOT NECESSARILY SHOWN. ELEVATIONS ARE TO GEODETIC DATUM. CONDUIT FOR POWER & TELEMETRY AS DIRECTED BY RDCO PUBLIC WORKS, B.C. HYDRO AND APPROVED BY THE CONTRACT ADMINISTRATOR. RECEIVED AND INSTALLED 2 PRE-PURCHASED FLYGT PUMPS c/w HOSES, CHAINS AND POWER CABLES. COORDINATED SUPPLY AND INSTALLATION OF ALL ELECTRICAL/CONTROLS EQUIPMENT WITH RDCO PUBLIC WORKS. ALL STAINLESS STEEL (S.S.) CALLED TO BE 316L GRADE. REFER TO APPENDIX E FOR FURTHER ELECTRICAL DETAILS.

"This as-constructed information was not prepared by the Regional District of Central Okanagan and therefore there is no guarantee of its accuracy. It is the recipient's and user's responsibility to confirm the accuracy of this as-constructed information before proceeding with any work that may be affected by this as-constructed information."

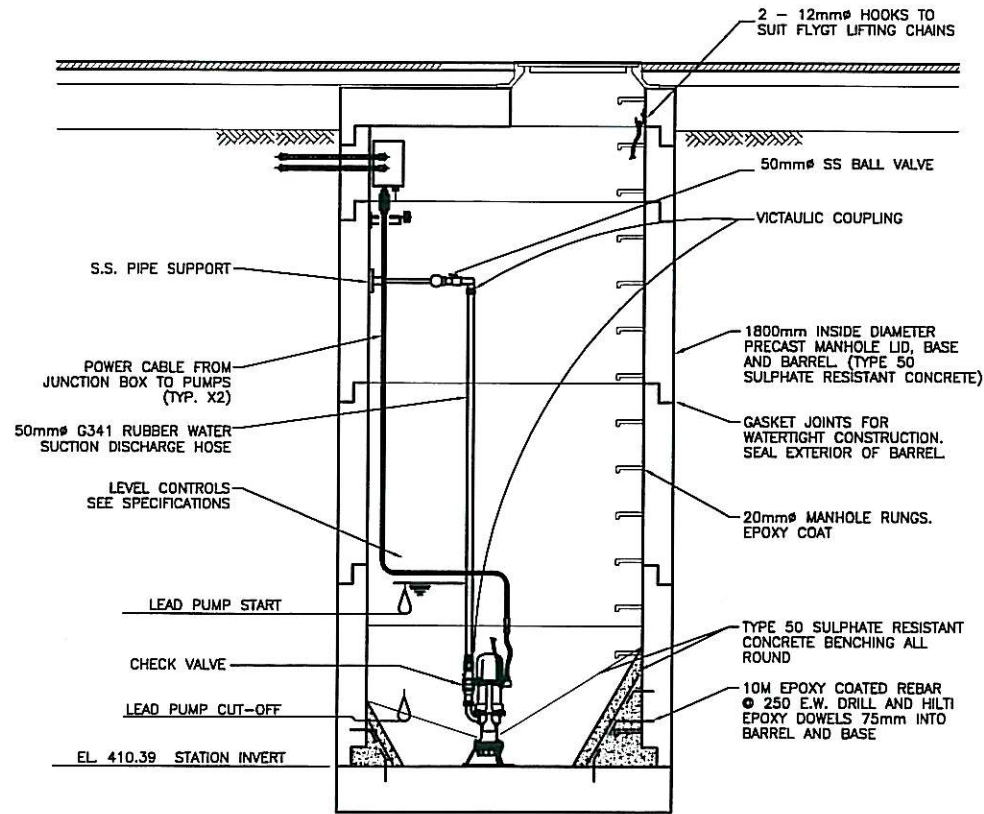

SECTION 1
SCALE: NTS

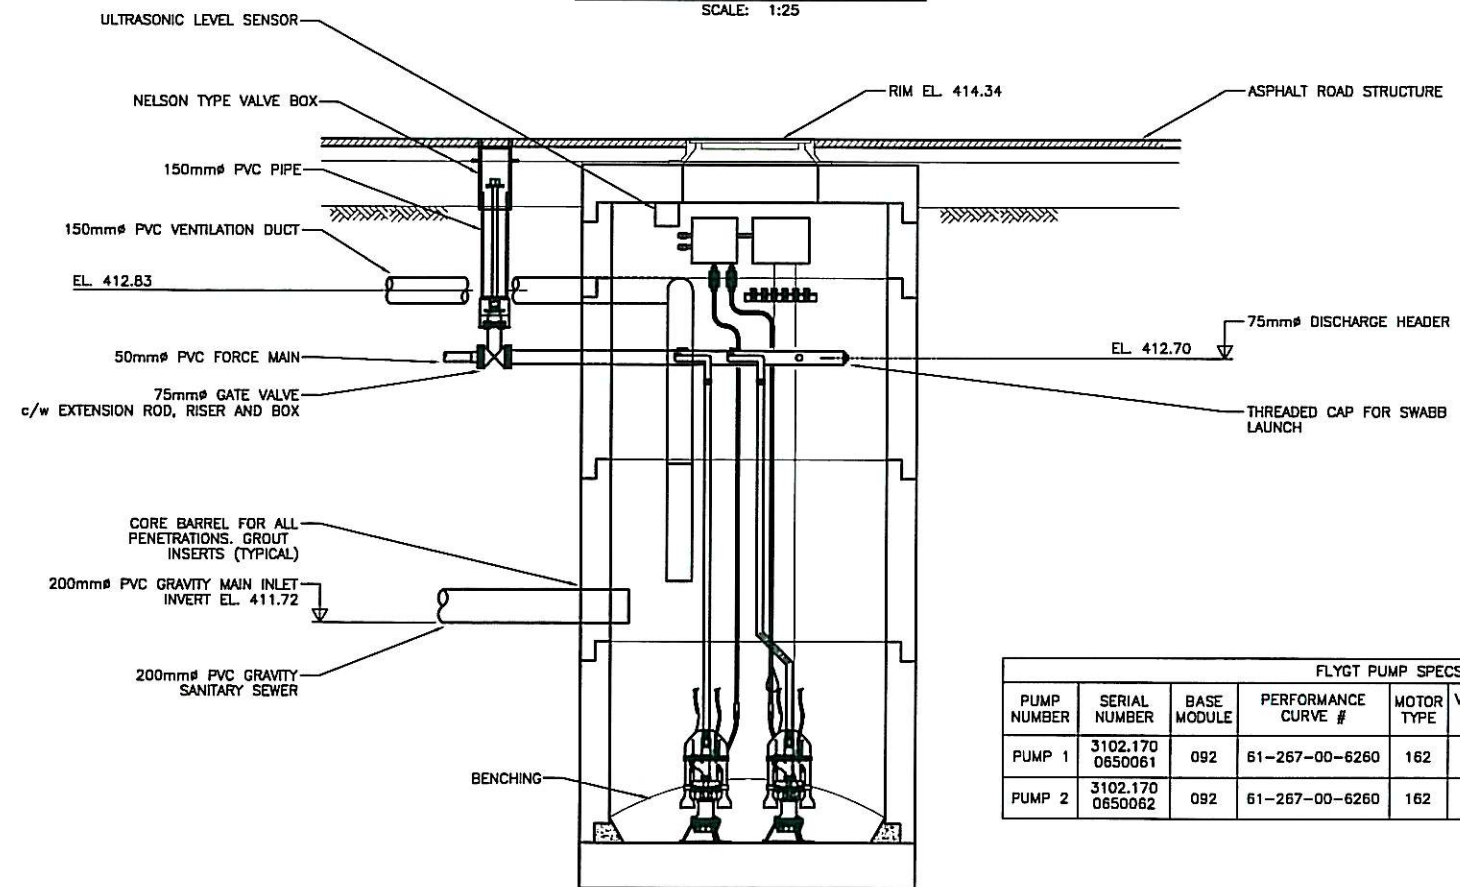

SECTION 2
SCALE: NTS

FLYGT PUMP SPECS								
PUMP NUMBER	SERIAL NUMBER	BASE MODULE	PERFORMANCE CURVE #	MOTOR TYPE	VOLTAGE (V)	IMPELLER NUMBER	CIMP. DIA	POWER
PUMP 1	3102.170 0650061	092	61-267-00-6260	162	230	486 54 08	142	4kW (5.4hp)
PUMP 2	3102.170 0650062	092	61-267-00-6260	162	230	486 64 08	142	4kW (5.4hp)

LEGEND	
CABLE TV	∩ CAP
GAS	▣ CATCH BASIN
SAN. SEWER	∇ ELECTRICAL BOX
STORM SEWER	⊕ HYDRANT
U.G. ELECTRICAL	⊞ VALVE
U.G. TELEPHONE	⊞ LAMP STANDARD
WATER	○ SAN. SANITARY MH (EXISTING OR FUTURE)
	● SAN. SANITARY MH (PROPOSED)
	○ STM. STORM MH (EXISTING OR FUTURE)
	● STM. STORM MH (PROPOSED)
	⊞ TRANSFORMER
	⊞ UTILITY JUNCTION BOX

No.	DATE	BY	ISSUED	CHK'd	No.	DATE	BY	REVISION	CHK'd
1	01/25/07	HK	FOR RECORD	MHC	1	01/25/07	HK	STATION DETAILS	MHC

PROFESSIONAL ENGINEER
M. H. CAMERON
REG. NO. 10107
R.D. CO. REGIONAL DISTRICT OF CENTRAL OKANAGAN

DRAWN: [Signature]
DESIGN: [Signature]
APPROVED: [Signature]
DATE: SEPT, 2006
SCALE: AS NOTED

205-1728 DOLPHIN AVE
KELOWNA BC V1Y 9R9

CTO Consultants Ltd.
PRO TEL 250 979-1221
FAX 250 979-1232

AREA 701- LAKEVIEW PHASE 5
SANITARY SEWER
KING RD S.L.S. PLANS AND SECTIONS

DRAWING NO. D4
REV. NO. 1

RECORD DRAWING



TEST REPORT

PRODUCT

KING ROAD LS 12

Serial No. 3102.170	0650061	Performance curve No. 61- 267-00-6260	Motor module/type 162	Voltage (V) 230
Base module 092	Impeller No. 486 54 08	Gear type	Gear ratio	Imp.diam/Blade angle 142
				Water temp °C 23

TEST RESULTS

Pump total head H (m)	Volume rate of flow Q (l/s)	Motor input power P (kW)	Voltage U (V)	Current I (A)	Overall efficiency η (%)
36.19	0.38	2.99	230	13.6	4.54
35.82	0.66	3.07	234	13.9	7.55
34.98	1.36	3.14	232	14.2	14.87
33.25	2.35	3.49	233	13.6	21.97
30.13	3.69	4.04	229	18.4	27.02
28.12	4.24	4.25	229	19.3	27.56
21.80	5.34	4.77	233	21.5	23.95
17.91	5.51	4.81	234	21.7	20.12


Accepted after HI/B	Test facility Lindas LCU Sweden	Test date 06-07-10	Time 08:20	Chief tester 5191
------------------------	---------------------------------------	-----------------------	---------------	----------------------

ORDERNR 171572 POS 2

PLOTTED TEST RESULTS Measured point : + = Q/H Duty point : \diamond = Q/H Calculated point : \wedge = Q/ETA overall
 X = Q/P \square = Q/P 1
 \triangle = Q/ETA overall

TOTAL HEAD

INPUT POWER

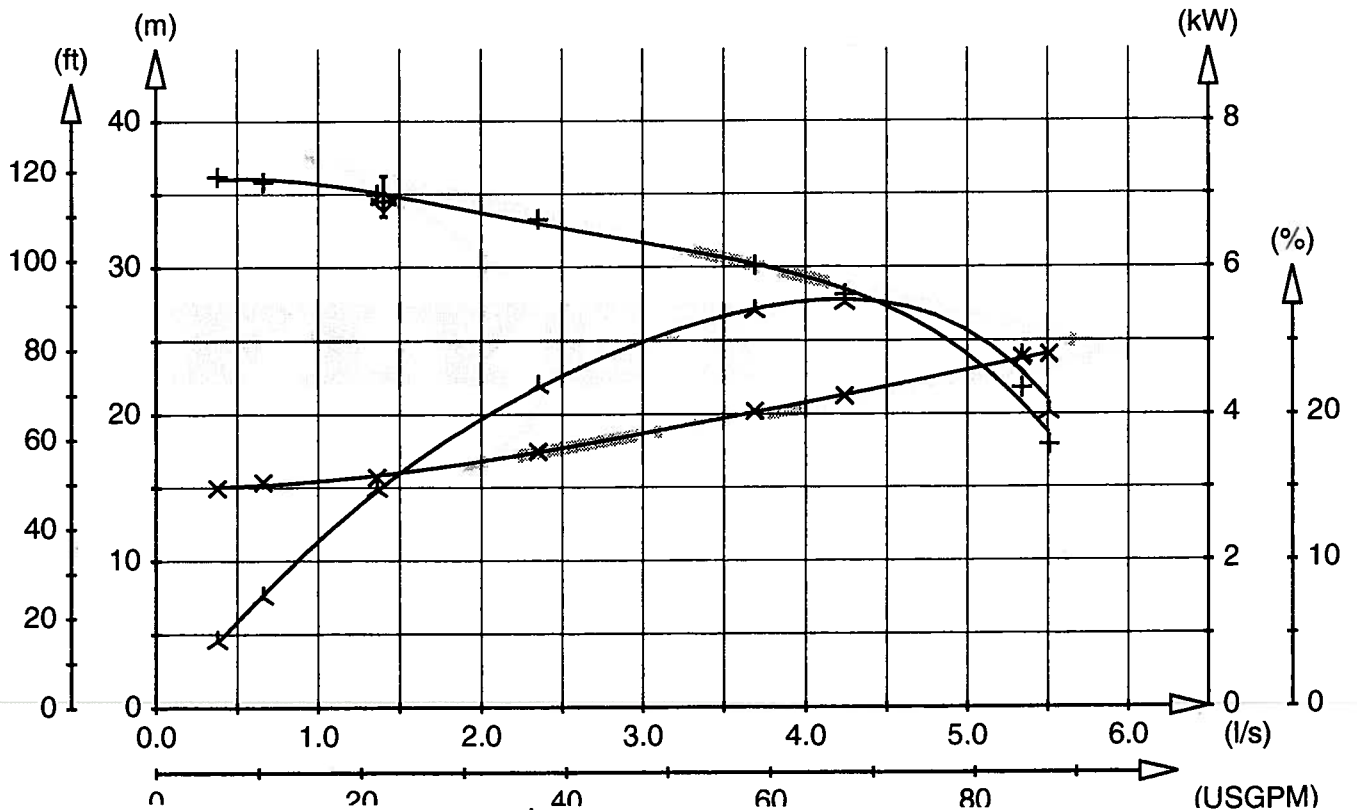



District of West Kelowna

Sanitary Lift Station Evaluation

Station: Thacker Road LS 13
Inspection By: Jim Kentel

Year Constructed: 9/1/2006
Year Upgraded:

Matrix Rating			
(10 - highest rating)	Civil	40	
(1 - lowest rating)	Process Mechanical	100	
	Electrical Instrumentation	22	
	Total Station Rating	162	(max. rating 370 points)



Civil:Matrix
Rating

Parking Area:	_____	n/a
Drainage:	Good	10
Influent sewer:	Gravity 200	10
Site access:	Good	10
Water service:	38mm Water Service	10
		40


Process Mechanical:Matrix
Rating

Station type:	Concrete 1.8m MH	n/a
Number of pumps:	2	n/a
Pump Redundancy:	Yes	n/a
Pump Manufacturer / Type:	FLYGT Submersible Grinder	8
Pump Model:	CP 3085.192	n/a
Rated Capacity:	3L/S @ 21.2 TDH	n/a
Capacity Confirmation:	_____	n/a
Discharge pipe type / diameter:	PVC/50	10
Header pipe type / diameter:	Rubber horse / 50	1
Check valve type / diameter:	/50	10
Isolation valve type / diameter:	SS Ball / 50	10
Piping Condition:	_____	9
Emergency pumpout connection:	Flush out hose connection	10
Pressure gauges:	No	1
Inlet bar screen:	No	1
Wetwell condition:	_____	7
Access Hatches:	MH Frame and Cover	5
Ladder / Platform:	Rungs / no platform	3
Wetwell benching:	Sulphate resistant concrete	5
Odour Control:	No	1
Ventilation:	Yes	8
Water washdown:	38mm Water Service	10
Confined Space Entry Requirements	No	1
		100


Electrical / Instrumentation:

Matrix
Rating

Service Type	V / A / Phase / Wire	1
Pump 1 :	HP 3.0 hp/2.3 Kw	1
	Volts 230 Rpm 3520	n/a
	FLA	n/a
Starting Current	A	n/a
Pump 2 :	HP 3.0hp	1
	Volts 230 Rpm 3520	n/a
	FLA	n/a
Starting Current		n/a
Alarm Functions:	Ultrasonic	1
	level control	n/a
		n/a
		n/a
Receptacles:		1
Interior Lighting:		1
Exterior Lighting:		1
SCADA / Telemetry:		1
Main Breaker:		1
Metering:		1
MCC:		1
Control Panel:		1
Lighting Panel:		1
Flowmeter:		1
Ampmeters:		1
TVSS:		1
Grounding:		1
Lighting Protection:		1
UPS:		1
PLC:		1
Level Control:	Ultrasonic FLYGT Bulb level	1
Standby Generator:		1
		22
Comments:		

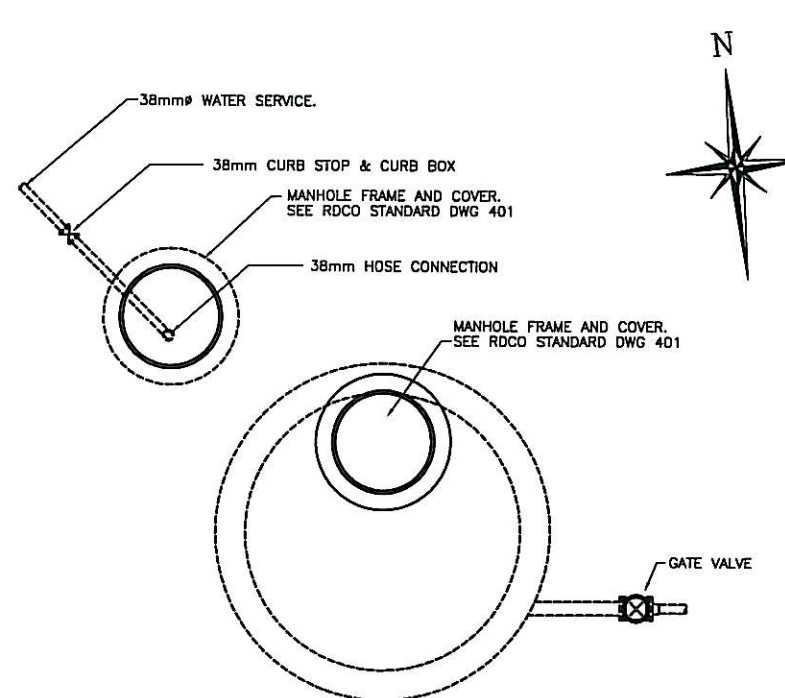


S.L.S. - TOP PLAN
SCALE: 1:25

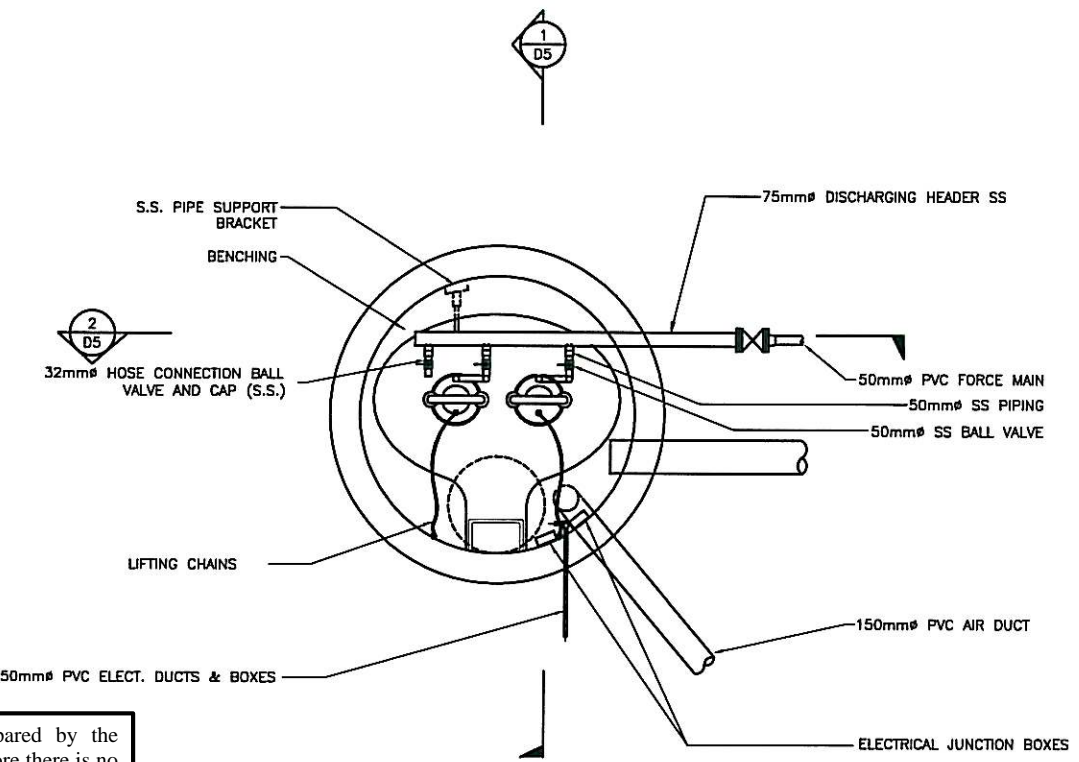


S.L.S. - WETWELL PLAN
SCALE: 1:25

"This as-constructed information was not prepared by the Regional District of Central Okanagan and therefore there is no guarantee of its accuracy. It is the recipient's and user's responsibility to confirm the accuracy of this as-constructed information before proceeding with any work that may be affected by this as-constructed information."

NOTES:
ALL LOCATIONS OF EXISTING UTILITIES SHOWN ARE APPROXIMATE ONLY. ALL OR ANY EXISTING STRUCTURES NOT NECESSARILY SHOWN.
ELEVATIONS ARE TO GEODETIC DATUM.
CONDUIT FOR POWER & TELEMETRY AS DIRECTED BY RDCO PUBLIC WORKS, B.C. HYDRO AND APPROVED BY THE CONTRACT ADMINISTRATOR.
RECEIVED AND INSTALLED 2 PRE-PURCHASED FLYGT PUMPS c/w HOSES, CHAINS AND POWER CABLES.
COORDINATED SUPPLY AND INSTALLATION OF ALL ELECTRICAL/CONTROLS EQUIPMENT WITH RDCO PUBLIC WORKS.
ALL STAINLESS STEEL (S.S.) CALLED TO BE 316L GRADE.
REFER TO APPENDIX E FOR FURTHER ELECTRICAL DETAILS.

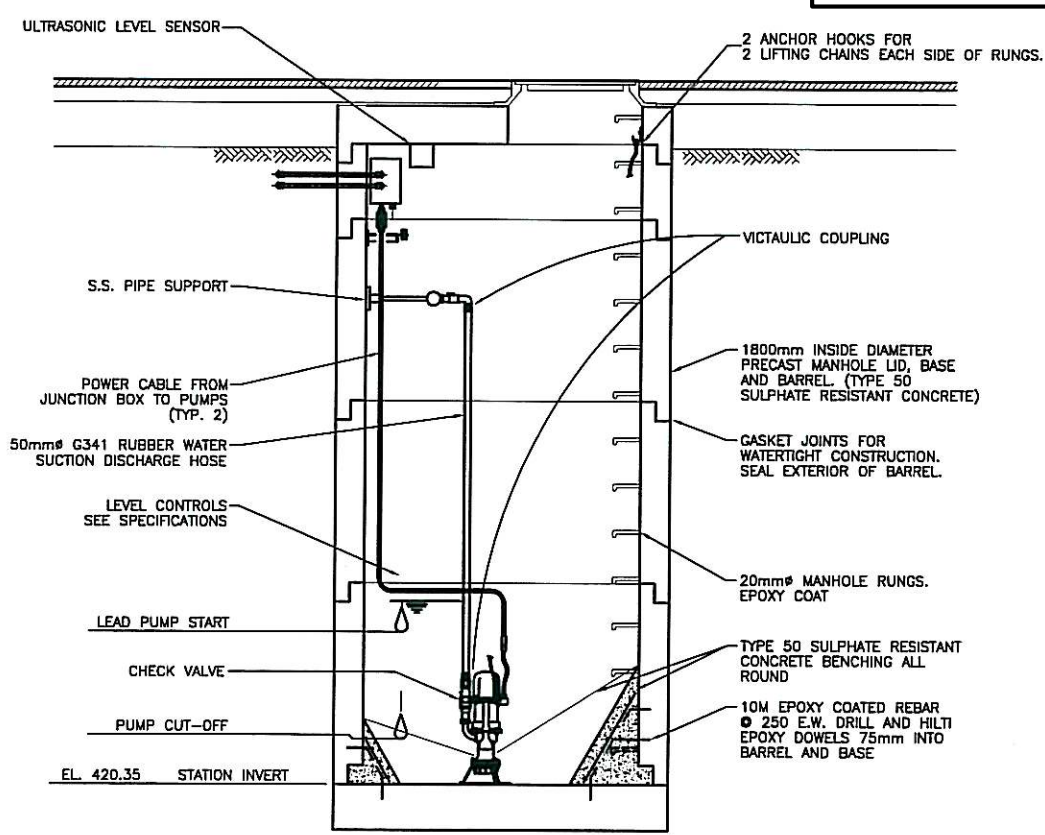

SECTION 1
SCALE: NTS D5

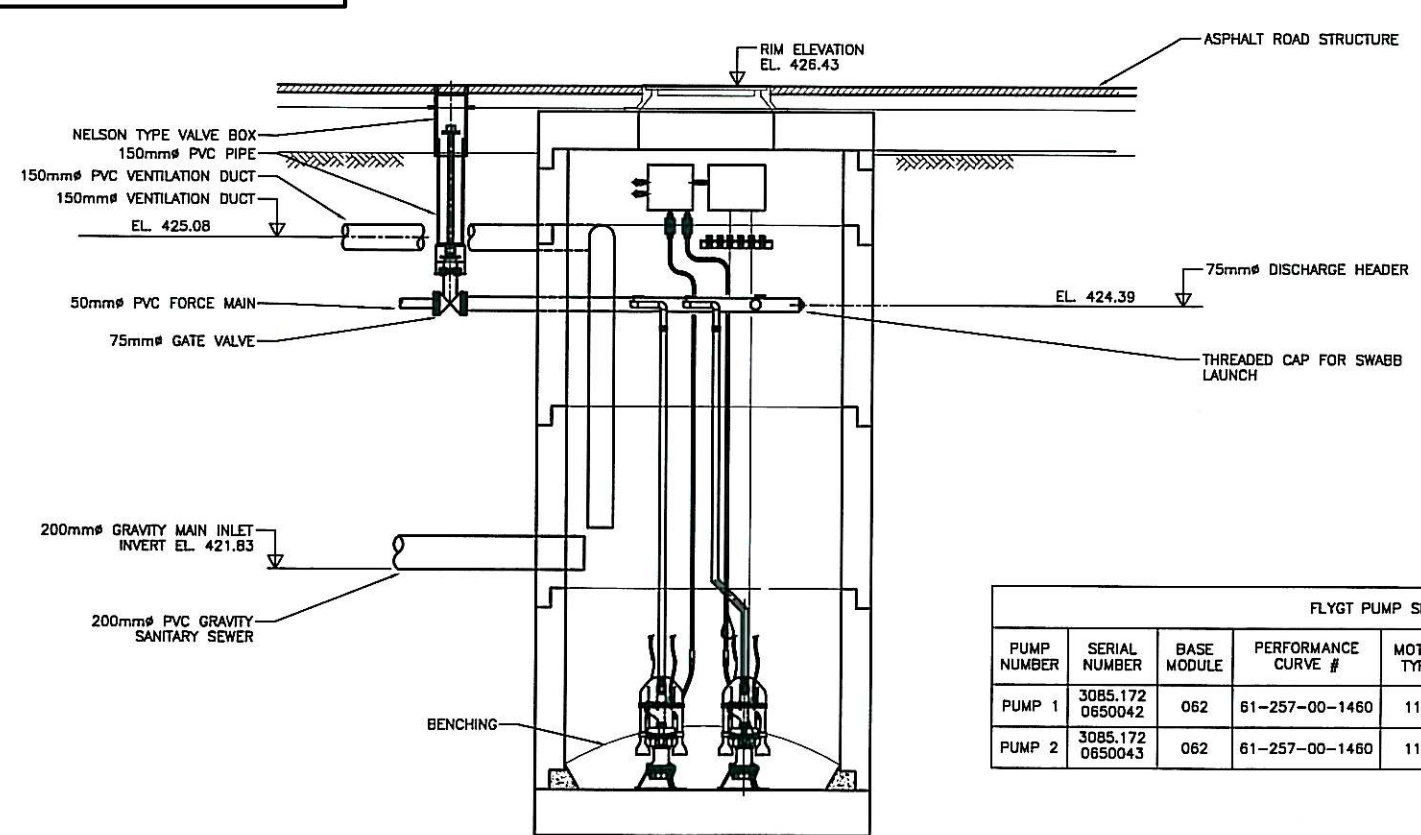

SECTION 2
SCALE: NTS D3

FLYGT PUMP SPECS								
PUMP NUMBER	SERIAL NUMBER	BASE MODULE	PERFORMANCE CURVE #	MOTOR TYPE	VOLTAGE (V)	IMPELLER NUMBER	IMP. DIA	POWER
PUMP 1	3085.172 0650042	062	61-257-00-1460	114	230	444 84 13	143	2.3kW (3.0hp)
PUMP 2	3085.172 0650043	062	61-257-00-1460	114	230	444 84 13	143	2.3kW (3.0hp)

LEGEND	
CABLE TV	1 CAP
GAS	2 CATCH BASIN
SAN. SEWER	3 ELECTRICAL BOX
STORM SEWER	4 HYDRANT
U.G. ELECTRICAL	5 VALVE
U.G. TELEPHONE	6 LAMP STANDARD
WATER	7
○ SAN	SANITARY MH (EXISTING OR FUTURE)
○ SAN	SANITARY MH (PROPOSED)
○ STM	STORM MH (EXISTING OR FUTURE)
○ STM	STORM MH (PROPOSED)
□	TRANSFORMER
□	UTILITY JUNCTION BOX

No.	DATE	BY	ISSUED	CHK'D	No.	DATE	BY	REVISION	CHK'D
1	01/25/07	HK	FOR RECORD	MHC	1	01/25/07	HK	STATION DETAILS	MHC

PROFESSIONAL ENGINEER
M. H. CAMERON
REG. NO. 12345
RDCO
REGIONAL DISTRICT OF CENTRAL OKANAGAN

DESIGN
APPROVED
DATE: SEPT, 2006
SCALE: AS NOTED

205-1728 DOLPHIN AVE
KELOWNA BC V1Y 8R9






CTO
Consultants Ltd

PRO
TEL 250 878-1221
FAX 250 878-1232

AREA 701- LAKEVIEW PHASE 5
SANITARY SEWER
THACKER S.L.S. PLANS AND SECTIONS


DRAWING NO. D5
REV. NO. 1

RECORD DRAWING

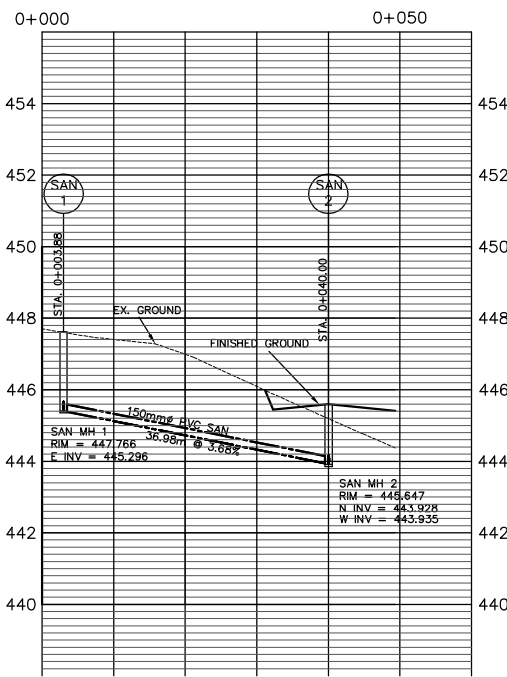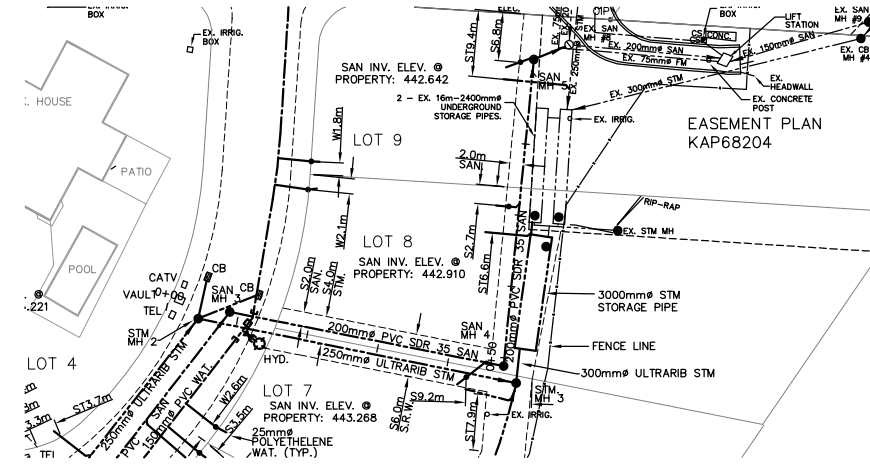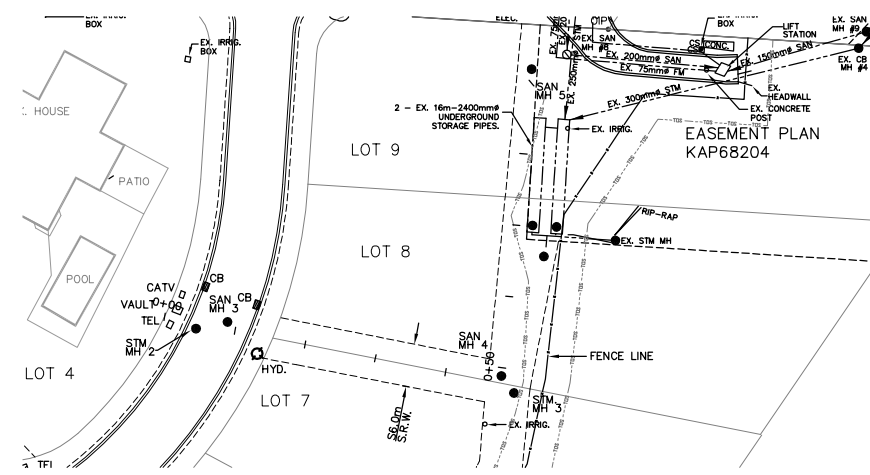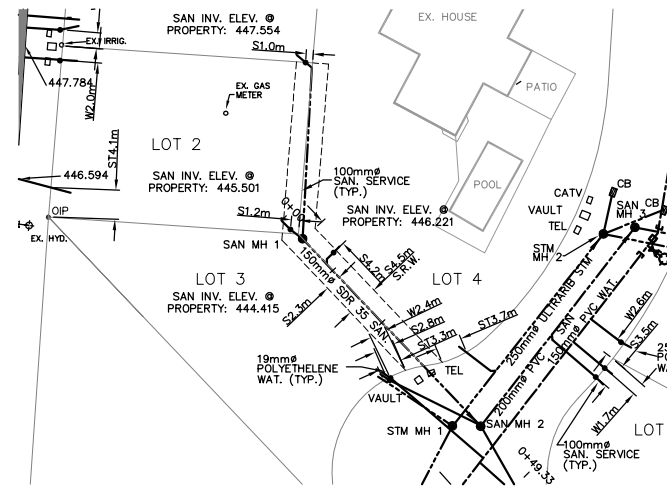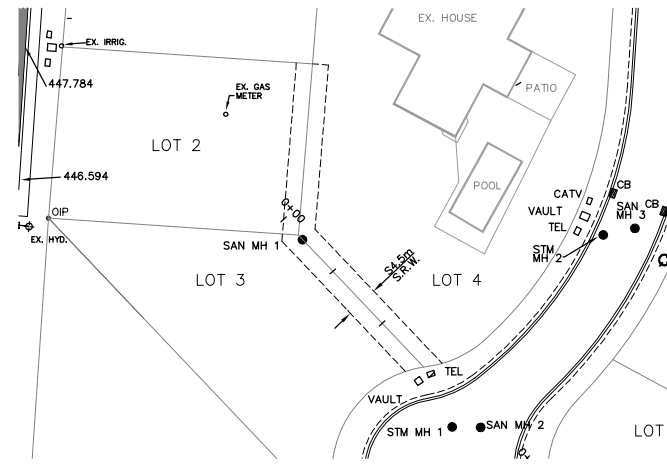

"This as-constructed information was not prepared by the Regional District of Central Okanagan and therefore there is no guarantee of its accuracy. It is the recipient's and user's responsibility to confirm the accuracy of this as-constructed information before proceeding with any work that may be affected by this as-constructed information."

"AS CONSTRUCTED"
O.B.P., JULY 28, 2003

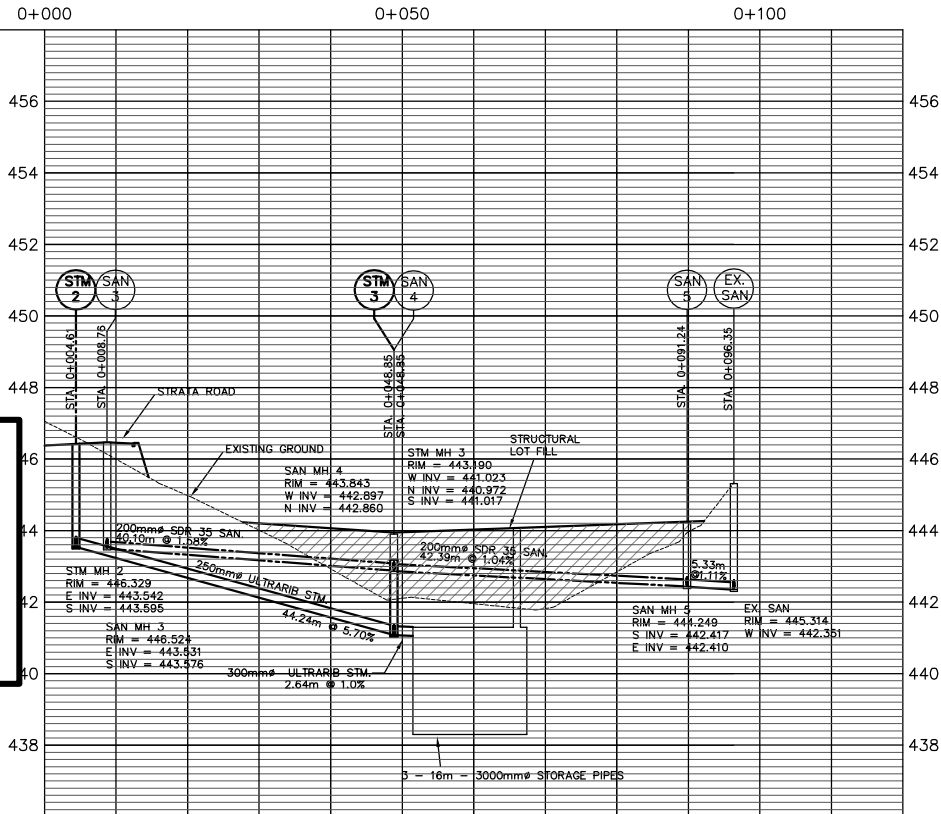

LEGEND

—○—	CAP	○ SAN #	SANITARY MH (EXISTING OR FUTURE)
—●—	CATCH BASIN	● SAN #	SANITARY MH (PROPOSED)
—□—	ELECTRICAL BOX	○ STM #	STORM MH (EXISTING OR FUTURE)
—◇—	HYDRANT	● STM #	STORM MH (PROPOSED)
—X—	VALVE	—□—	TRANSFORMER
—○—	U.S. TELEPHONE	—◇—	UTILITY JUNCTION BOX
—□—	LAMP STANDARD		

No.	MM/DD/YY	BY	REVISION	Chk'd
3	09/04/03	RW	REVISED AS PER R.D.C.O.	MDN
2	07/28/03	OP	AS CONSTRUCTED	DEP
1	03/28/03	RW	GENERAL REVISIONS	DEP



MURRAY D. NOBLE, P.ENG.
DRAWN R.J.W.
DESIGN P.A.C.E.
APPROVED D.E.P.
DATE FEB 2003
SCALE
H = 1:500
V = 1:100

9 LOT STRATA SUBDIVISION
THACKER DRIVE
645135 B.C. LTD.
EASEMENT PLAN/PROFILE

PACE
D.E. PILLING & ASSOC. LTD.
CONSULTING ENGINEERING
#200, 840 GROVES AVE., KELOWNA, B.C. V1Y 4V7
TEL: 1-250-763-2315
FAX: 1-250-763-6559
EMAIL: engineering@pilling.ca

DRAWING NO.
1556-R2
REV. NO.
3

TEST REPORT

PRODUCT

THACKER DRIVE LS 13

Serial No. 3085.172		0650042		Performance curve No. 61-257-00-1460		Motor module/type 114		Voltage (V) 230	
Base module 062	Impeller No. 444 84 13			Gear type	Gear ratio		Imp.diam/Blade angle 143		Water temp °C 20

TEST RESULTS

Pump total head H (m)	Volume rate of flow Q (l/s)	Motor input power P (kW)	Voltage U (V)	Current I (A)	Overall efficiency η (%)
34.53	0.03	2.85	219	21.3	0.35
33.47	0.41	2.88	219	21.4	4.73
31.44	1.18	3.10	221	22.2	11.78
31.43	1.19	3.10	221	22.3	11.81
31.07	1.30	3.15	222	22.4	12.56
28.07	2.13	3.38	221	22.7	17.30
21.25	3.10	3.72	222	23.3	17.35
21.24	3.11	3.71	222	23.2	17.46

Accepted after	Test facility	Test date	Time	Chief tester	0300
HI/B	Lindas LC4 Sweden	06-07-05	07:42		


ORDERNR 171572 POS 1

PLOTTED TEST RESULTS

Measured point : \pm = Q/H Duty point : \diamond = Q/H
 \times = Q/P \square = Q/P
 \triangle = Q/ETA overall \blacktriangle = Q/ETA overall

TOTAL HEAD

INPUT POWER

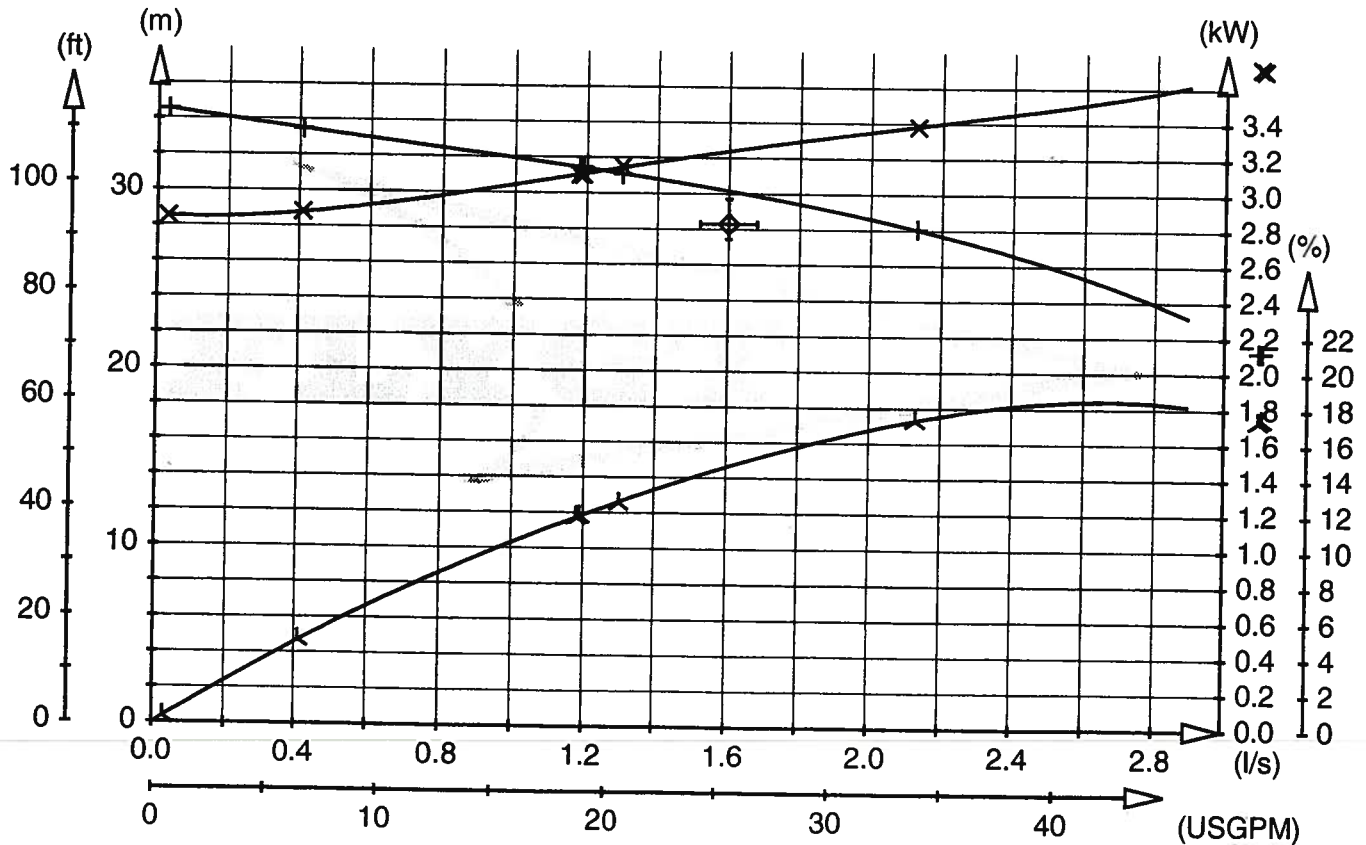

PRODUCT

Serial No. 3085.172		0650043		Performance curve No. 61-257-00-1460		Motor module/type 114		Voltage (V) 230	
Base module 062		Impeller No. 444 84 13		Gear type		Gear ratio		Imp.diam/Blade angle 143	
								Water temp °C 20	

TEST RESULTS

Pump total head H (m)	Volume rate of flow Q (l/s)	Motor input power P (kW)	Voltage U (V)	Current I (A)	Overall efficiency η (%)
34.73	0.03	2.91	221	22.0	0.38
33.63	0.42	2.96	222	22.1	4.66
31.78	1.13	3.17	224	23.1	11.07
31.53	1.20	3.20	224	23.1	11.63
31.22	1.29	3.16	222	22.4	12.50
28.17	2.12	3.48	225	23.5	16.81
20.92	3.10	3.69	220	22.9	17.23
20.90	3.10	3.71	220	23.0	17.14


Accepted after HI/B	Test facility Lindas LC4 Sweden	Test date 06-07-05	Time 07:33	Chief tester 0300
-------------------------------	---	------------------------------	----------------------	-----------------------------

ORDERNR 171572 POS 1

PLOTTED TEST RESULTS Measured point: + = Q/H X = Q/P Duty point: ◇ = Q/H □ = Q/P Calculated point: λ = Q/ETA overall 6
 △ = Q/ETA overall

TOTAL HEAD

INPUT POWER

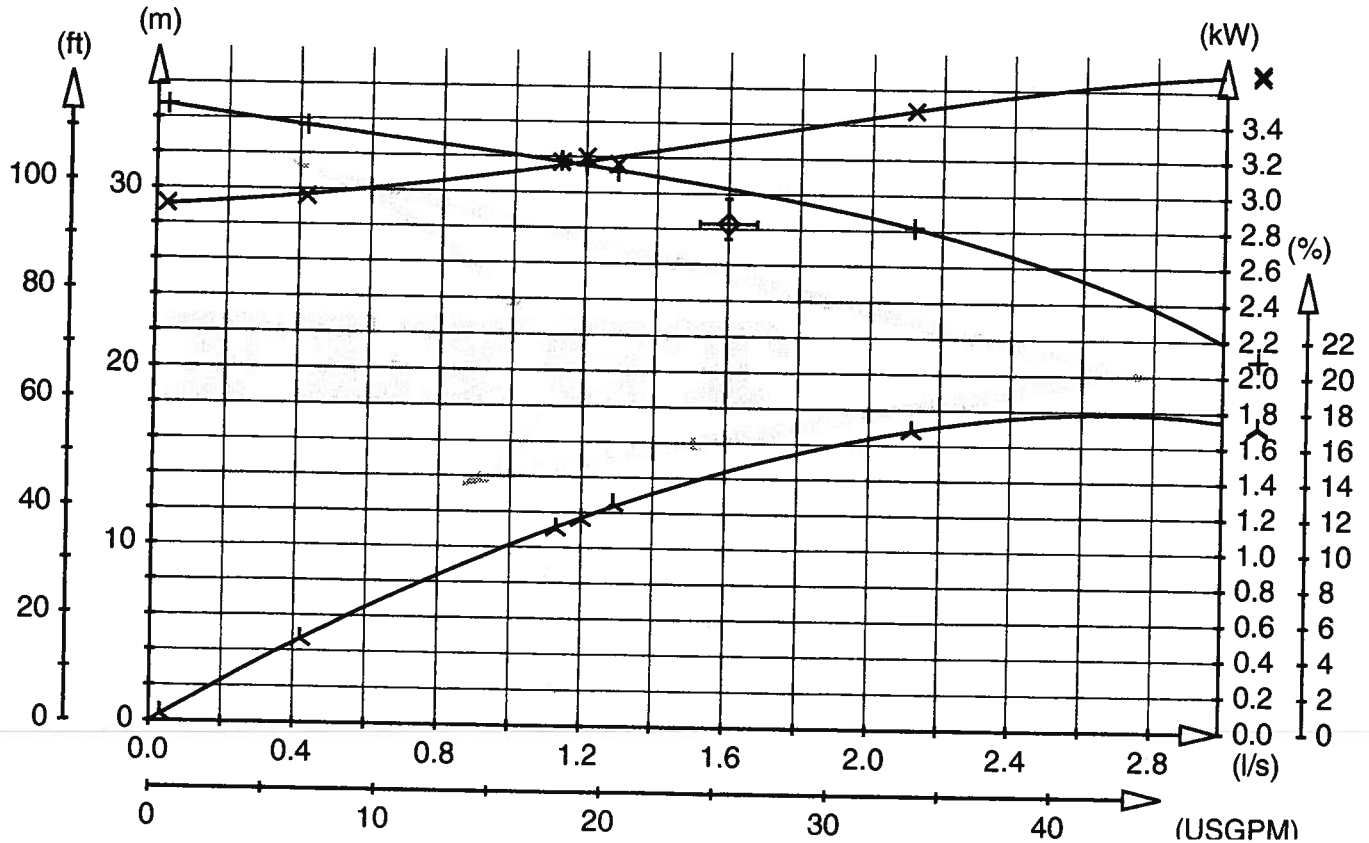



District of West Kelowna

Sanitary Lift Station Evaluation

Station: Collens Hill LS 14
Inspection By: Jim Kentel

Year Constructed: 9/1/2004
Year Upgraded:

Matrix Rating		
(10 - highest rating)	Civil	40
(1 - lowest rating)	Process Mechanical	153
	Electrical Instrumentation	132
	Total Station Rating	325 (max. rating 370 points)



Civil:Matrix
Rating

Parking Area:	_____	n/a
Drainage:	Good	10
Influent sewer:	Gravity 200	10
Site access:	Good	10
Water service:	Yes	10
		40


Process Mechanical:Matrix
Rating

Station type:	FRP 2.4m	n/a
Number of pumps:	2	n/a
Pump Redundancy:	Yes	n/a
Pump Manufacturer / Type:	FLYGT/Summersible	7
Pump Model:	NP3171.180HT	n/a
Rated Capacity:	_____	n/a
Capacity Confirmation:	_____	n/a
Discharge pipe type / diameter:	HPPE DR 17/100	10
Header pipe type / diameter:	EPOXY Steel /100	8
Check valve type / diameter:	FLYGT #5087 HDL/100	10
Isolation valve type / diameter:	CI Plug/100	10
Piping Condition:	_____	9
Emergency pumpout connection:	100	10
Pressure gauges:	Yes	10
Inlet bar screen:	No	1
Wetwell condition:	_____	10
Access Hatches:	Alum	10
Ladder / Platform:	Yes	10
Wetwell benching:	Yes	10
Odour Control:	Carbon Filter to Vent	8
Ventilation:	Yes	10
Water washdown:	Yes	10
Confined Space Entry Requirements	Davit	10
		153

Electrical / Instrumentation:

Matrix
Rating

Service Type	V / A / Phase / Wire	n/a
Pump 1 :	HP 25	n/a
	Volts 600 Rpm 1760	n/a
	FLA 32	n/a
Starting Current	228	n/a
Pump 2 :	HP 25	n/a
	Volts 600 Rpm 1760	n/a
	FLA 32	n/a
Starting Current	228	n/a
Alarm Functions:	Yes	10
		n/a
		n/a
		n/a
Receptacles:	Yes	10
Interior Lighting:	Yes	10
Exterior Lighting:		1
SCADA / Telemetry:	Yes	10
Main Breaker:		10
Control Panel:		10
Lighting Panel:		10
Flowmeter:	Chamber, ABB P/50844/1/1	10
Grounding:		10
Surge Protection:	Yes	10
UPS:		10
PLC:		10
Level Control:	Ultrasonic/FLYGT Bulbs	10
Standby Generator:		1
		132
Comments:		

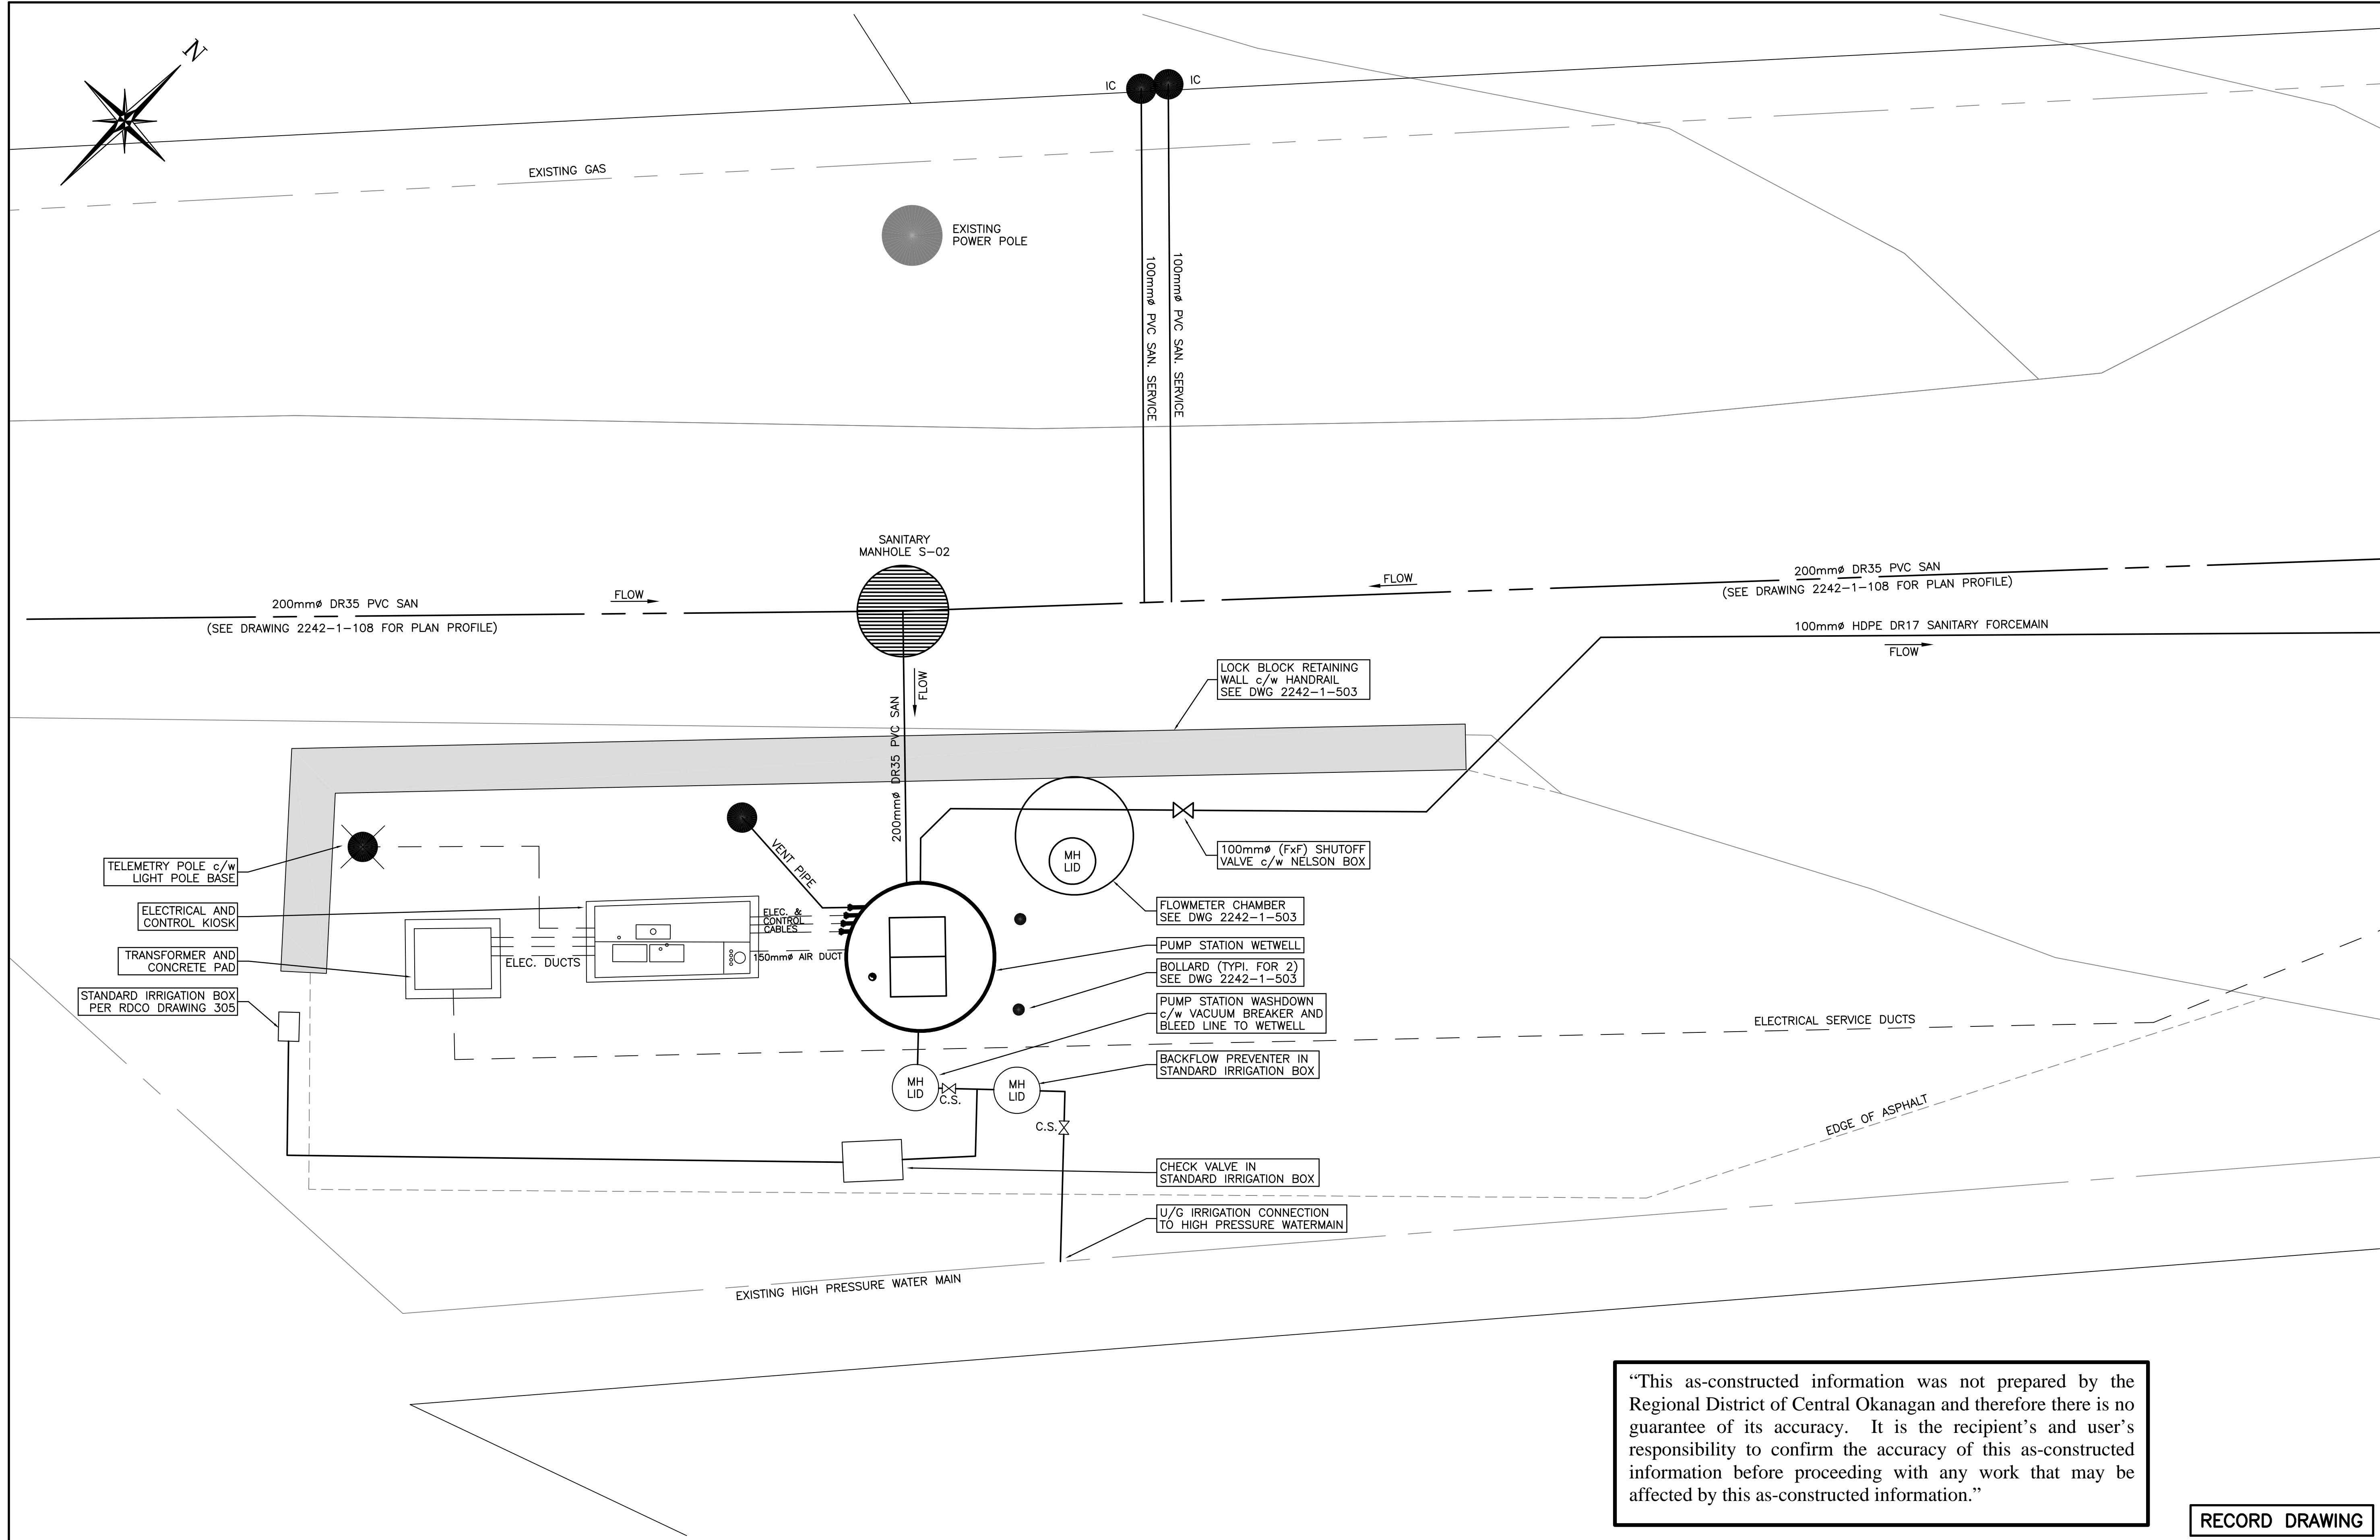

"This as-constructed information was not prepared by the Regional District of Central Okanagan and therefore there is no guarantee of its accuracy. It is the recipient's and user's responsibility to confirm the accuracy of this as-constructed information before proceeding with any work that may be affected by this as-constructed information."

RECORD DRAWING

LEGEND	
—	WATER
—	SAN. SEWER
—	STORM SEWER
—	GAS
—	U.G. TELEPHONE
—	U.G. ELECTRICAL
—	CABLE TV
J	CAP
■	CATCH BASIN
⊕	ELECTRICAL BOX
⊕	HYDRANT
⊕	VALVE
⊕	LAMP STANDARD
⊕	EXISTING SEPTIC TANK
SAN#	SAN MANHOLE (EXISTING OR FUTURE)
STM#	STORM MANHOLE (EXISTING OR FUTURE)
MH#	MANHOLE (PROPOSED)
⊕	DRAWING REFERENCE NUMBER
⊕	MANHOLE NUMBER
CO	CLEAN-OUT
IC	INSPECTION CHAMBER

No.	MM/DD/YY	DATE	BY	REVISION	Chk'd	No.	MM/DD/YY	DATE	BY	REVISION	Chk'd
5	09/13/04		BC	PUMP STATION REVISION							
4	08/04/04		JB	C.C.N. #2							
3	06/28/04		KR	C.C.N. #1							
2	04/29/04		PM	CONSTRUCTION ISSUE		7	01/19/07	JB		REVISIONS PER RDCCO COMMENTS	DRG
1	01/30/04			TENDER ISSUE		6	01/12/07	JB		RECORD DRAWING	DRG











P.ENG.	
DRAWN:	KR/BC
DESIGN:	BC
APPROVED:	RAW
DATE:	OCT 03
SCALE:	1:50

Associated Engineering

Suite 420
1628 Dickson Avenue
Kelowna, B.C., V1Y 9X1
Tel: (250) 763-3638
Fax: (250) 763-8880

**LAKEVIEW PHASE ONE
SANITARY SEWER
SANITARY LIFT STATION SITE PLAN**

DRAWING NO.	
2242-1-501	
REV. NO.	
7	

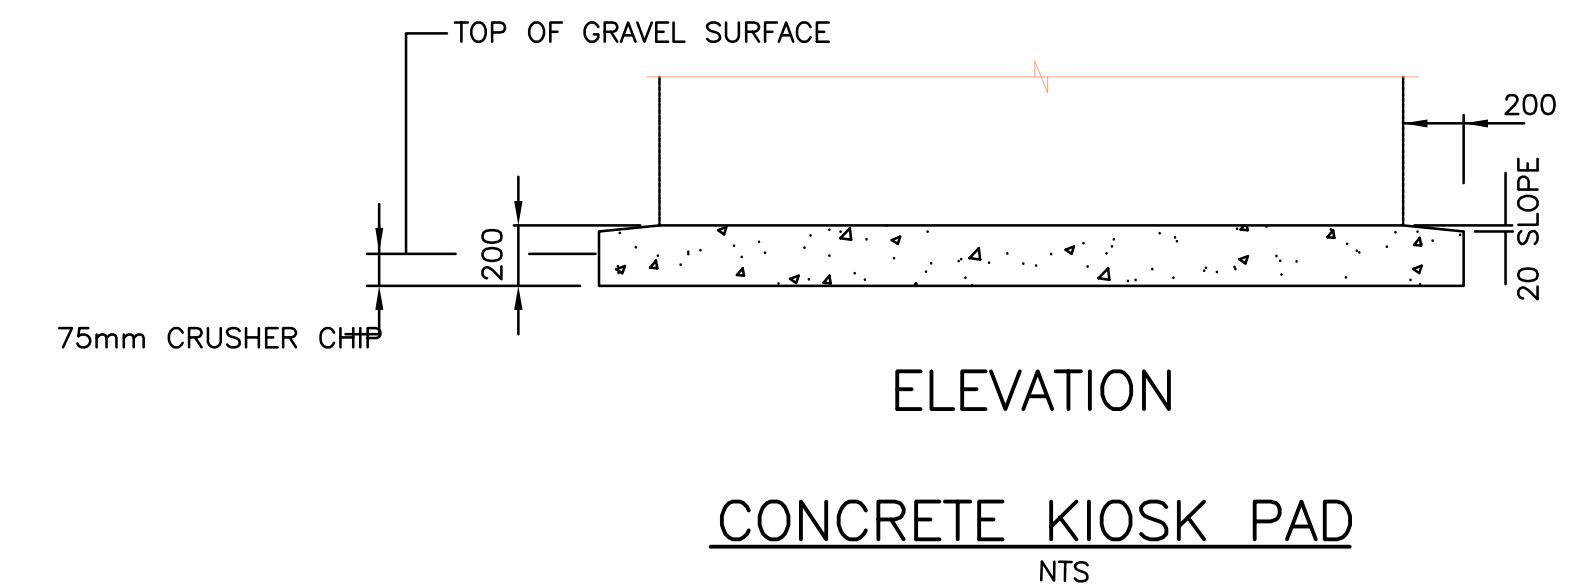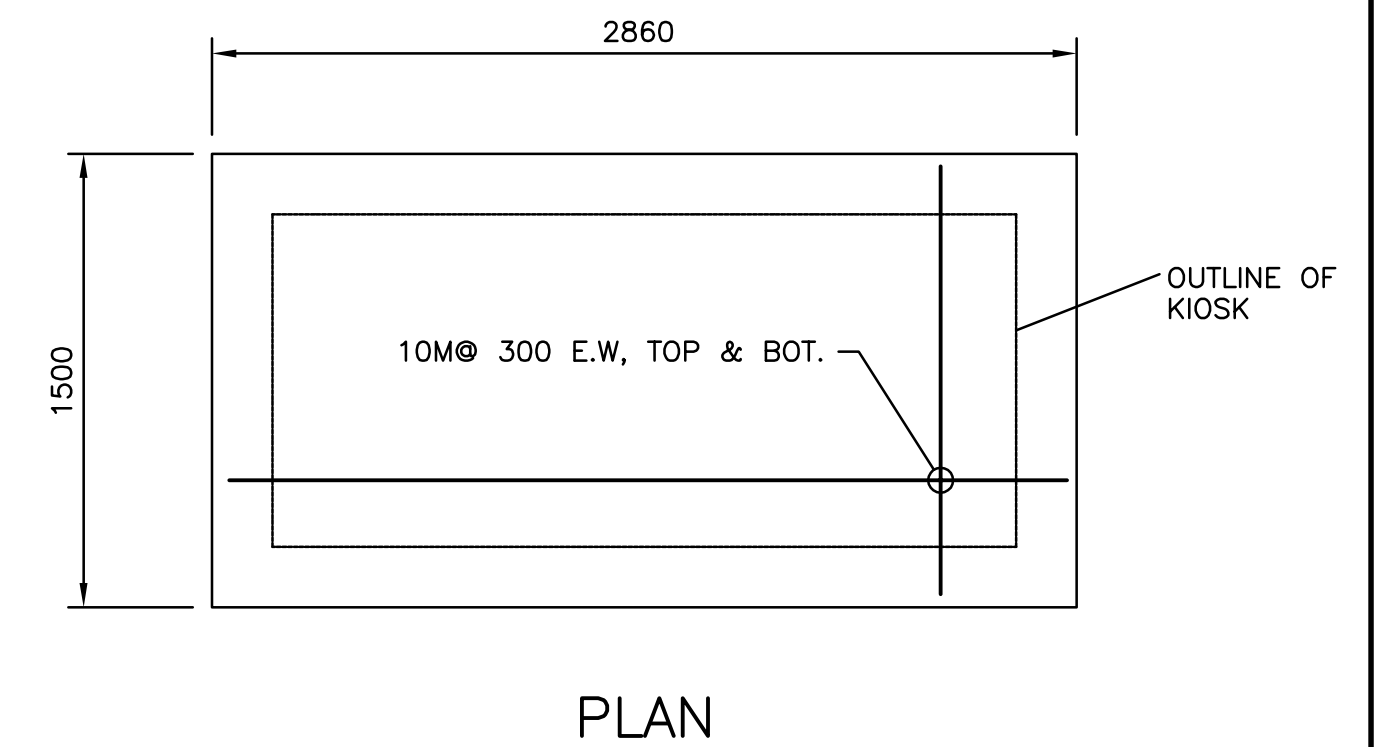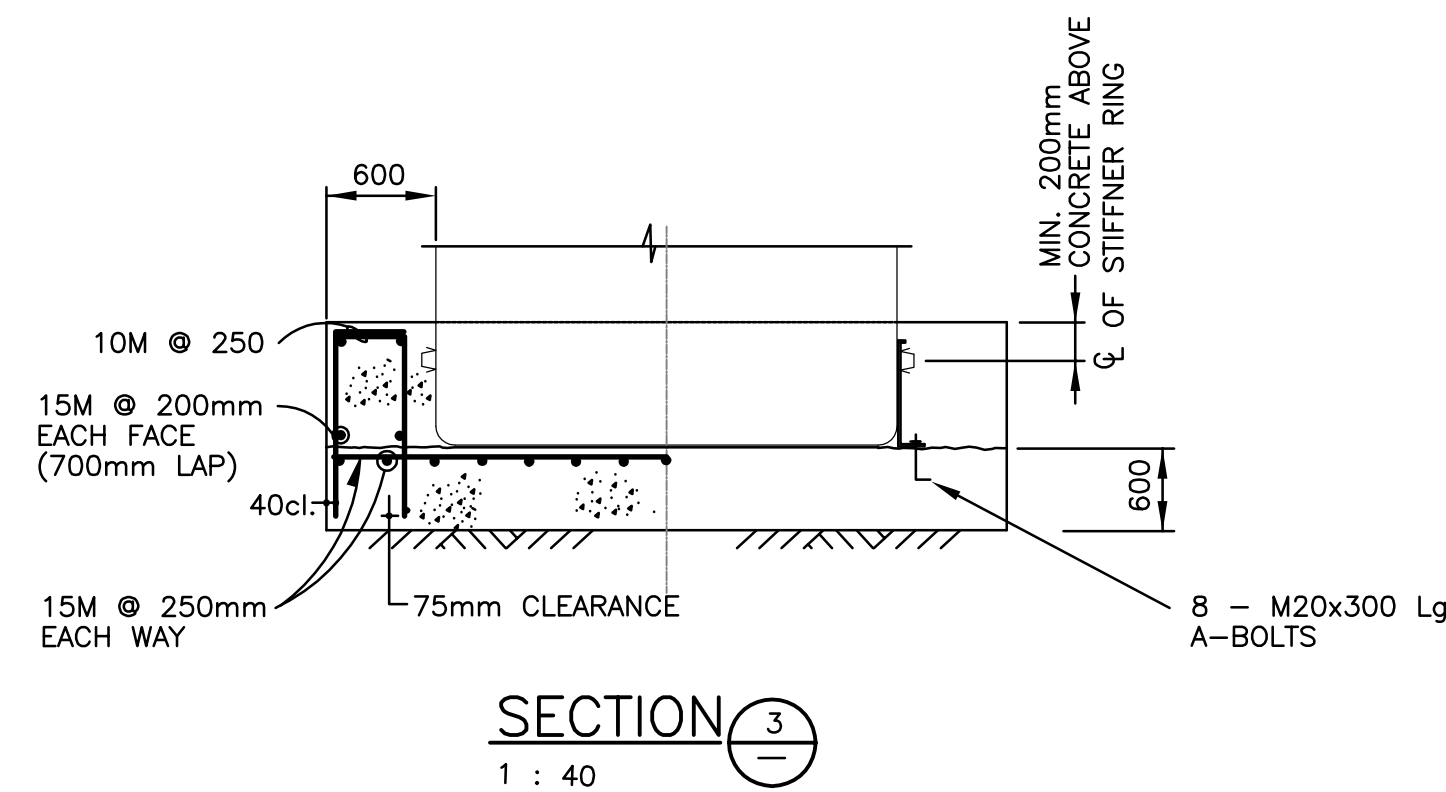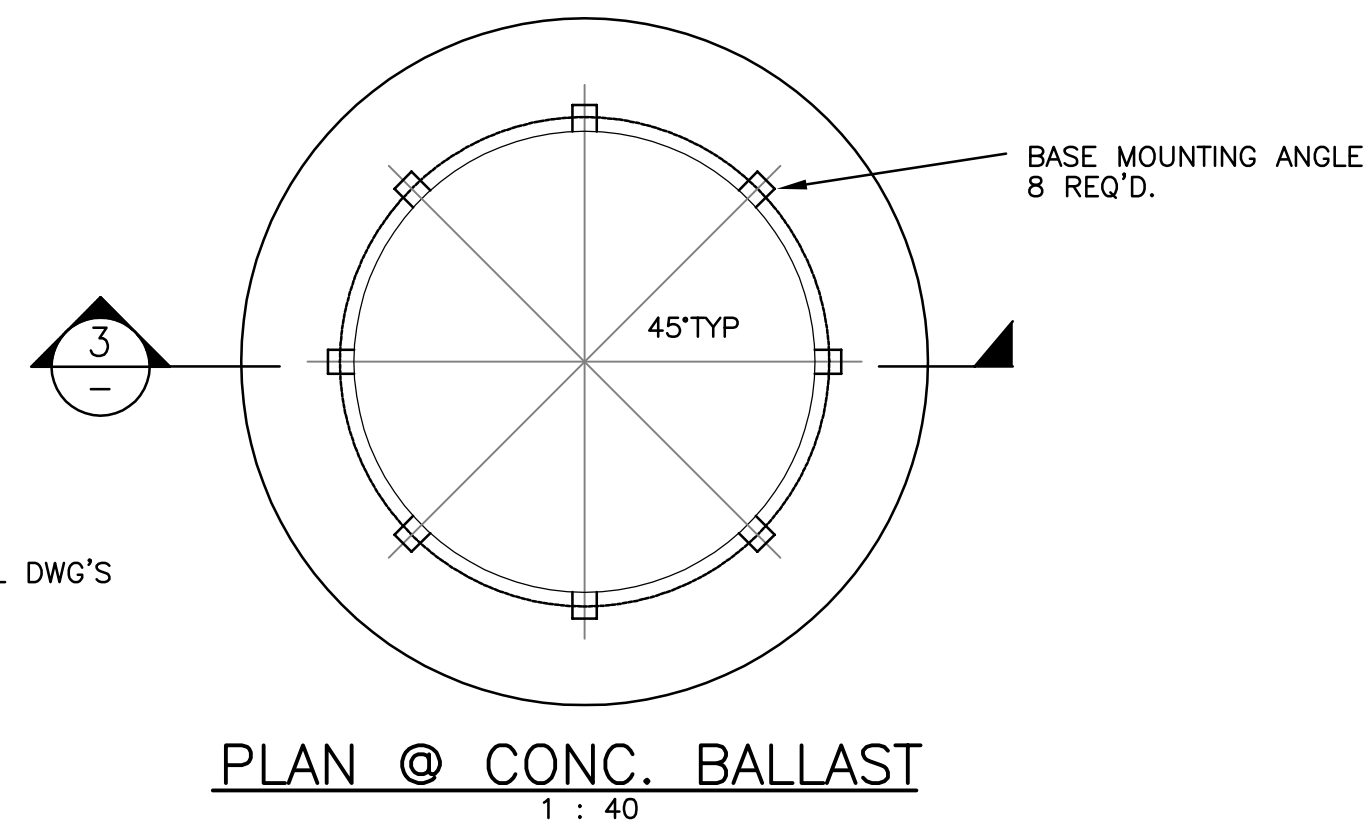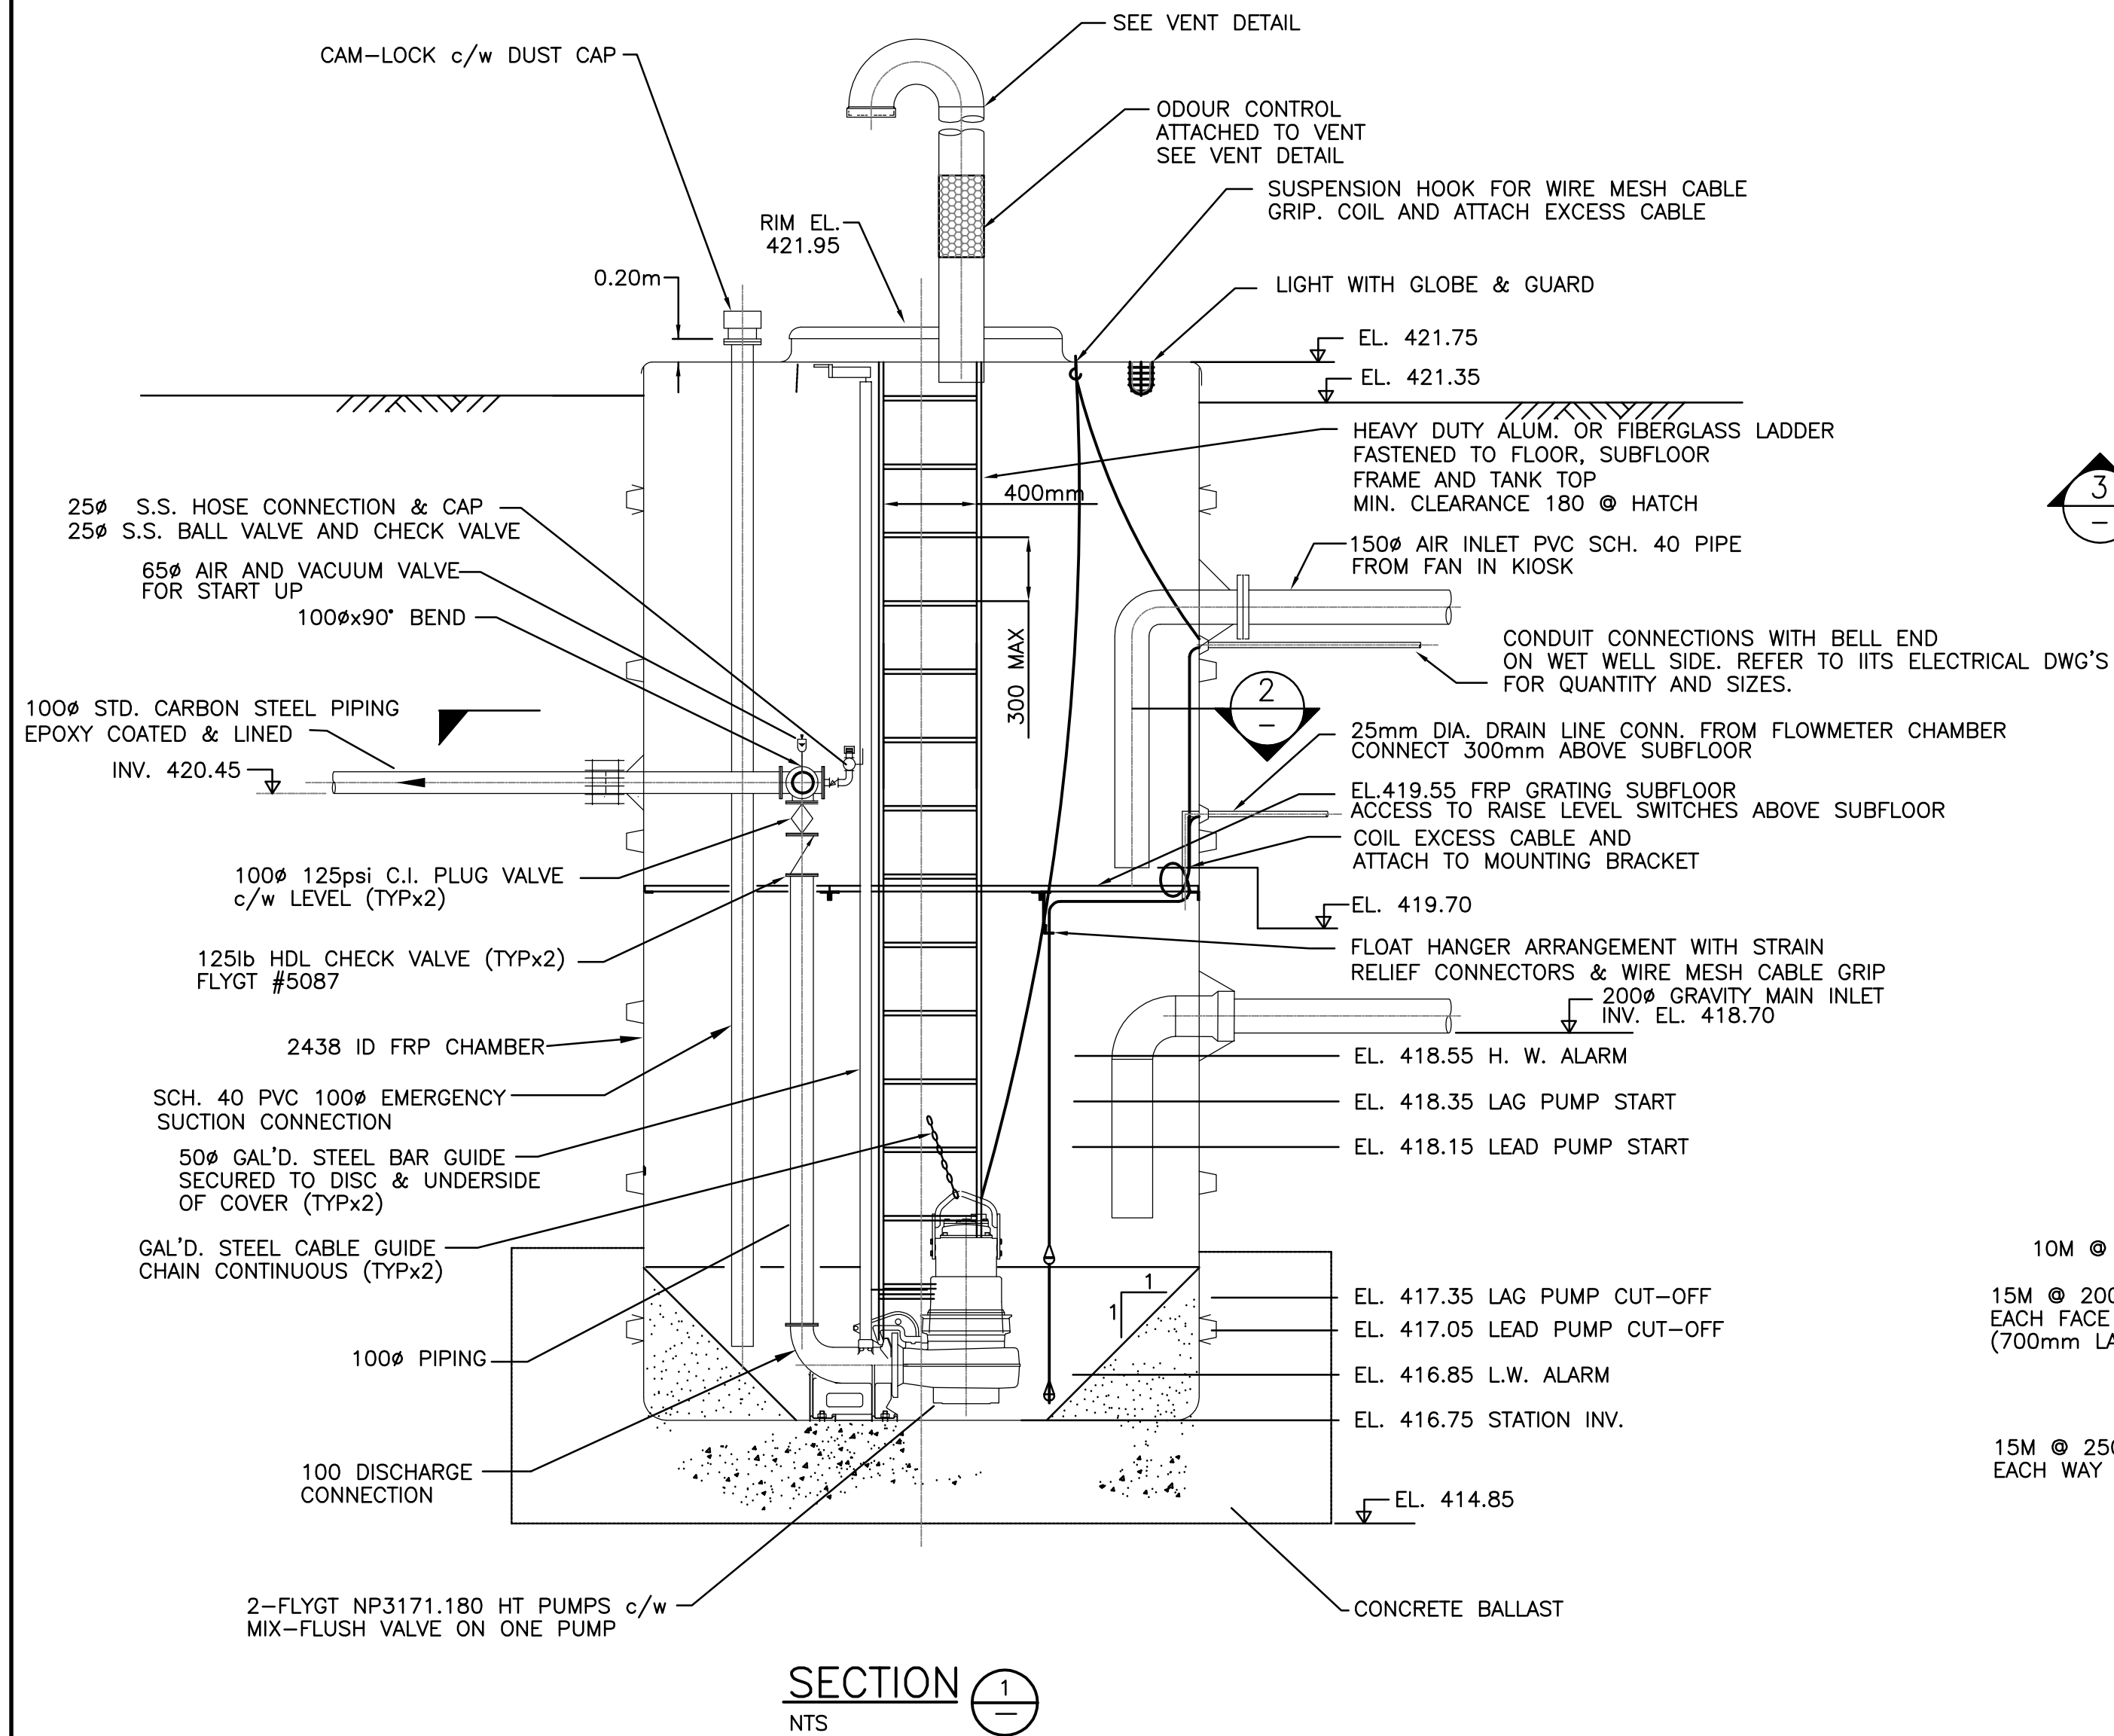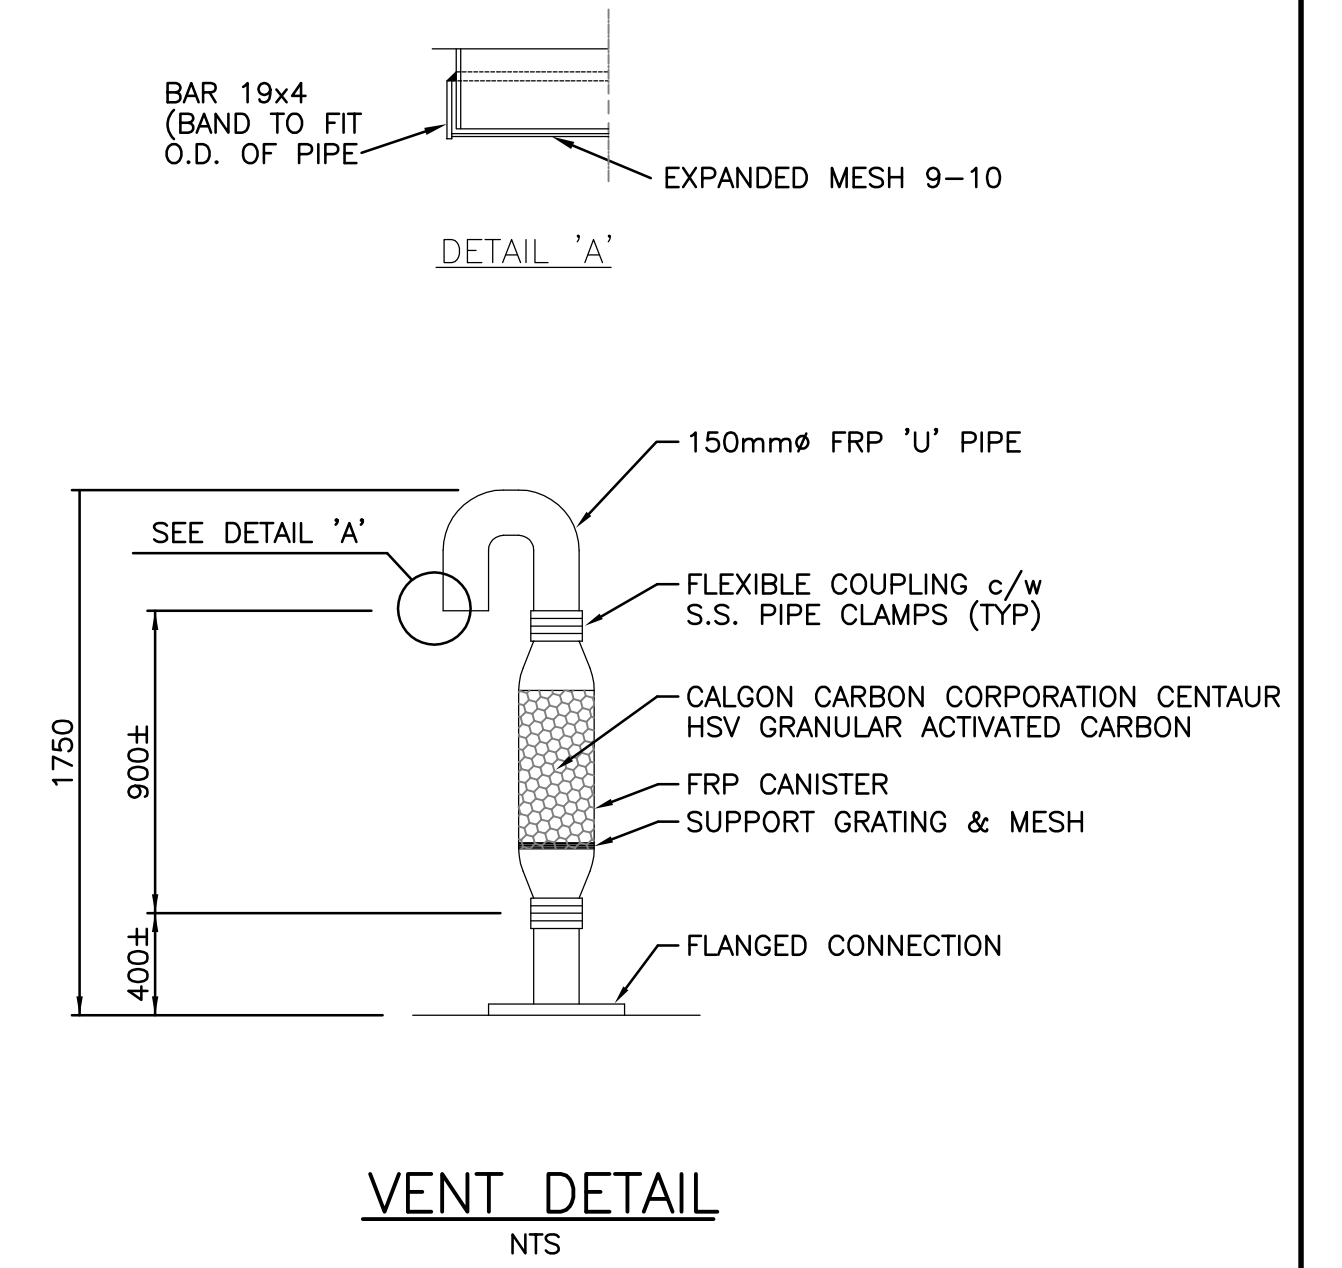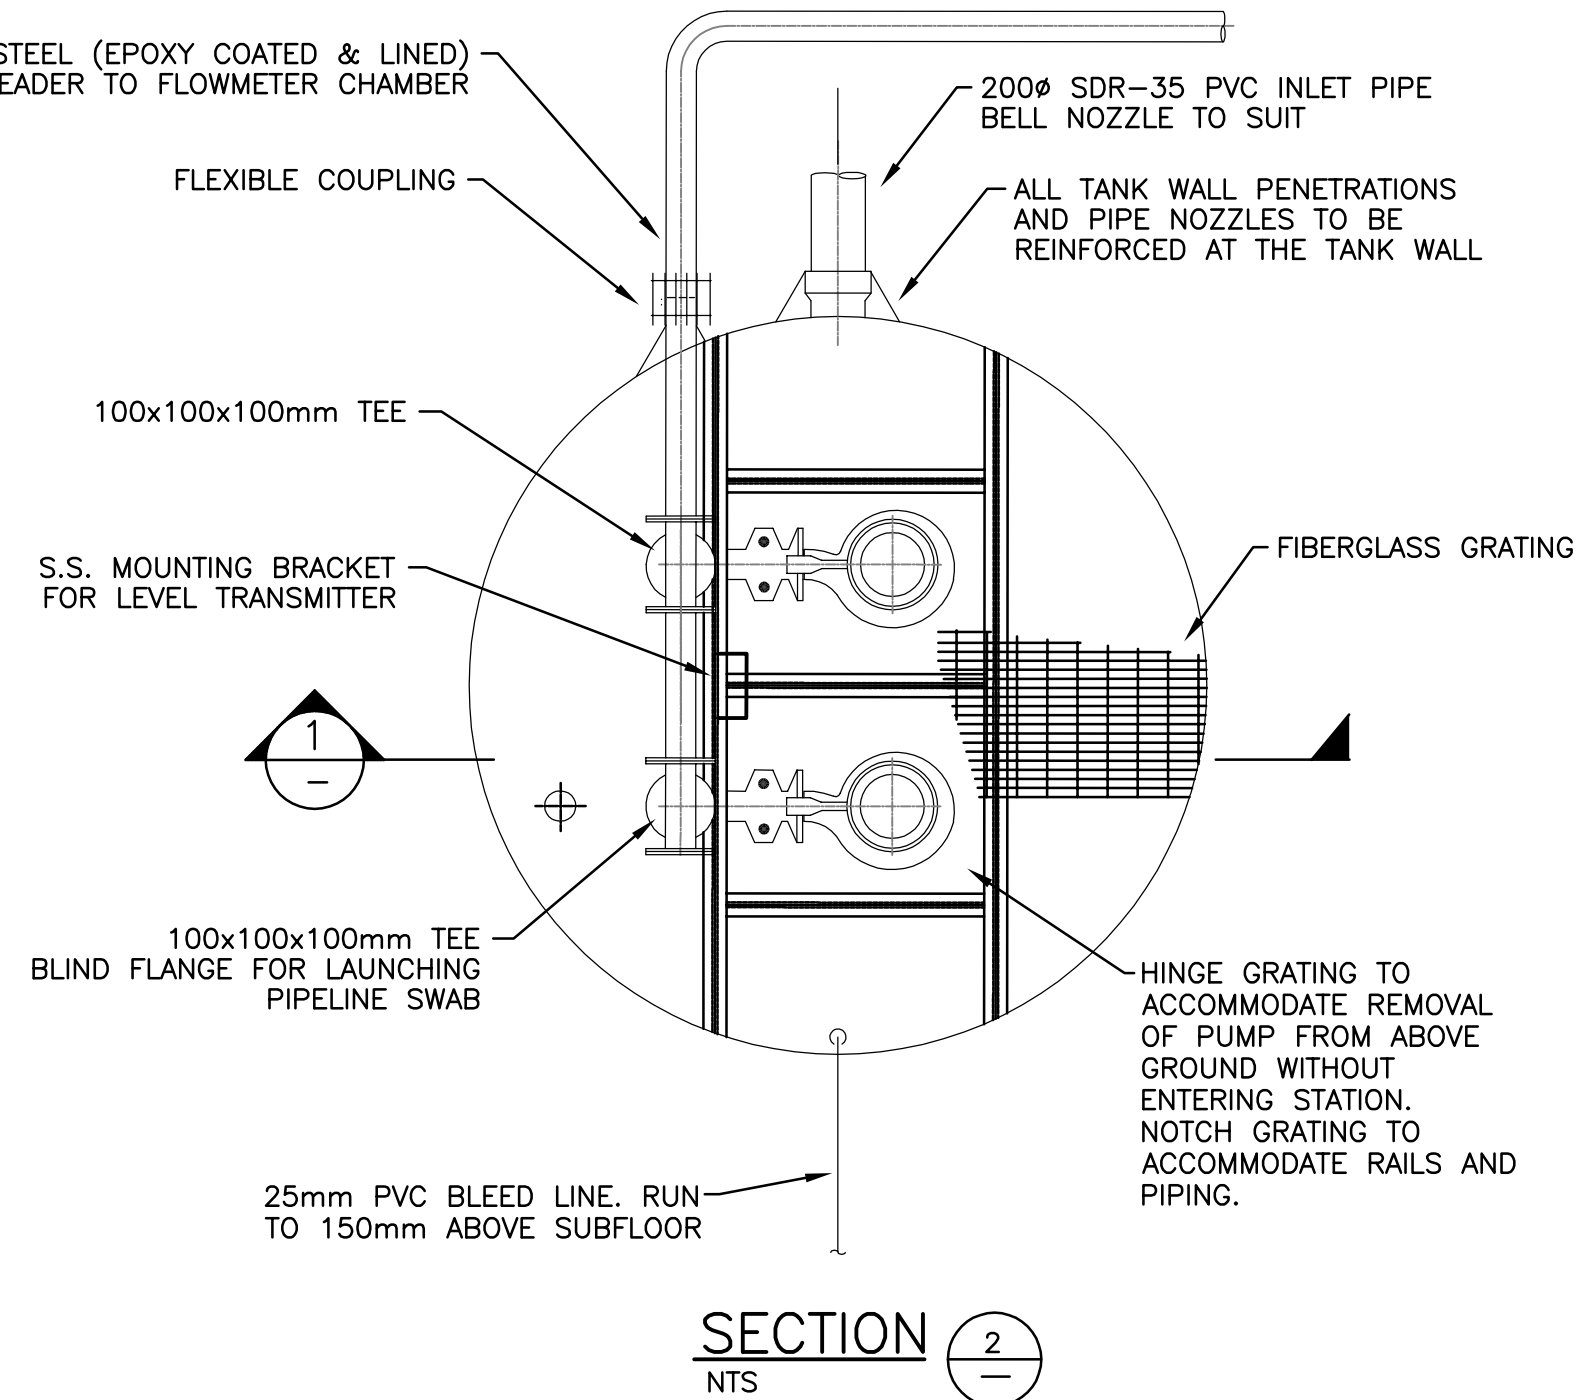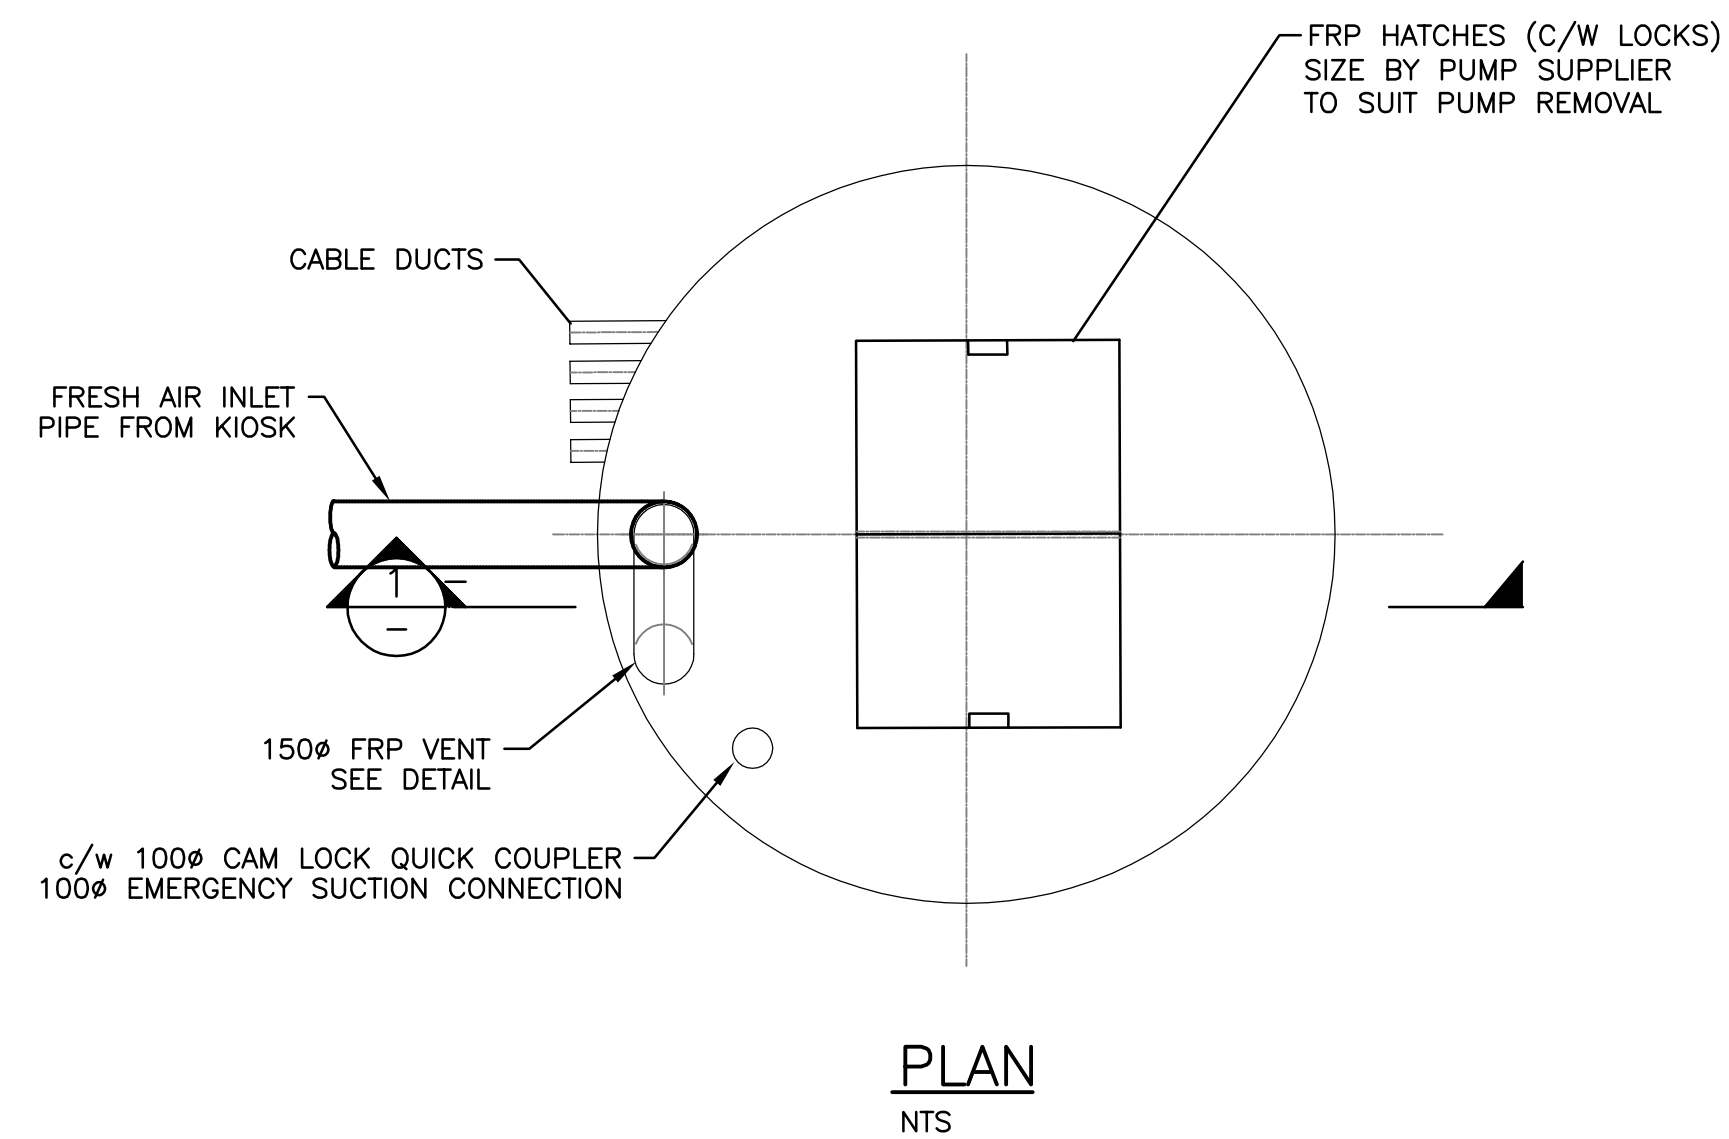

"This as-constructed information was not prepared by the Regional District of Central Okanagan and therefore there is no guarantee of its accuracy. It is the recipient's and user's responsibility to confirm the accuracy of this as-constructed information before proceeding with any work that may be affected by this as-constructed information."

RECORD DRAWING

LEGEND	
WATER	J CAP
SAN. SEWER	□ CATCH BASIN
STORM SEWER	⊕ ELECTRICAL BOX
GAS	⊕ HYDRANT
U.G. TELEPHONE	⊕ VALVE
U.G. ELECTRICAL	⊕ LAMP STANDARD
CABLE TV	⊕ EXISTING SEPTIC TANK
SAN# ○	SAN MANHOLE (EXISTING OR FUTURE)
STM# ○	STORM MANHOLE (EXISTING OR FUTURE)
MH# ●	MANHOLE (PROPOSED)
⑩	DRAWING REFERENCE NUMBER
⊕	MANHOLE NUMBER
⊕	CLEAN-OUT
⊕	INSPECTION CHAMBER

No.	DATE	BY	REVISION	Chk'd	No.	DATE	BY	REVISION	Chk'd
5	09/13/04	BC	PUMP STATION REVISION	BC					
4	08/04/04	JB	C.C.N. #2	BC					
3	06/28/04	JB	C.C.N. #1	BC					
2	04/29/04	BC	CONSTRUCTION ISSUE	BC	7	01/19/07	JB	REVISIONS PER RDCC COMMENTS	DRG
1	01/30/04	CB	ISSUED FOR TENDER	BC	6	01/12/07	JB	RECORD DRAWING	DRG


RD
REGIONAL DISTRICT
OF CENTRAL OKANAGAN

DRAWN:	MB/KR
DESIGN:	BC
APPROVED:	RAV
DATE:	OCT 03
SCALE:	AS NOTED


Associated Engineering
Suite 420
1628 Dickson Avenue
Kelowna, B.C., V1Y 3X1
Tel: (250) 763-3638
Fax: (250) 763-8880

**LAKEVIEW PHASE ONE
SANITARY SEWER
SANITARY LIFT STATION DETAILS**


DRAWING NO.	2242-1-502
REV. NO.	7

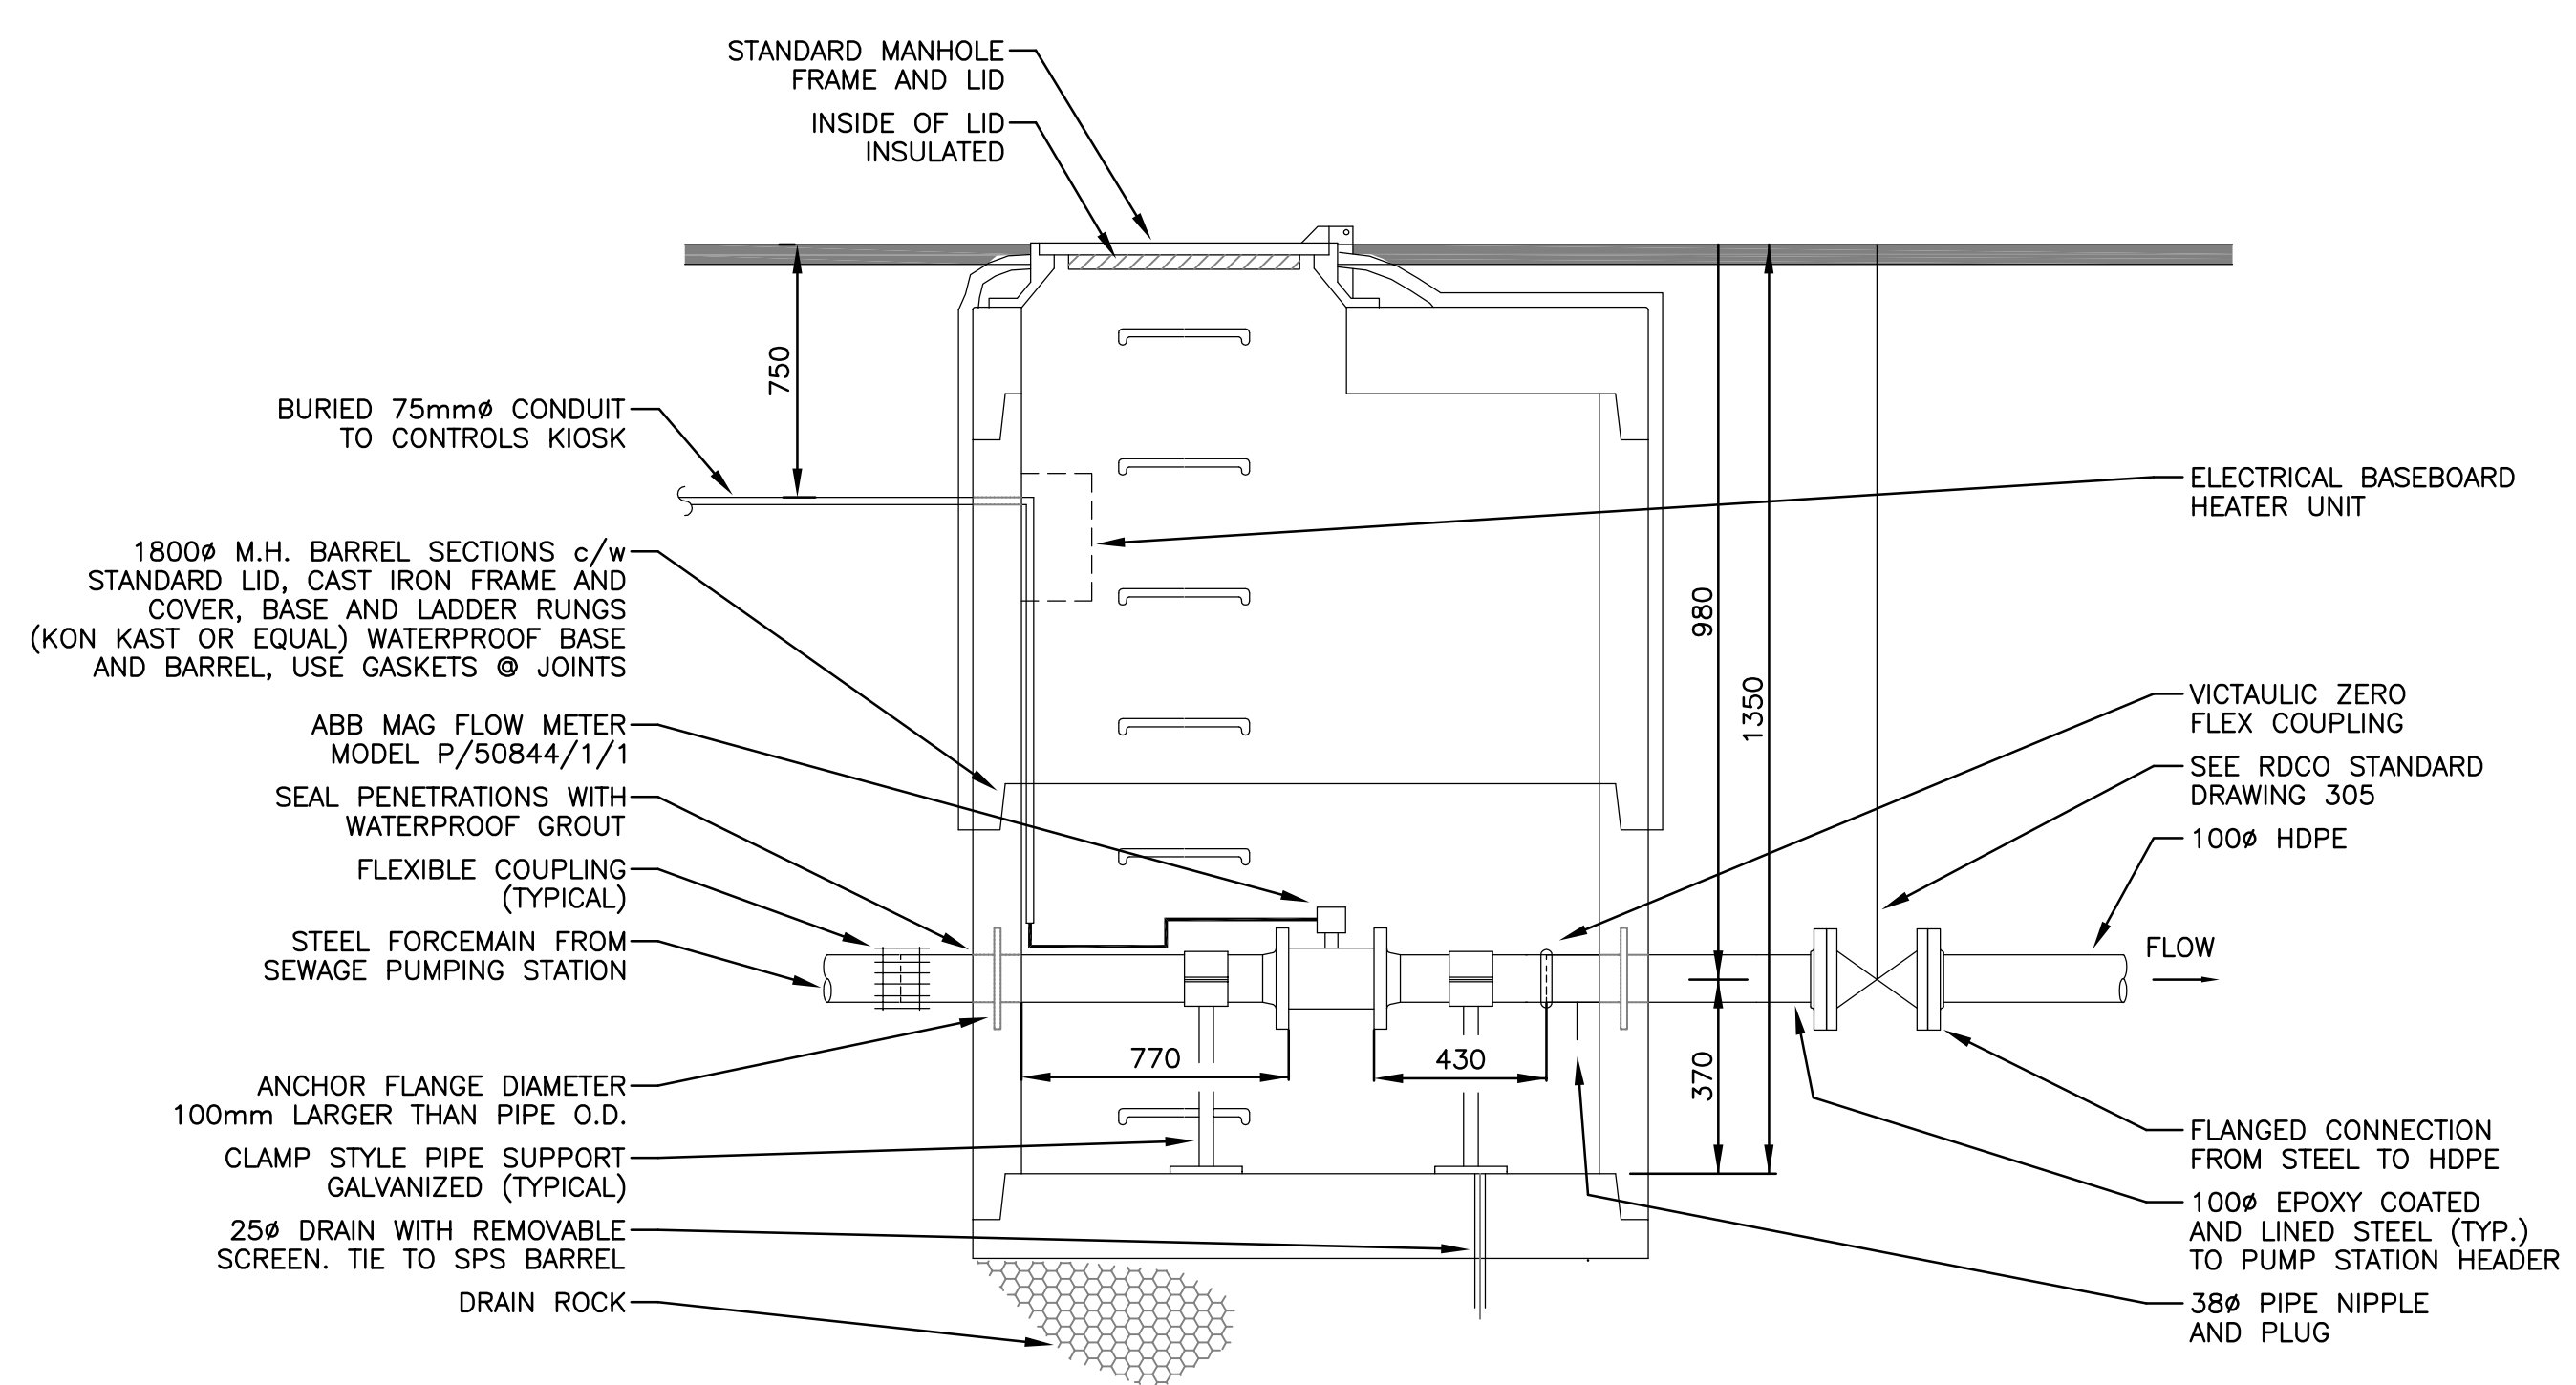

FLOWMETER CHAMBER
NOT TO SCALE

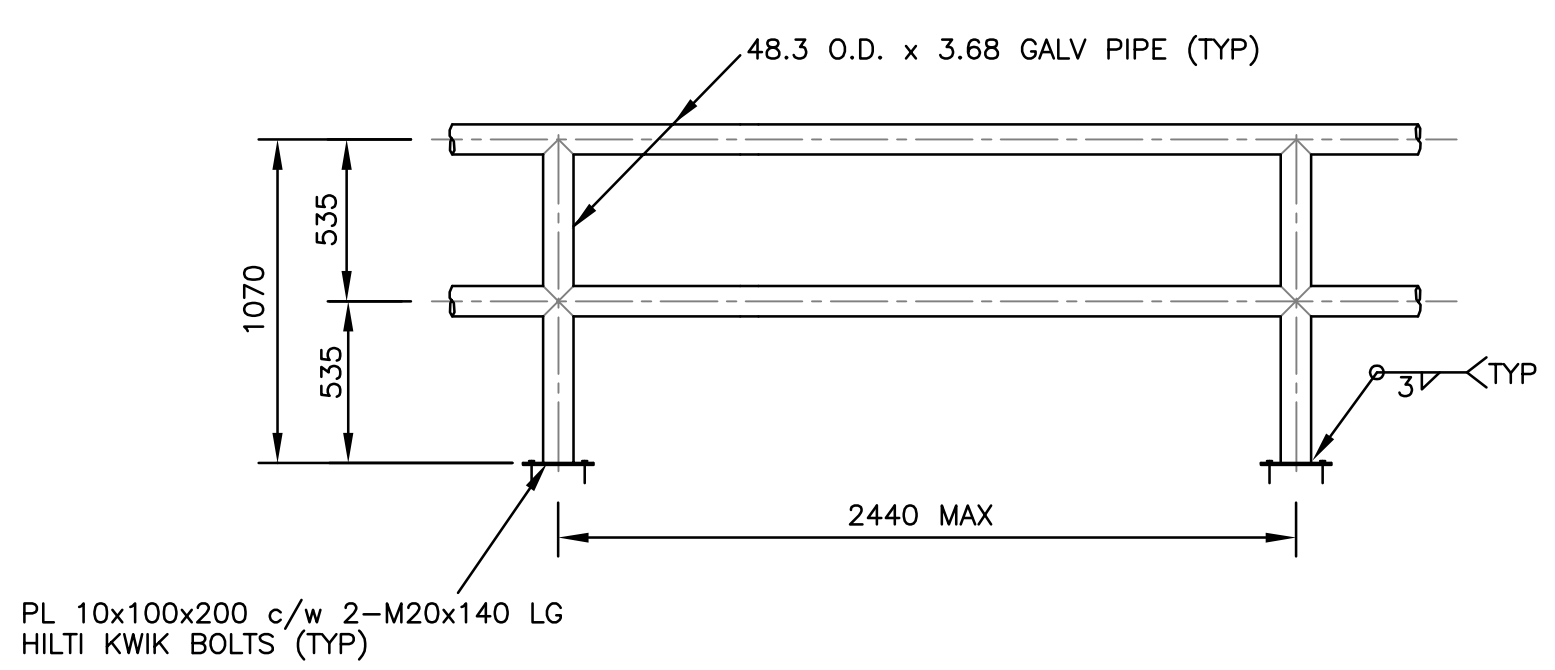

TYPICAL HANDRAIL DETAIL
NOT TO SCALE

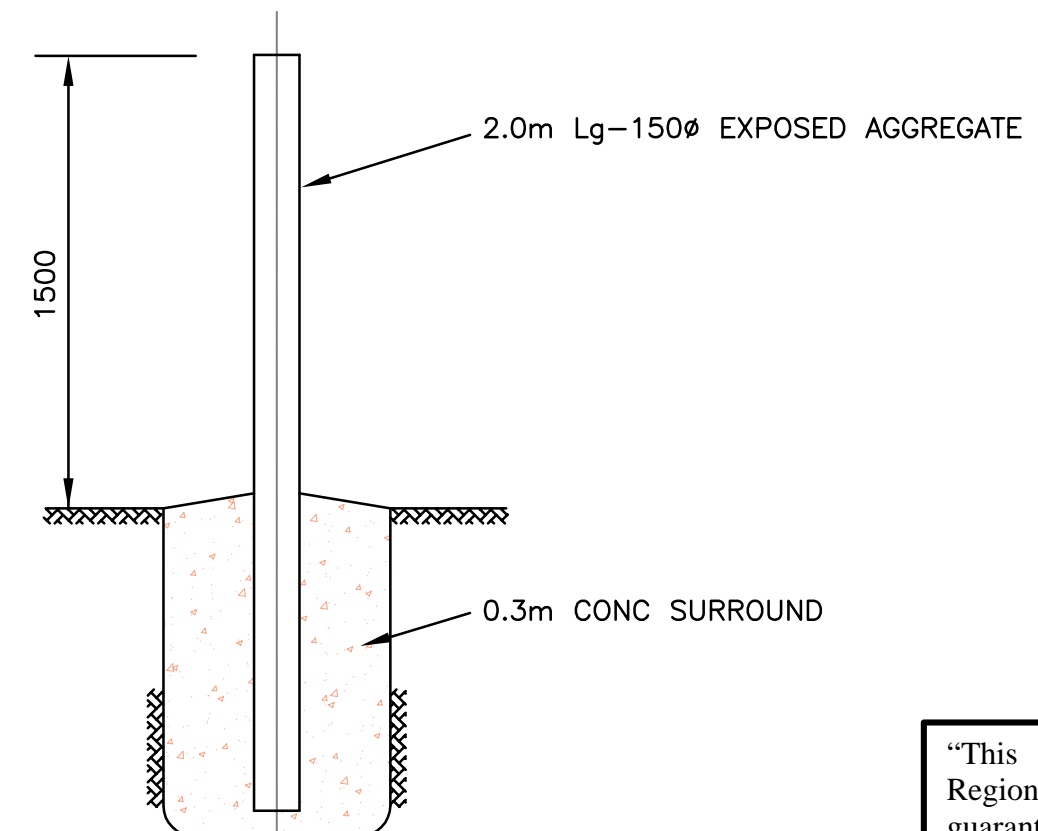

BOLLARD DETAIL
NOT TO SCALE

"This as-constructed information was not prepared by the Regional District of Central Okanagan and therefore there is no guarantee of its accuracy. It is the recipient's and user's responsibility to confirm the accuracy of this as-constructed information before proceeding with any work that may be affected by this as-constructed information."

RECORD DRAWING

LEGEND	
WATER	J CAP
SAN. SEWER	■ CATCH BASIN
STORM SEWER	⊕ ELECTRICAL BOX
GAS	⊕ HYDRANT
U.G. TELEPHONE	⊕ VALVE
U.G. ELECTRICAL	⊕ LAMP STANDARD
CABLE TV	⊕ EXISTING SEPTIC TANK
SAN# ○	SAN MANHOLE (EXISTING OR FUTURE)
STM# ○	STORM MANHOLE (EXISTING OR FUTURE)
MH# ●	MANHOLE (PROPOSED)
(19)	DRAWING REFERENCE NUMBER
(28)	MANHOLE NUMBER
CO ●	CLEAN-OUT
IC ●	INSPECTION CHAMBER

No.	MM/DD/YY	DATE	BY	REVISION	Chk'd	No.	MM/DD/YY	DATE	BY	REVISION	Chk'd
4	08/04/04		BC	C.C.N. #1							
3	06/28/04		BC	C.C.N. #1							
2	04/29/04		PM	CONSTRUCTION ISSUE		7	01/19/07		JB	REVISIONS PER RDCC COMMENTS	DRG
1	01/30/04		BC	ISSUED FOR TENDER		6	01/12/07		JB	RECORD DRAWING	DRG
0	10/30/03		BC	RECO REVIEW		5	09/13/04		BC	PUMP STATION DESIGN	BC



P.ENG.	
DRAWN:	MB/KR
DESIGN:	BC
APPROVED:	RAV
DATE:	OCT 03
SCALE:	AS NOTED

Associated Engineering



Suite 420
1628 Dickson Avenue
Kelowna, B.C., V1Y 5X1
Tel: (250) 763-3638
Fax: (250) 763-8880

**LAKEVIEW PHASE ONE
SANITARY SEWER
CONSTRUCTION DETAILS**

DRAWING NO.
2242-1-503
REV. NO.
7

* ASSUMED MODEL NUMBER.

FLYGT		PERFORMANCE CURVE			PRODUCT NP3171.181	TYPE HT
DATE 2013-10-23	PROJECT COLLENS HILL LS 14*				CURVE NO 63-452-00-6050	ISSUE 1
MOTOR COS PHI	1/1-LOAD 0.86	3/4-LOAD 0.81	1/2-LOAD 0.70	MOTOR SHAFT POWER 25 kW	IMPELLER DIAMETER 303 mm	
MOTOR EFFICIENCY	89.5 %	90.5 %	90.0 %	STARTING CURRENT ... 228 A	MOTORTYPE 25-19-4AA	STATOR 06D
GEAR EFFICIENCY	---	---	---	RATED CURRENT ... 32 A	REV 10	
COMMENTS	INLET/OUTLET -100 mm		RATED SPEED 1765 rpm	FREQ. 60 Hz	PHASES 3	VOLTAGE 600 V
	IMP. THROUGHLET ---		TOT.MOM.OF INERTIA ... 0.19 kgm2	POLES 4		
			NO. OF BLADES 2	GEARTYPE ---		RATIO ---

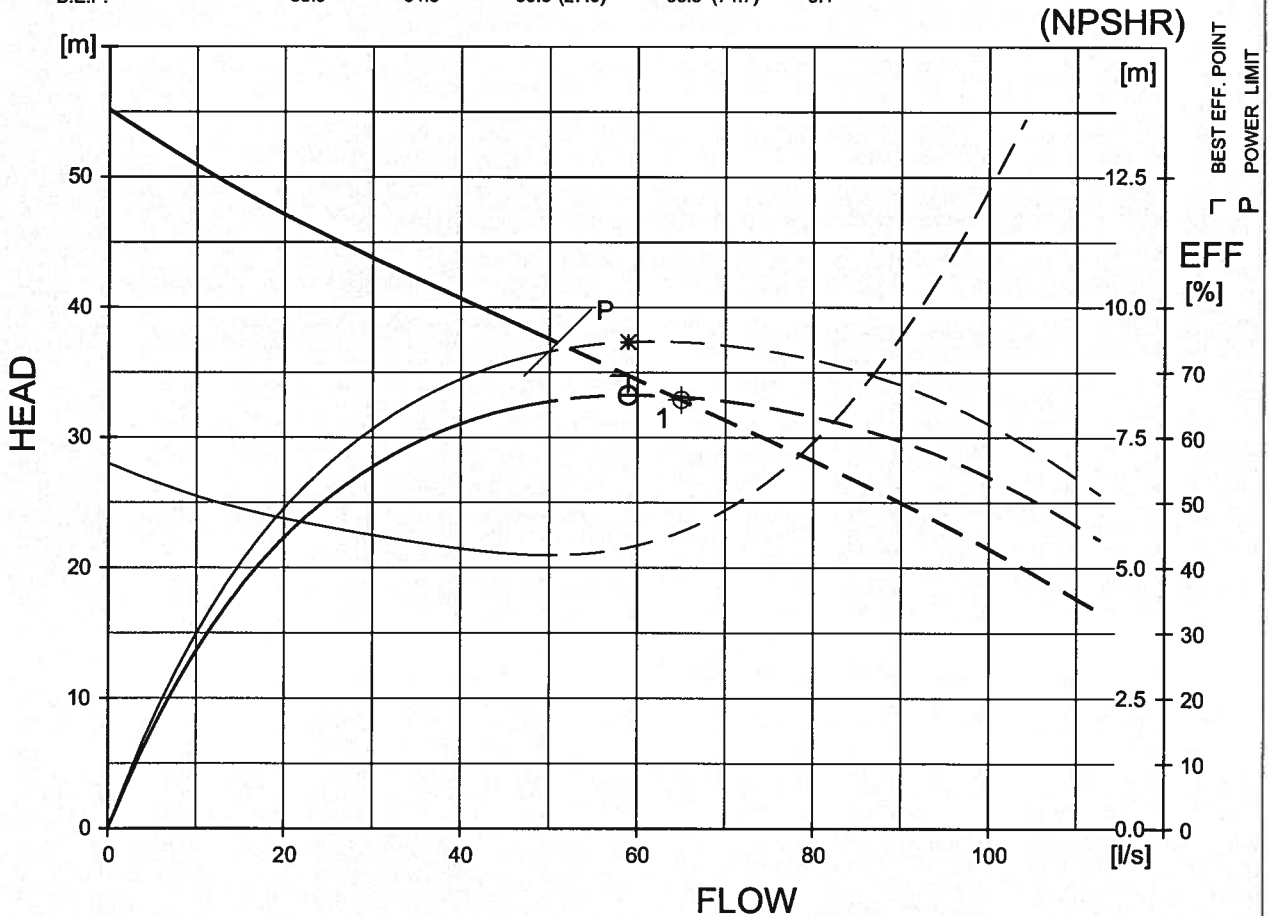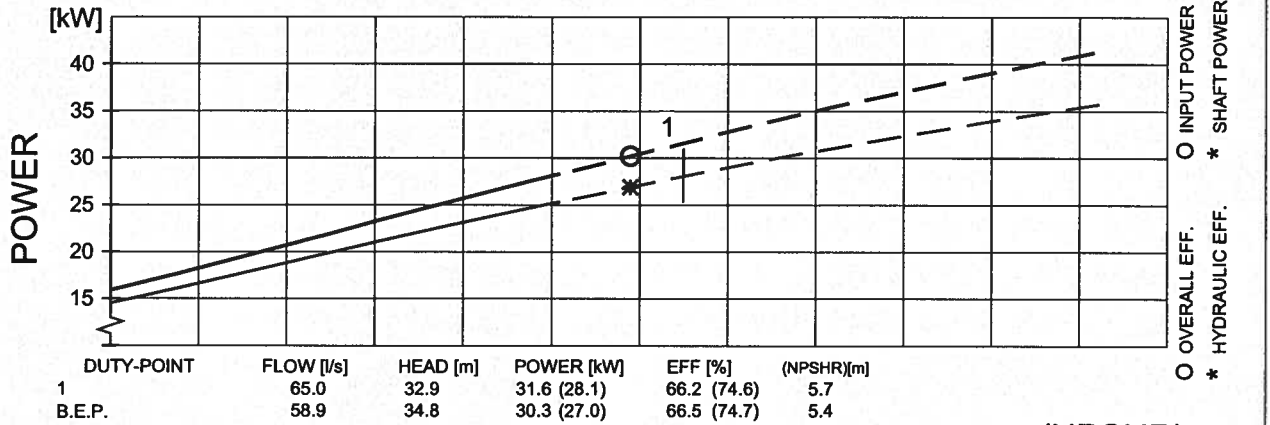

FLYPS3.1.5.7 (20060531)

(NPSHR) = (NPSH3) + margins

Performance with clear water and rating data at 40 °C



CURVE

Rating

Frequency	60 Hz	Product	3171 . 181	Issue	1
Phases	3	Motor	25-19-4AA	Start max	30
Poles	4	Output power	25.0 kW	Issue date	
Approval		Installations	PSTZ	Valid from	6/8/2005
Cooling		Type of duty	S1	Status	APPR

Max temperature **40 ° C / 104 ° F**

	<i>Alternative 1</i>	<i>Alternative 2</i>		
Voltage	600 V	V	Stator variant	06
Connection	D		Speed	1765 r/min
Current	32.0 A	A	Module number	165
Starting	228.0 A	A	Motor issue	10
Power factor	0.86			
Locked rotor code	H			

Warm liquid data

Note! Reduced rated output power

	70 ° C / 158 ° F	° C / ° F
Max temperature		
Current (1)	29.0 A	A
Current (2)	A	A
Max input power	25.0 kW	kW



District of West Kelowna

Sanitary Lift Station Evaluation

Station: Casa Rio Ls 15
Inspection By: Jim Kentel

Year Constructed:
Year Upgraded:

Matrix Rating		
(10 - highest rating)	Civil	23
(1 - lowest rating)	Process Mechanical	17
	Electrical Instrumentation	17
	Total Station Rating	57 (max. rating 370 points)



Civil:

Matrix
Rating

Parking Area:	_____	n/a
Drainage:	Good	10
Influent sewer:	Good	10
Site access:	Poor in park by lake	2
Water service:	No	1
		<u>23</u>

Process Mechanical:

Matrix
Rating

Station type:	Concrete Manhole	n/a
Number of pumps:	_____	n/a
Pump Redundancy:	_____	n/a
Pump Manufacturer / Type:	Goulds	1
Pump Model:	_____	n/a
Rated Capacity:	_____	n/a
Capacity Confirmation:	_____	n/a
Discharge pipe type / diameter:	_____	1
Header pipe type / diameter:	_____	1
Check valve type / diameter:	_____	1
Isolation valve type / diameter:	_____	1
Piping Condition:	_____	1
Emergency pumpout connection:	_____	1
Pressure gauges:	_____	1
Inlet bar screen:	_____	1
Wetwell condition:	_____	1
Access Hatches:	MH frame and cover	1
Ladder / Platform:	rungs	1
Wetwell benching:	_____	1
Odour Control:	_____	1
Ventilation:	_____	1
Water washdown:	_____	1
Confined Space Entry Requirements	_____	1
		<u>17</u>

Electrical / Instrumentation:

**Matrix
Rating**

Service Type	V / A / Phase / Wire	n/a
Pump 1 :	HP 1.5	n/a
	Volts Rpm	n/a
	FLA	n/a
	Starter	n/a
Pump 2 :	HP 1.5	n/a
	Volts Rpm	n/a
	FLA	n/a
	Starter	n/a
Alarm Functions:		n/a
		1
		n/a
		n/a
		n/a
Receptacles:		1
Interior Lighting:		1
Exterior Lighting:		1
SCADA / Telemetry:		1
Main Breaker:		1
Metering:		1
MCC:		1
Control Panel:		1
Lighting Panel:		1
Flowmeter: No		1
Grounding:		1
Surge Protection:		1
UPS:		1
PLC:		1
Level Control:		1
Standby Generator:		1
		17
Comments:		



District of West Kelowna

Sanitary Lift Station Evaluation

Station: Stevens Road LS 16
Inspection By: Jim Kentel

Year Constructed: 10/1/1996
Year Upgraded:

Matrix Rating			
(10 - highest rating)	Civil		30
(1 - lowest rating)	Process Mechanical		123
	Electrical Instrumentation		103
	Total Station Rating		256 (max. rating 370 points)



Civil:**Matrix
Rating**

Parking Area:	_____	n/a
Drainage:	Private property drainage	5
Influent sewer:	Gravity 200 PVC	10
Site access:	off side walk	5
Water service:	25mm	10
		30



Process Mechanical:**Matrix
Rating**

Station type:	Above Ground self priming	n/a
Number of pumps:	2	n/a
Pump Redundancy:	Yes	n/a
Pump Manufacturer / Type:	Gorman Pump	5
Pump Model:	T3A3-13	n/a
Rated Capacity:	20.5 L/S @ 29.3m TDH	n/a
Capacity Confirmation:	_____	n/a
Discharge pipe type / diameter:	PVC/150	10
Header pipe type / diameter:	CI/100	10
Check valve type / diameter:	CI Check/100	10
Isolation valve type / diameter:	CI Plug/100	10
Piping Condition:	Good	7
Emergency pumpout connection:	Yes	10
Pressure gauges:	Yes	10
Inlet bar screen:	No	1
Wetwell condition:	_____	5
Access Hatches:	Yes	10
Ladder / Platform:	Yes/NA	5
Wetwell benching:	Concrete	8
Odour Control:	No	1
Ventilation:	No	1
Water washdown:	25 - 50 Yard Hydrant	10
Confined Space Entry Requirements	N/A	10
		123





Electrical / Instrumentation:

Matrix
Rating

Service Type	V / A / Phase / Wire	n/a
Pump 1 :	HP 20	n/a
	Volts 575 Rpm 2150	n/a
	FLA	n/a
Starting Current		n/a
Pump 2 :	HP 20	n/a
	Volts 575 Rpm 2150	n/a
	FLA	n/a
Starting Current		n/a
Alarm Functions:		10
		n/a
		n/a
		n/a
Receptacle	Yes	10
Interior Lighting:	No	1
Exterior Lighting:	No	1
SCADA / Telemetry:		10
Control Panel:		10
Lighting Panel:		10
Flowmeter:	Grey line	10
Grounding:		10
UPS:		10
PLC:		10
Level Control:	Millitronics	10
Standby Generator:	No	1
		103
Comments:		

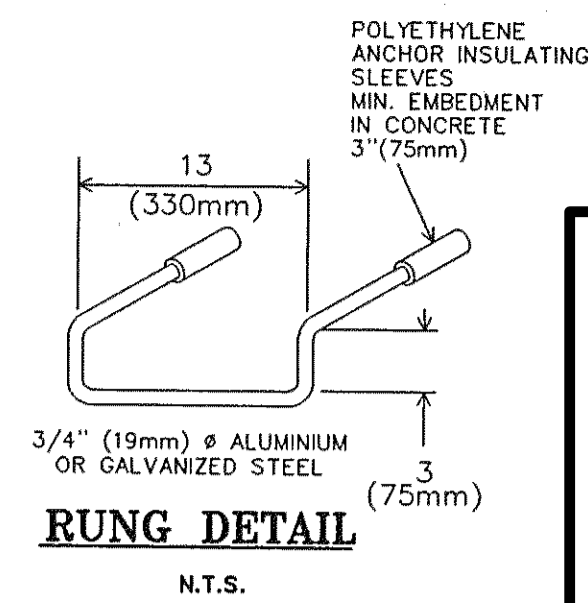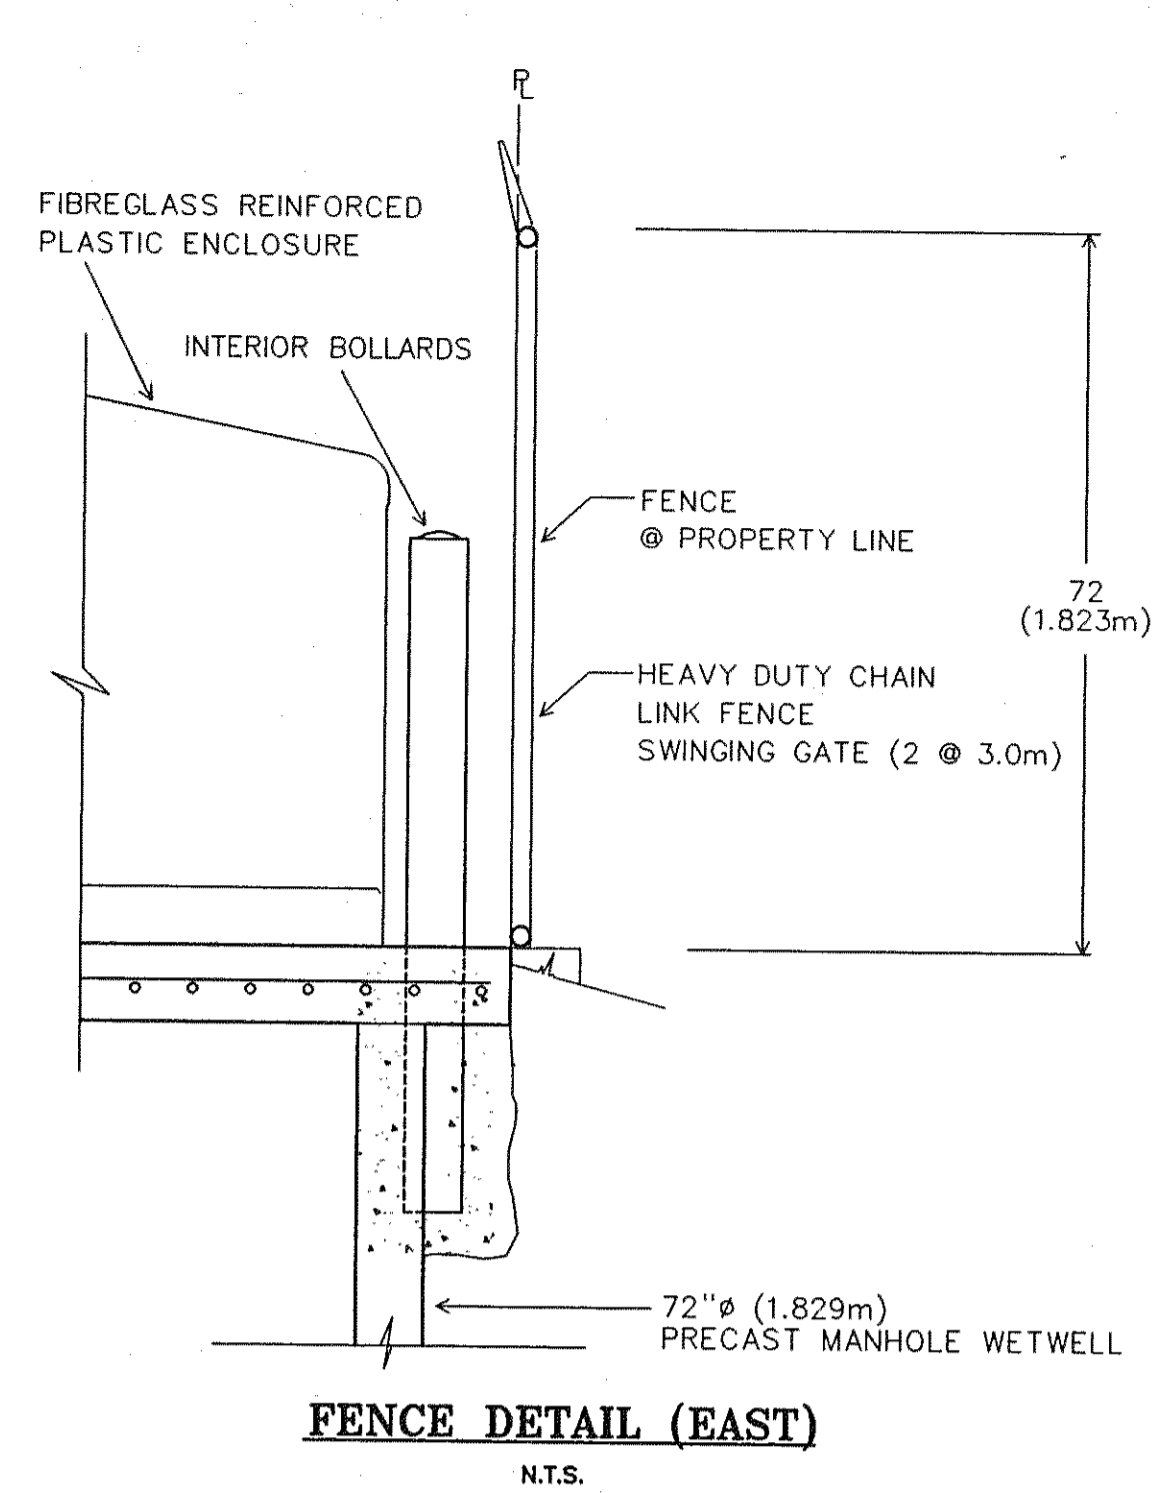


"This as-constructed information was not prepared by the Regional District of Central Okanagan and therefore there is no guarantee of its accuracy. It is the recipient's and user's responsibility to confirm the accuracy of this as-constructed information before proceeding with any work that may be affected by this as-constructed information."

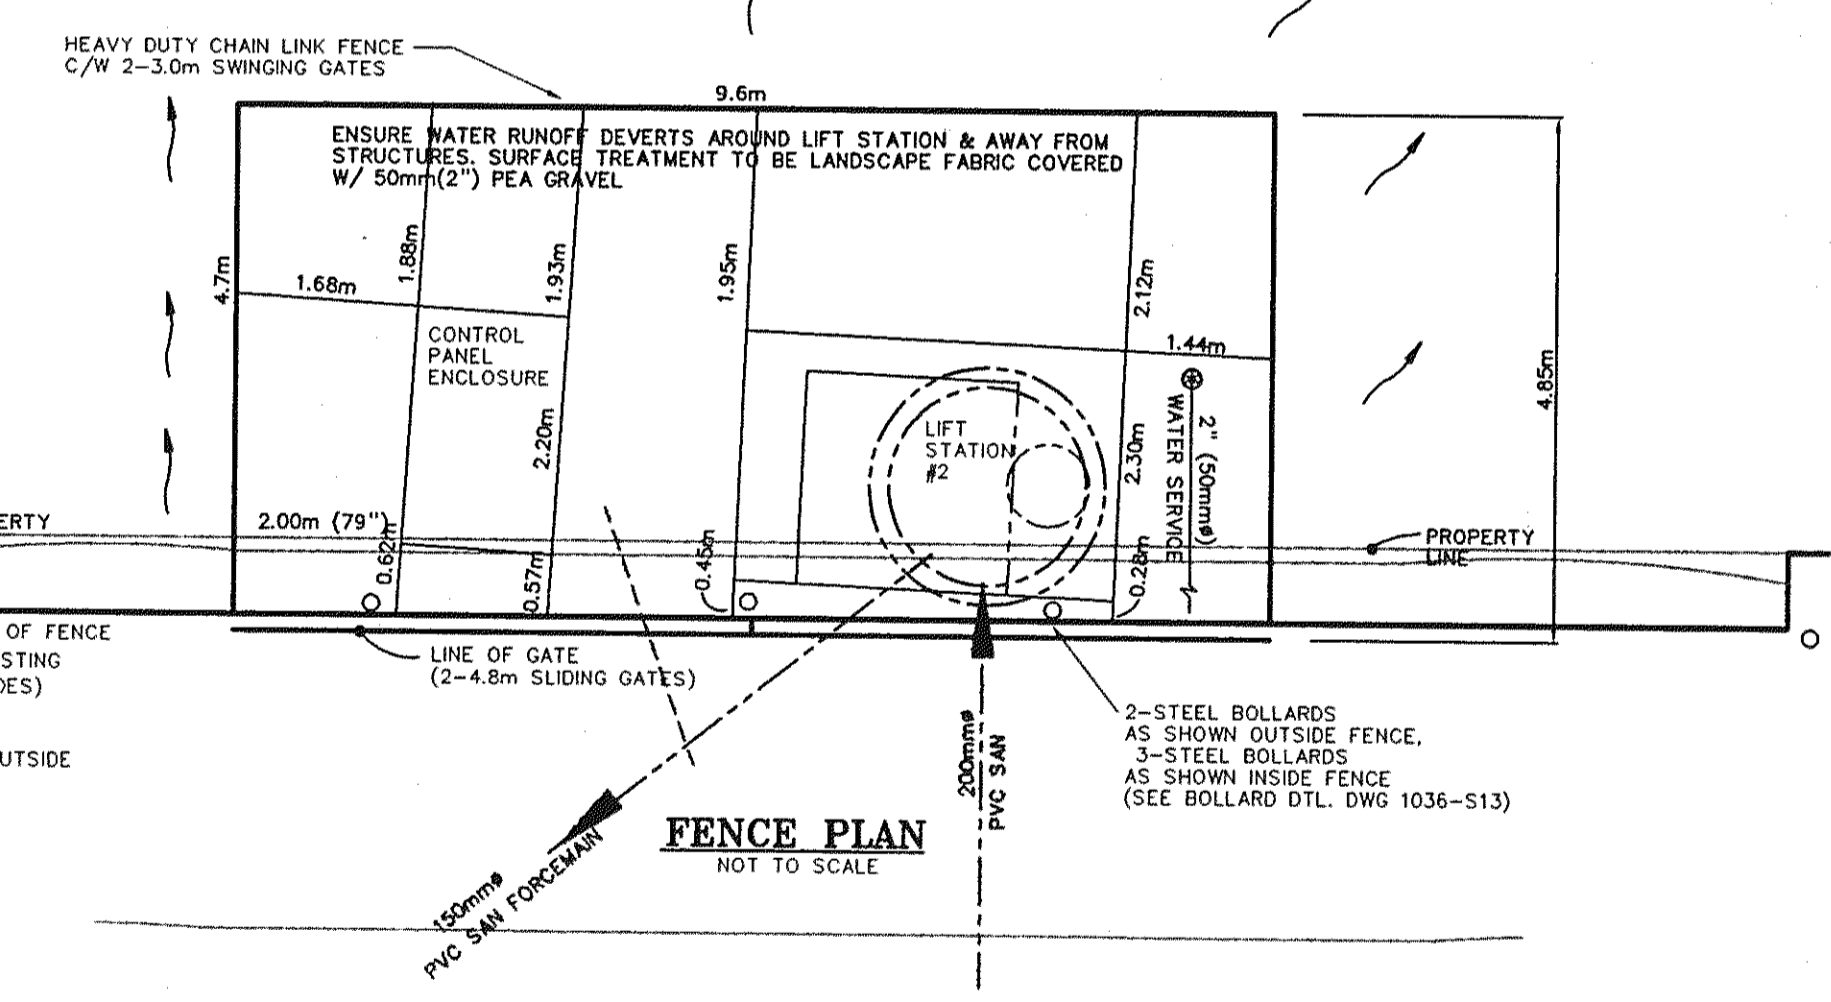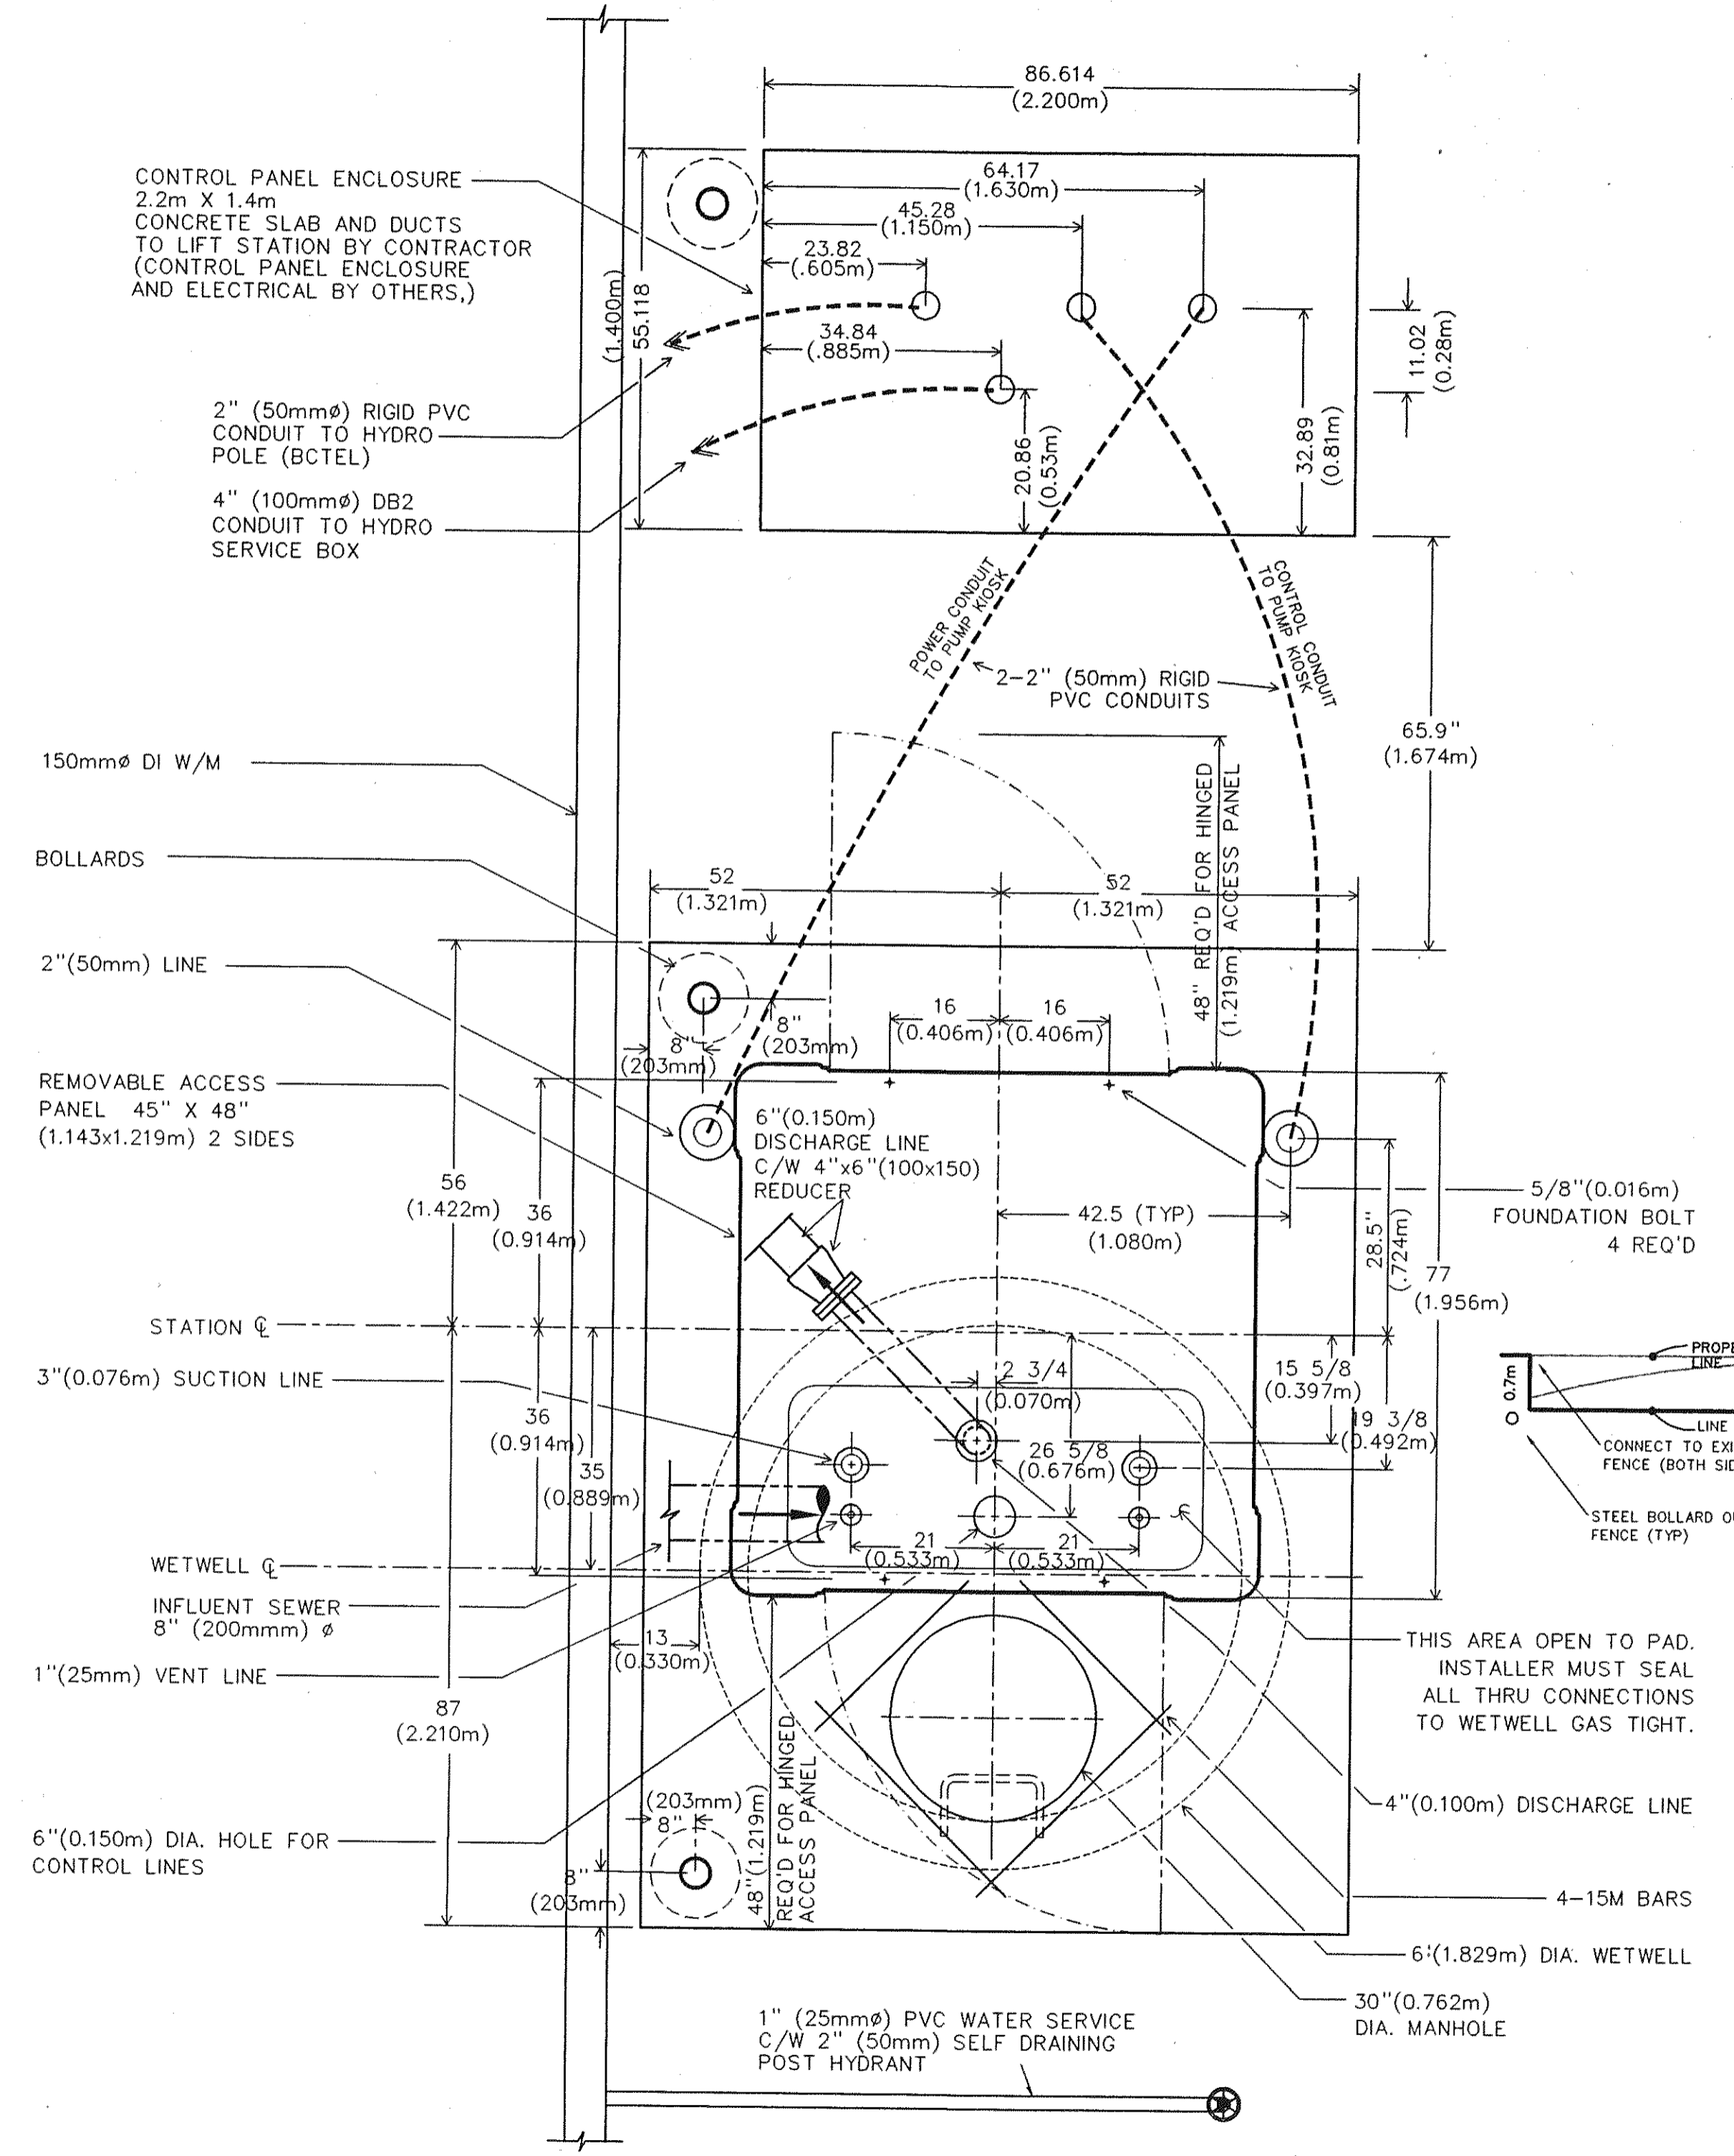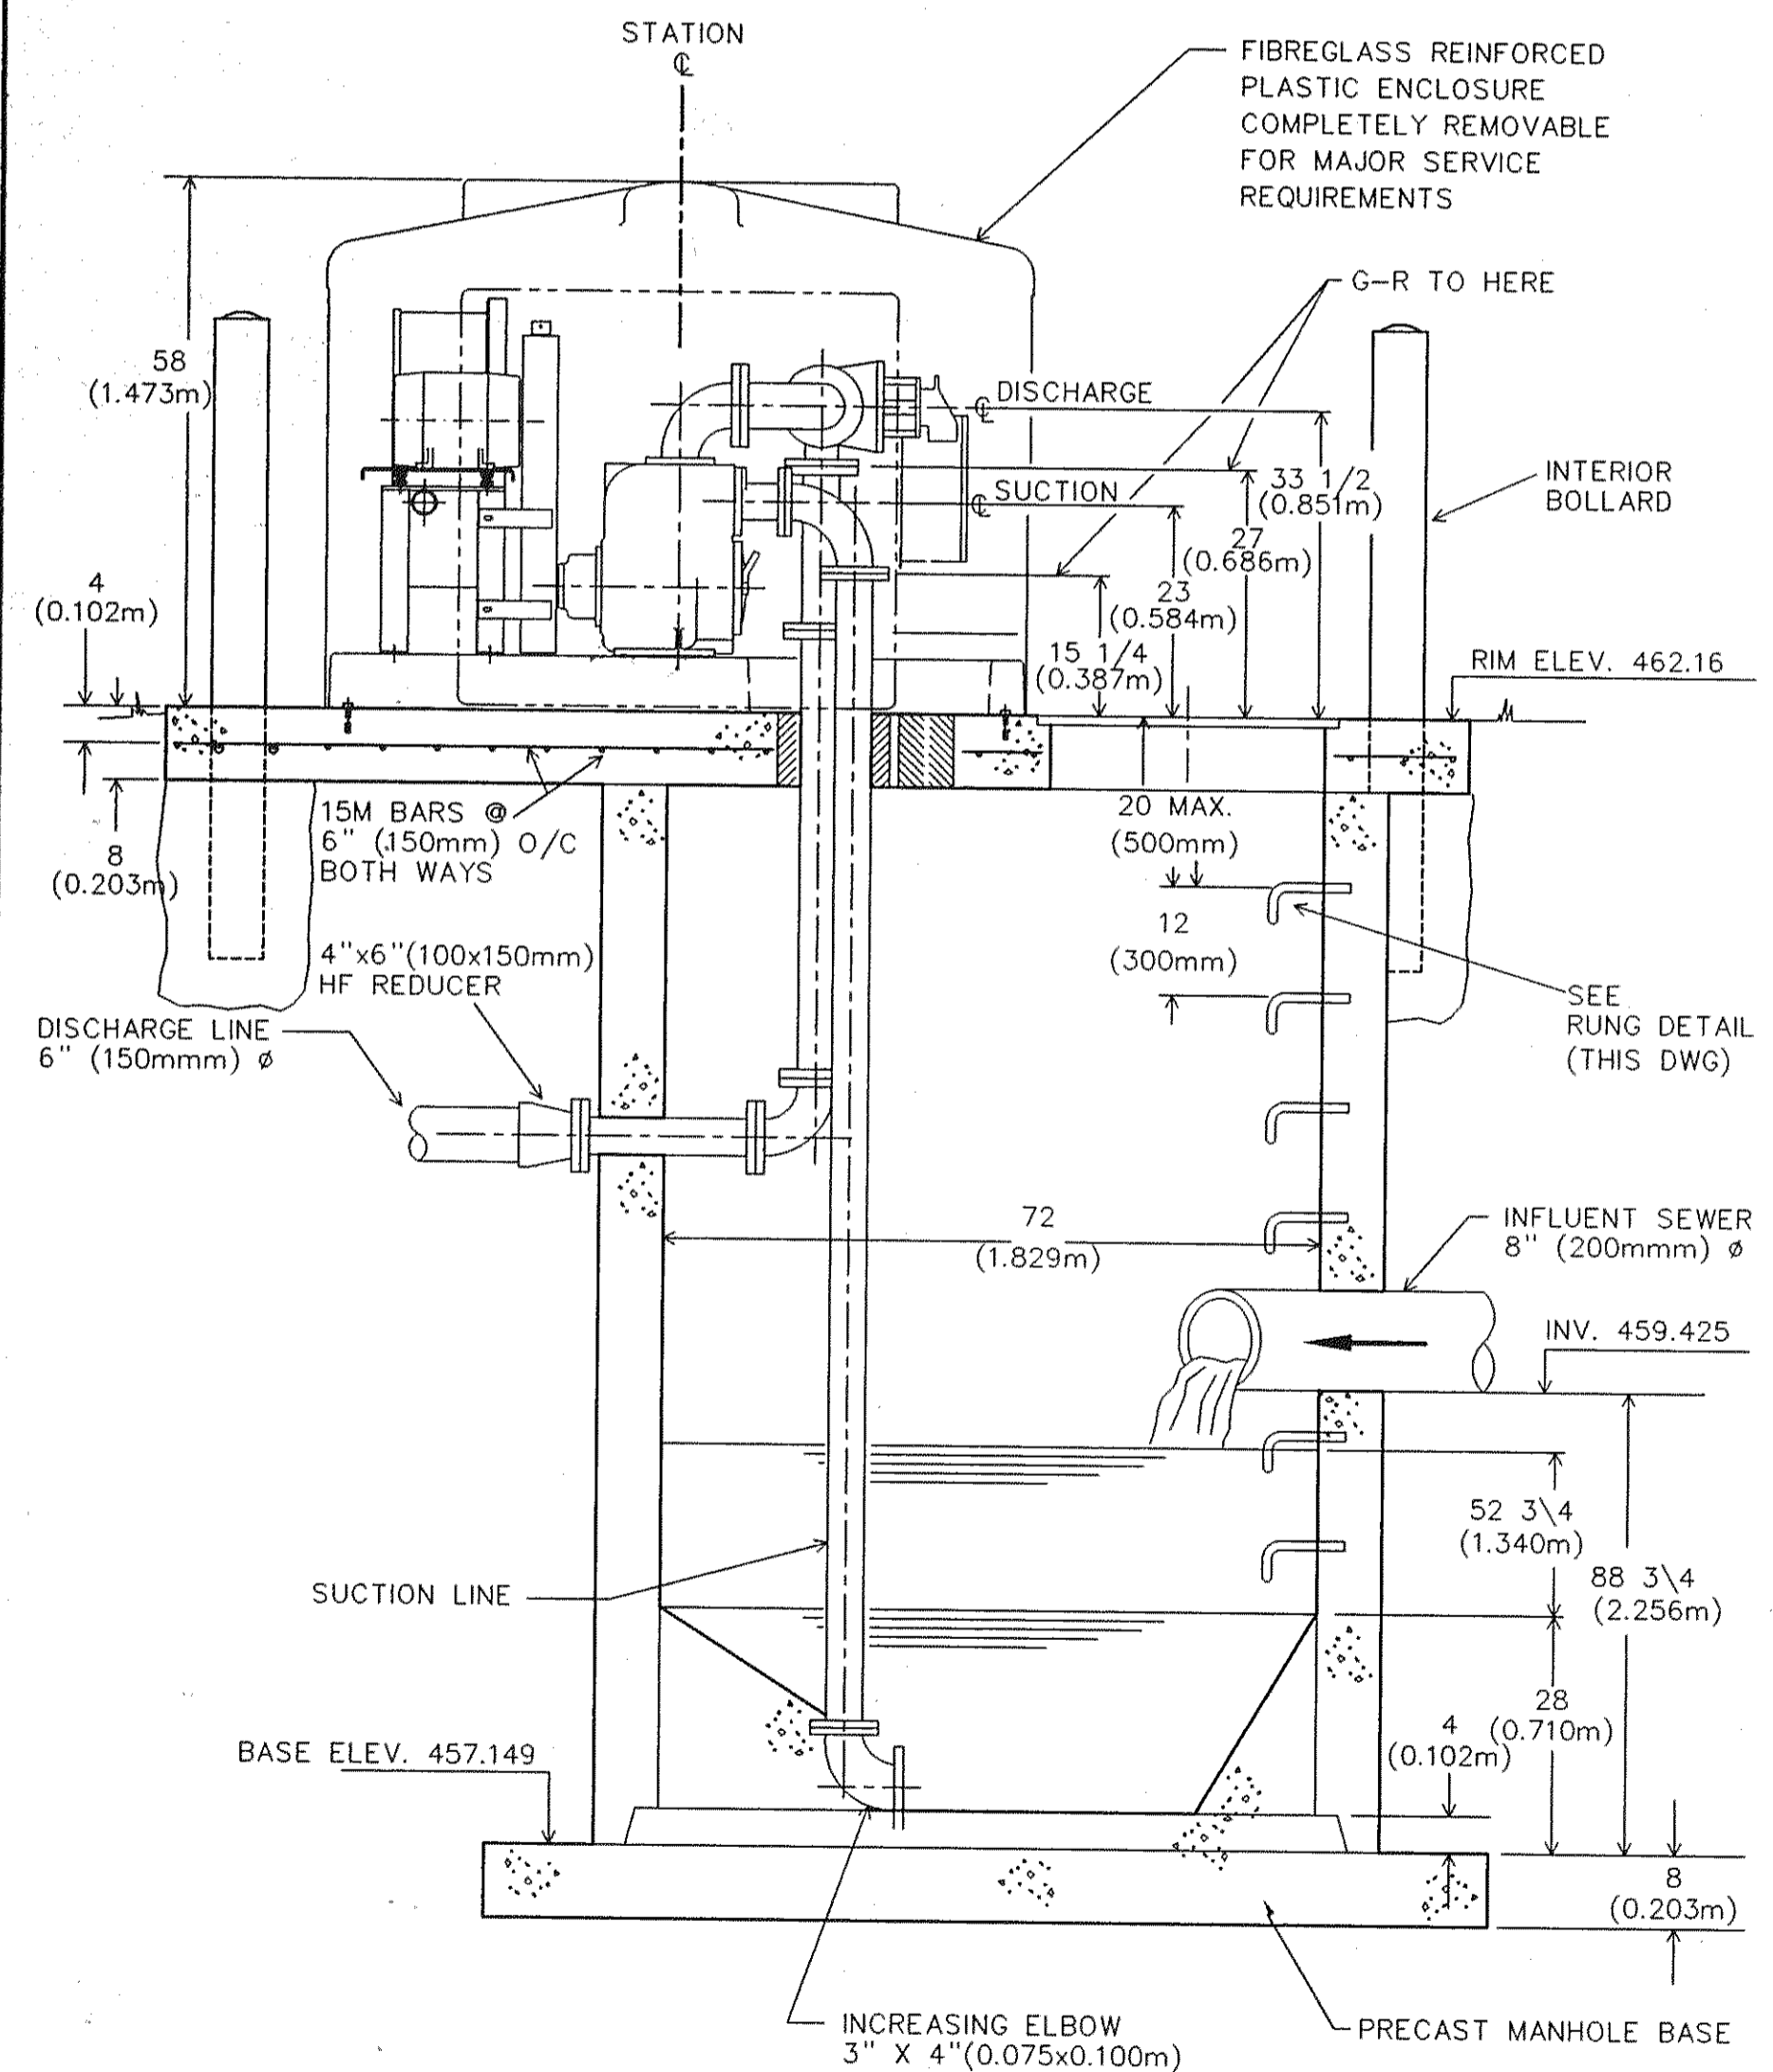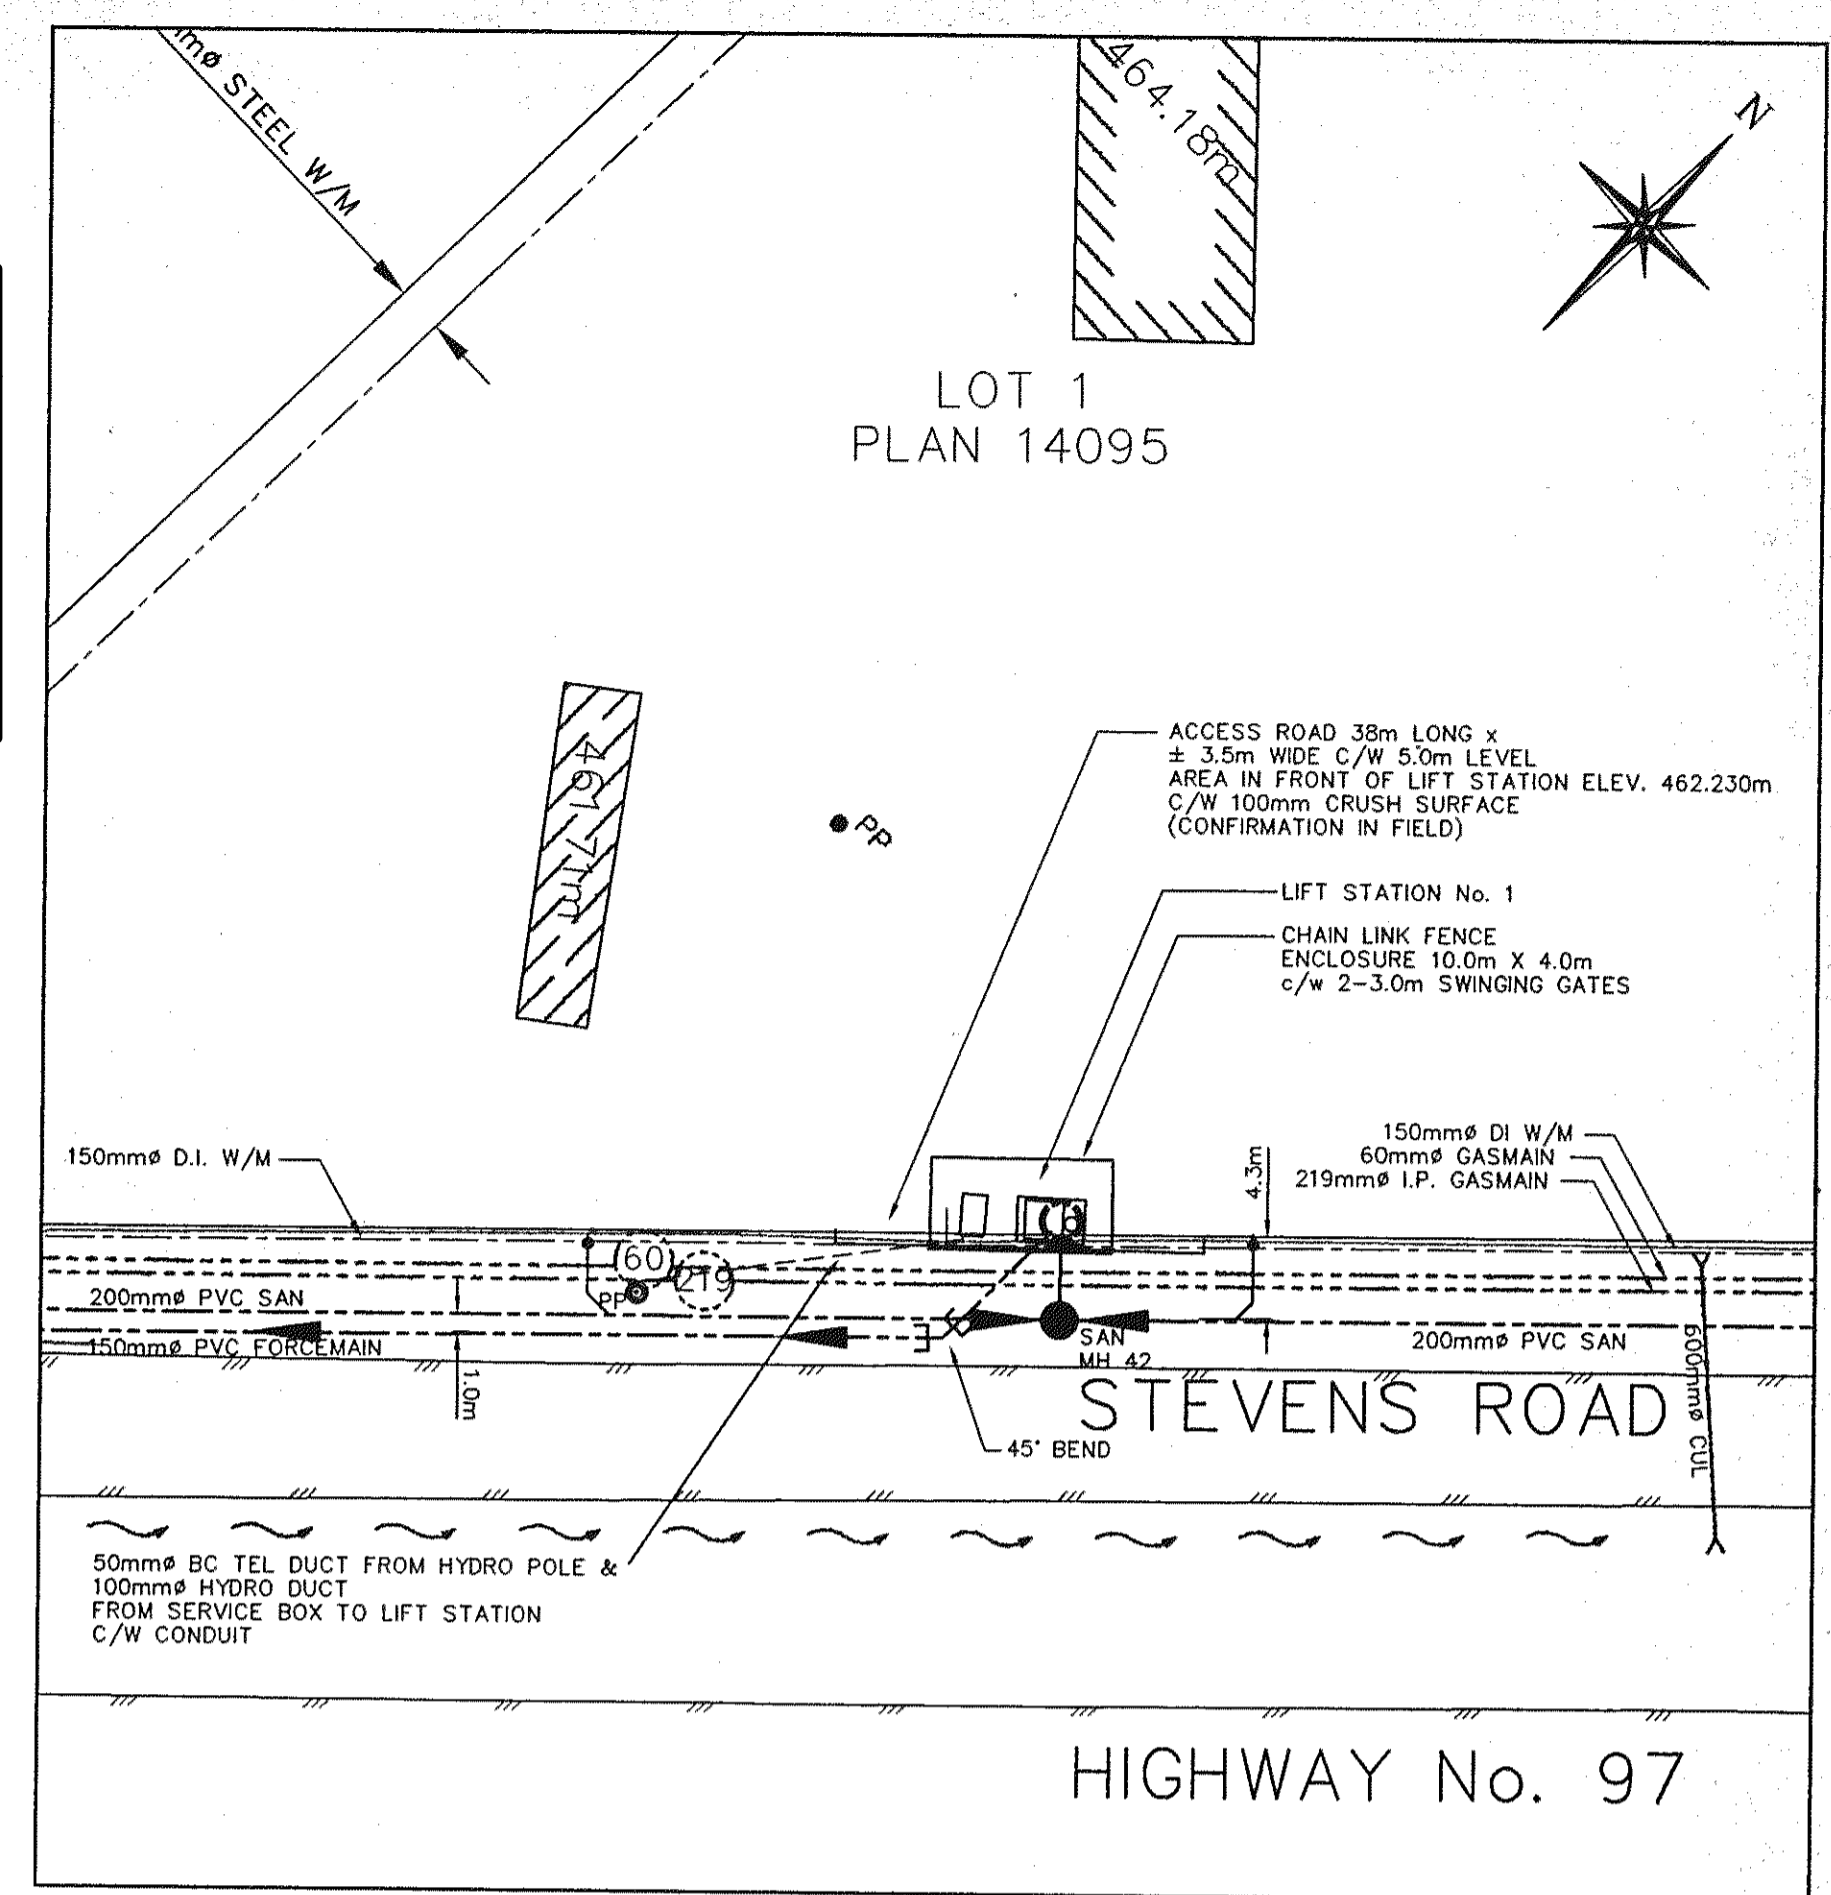

LEGEND

WATER	HYDRANT	PERC. HOLE
SAN. SEWER	WATER VALVE	PP POWER POLE
STORM SEWER	REDUCER	LS LAMP STD.
GAS	SANITARY MH	TL TRAFFIC LIGHT
U.G. TELEPHONE	STORM MH	TR TRANSFORMER
U.G. ELECTRICAL	CATCH BASIN	TEL SB
	DRYWELL	ELECT. SB

No.	MM/DD/YY	DATE	BY	REVISION	Chk'd	No.	MM/DD/YY	DATE	BY	REVISION	Chk'd
5	MAR. 10, 97	E.B.B.		REVISED LIFT STA. INV. / W/M / MISC.							
4	FEB. 23, 97	E.B.B.		REVISED LIFT STA. LOC'N & ELEV'S							
3	NOV. 27, 96	E.B.B.		REVISED LIFT STA. LOC'N, WETWELL SIZE, MISC.							
2	SEPT. 7, 96	E.B.B.		REVISED LIFT STATION WATER SERVICE & HYDRANT							
1	SEPT. 1, 96	E.B.B.		REVISED LIFT STATION FENCE & LOCATION							
6	MAY, 97	E.B.B.		AS CONSTRUCTED RIM AND INVERTS ONLY							

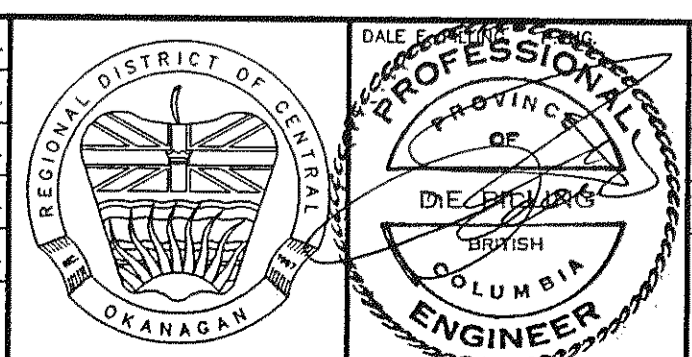

DRAWN	R.H.
DESIGN	P.A.C.E.
APPROVED	D.E.P.
DATE	MAY, 1995
SCALE	1 : 20 IMPERIAL

PACE
D. E. PILLING and ASSOCIATES
CONSULTING ENGINEERING Ltd.
#200, 540 GROVES AVENUE, KELOWNA, B.C. V1Y-4Y7
TEL: 763-2315 FAX: 763-6559

WESTSIDE INDUSTRIAL PARK
REG. DIST. OF CENTRAL OKANAGAN
1450 K.L.O. ROAD KELOWNA, B.C. V1W-3Z4
LIFT STATION #1
CONSTRUCTION SPECIFICATIONS

DRAWING NO.	1036-S11
R.D.C.O. No.	100.303
REV. NO.	6
PLOT DATE:	06-13-97 09:57
MM-DD-YY HH:MM	

WL-02988

39511-003

T3A3-B 3 X 4 X 4
OR
3 X 4 X 6 39511003.DGN

GORMAN-RUPP CO.
MANSFIELD, OHIO ST. THOMAS, ONTARIO



NAME
6' X 6' ABOVEGROUND SEWAGE
LIFT STATION W/DUPLEX T3A3-B PUMPS

DRN.	BM	CHK.	KEH	APP.	PFB	DATE	5/2/97
------	----	------	-----	------	-----	------	--------


SERIAL NO.

ITEM	DESCRIPTION	MAT'L & SIZE
1	PUMP	CAST IRON T3A3-B
2	MOTOR	CAST IRON
3	CHECK VALVE	CAST IRON 4"(100mm)
4	PLUG VALVE	CAST IRON 4"(100mm)
5	MOTOR CONTROL PANEL	STEEL
6	LIQUID LEVEL PANEL	STEEL
7	BELTGUARD	STEEL


"This as-constructed information was not prepared by the Regional District of Central Okanagan and therefore there is no guarantee of its accuracy. It is the recipient's and user's responsibility to confirm the accuracy of this as-constructed information before proceeding with any work that may be affected by this as-constructed information."

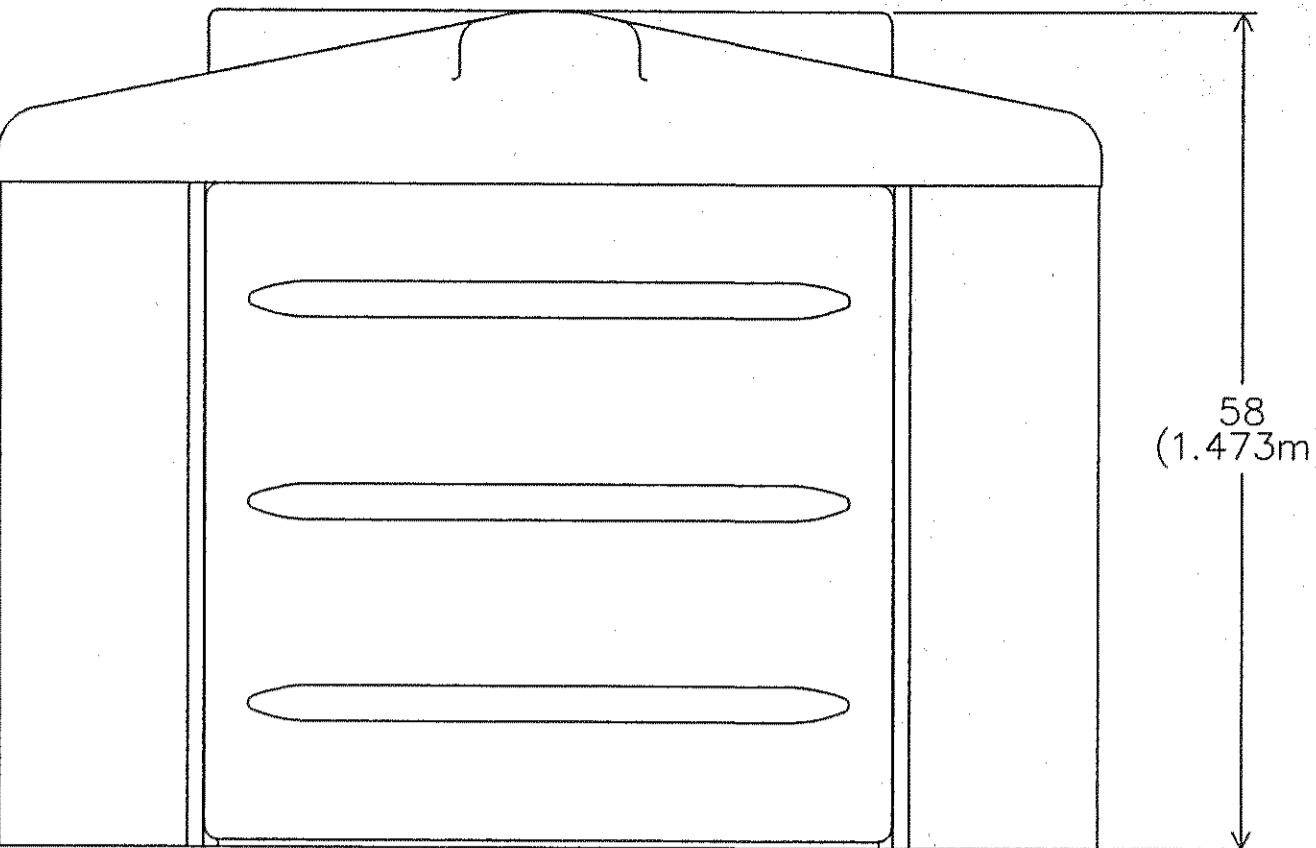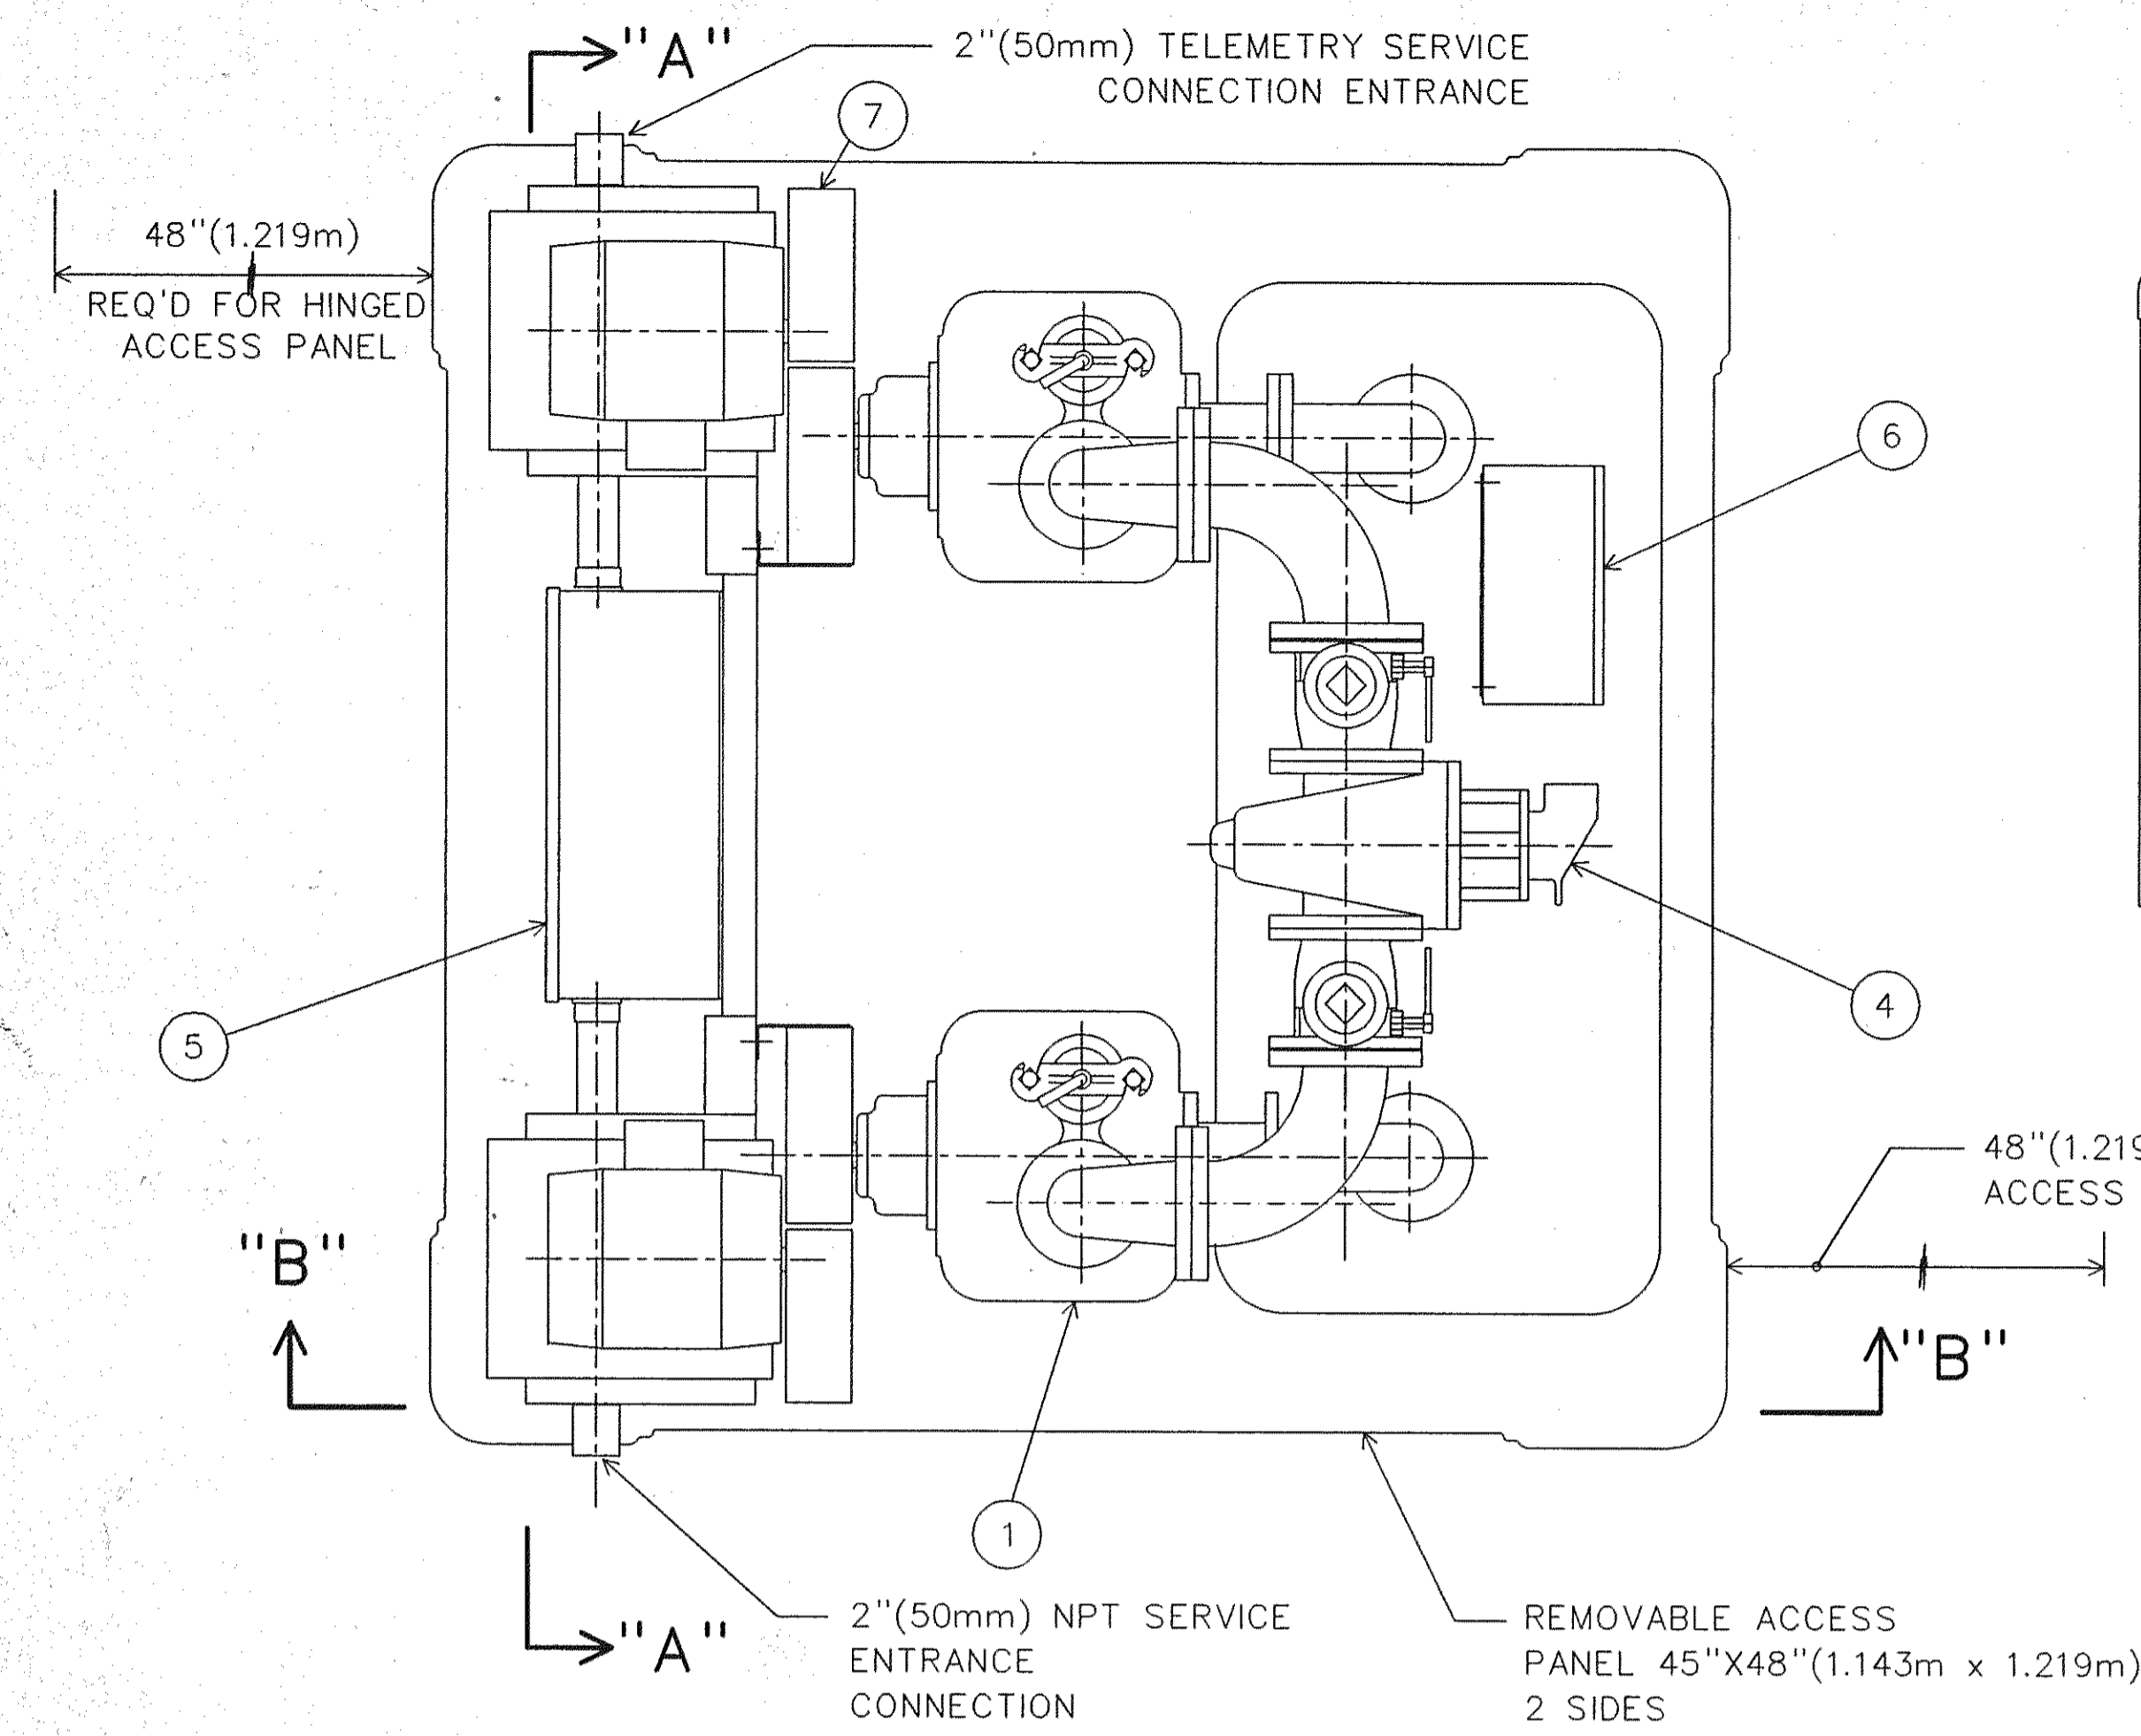


ELEVATION

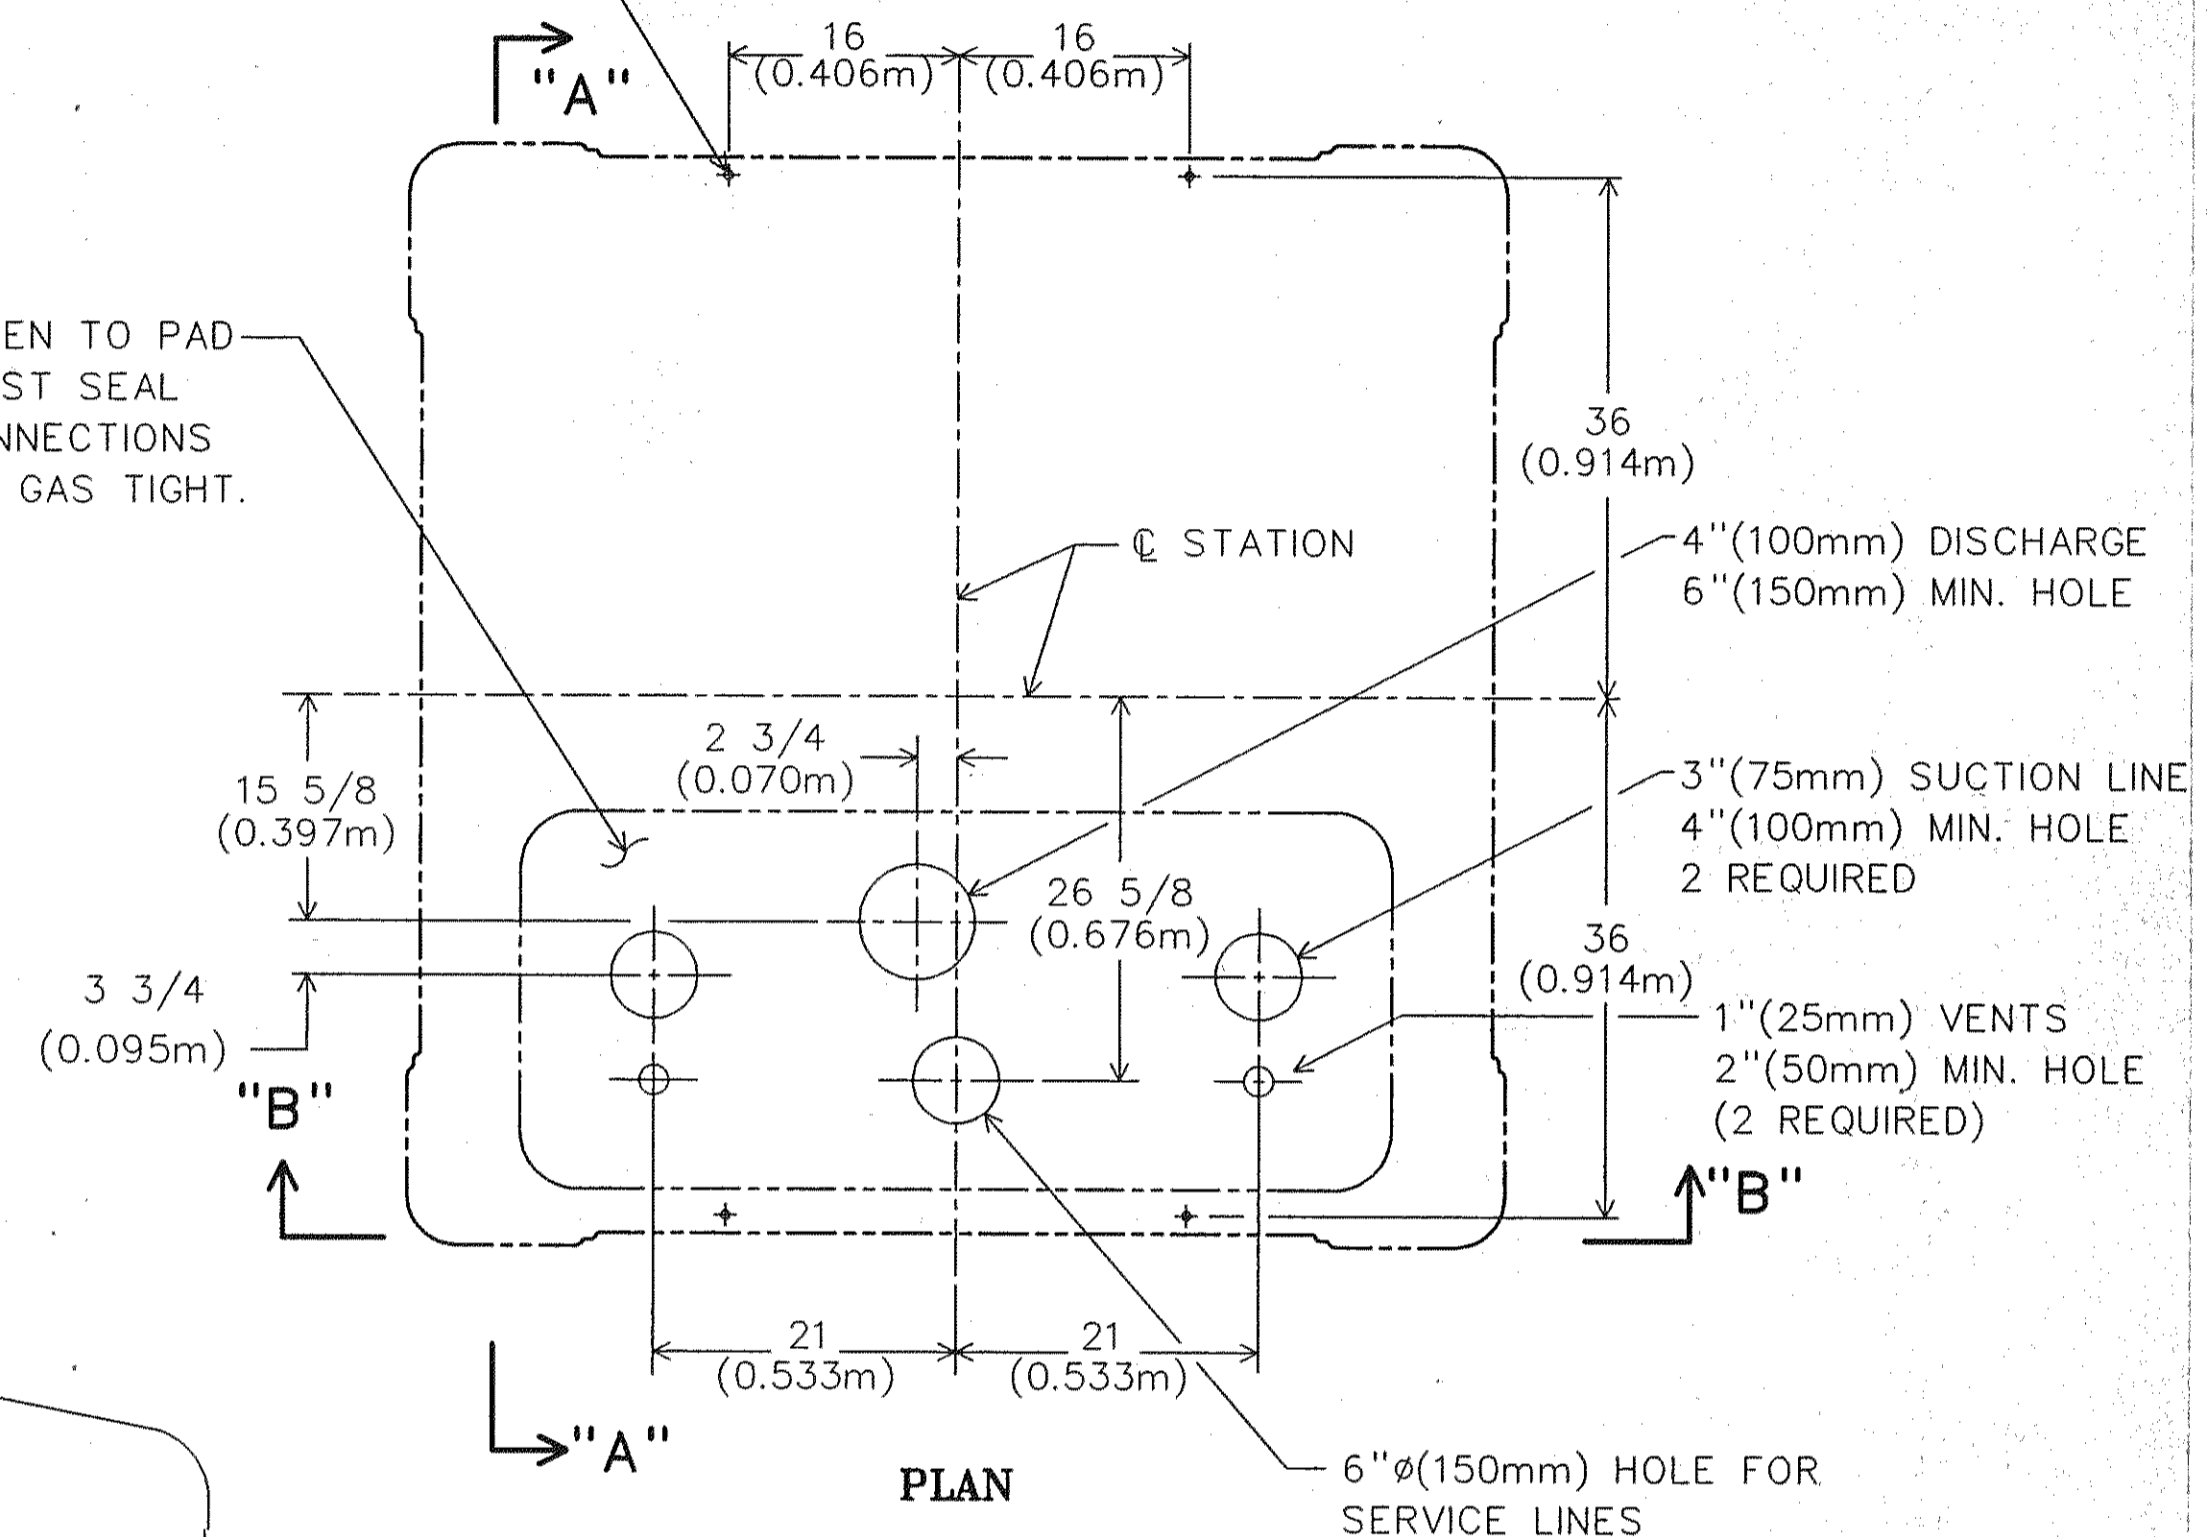

PLAN

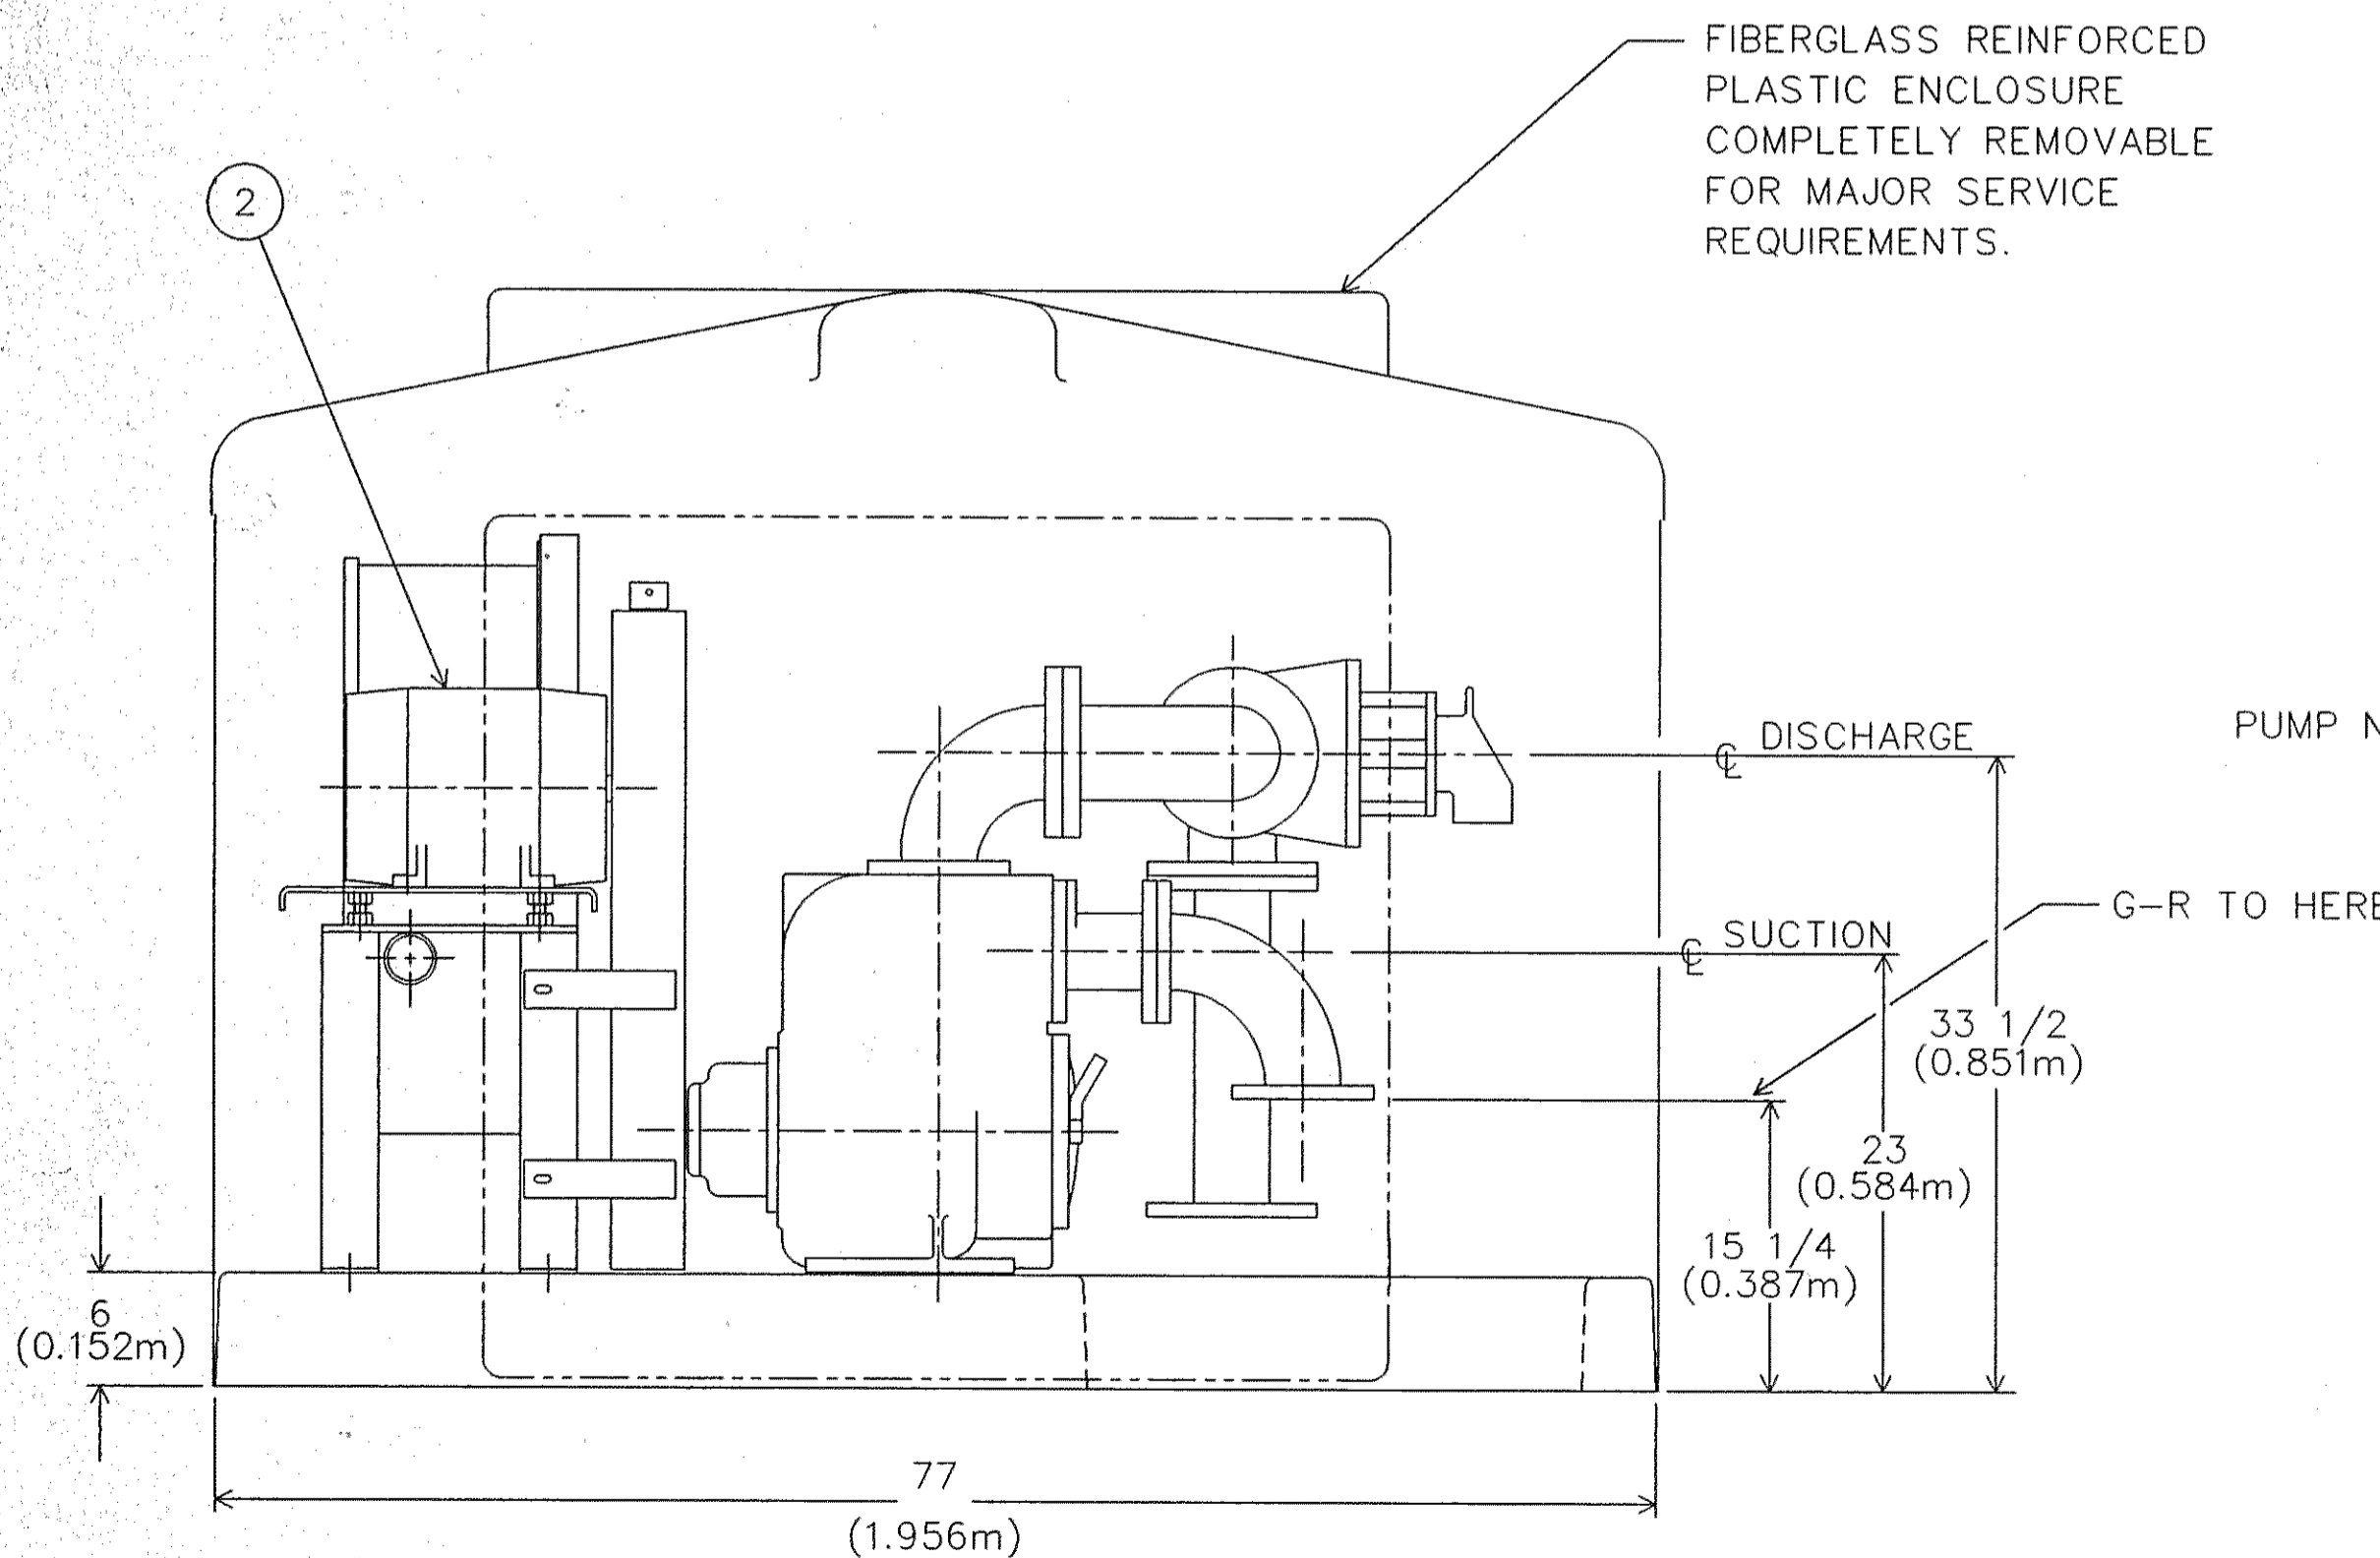

SECTION "A"

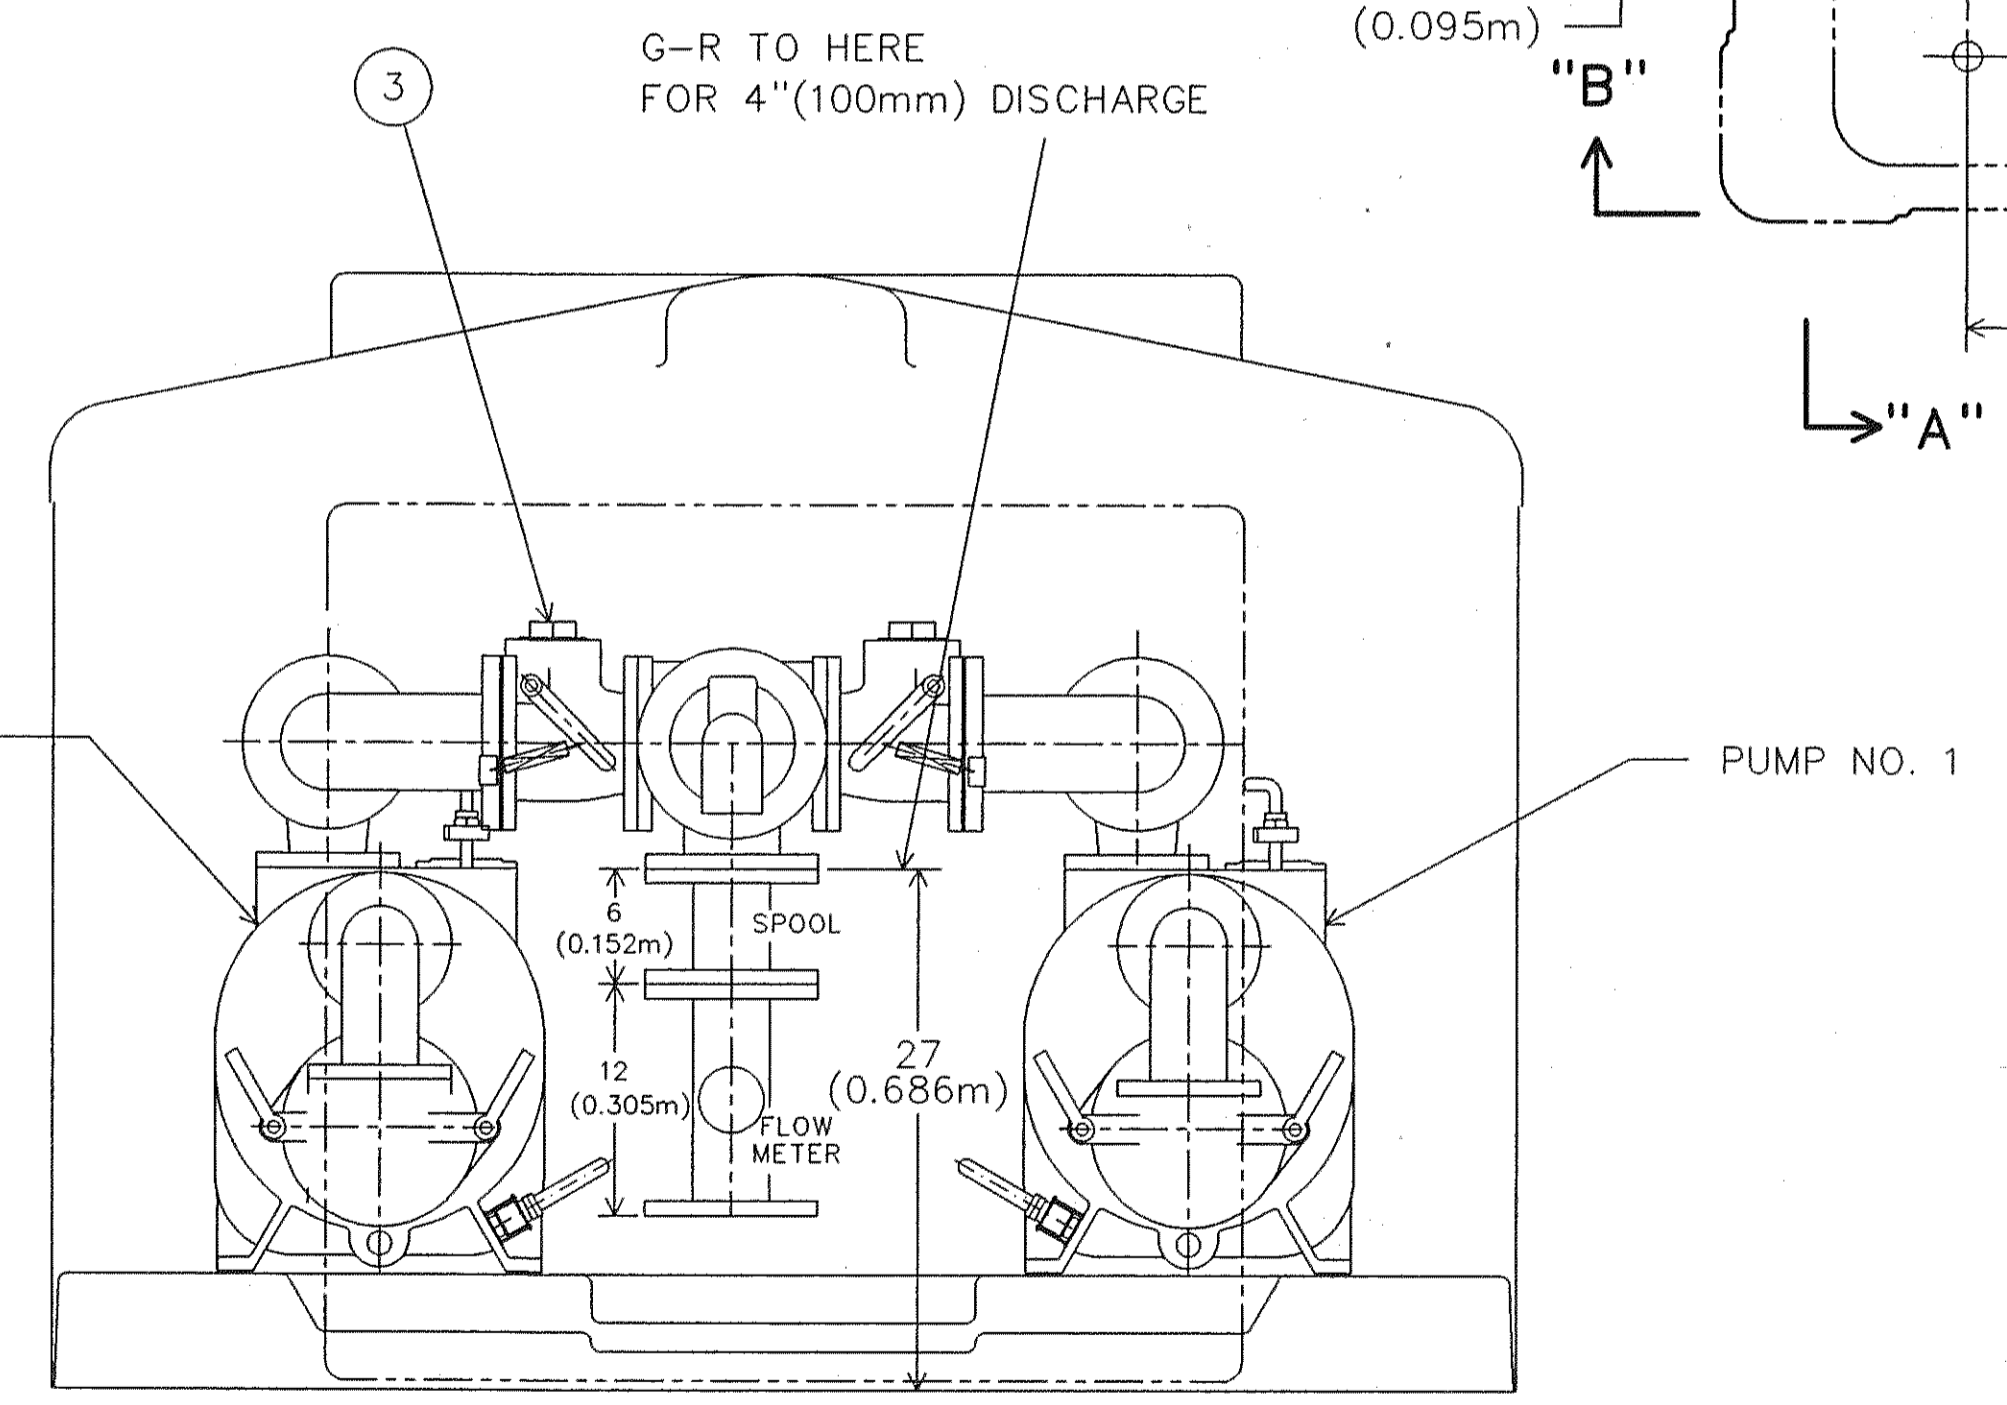

SECTION "A"

NOTE: CUSTOMER SUCTION AND DISCHARGE CONNECTIONS ARE 125# FLANGE

3 X 4 X 4 AS SHOWN
3 X 4 X 6 WITH INCREASER

45113013.DGN

GORMAN-RUPP
THE GORMAN-RUPP CO.
MANSFIELD, OHIO ST. THOMAS, ONTARIO

NAME 6' X 6' ABOVEGROUND SEWAGE LIFT STATION W/DUPLEX T3A3-B PUMPS			
DRN. BM	CHK. KEH	APP. PFB	DATE 3/18/75
D 45113-013			SERIAL NO.

WL-02989

LEGEND	SYMBOL	DESCRIPTION
WATER	HYD	HYDRANT
SAN. SEWER	WV	WATER VALVE
STORM SEWER	REDUCER	REDUCER
GAS	SAN	SANITARY MH
U.G. TELEPHONE	STM	STORM MH
U.G. ELECTRICAL	CB	CATCH BASIN
	DW	DRYWELL
	PERC	PERC. HOLE
	PP	POWER POLE
	LAMP STD.	LAMP STD.
	TR	TRAFFIC LIGHT
	TR	TRANSFORMER
	TEL. SB	TEL. SB
	ELECT. SB	ELECT. SB

No.	MM/DD/YY	DATE	BY	REVISION	Chk'd	No.	MM/DD/YY	DATE	BY	REVISION	Chk'd
1	09/13/96		R.H.	FLOW METER ADDED TO STATION							
2	11/21/96		E.B.B.	REVISED FLOW METER, MOVED REDUCER							

REGIONAL DISTRICT OF CENTRAL OKANAGAN

PROFESSIONAL ENGINEER

D. E. PILLING and ASSOCIATES CONSULTING ENGINEERING Ltd.

DESIGN	P.A.C.E.
APPROVED	D.E.P.
DATE	MAY, 1996
SCALE	1 : 10 IMPERIAL

PACE

D. E. PILLING and ASSOCIATES CONSULTING ENGINEERING Ltd.
#200, 540 GROVES AVENUE, KELOWNA, B.C. V1Y-4Y7
TEL: 763-2315 FAX: 763-5559

WESTSIDE INDUSTRIAL PARK
REG. DIST. OF CENTRAL OKANAGAN
1450 K.L.O. ROAD KELOWNA, B.C. V1W-3Z4

LIFT STATION #1 - DETAILS

DRAWING NO.	1036-S12
R.D.C.G. No.	100.303
REV. NO.	2
PLOT DATE	11-21-96 12:14 pm




STEVENS ROAD LS 16

Model T3A-B Size 3" x 3"
Imp. Dia. 8 3/4"
RPM VARIOUS
Max. Solids 2 1/2

TEST PERFORMANCE
70°F clear water at sea level
3.2 foot horizontal offset with
3 inch suction pipe

REPRIMING LIFTS
650 rpm 5 feet - 750 rpm 6 feet
850 rpm 8 feet - 950 rpm 10 feet
1050 rpm 13 feet - 1150 rpm 16 feet
1250 rpm 18 feet - 1350 rpm 19 feet
1450 rpm 21 feet - 1550 rpm 20 feet
1650 rpm 22 feet - 1750 rpm 22 feet
1850 rpm 25 feet - 1950 rpm 24 feet
2050 rpm 25 feet - 2150 rpm 25 feet
Figure NSPH required prior to using
above table. DO NOT use as avail-
able Suction Lifts.

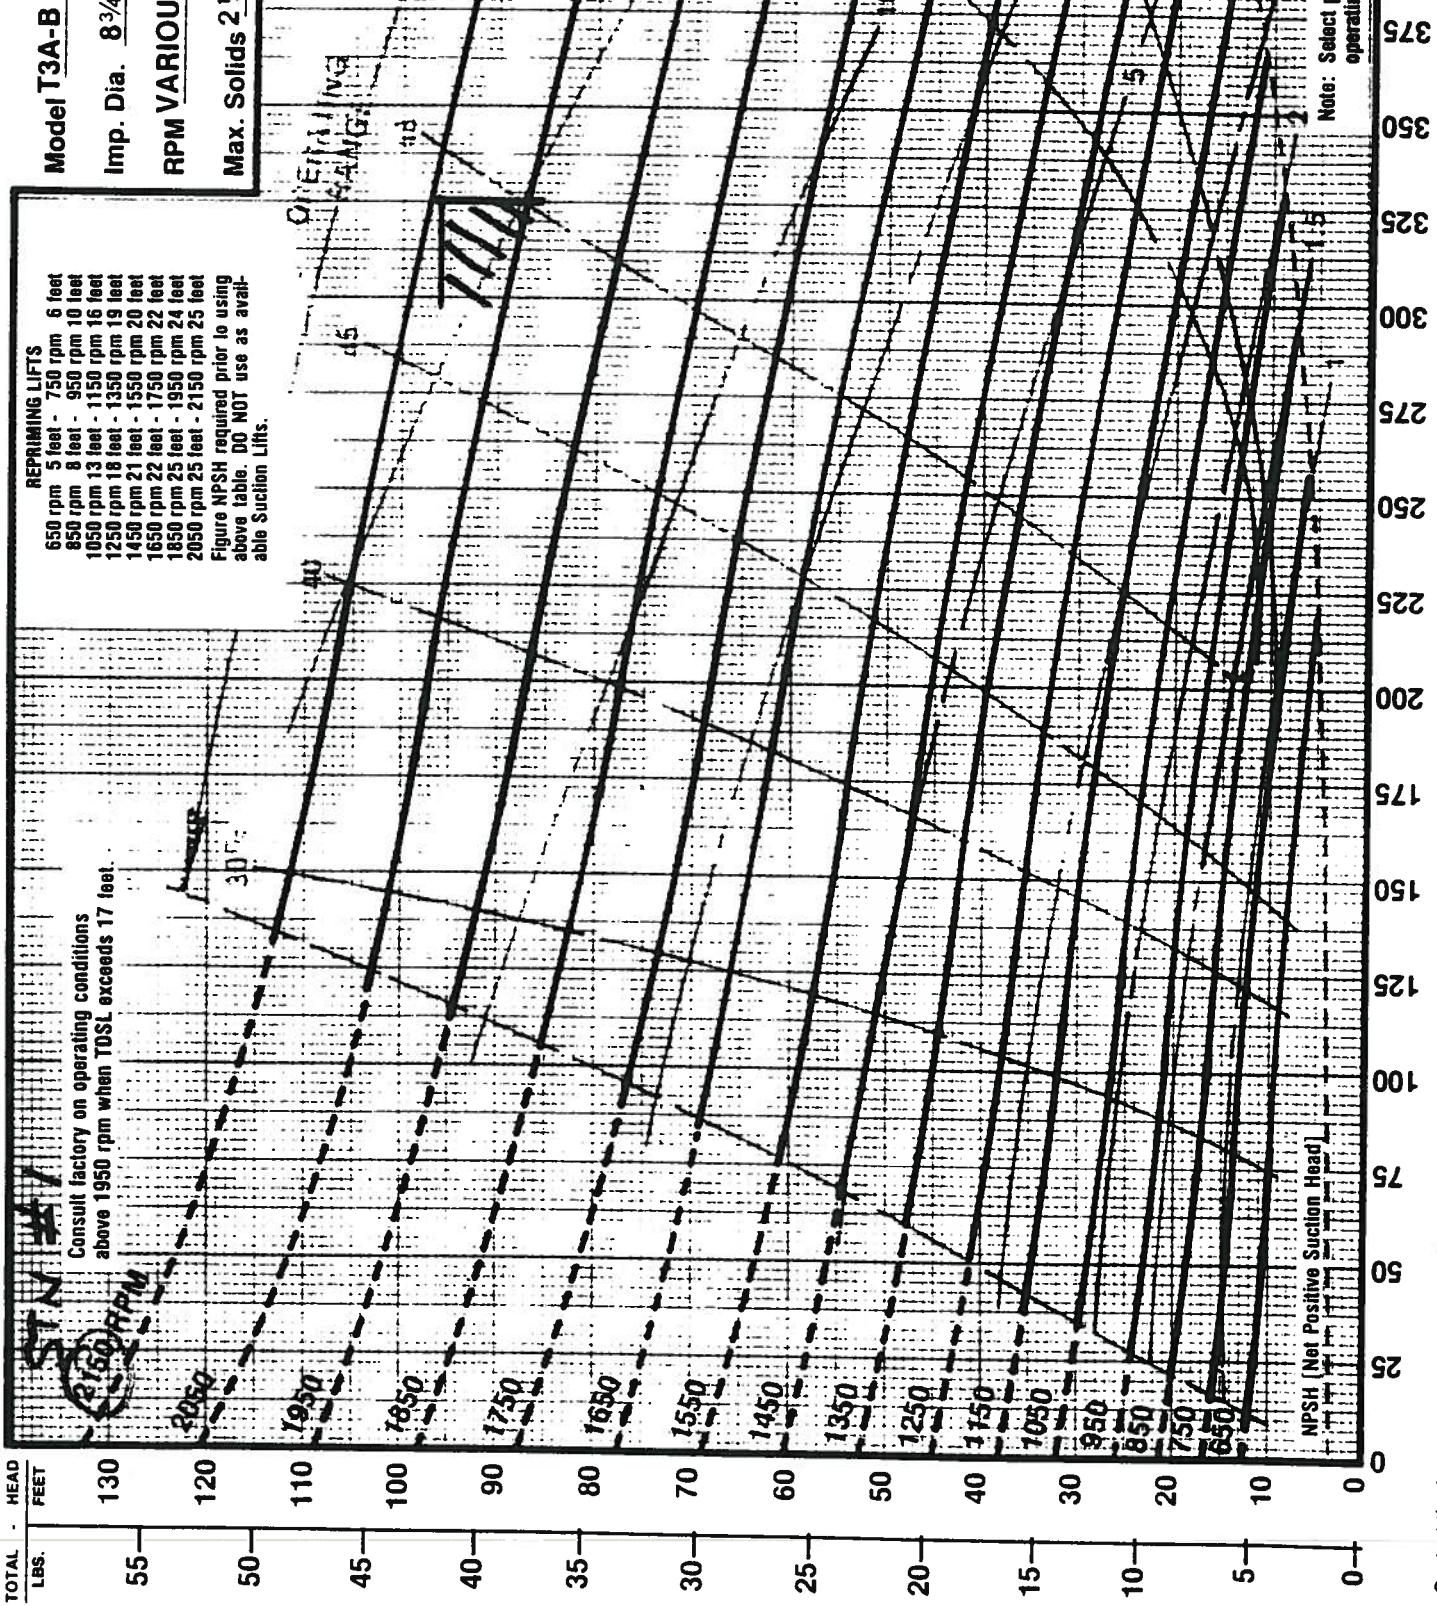

Contact the factory on special applications or applications
exceeding normal or other performance limitations indicated

11.5 GALLONS PER MINUTE



District of West Kelowna

Sanitary Lift Station Evaluation

Station: Somerset Court LS 17
Inspection By: Jim Kentel

Year Constructed: 11/1/2006
Year Upgraded:

Matrix Rating		
(10 - highest rating)	Civil	31
(1 - lowest rating)	Process Mechanical	84
	Electrical Instrumentation	85
	Total Station Rating	200 (max. rating 370 points)



Civil:Matrix
Rating

Parking Area:	_____	n/a
Drainage:	_____	10
Influent sewer:	2-200; 150; 4-100	10
Site access:	_____	10
Water service:	_____	1
		31







Process Mechanical:Matrix
Rating

Station type:	Concrete MH - 1.8m Submersible	n/a
Number of pumps:	2	n/a
Pump Redundancy:	Yes	n/a
Pump Manufacturer / Type:	FLYGT-Grinder	8
Pump Model:	MF 3085	n/a
Rated Capacity:	2.7 L/S @ 19.0m TDH	n/a
Capacity Confirmation:	_____	n/a
Forcemain pipe type / diameter:	PVC SDR 26 / 50	10
Header pipe type / diameter:	Rubber Hose / 50	1
Check valve type / diameter:	SS Check / 38	10
Isolation valve type / diameter:	SS Ball / 38	10
Piping Condition:	Good	8
Emergency pumpout connection:	No Flush out connection	1
Pressure gauges:	No	1
Inlet bar screen:	No	1
Wetwell condition:	_____	5
Access Hatches:	MH Frame and Cover	5
Ladder / Platform:	Rungs / no platform	3
Wetwell benching:	Sulfate resistant concrete	8
Odour Control:	No	1
Ventilation:	No	1
Water washdown:	38mm	10
Confined Space Entry Requirements	No	1
		84

Electrical / Instrumentation:

Matrix
Rating

Service Type	V / A / Phase / Wire	n/a
Pump 1 :	HP 3.0	n/a
	Volts 230 Rpm 3520	n/a
	FLA 13.0A	n/a
Starting Current		n/a
Pump 2 :	HP 3.0	n/a
	Volts 230 Rpm 3520	n/a
	FLA 13.0A	n/a
Starting Current		n/a
Alarm Functions:	Level control	5
		n/a
		n/a
		n/a
Receptacle	No	1
Interior Lighting:	No	1
Exterior Lighting:	No	1
SCADA / Telemetry:		5
Main Breaker:		10
Control Panel:		10
Lighting Panel:		10
Flowmeter:	No	1
Grounding:		10
UPS:		10
PLC:		10
Level Control:	Milltronics/Float Bulbs	10
Standby Generator:	No	1
		85
Comments:		

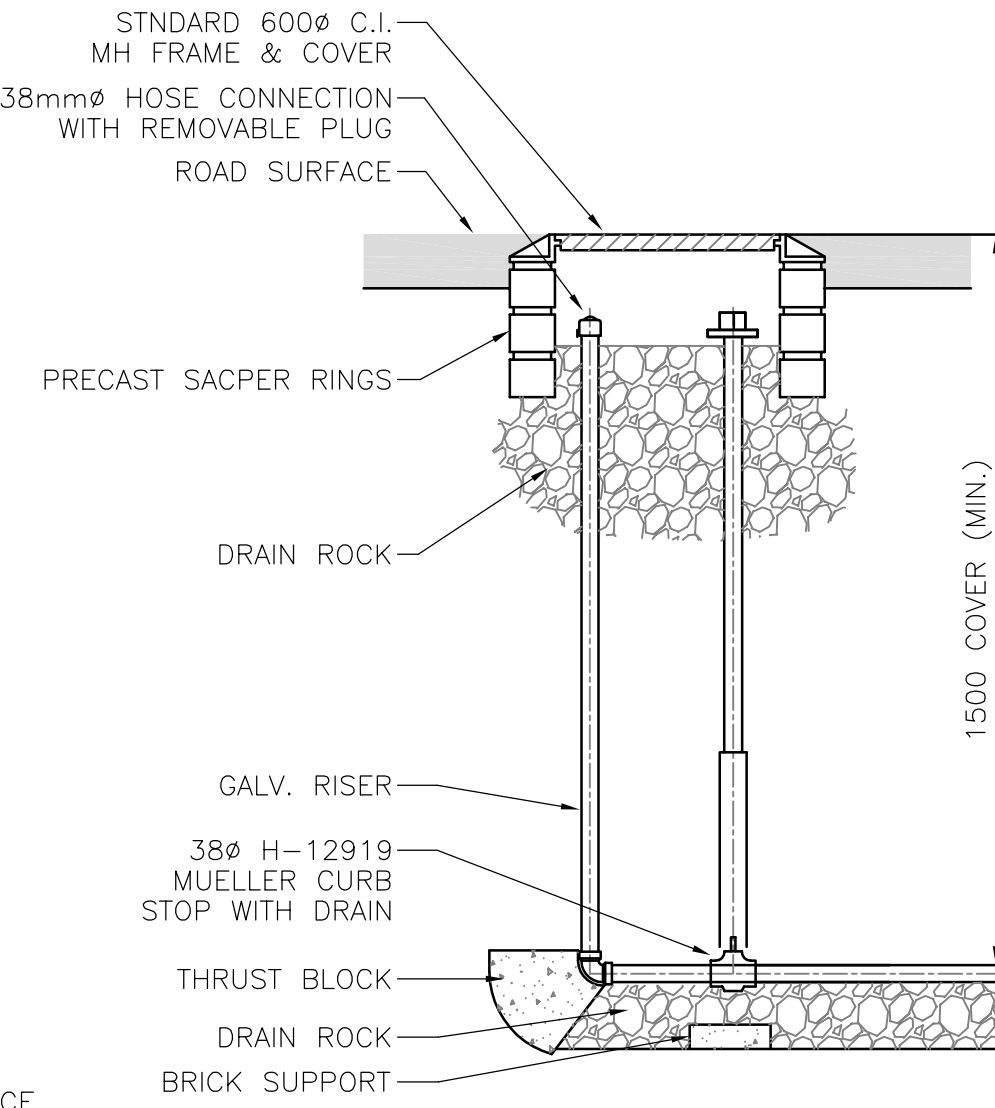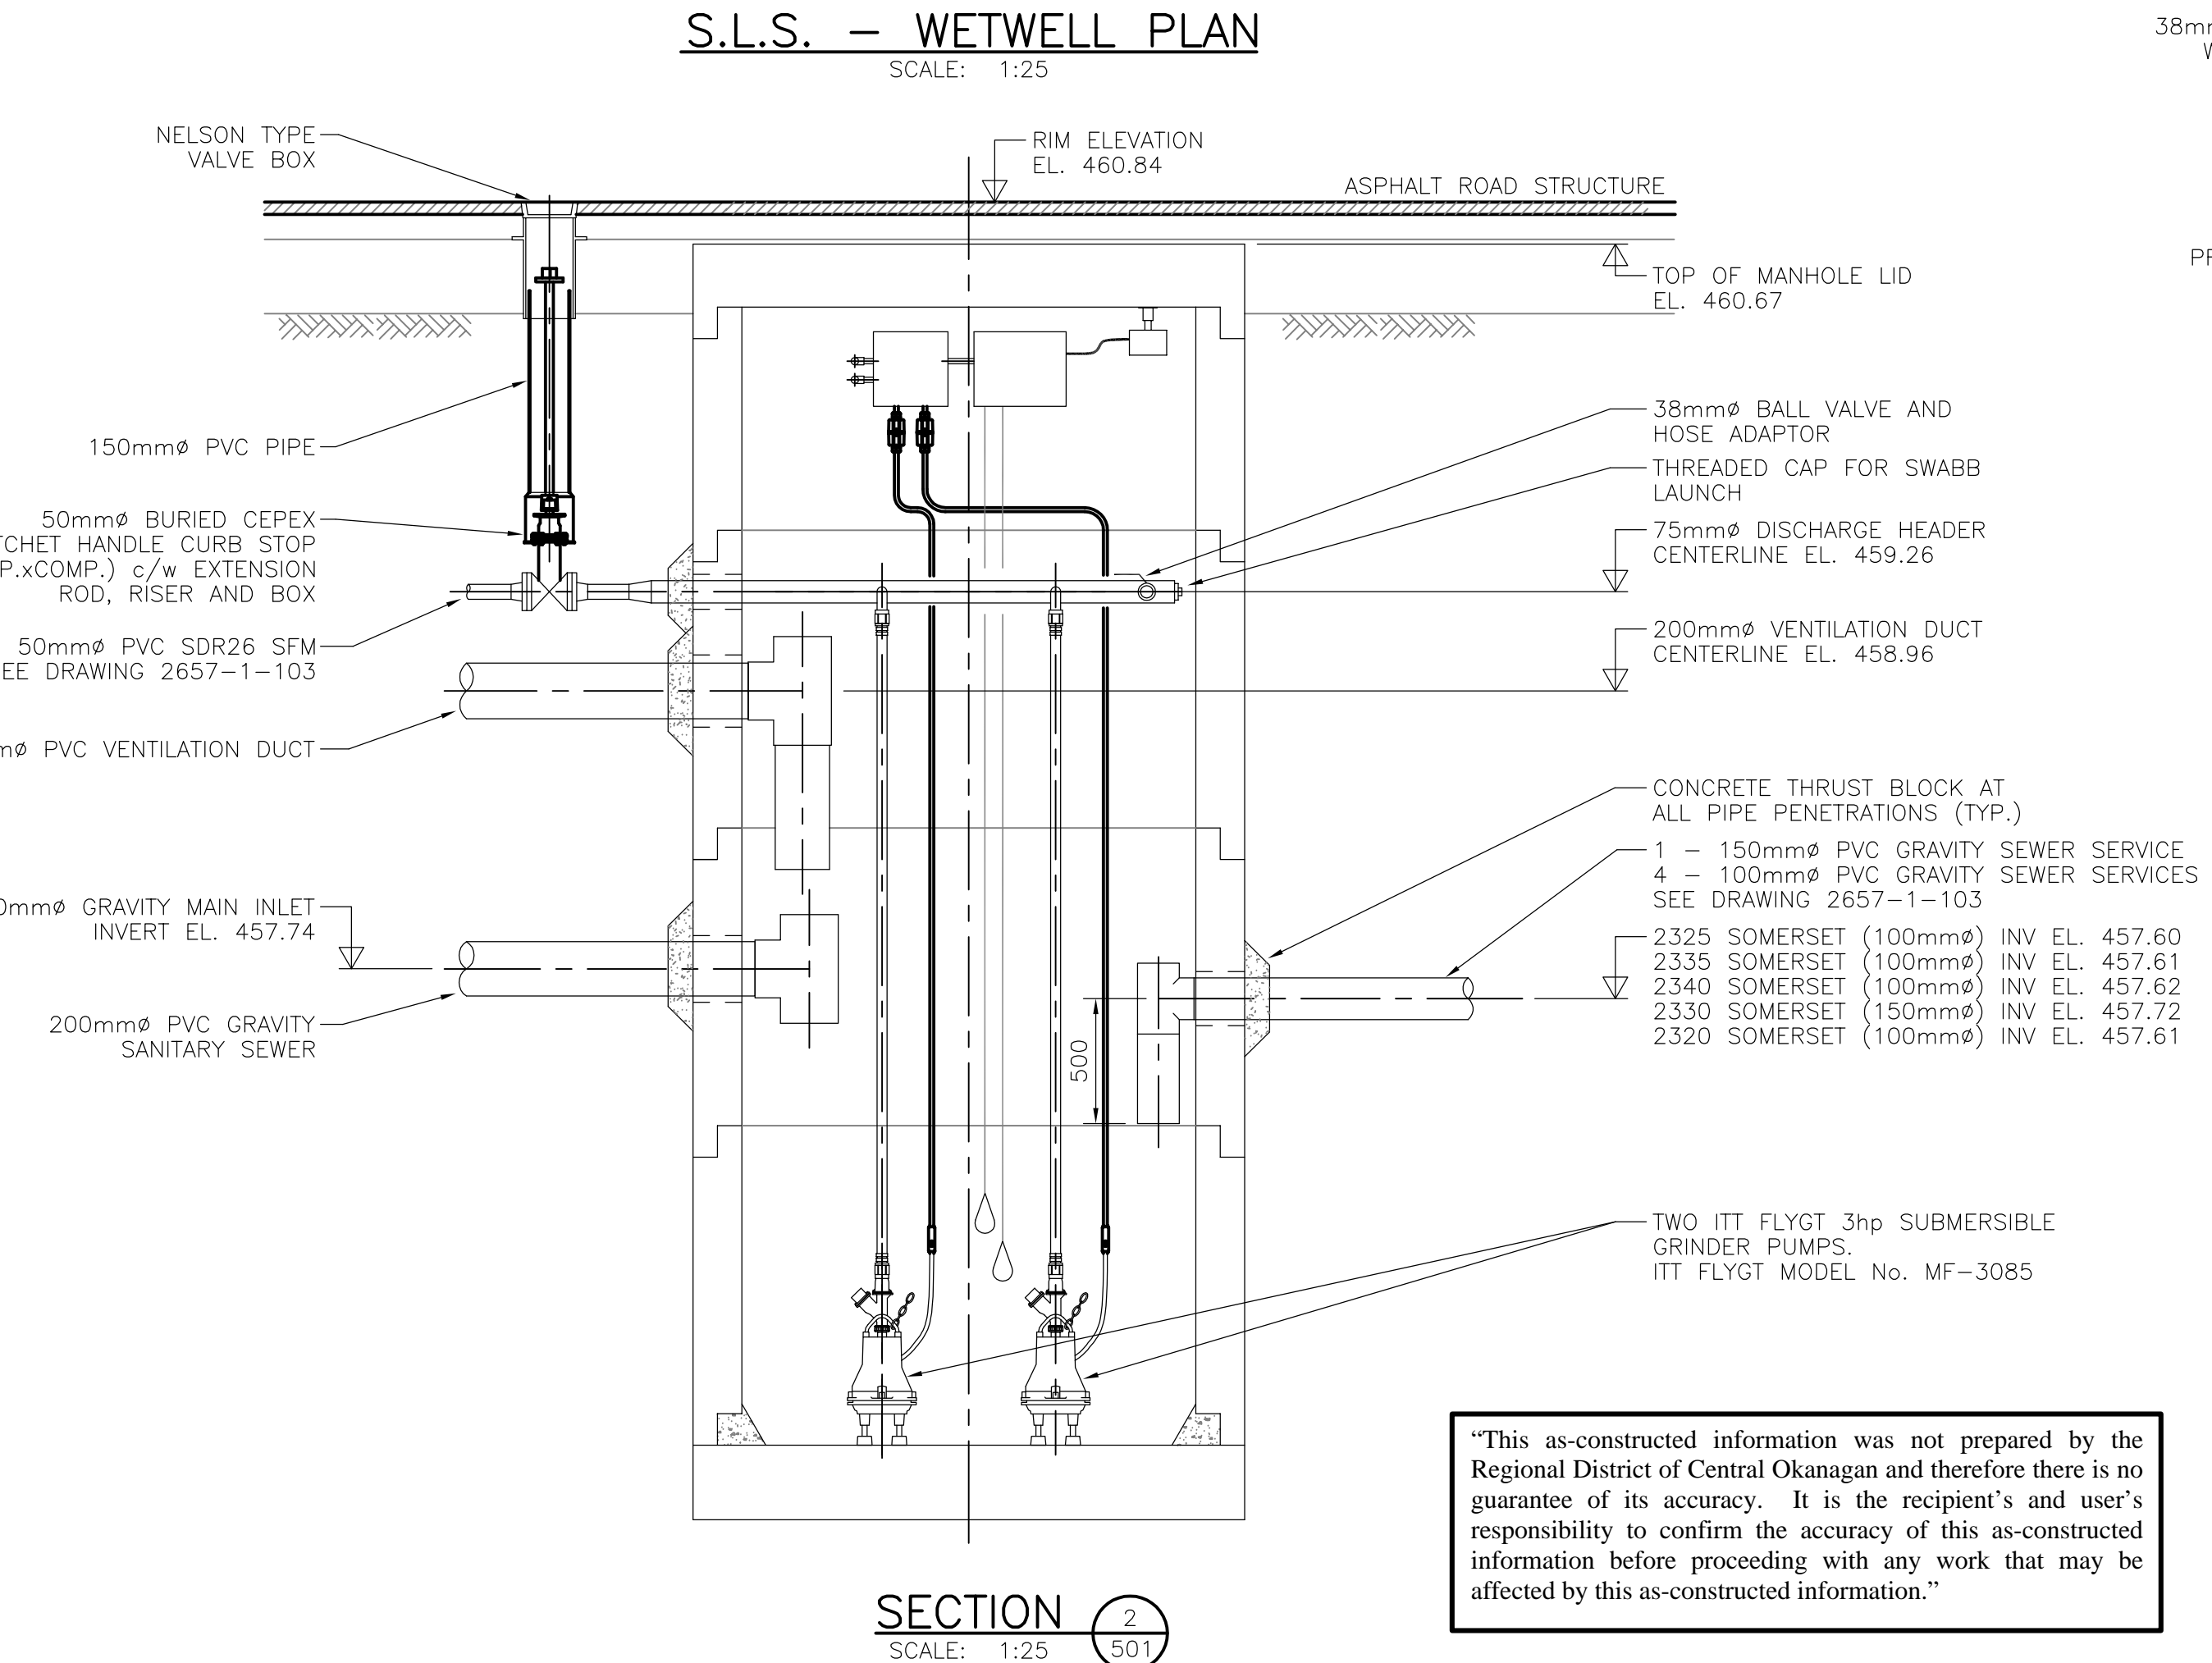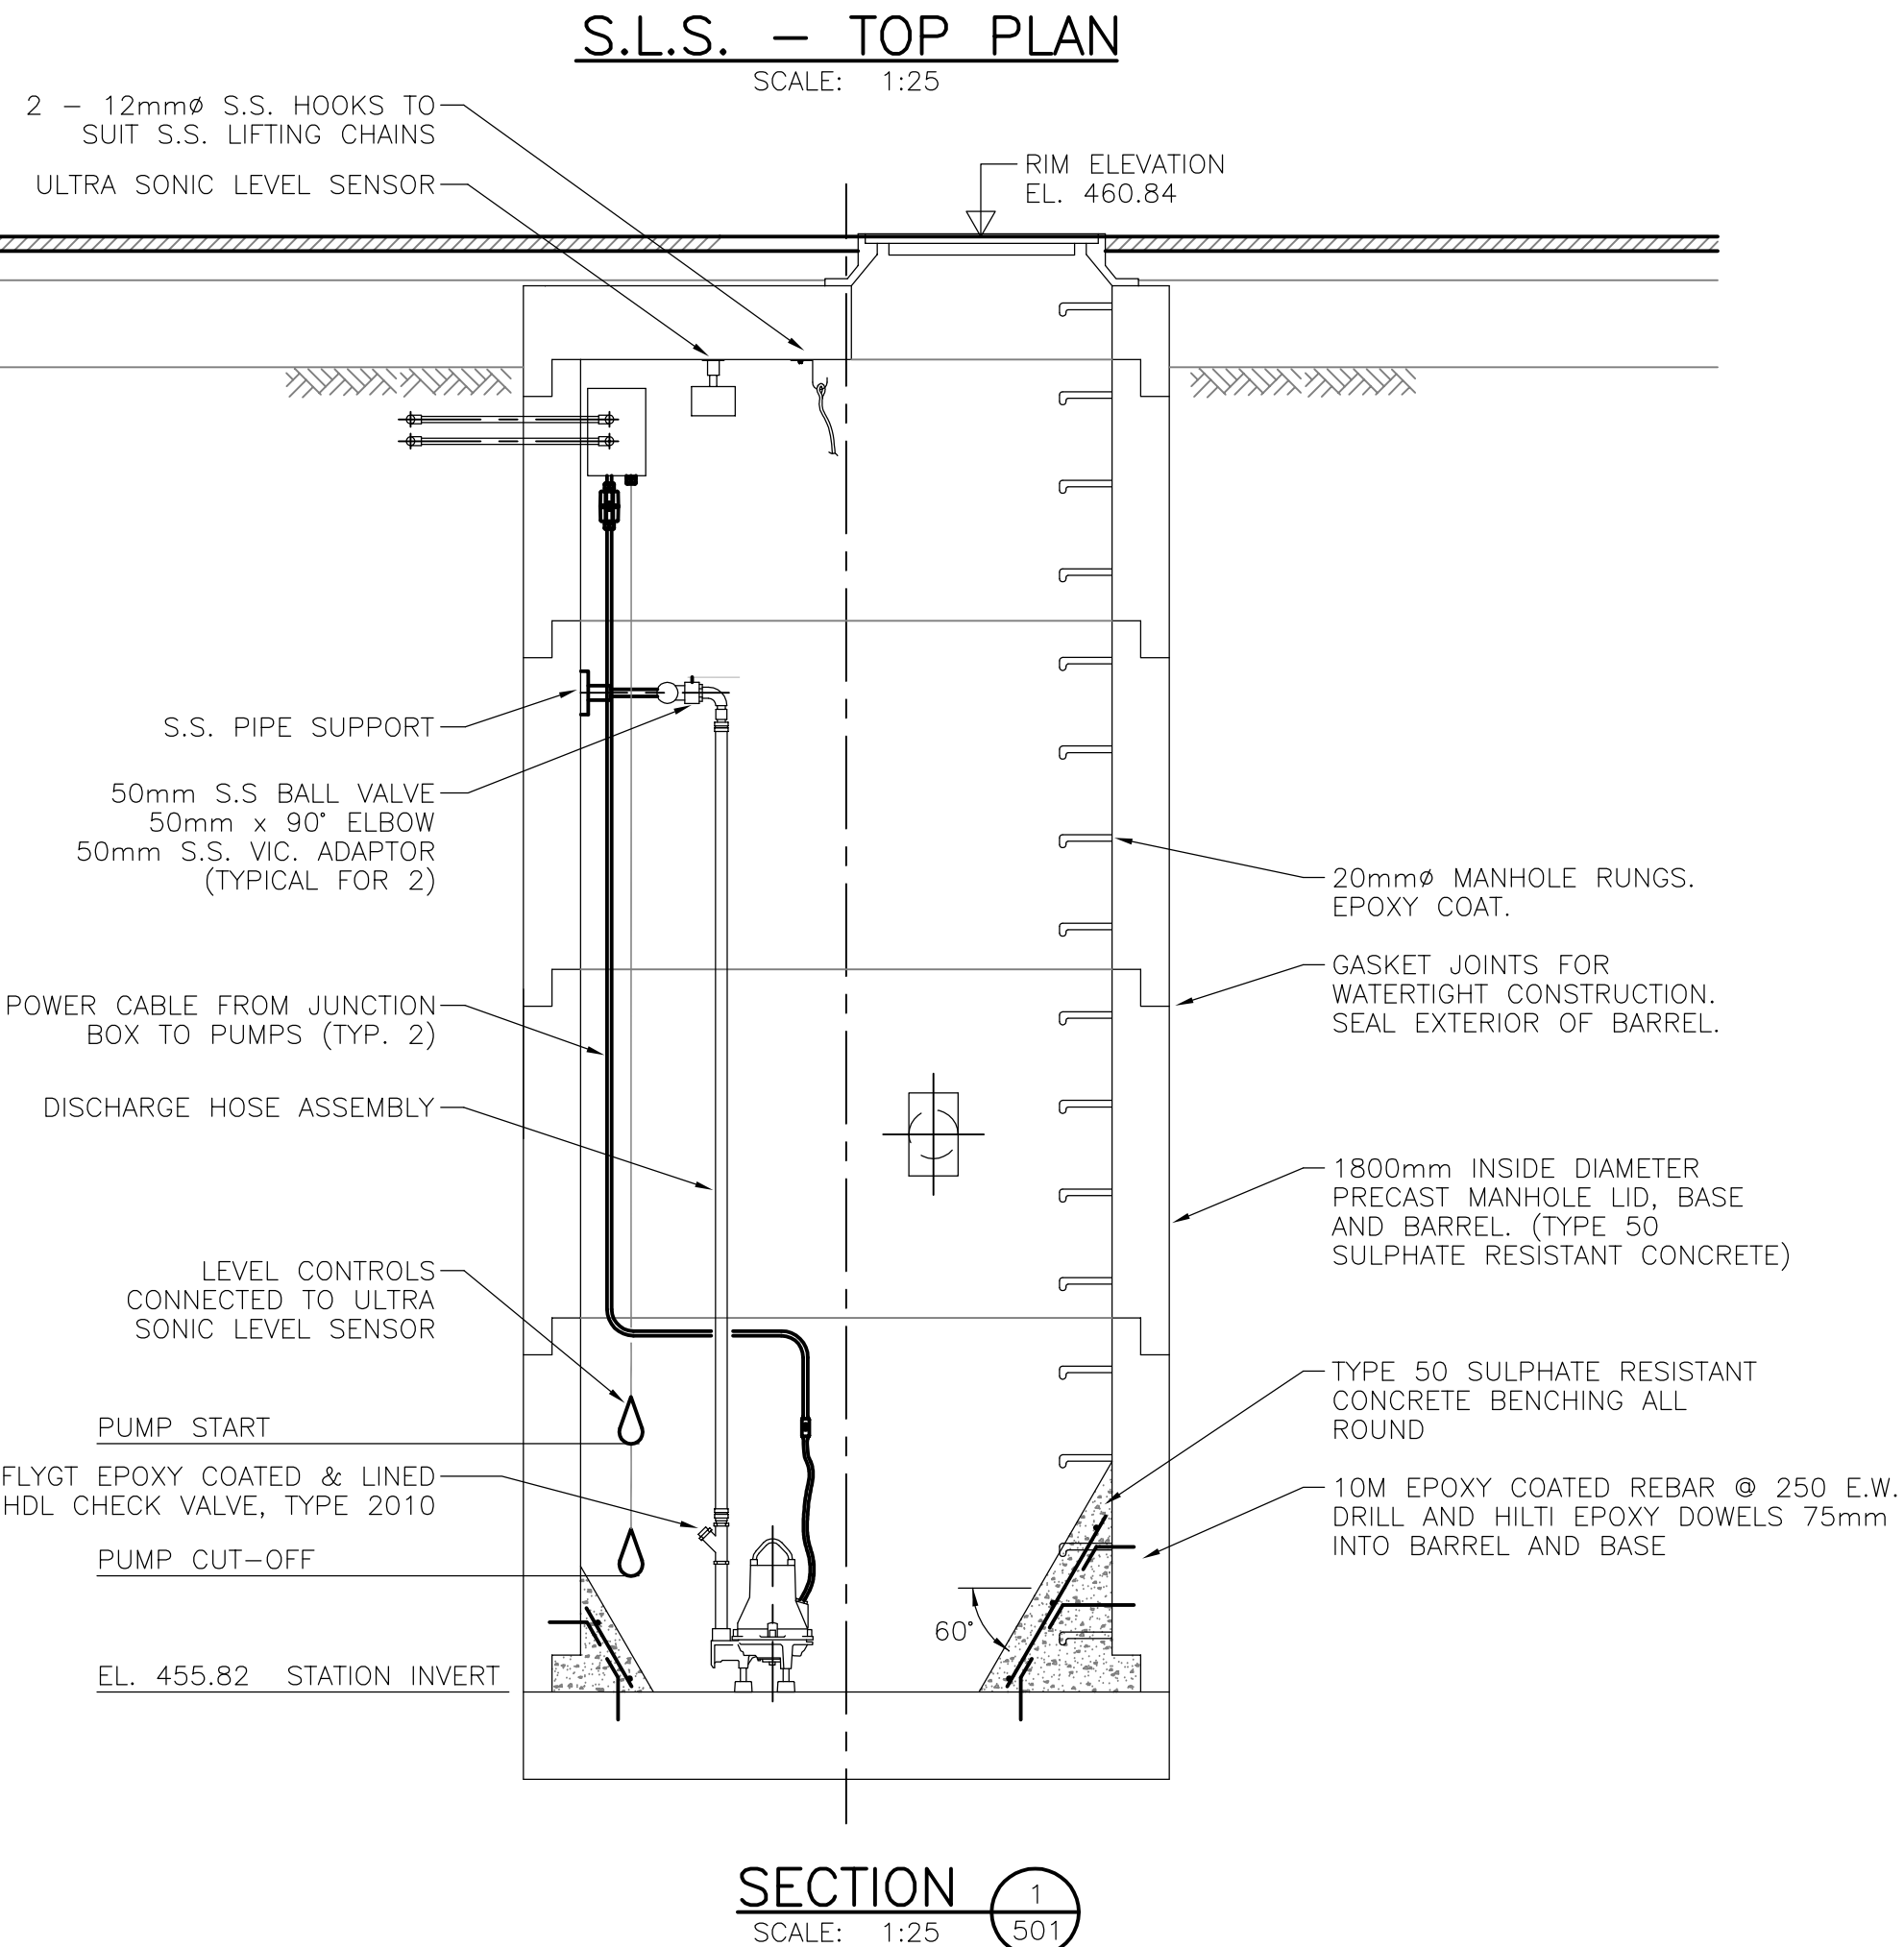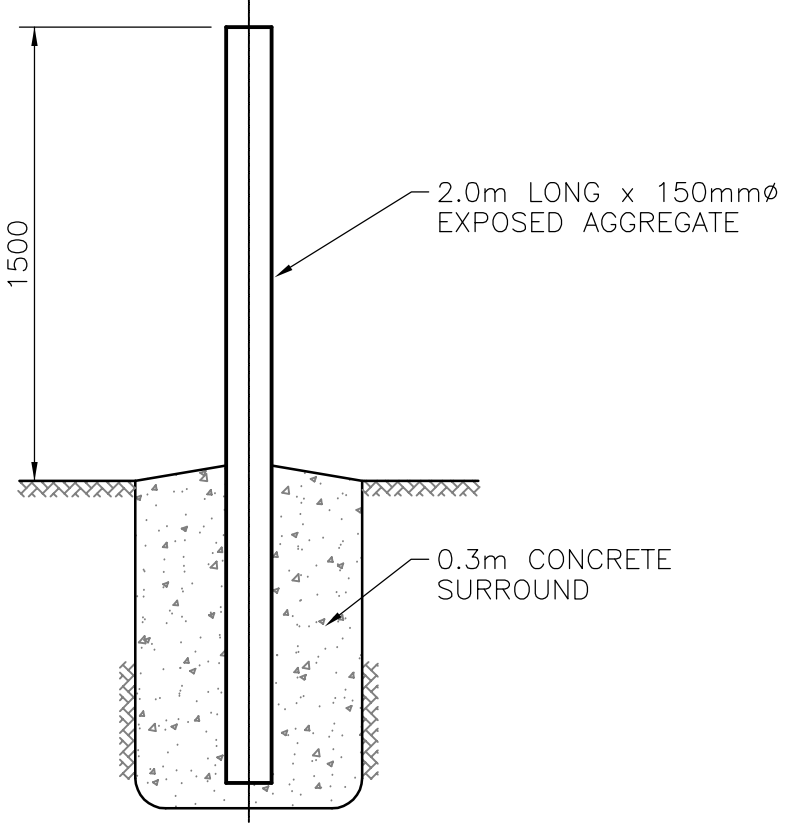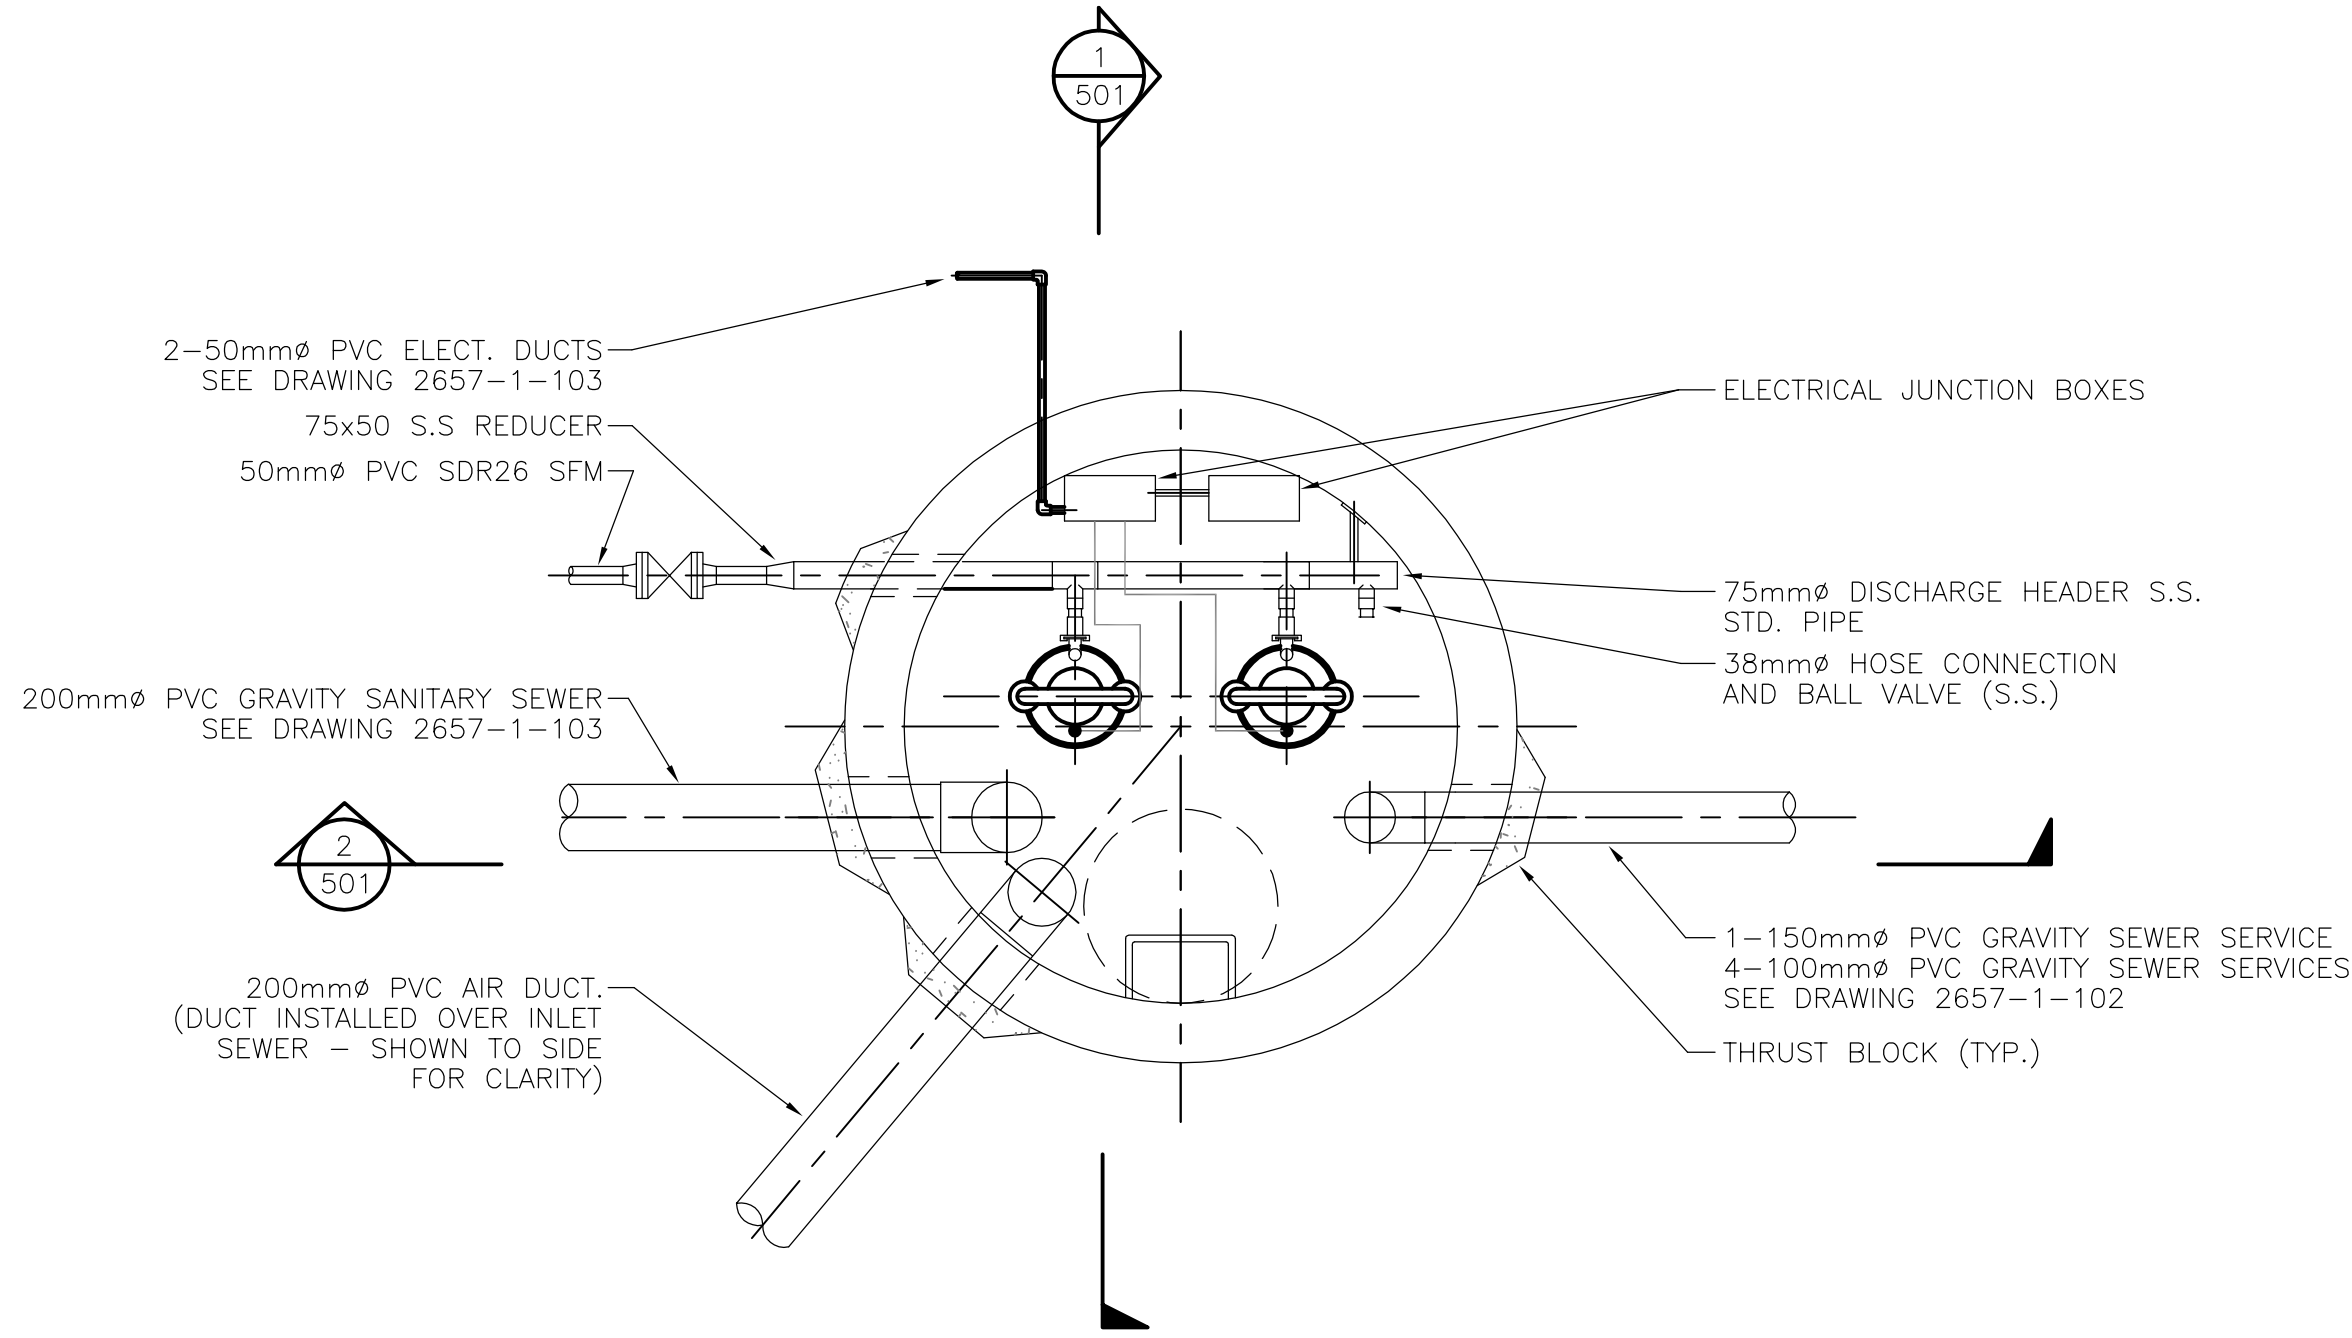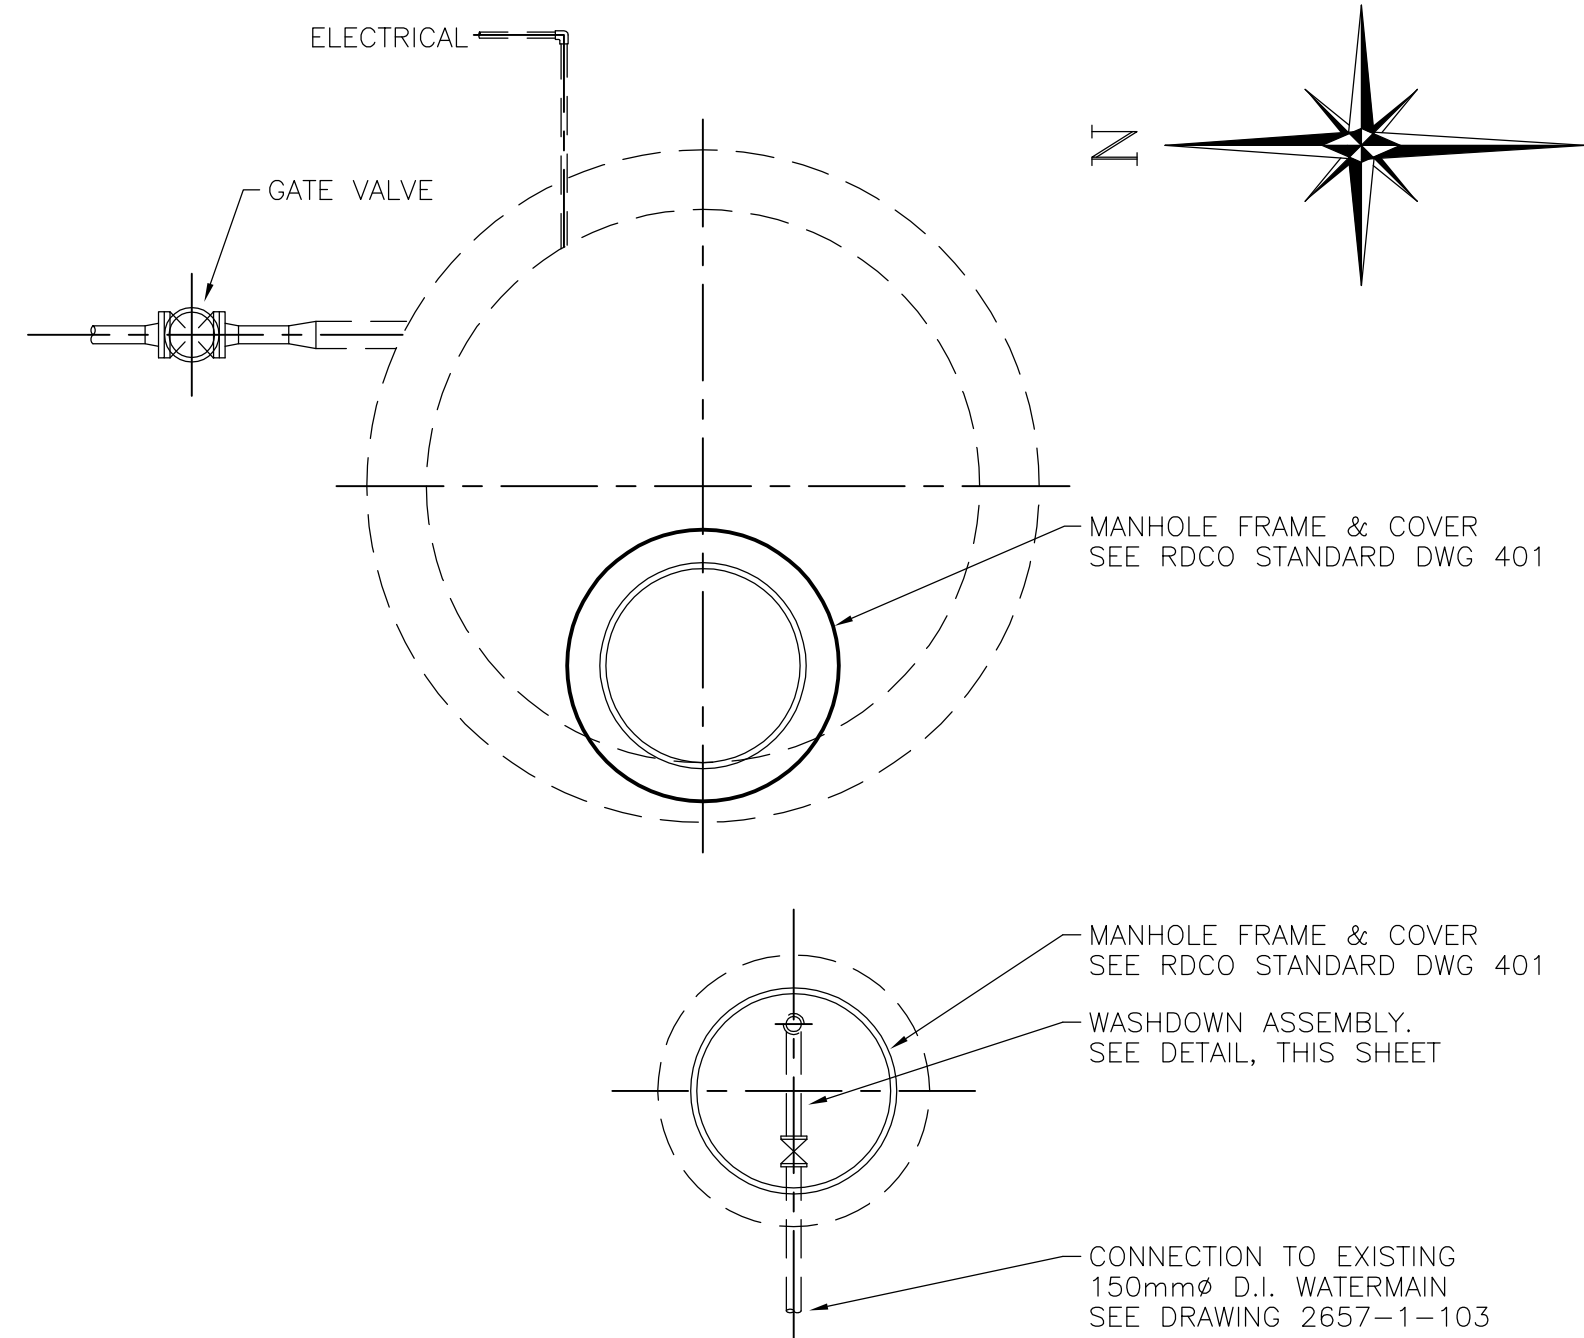

"This as-constructed information was not prepared by the Regional District of Central Okanagan and therefore there is no guarantee of its accuracy. It is the recipient's and user's responsibility to confirm the accuracy of this as-constructed information before proceeding with any work that may be affected by this as-constructed information."

NOTES:
ALL LOCATIONS OF EXISTING UTILITIES SHOWN ARE APPROXIMATE ONLY. ALL OR ANY EXISTING STRUCTURES NOT NECESSARILY SHOWN.
ELEVATIONS ARE TO GEODETIC DATUM.
CONDUIT FOR POWER & TELEMETRY AS DIRECTED BY R.D.C.O. PUBLIC WORKS, B.C. HYDRO AND APPROVED BY THE CONTRACT ADMINISTRATOR
COORDINATED SUPPLY AND INSTALLATION OF ALL ELECTRICAL/CONTROLS EQUIPMENT WITH R.D.C.O. PUBLIC WORKS.

No.	MM/DD/YY DATE	BY	REVISION	Chk'd	No.	MM/DD/YY DATE	BY	REVISION	Chk'd
D	02/12/07	JB	REVISIONS PER RDCC COMMENTS	DRG					
C	01/05/07	JB	RECORD DRAWING	DRG					
B	05/05/06	JB	ISSUED FOR CONSTRUCTION	DRG					
A	02/24/06	BC	ISSUED FOR TENDER	DRG					



P.ENG.	
DRAWN:	B. CRANNA
DESIGN:	B. CRANNA
APPROVED:	D. GREER
DATE:	02/24/06
SCALE:	AS NOTED

Associated Engineering
Suite 420
1628 Dickson Avenue
Kelowna, B.C. V1Y 3X1
Tel: (250) 763-3638
Fax: (250) 763-8880

**AREA 701 - STAGE 3, LAKEVIEW PHASE 4
SANITARY SEWER PROJECT
SOMERSET CT. S.L.S. PLANS AND SECTIONS**

DRAWING NO.	2657-1-501
REV. NO.	D



TEST REPORT

SOMERSET COURT LS 17

PRODUCT

Serial No. 3085.172		0650390		Performance curve No. 61- 257-00-1460		Motor module/type 114		Voltage (V) 230	
Base module 062		Impeller No. 444 84 13		Gear type		Gear ratio		Imp.diam/Blade angle 143	
								Water temp °C 20	

TEST RESULTS

Pump total head H (m)	Volume rate of flow Q (l/s)	Motor input power P (kW)	Voltage U (V)	Current I (A)	Overall efficiency η (%)
34.12	0.06	1.93	224	8.8	0.98
33.11	0.40	1.97	225	9.0	6.64
30.97	1.16	2.14	224	9.8	16.42
30.97	1.16	2.15	224	9.8	16.43
30.47	1.30	2.17	224	9.9	17.90
27.04	2.05	2.43	224	11.1	22.33
18.98	2.68	2.68	223	12.3	18.60
18.96	2.68	2.68	223	12.3	18.62


Accepted after ISO9906/2	Test facility Lindas LC4 Sweden	Test date 06-08-29	Time 10:22	Chief tester 2055
-----------------------------	---------------------------------------	-----------------------	---------------	----------------------

ORDERNR 175834 POS 1

PLOTTED TEST RESULTS Measured point : + = Q/H Duty point : \diamond = Q/H
 X = Q/P \square = Q/P Calculated point : λ = Q/ETA overall
 \triangle = Q/ETA overall 6

TOTAL HEAD

INPUT POWER

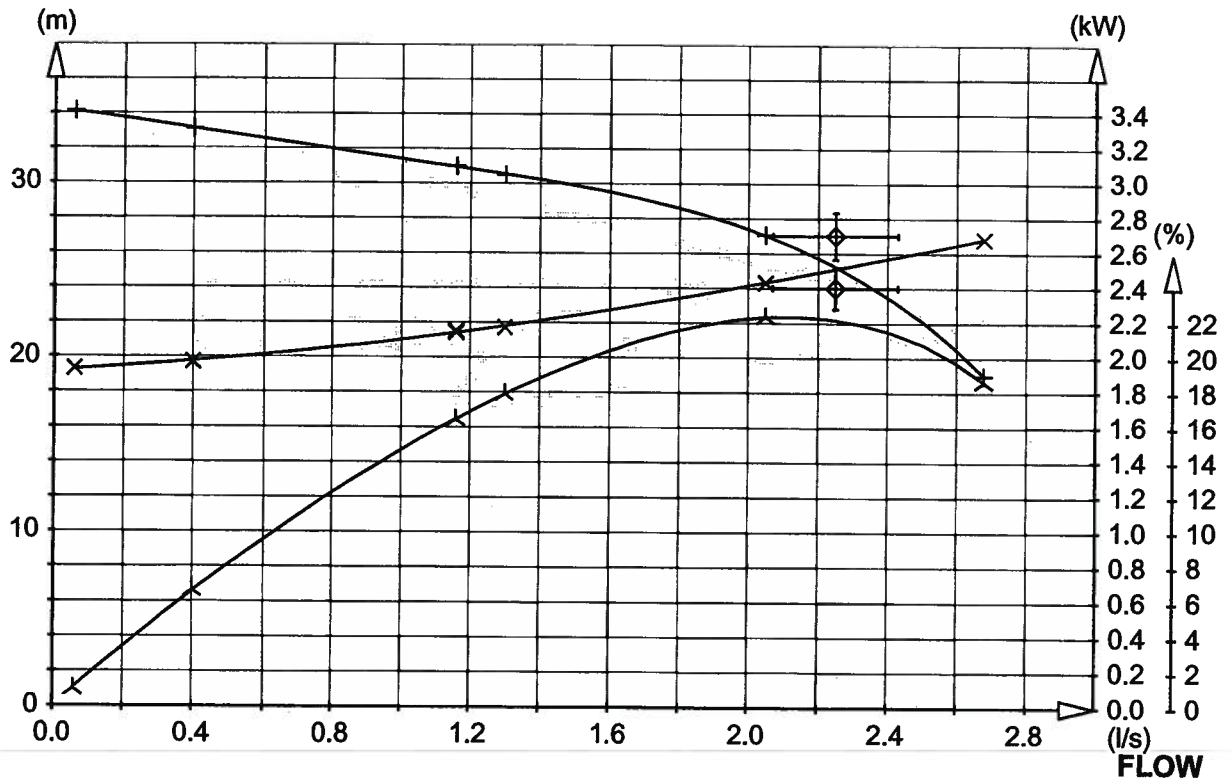



TEST REPORT

PRODUCT

Serial No. 3085.172		0650391		Performance curve No. 61- 257-00-1460		Motor module/type 114		Voltage (V) 230	
Base module 062		Impeller No. 444 84 13		Gear type		Gear ratio		Imp.diam/Blade angle 143	
								Water temp °C 20	

TEST RESULTS

Pump total head H (m)	Volume rate of flow Q (l/s)	Motor input power P (kW)	Voltage U (V)	Current I (A)	Overall efficiency η (%)
33.69	0.04	2.19	223	10.0	0.66
32.54	0.41	2.24	223	10.2	5.86
30.21	1.18	2.40	224	10.9	14.56
30.21	1.18	2.40	224	11.0	14.54
29.67	1.31	2.42	224	11.0	15.73
26.56	2.04	2.70	223	12.4	19.72
18.44	2.68	2.97	222	13.6	16.30
18.40	2.68	2.97	222	13.6	16.30


Accepted after ISO9906/2	Test facility Lindas LC4 Sweden	Test date 06-08-29	Time 10:34	Chief tester 2055
-----------------------------	---------------------------------------	-----------------------	---------------	----------------------

ORDERNR 175834 POS 1

PLOTTED TEST RESULTS Measured point : + = Q/H Duty point : \diamond = Q/H
 X = Q/P \square = Q/P Calculated point : \wedge = Q/ETA overall
 \triangle = Q/ETA overall 6

TOTAL HEAD

INPUT POWER

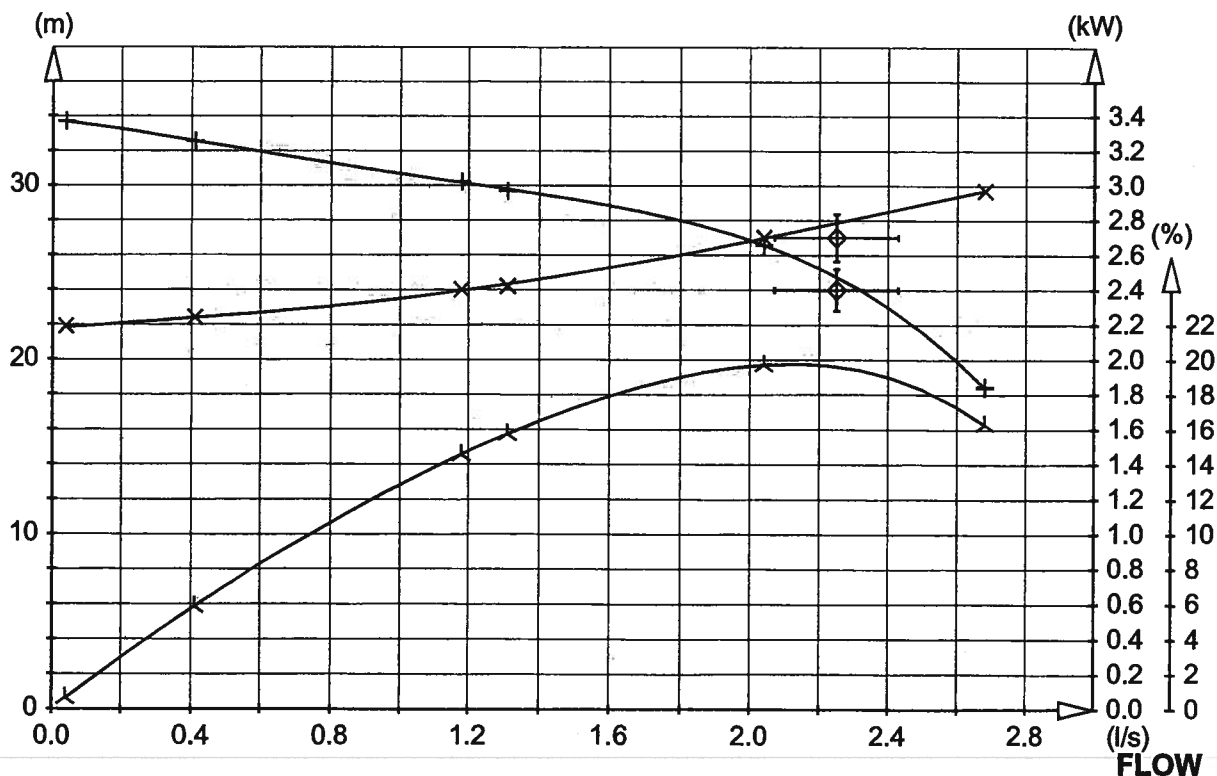



District of West Kelowna

Sanitary Lift Station Evaluation

Station: Devon Court LS 18
Inspection By: Jim Kentel

Year Constructed: 10/1/2006
Year Upgraded:

Matrix Rating
(10 - highest rating)
(1 - lowest rating)

	Civil	40
	Process Mechanical	84
	Electrical Instrumentation	103
	Total Station Rating	227 (max. rating 370 points)



Civil:

	<u>Matrix Rating</u>
Parking Area:	n/a
Drainage: Good	10
Influent sewer: 2-150mm, 2-100mm, 1-200mm	10
Site access: Off road	10
Water service: Yes	10
	40



Process Mechanical:

	<u>Matrix Rating</u>
Station type: Concrete 1.8 MH	n/a
Number of pumps: 2	n/a
Pump Redundancy: Yes	n/a
Pump Manufacturer / Type: FLYGT Grinder	5
Pump Model: MF 3085	n/a
Rated Capacity: 2.7m L/S @ 19.3m TDH	n/a
Capacity Confirmation:	n/a
Discharge pipe type / diameter: PVC SDR 26 / 50	10
Header pipe type / diameter: Rubber Hose/50	1
Check valve type / diameter: /50	1
Isolation valve type / diameter: SS Ball / 50	10
Piping Condition:	1
Emergency pumpout connection: No	1
Pressure gauges: No	1
Inlet bar screen: No	1
Wetwell condition: Good	10
Access Hatches: MH Frame and cover	8
Ladder / Platform: Rungs/ No Platform	5
Wetwell benching: Sulphate resistant concrete	8
Odour Control: No	1
Ventilation: Yes	10
Water washdown: Yes	10
Confined Space Entry Requirements: No	1
	84


Electrical / Instrumentation:

**Matrix
Rating**

Service Type	V / A / Phase / Wire	n/a
Pump 1 :	HP 3.0	n/a
	Volts 230 Rpm 3520	n/a
	FLA 13.0A	n/a
Starting Current		n/a
Pump 2 :	HP 3.0	n/a
	Volts 230 Rpm 3520	n/a
	FLA 13.0A	n/a
Starting Current		n/a
Alarm Functions:		n/a
		5
		n/a
		n/a
		n/a
Receptacles:	Yes	10
Interior Lighting:	Yes	10
Exterior Lighting:	No	1
SCADA / Telemetry:		5
Main Breaker:	100A	10
Control Panel:		10
Lighting Panel:		10
Flowmeter:	No	1
Grounding:		10
UPS:		10
PLC:		10
Level Control:	Ultrasonic/ Float Bulbs	10
Standby Generator:	No	1
		103
Comments:		

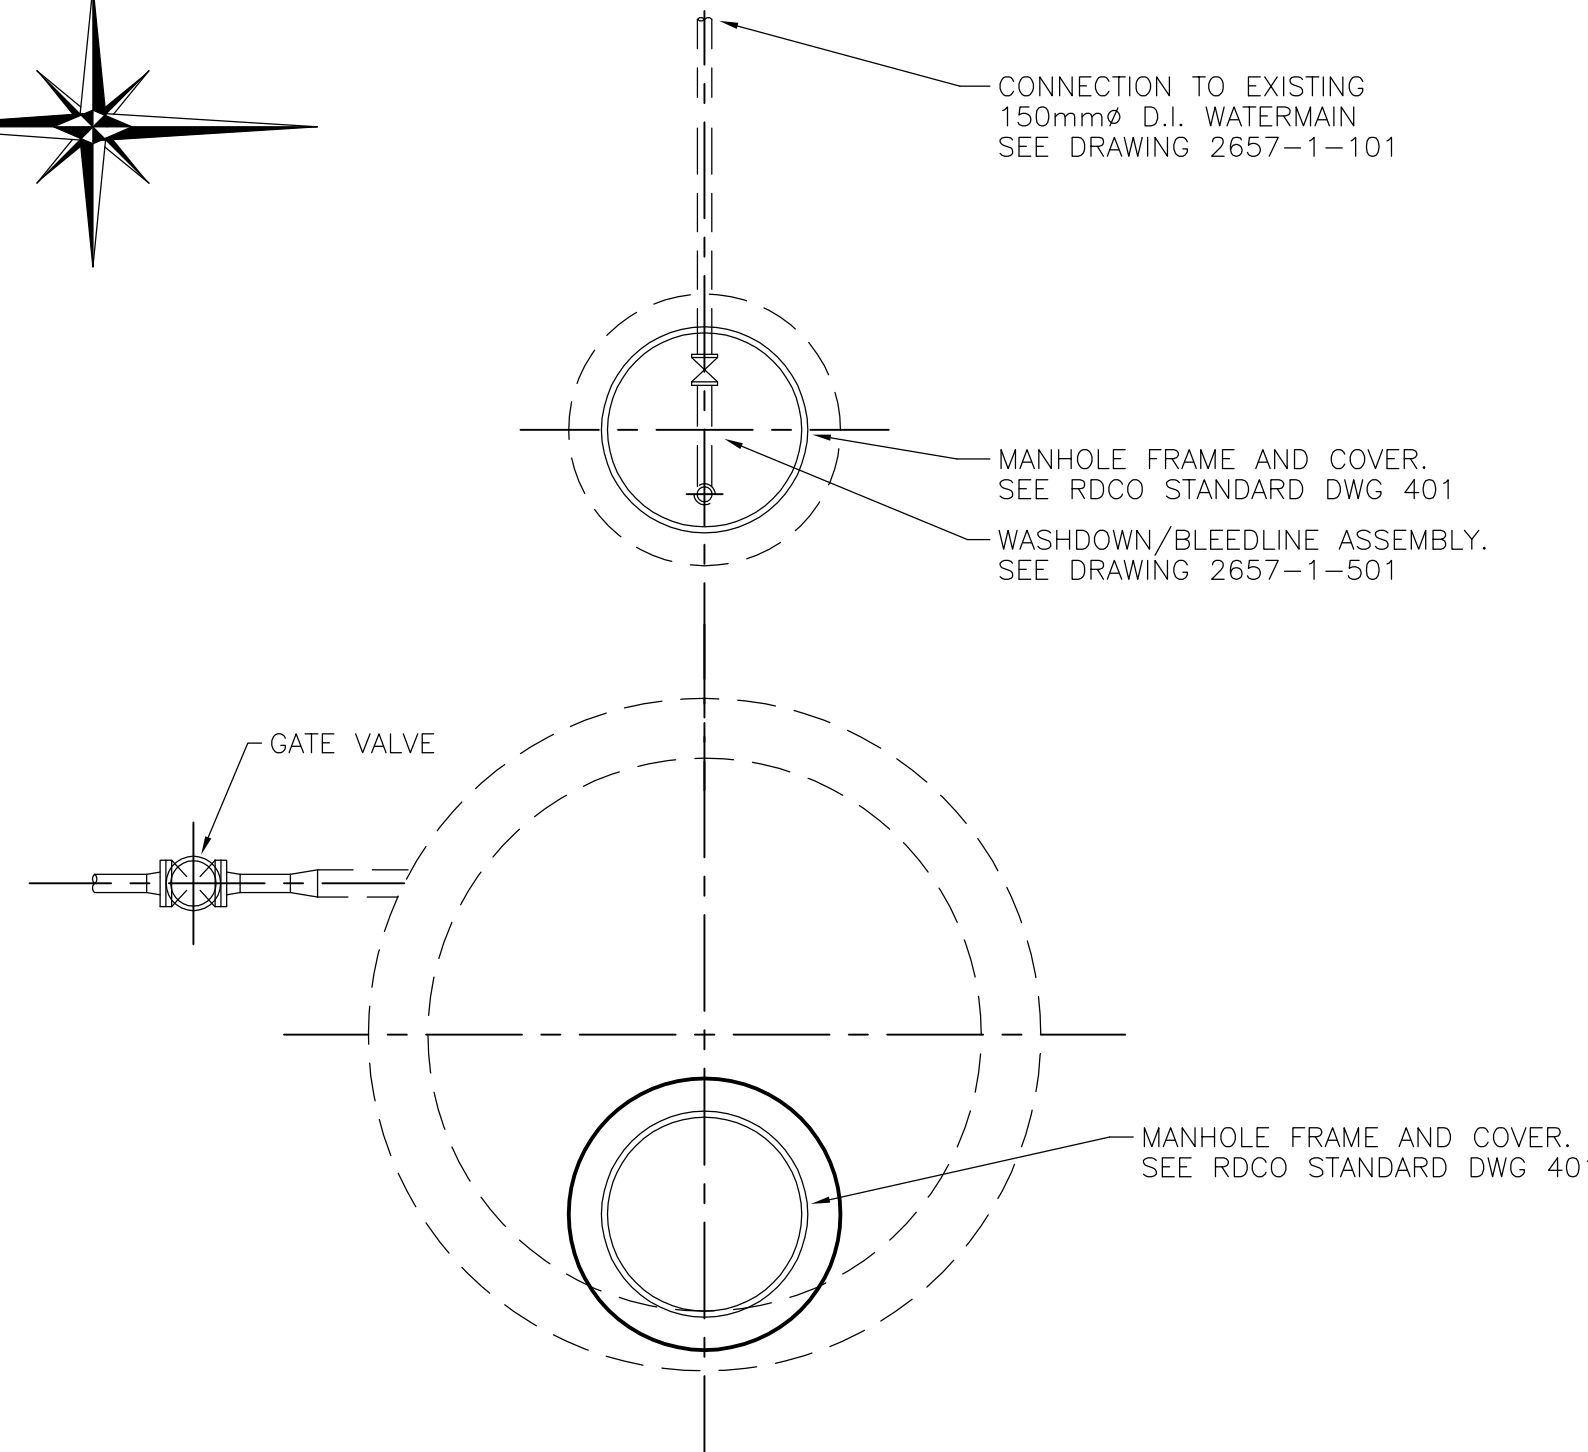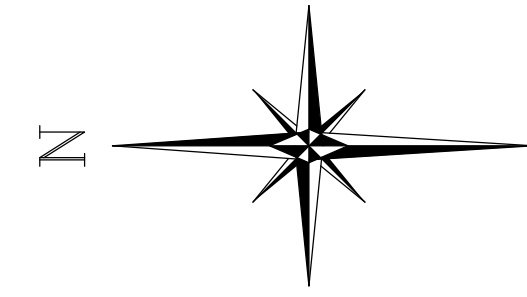

S.L.S. - TOP PLAN
SCALE: 1:25

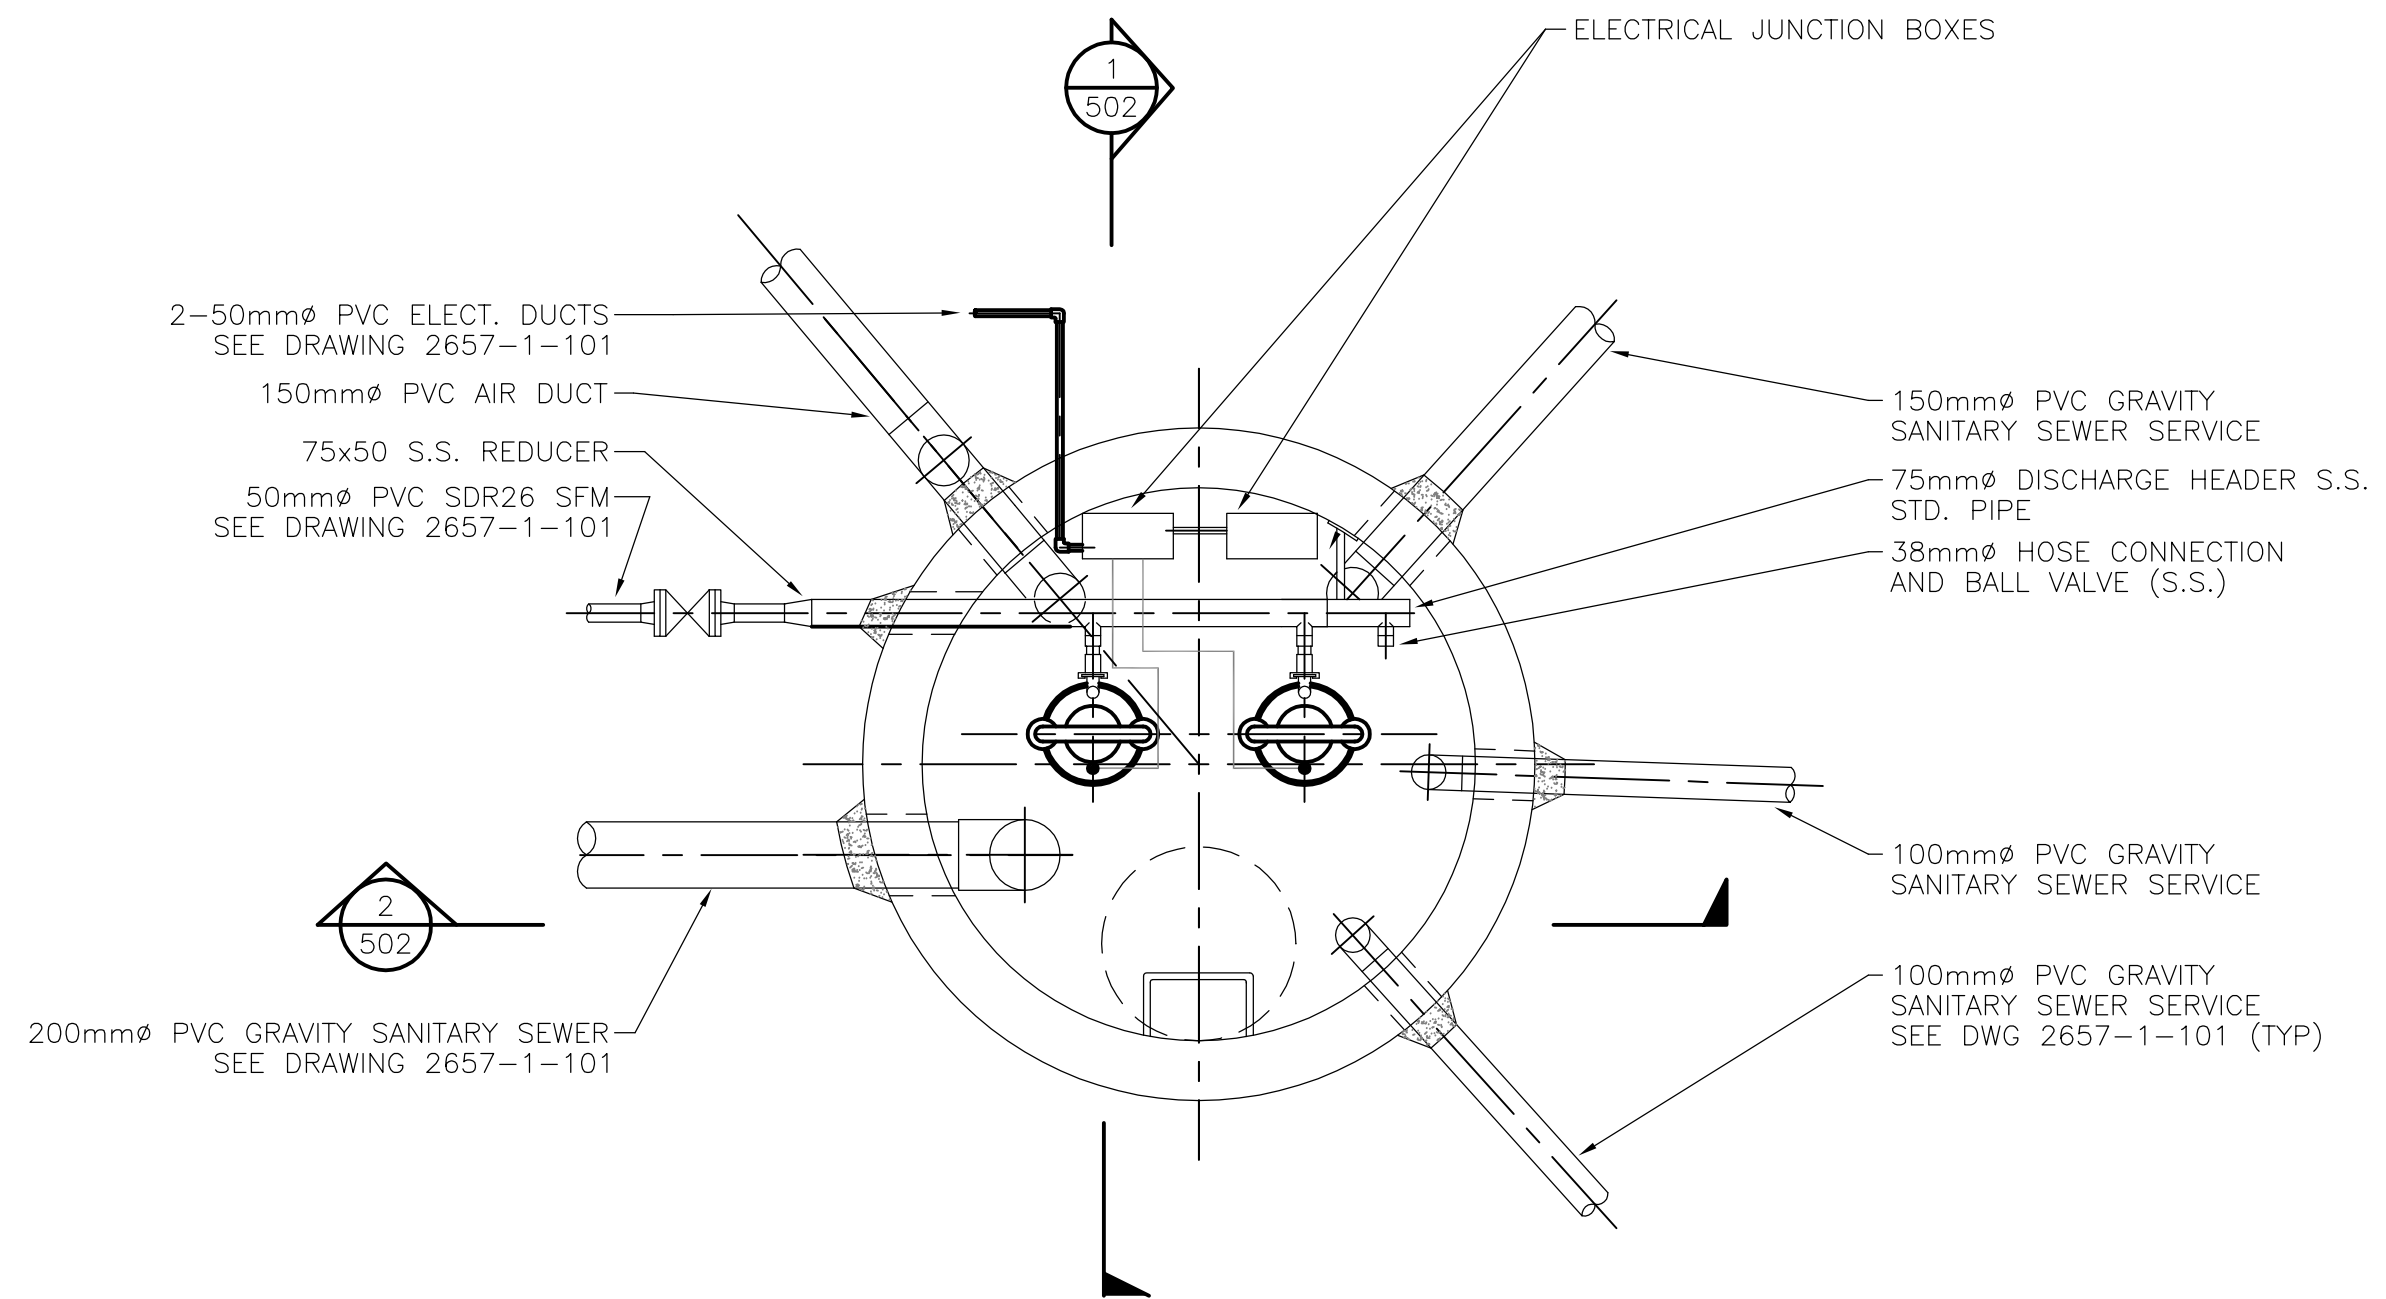

S.L.S. - WETWELL PLAN
SCALE: 1:25


NOTES:

ALL LOCATIONS OF EXISTING UTILITIES SHOWN ARE APPROXIMATE ONLY. ALL OR ANY EXISTING STRUCTURES NOT NECESSARILY SHOWN.


ELEVATIONS ARE TO GEODETIC DATUM.

CONDUIT FOR POWER & TELEMETRY AS DIRECTED BY R.D.C.O. PUBLIC WORKS, B.C. HYDRO AND APPROVED BY THE CONTRACT ADMINISTRATOR

COORDINATED SUPPLY AND INSTALLATION OF ALL ELECTRICAL/CONTROLS EQUIPMENT WITH R.D.C.O. PUBLIC WORKS.

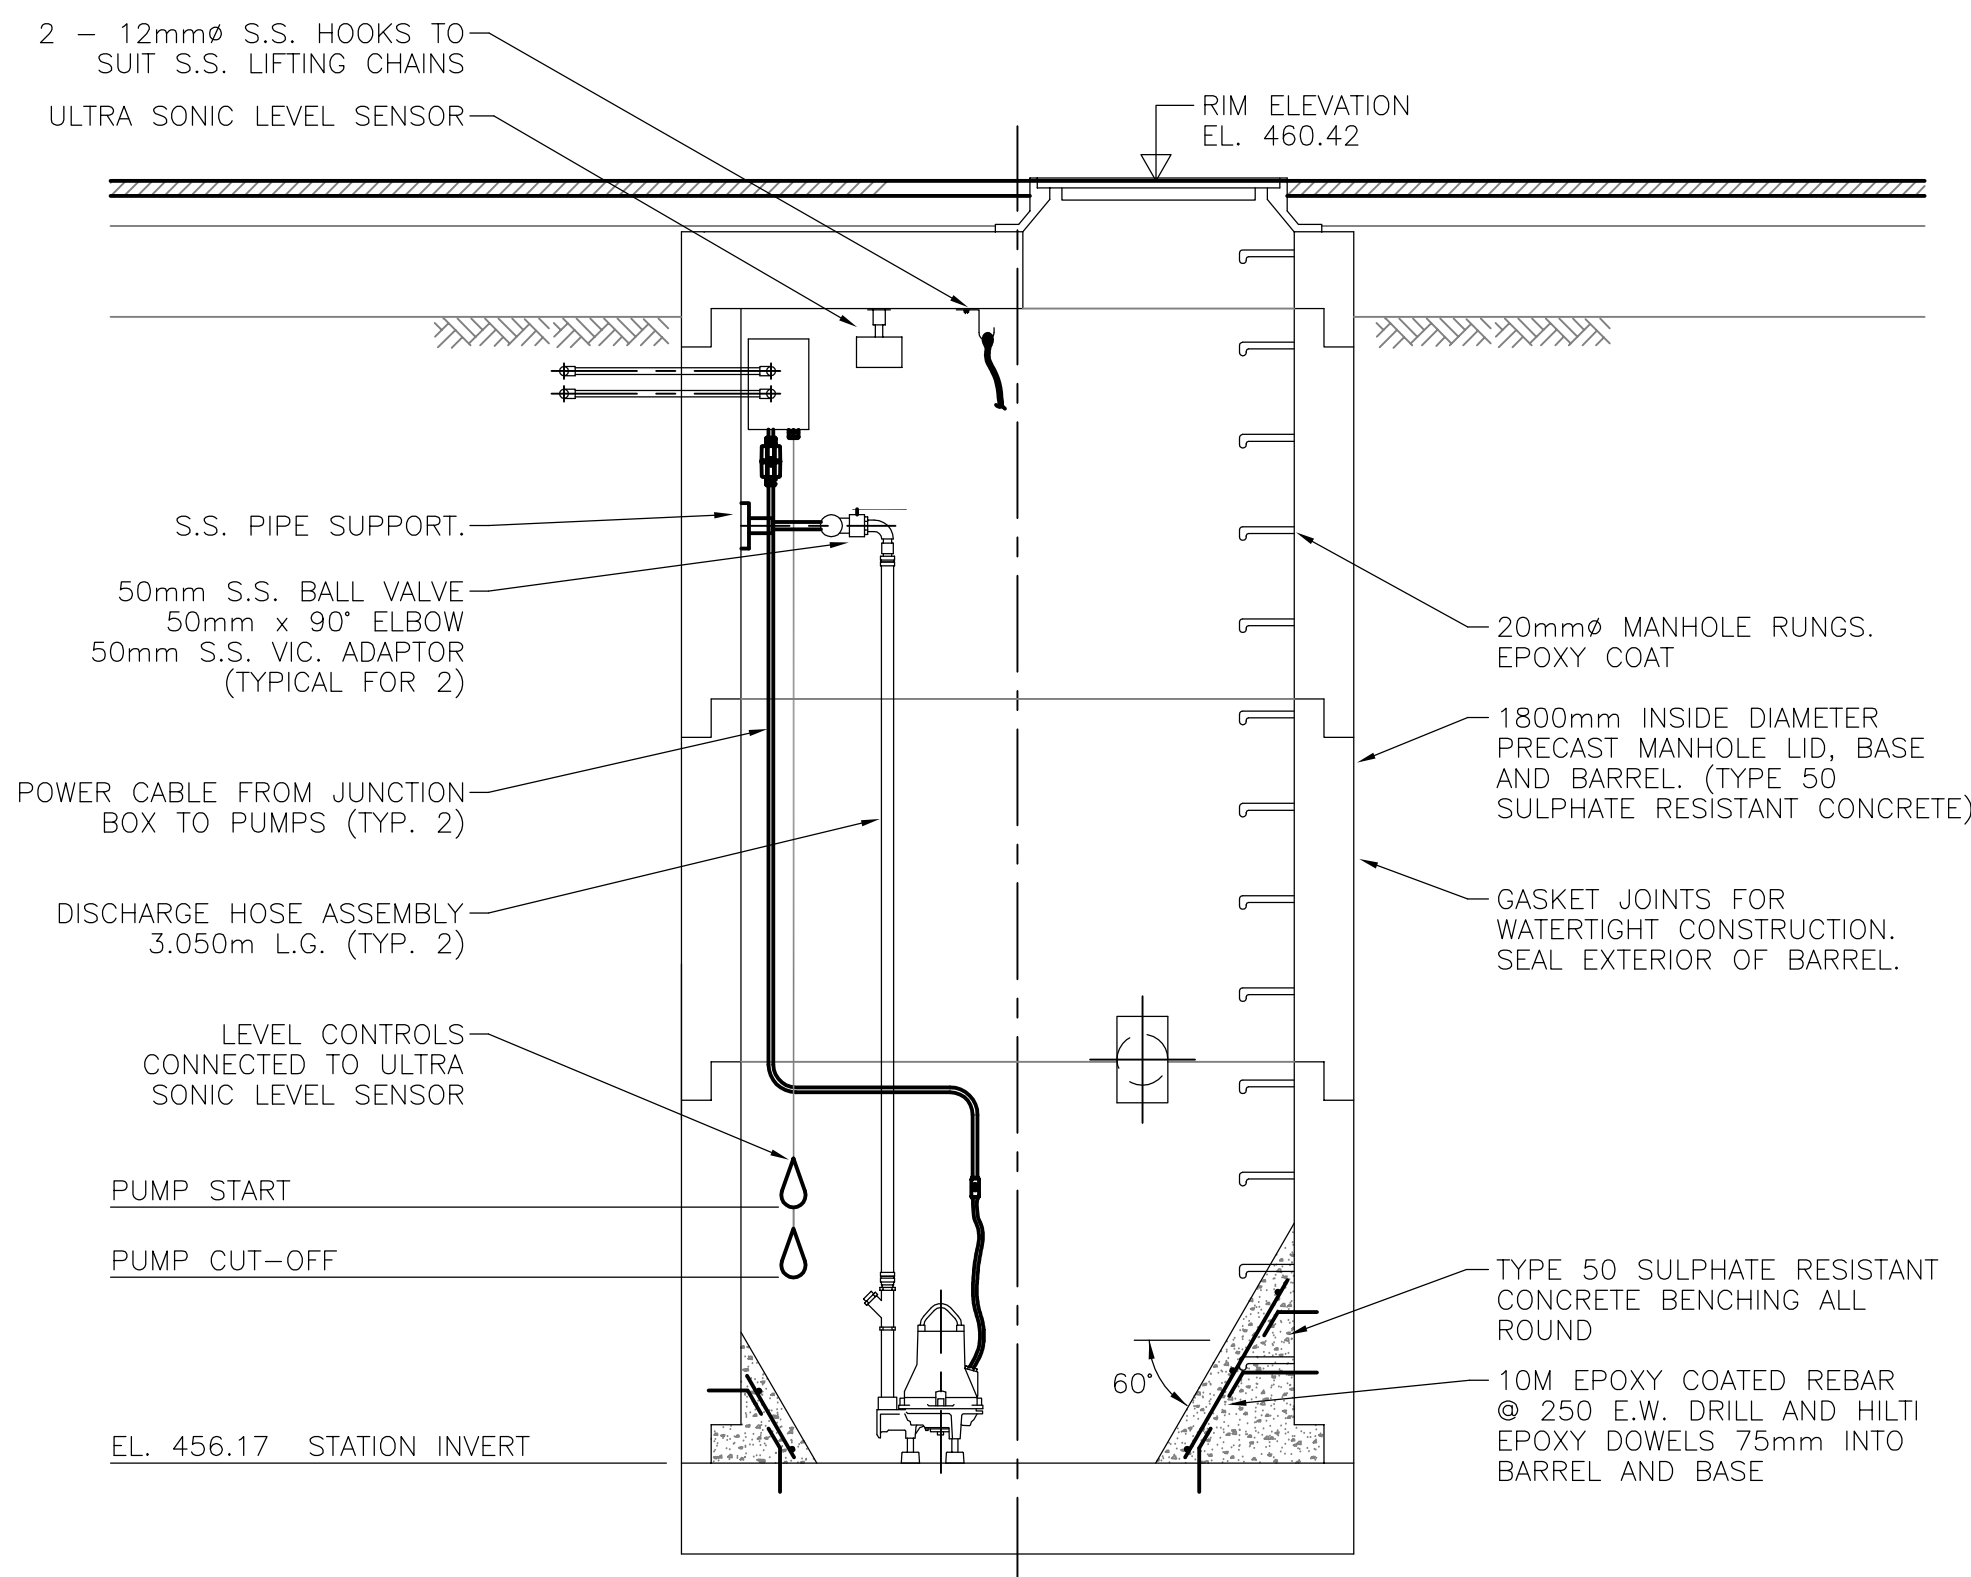

SECTION 1
SCALE: 1:25

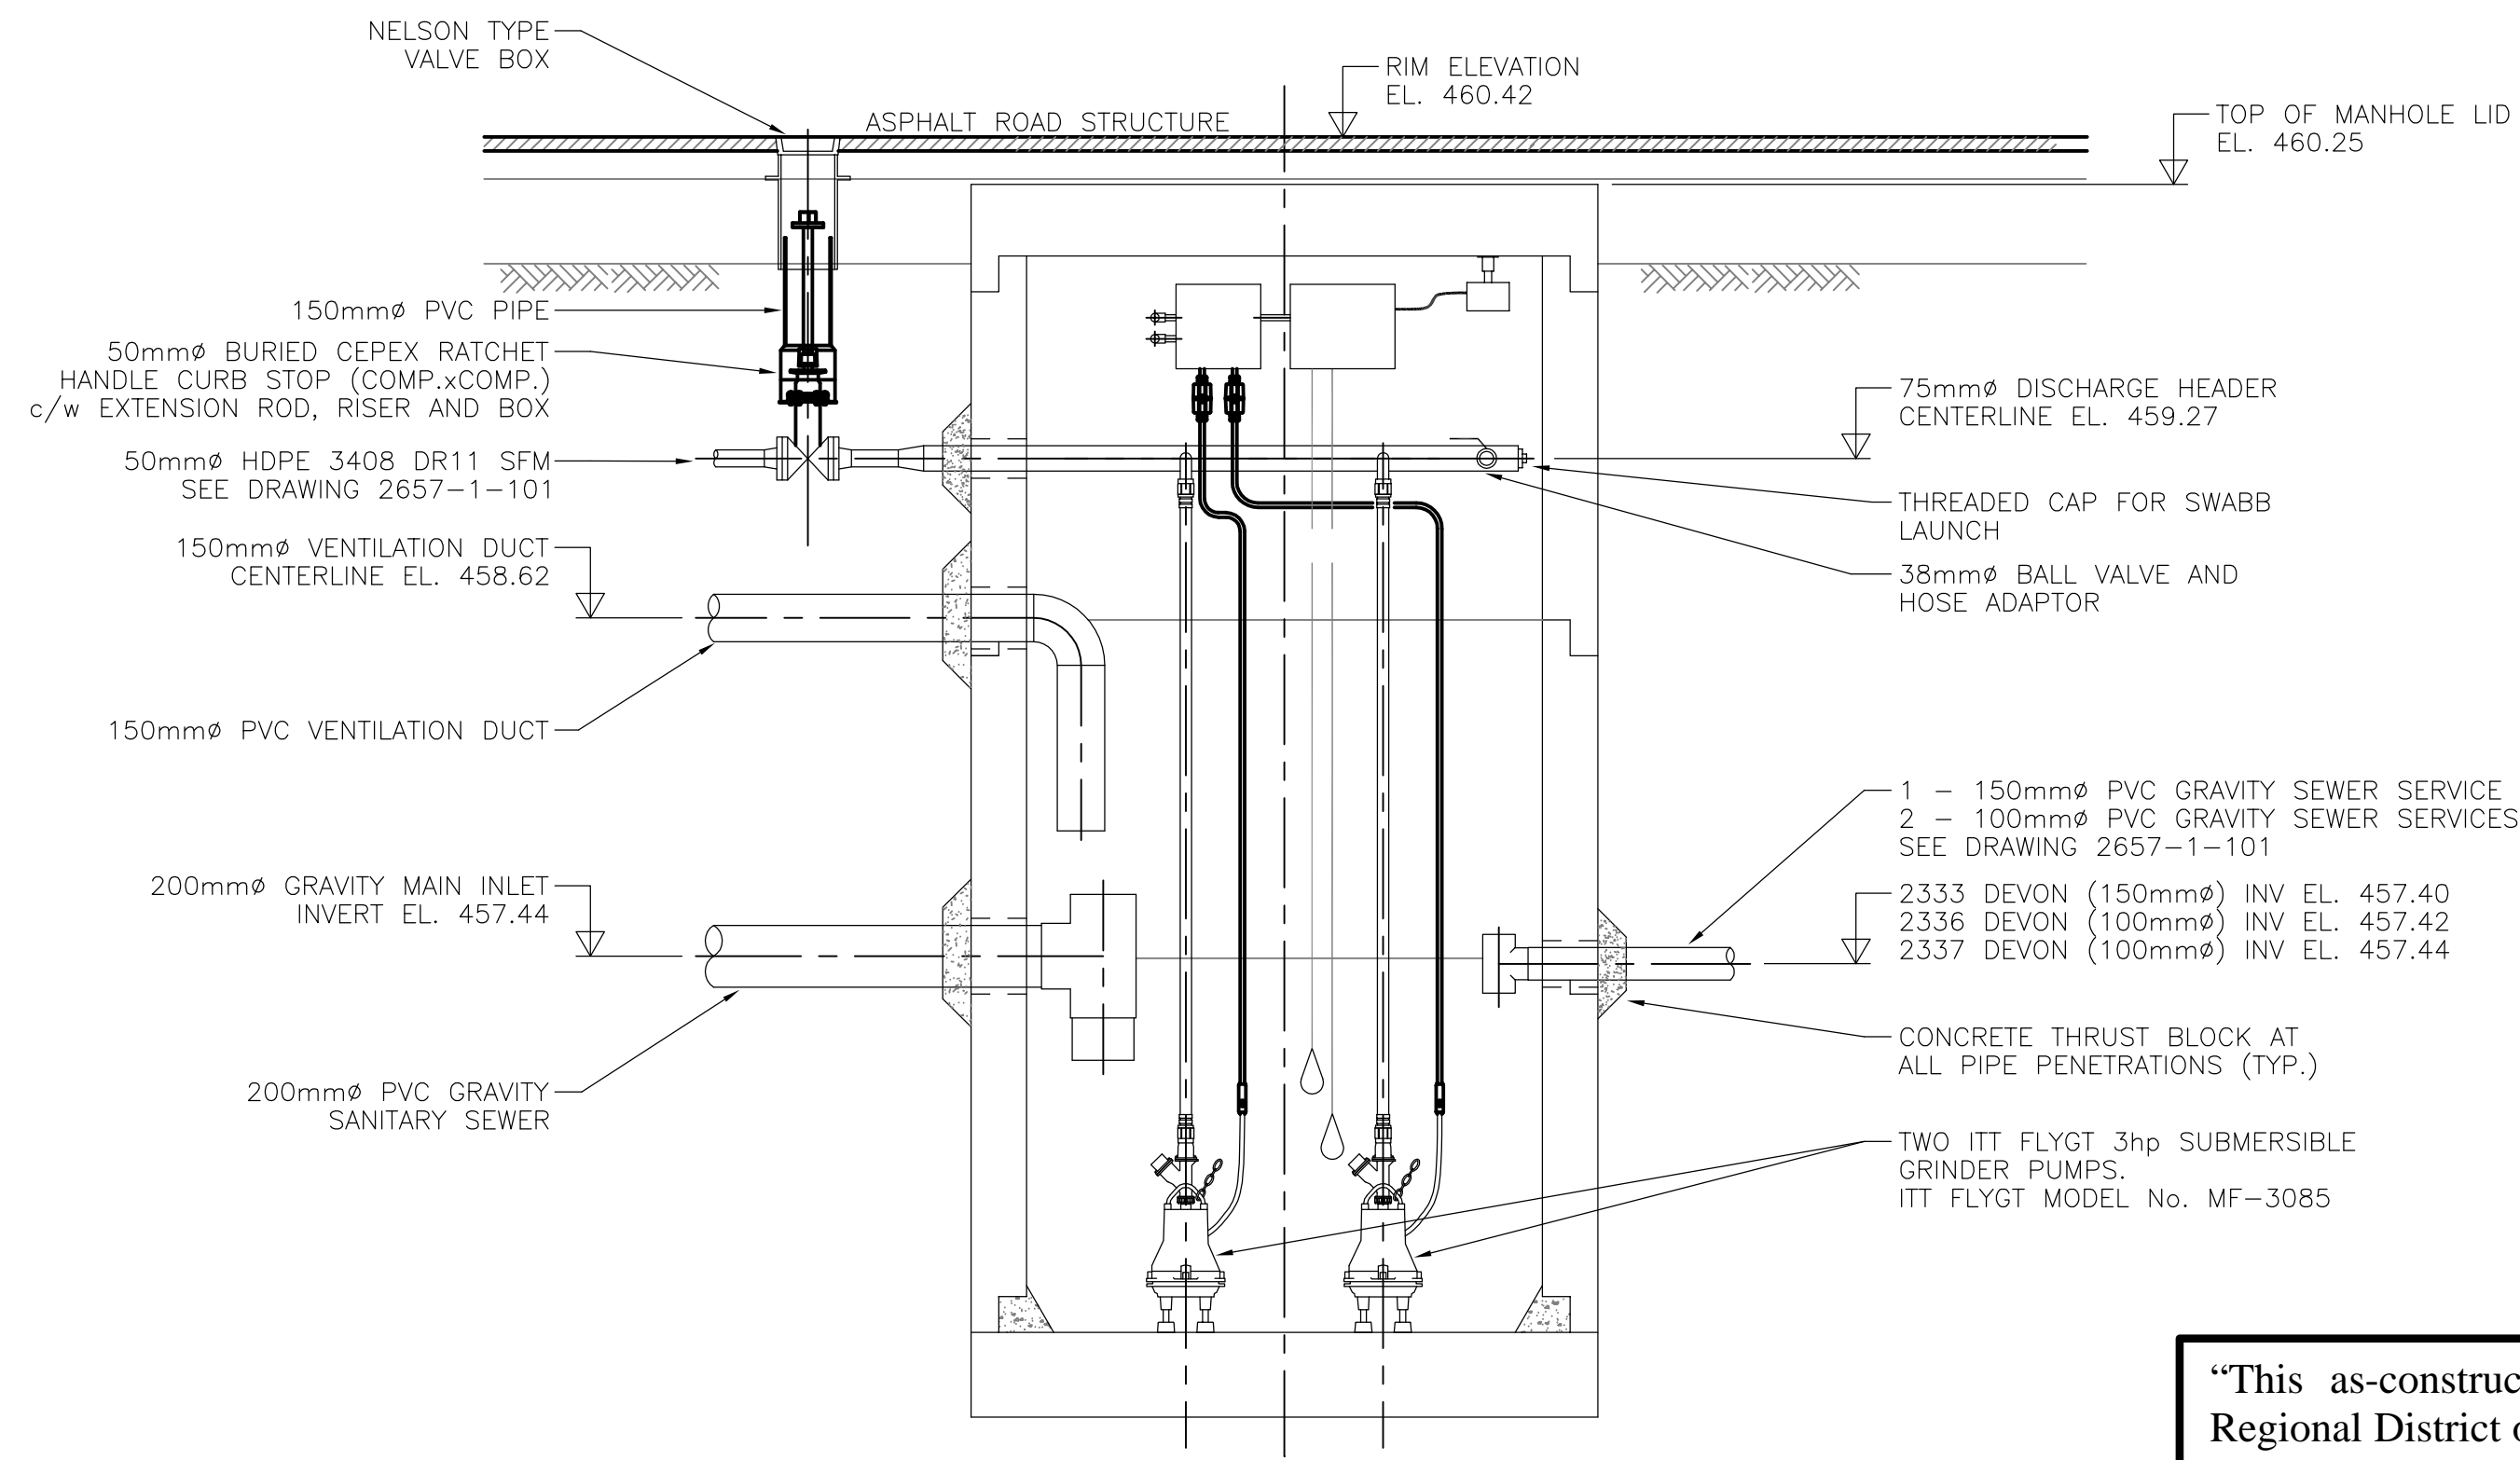

SECTION 2
SCALE: 1:25

"This as-constructed information was not prepared by the Regional District of Central Okanagan and therefore there is no guarantee of its accuracy. It is the recipient's and user's responsibility to confirm the accuracy of this as-constructed information before proceeding with any work that may be affected by this as-constructed information."

No.	MM/DD/YY	DATE	BY	REVISION	Chk'd	No.	MM/DD/YY	DATE	BY	REVISION	Chk'd
D	02/12/07		JB	REVISIONS PER RDCC COMMENTS	DRG						
C	01/05/07		JB	RECORD DRAWING	DRG						
B	05/05/06		JB	ISSUED FOR CONSTRUCTION	DRG						
A	02/24/06		BC	ISSUED FOR TENDER	DRG						

P.ENG.

DRAWN: B. CRANNA
DESIGN: B. CRANNA
APPROVED: D. GREER
DATE: 02/24/06
SCALE: AS NOTED

Suite 420
1628 Dickson Avenue
Kelowna, B.C. V1Y 3X1
Tel: (250) 763-3638
Fax: (250) 763-8880

**AREA 701 - STAGE 3, LAKEVIEW PHASE 4
SANITARY SEWER PROJECT
DEVON CT. S.L.S. PLANS AND SECTIONS**

DRAWING NO.	2657-1-502
REV. NO.	D



TEST REPORT

DEVON COURT LS 18

PRODUCT

Serial No. 3085.172		0650392		Performance curve No. 61- 257-00-1460		Motor module/type 114		Voltage (V) 230	
Base module 062	Impeller No. 444 84 13			Gear type	Gear ratio		Imp.diam/Blade angle 143		Water temp °C 20

TEST RESULTS

Pump total head H (m)	Volume rate of flow Q (l/s)	Motor input power P (kW)	Voltage U (V)	Current I (A)	Overall efficiency η (%)
34.14	0.05	2.12	231	9.3	0.86
33.11	0.41	2.17	230	9.6	6.12
31.02	1.16	2.34	230	10.3	15.10
31.01	1.16	2.34	230	10.3	15.11
30.46	1.30	2.38	228	10.5	16.37
27.27	2.04	2.68	230	11.8	20.39
16.92	2.62	2.87	230	12.7	15.21
17.00	2.63	2.86	230	12.7	15.30

Accepted after ISO9906/2	Test facility Lindas LC4 Sweden	Test date 06-08-29	Time 14:25	Chief tester 5324
-----------------------------	---------------------------------------	-----------------------	---------------	----------------------


ORDERNR 175834 POS 2

PLOTTED TEST RESULTS

Measured point : \pm = Q/H Duty point : \diamond = Q/H
 \times = Q/P \square = Q/P
 \triangle = Q/ETA overall Calculated point : \wedge = Q/ETA overall
 6

TOTAL HEAD

INPUT POWER

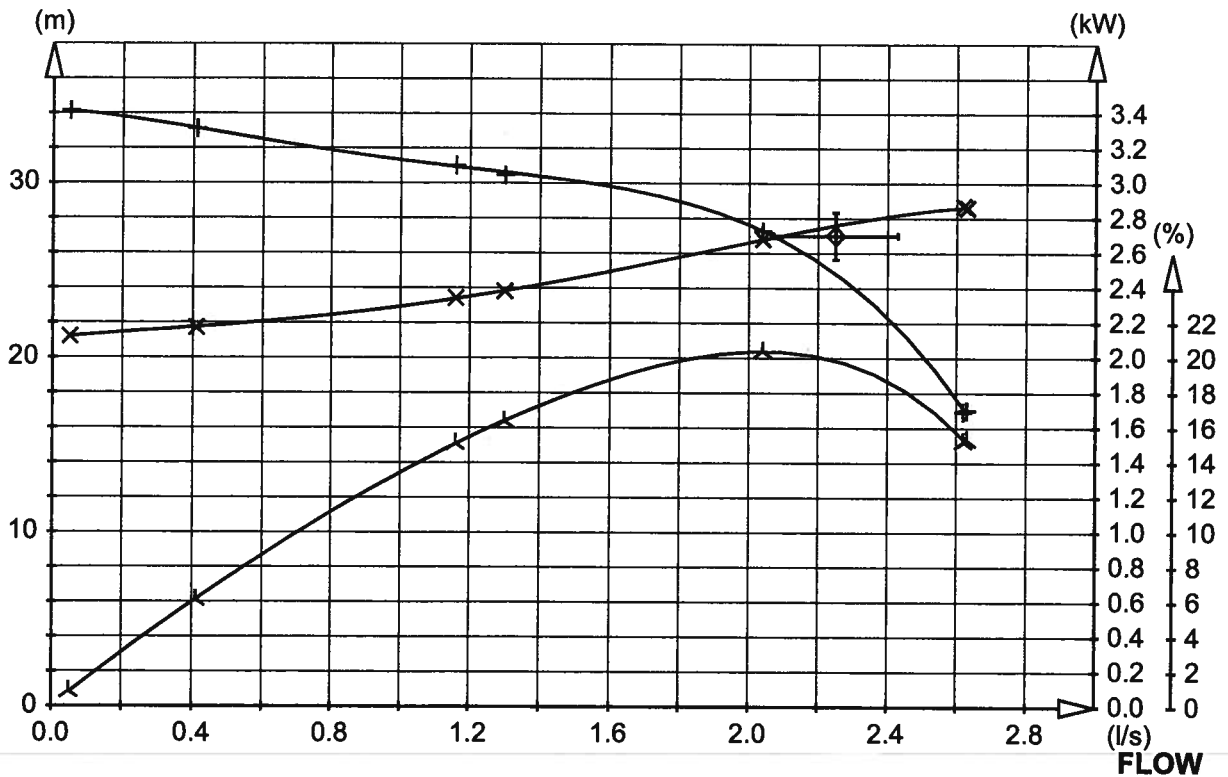



TEST REPORT

PRODUCT

Serial No. 3085.172		0650393		Performance curve No. 61-257-00-1460		Motor module/type 114		Voltage (V) 230	
Base module 062		Impeller No. 444 84 13		Gear type		Gear ratio		Imp.diam/Blade angle 143	
								Water temp °C 20	

TEST RESULTS

Pump total head H (m)	Volume rate of flow Q (l/s)	Motor input power P (kW)	Voltage U (V)	Current I (A)	Overall efficiency η (%)
34.32	0.03	2.08	229	9.2	0.46
33.24	0.42	2.15	229	9.5	6.34
31.11	1.18	2.33	229	10.3	15.46
31.11	1.18	2.33	229	10.3	15.49
30.75	1.27	2.34	229	10.4	16.43
27.62	2.04	2.61	228	11.6	21.26
19.41	2.71	2.86	228	12.7	18.01
19.38	2.71	2.87	228	12.8	17.94


Accepted after ISO9906/2	Test facility Lindas LC4 Sweden	Test date 06-08-29	Time 14:35	Chief tester 5324
-----------------------------	---------------------------------------	-----------------------	---------------	----------------------

ORDERNR 175834 POS 2

PLOTTED TEST RESULTS Measured point : + = Q/H
 X = Q/P
 Duty point : \diamond = Q/H
 \square = Q/P
 Δ = Q/ETA overall
 Calculated point : \wedge = Q/ETA overall
 6

TOTAL HEAD

INPUT POWER

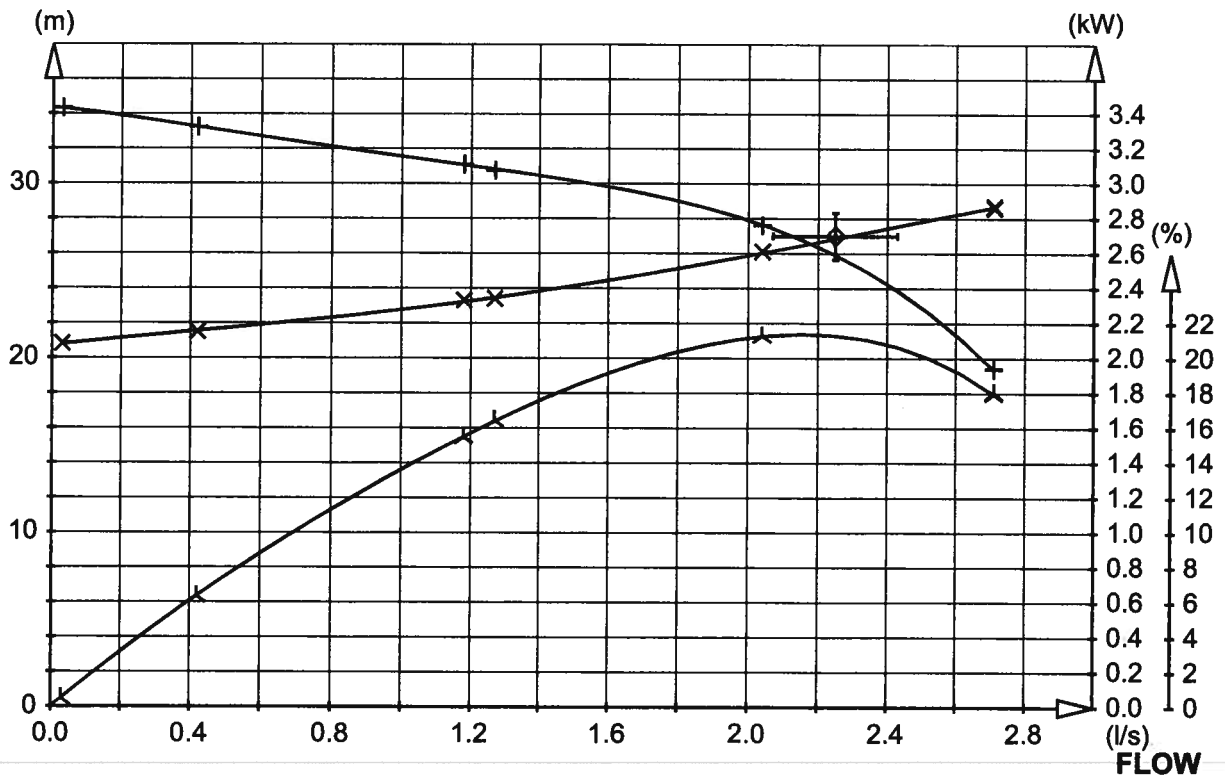



District of West Kelowna

Sanitary Lift Station Evaluation

Station: Faulkner Creek Ls 19
Inspection By: Jim Kentel

Year Constructed: 1994
Year Upgraded: 2013

Matrix Rating			
(10 - highest rating)	Civil	40	
(1 - lowest rating)	Process Mechanical	115	
	Electrical Instrumentation	149	
	Total Station Rating	304	(max. rating 370 points)



Civil:Matrix
Rating

Parking Area:	_____	n/a
Drainage:	Good	10
Influent sewer:	Gravity 200	10
Site access:	Good	10
Water service:	Yes	10
		40

Process Mechanical:Matrix
Rating

Station type:	Concrete/Sumpersible	n/a
Number of pumps:	2	n/a
Pump Redundancy:	Yes	n/a
Pump Manufacturer / Type:	Fontaine - Bleue	5
Pump Model:	10BH-SU31	n/a
Rated Capacity:	39 L/S @ 62m TDH	n/a
Capacity Confirmation:	_____	n/a
Forcemain pipe type / diameter:	PVC/200	8
Header pipe type / diameter:	Steel/150	8
Check valve type / diameter:	Val-matic Plug Swing Flex /150	8
Isolation valve type / diameter:	Val-matic Plug / 1501	8
Piping Condition:	Good	8
Emergency pumpout connection:	_____	1
Pressure gauges:	Yes	8
Inlet bar screen:	Comminitor	8
Wetwell condition:	Good	8
Access Hatches:	Yes	10
Ladder / Platform:	Yes/No	5
Wetwell benching:	Concrete	8
Odour Control:	No	1
Ventilation:	Yes	10
Water washdown:	_____	1
Confined Space Entry Requirements	Davit and Hoist	10
		115


Electrical / Instrumentation:

Matrix
Rating

Service Type	V / A / Phase / Wire	1
Pump 1 :	HP 60	1
	Volts 575 Rpm 3600	n/a
	FLA 62A	n/a
Starting Current		n/a
Pump 2 :	HP 60	1
	Volts 575 Rpm 3600	n/a
	FLA 62A	n/a
Starting Current		n/a
Pump 3 :	HP	1
Future Pump	Volts Rpm	n/a
	FLA	n/a
Starting Current		n/a
Alarm Functions:	Yes	10
		n/a
		n/a
		n/a
Receptacle	Yes	10
Interior Lighting:	Yes	10
Exterior Lighting:	Yes	10
SCADA / Telemetry:	Yes	10
Main Breaker:	225A	10
Control Panel:	Yes	10
Lighting Panel:	Yes	10
Flowmeter:	Fisher & Porter COPa-X/150mm	10
Grounding:	Yes	10
Surge Protection:	Yes	10
UPS:	Yes	10
PLC:	Yes	10
Level Control:	Ultrasonic	10
Standby Generator:	No/genset/storage tank receptacle	5
		149
Comments:		

Fontaine-bleue

FAULKNER CREEK PARK LS. 19
(UPGRADED 2013)

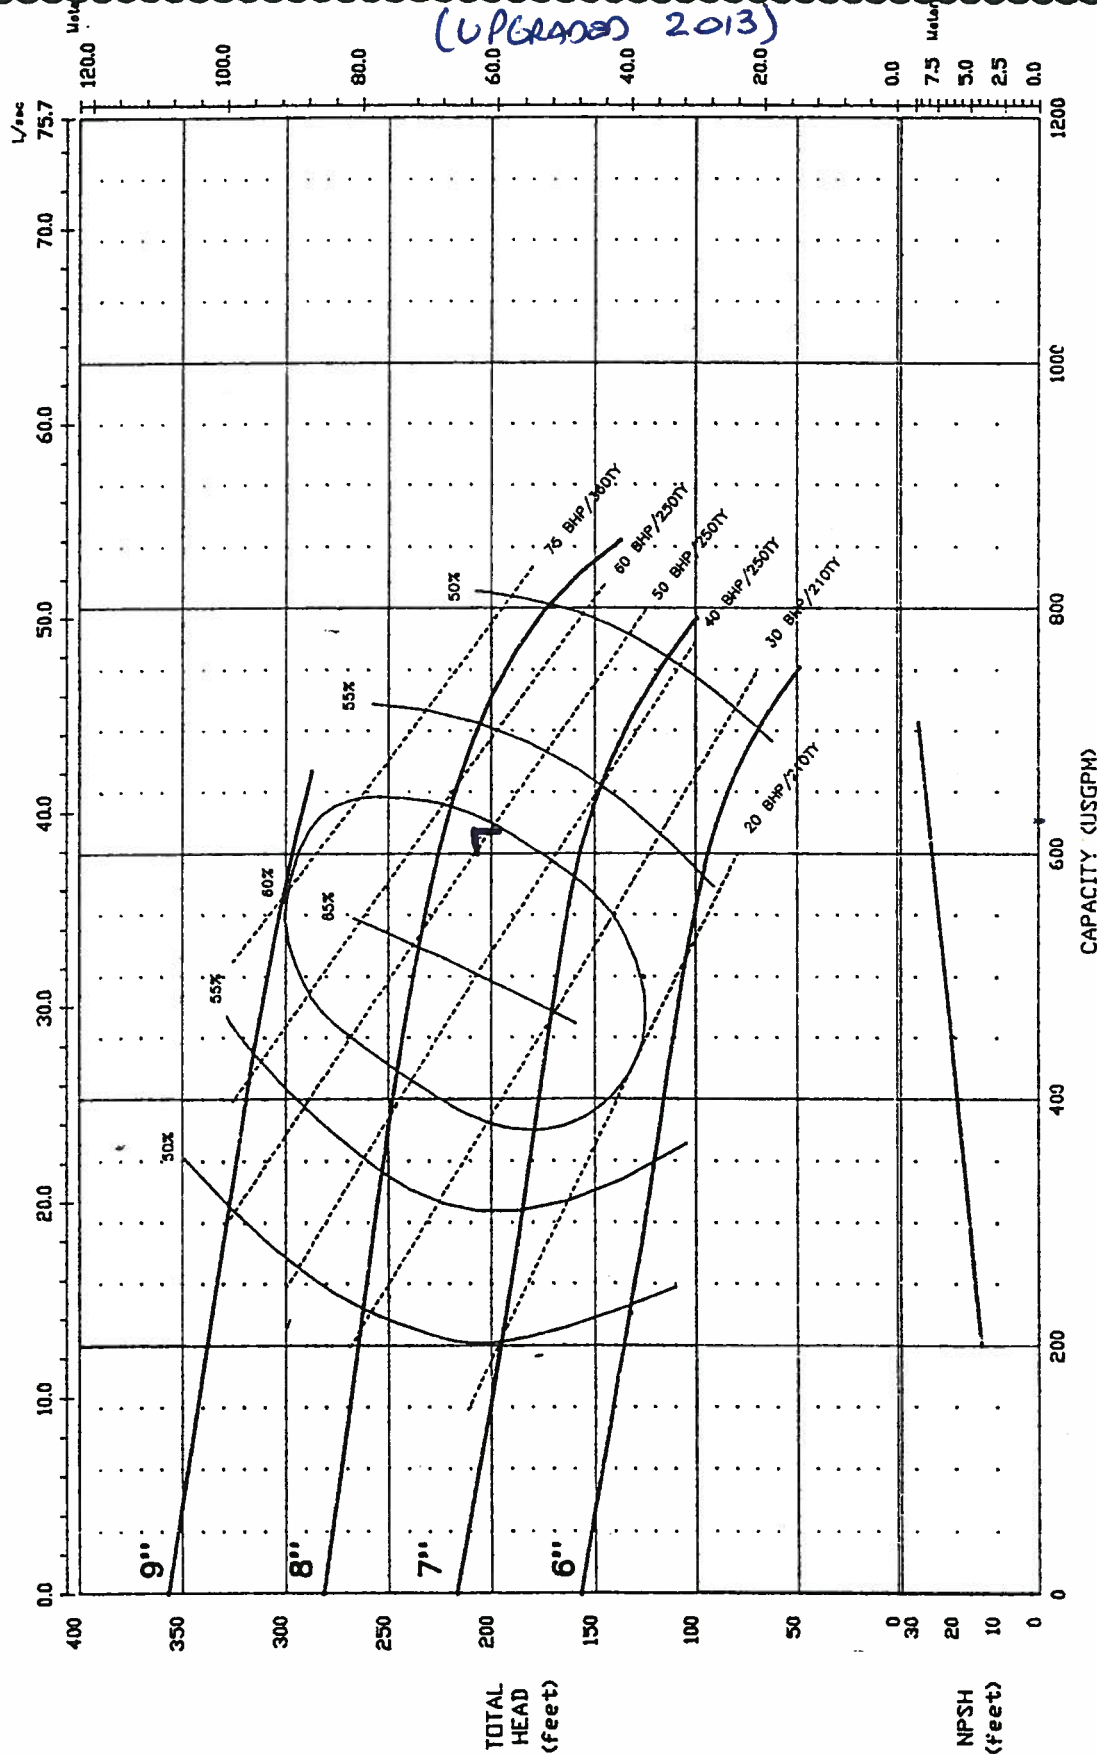

SPEED: 3600 RPM
FREQUENCY: 60 Hz
OPERATING PT. 618 USGPM @ 203'

IMPELLER: CA8-8
Vanes: 2
Eye diameter: 3 in (76 mm)
Solid: 3 in (76 mm)
Eye area: 7.07 in² (45 cm²)

Suction size: 3 in (76 mm)
Discharge: 4 in (101 mm)
PUMP: 10BH

In effect:

Supersedes:

Section:

Page:



District of West Kelowna

Sanitary Lift Station Evaluation

Station: Horizon Village LS 20
Inspection By: Jim Kentel

Year Constructed: 11/1/1998
Year Upgraded: Plan to be replaced in 2014

Matrix Rating		
(10 - highest rating)	Civil	40
(1 - lowest rating)	Process Mechanical	79
	Electrical Instrumentation	114
	Total Station Rating	233 (max. rating 370 points)

Civil:Matrix
Rating

Parking Area:	_____	n/a
Drainage:	Good	10
Influent sewer:	Gravity 200	10
Site access:	Good	10
Water service:	Yes	10
		40


Process Mechanical:Matrix
Rating

Station type:	Concrete/Sumpersible	n/a
Number of pumps:	2	n/a
Pump Redundancy:	Yes	n/a
Pump Manufacturer / Type:	Fontaine-Bleue	5
Pump Model:	10BH-SU31	n/a
Rated Capacity:	20-5 L/S @ 62.5m TDH	n/a
Capacity Confirmation:	_____	n/a
Forcemain pipe type / diameter:	PVC/150	8
Header pipe type / diameter:	Steel/100	5
Check valve type / diameter:	/100	5
Isolation valve type / diameter:	/100	5
Piping Condition:	_____	5
Emergency pumpout connection:	No	1
Pressure gauges:	Yes	5
Inlet bar screen:	No	1
Wetwell condition:	_____	8
Access Hatches:	Yes	8
Ladder / Platform:	Yes	5
Wetwell benching:	Concrete	5
Odour Control:	No	1
Ventilation:	No	1
Water washdown:	_____	1
Confined Space Entry Requirements	Davit and Hoist	10
		79

Electrical / Instrumentation:

Matrix
Rating

Service Type	V / A / Phase / Wire	1
Pump 1 :	HP 60	5
	Volts 575 Rpm	n/a
	FLA 62A	n/a
Starting Current		n/a
Pump 2 :	HP 60	5
	Volts 575 Rpm	n/a
	FLA 62A	n/a
Starting Current		n/a
Alarm Functions:	Yes	1
		n/a
		n/a
		n/a
Receptacle	Yes	10
Interior Lighting:	Yes	10
Exterior Lighting:	No	1
SCADA / Telemetry:	Yes	10
Main Breaker:	200A	10
Control Panel:	Yes	8
Lighting Panel:	Yes	8
Flowmeter:	Fischer & Porter	1
Grounding:	Yes	10
Surge Protection:	Yes	10
UPS:	Yes	10
PLC:	Yes	8
Level Control:	Milltronics/bulbs	1
Standby Generator:	No/Genset receptacle	5
		114
Comments:		

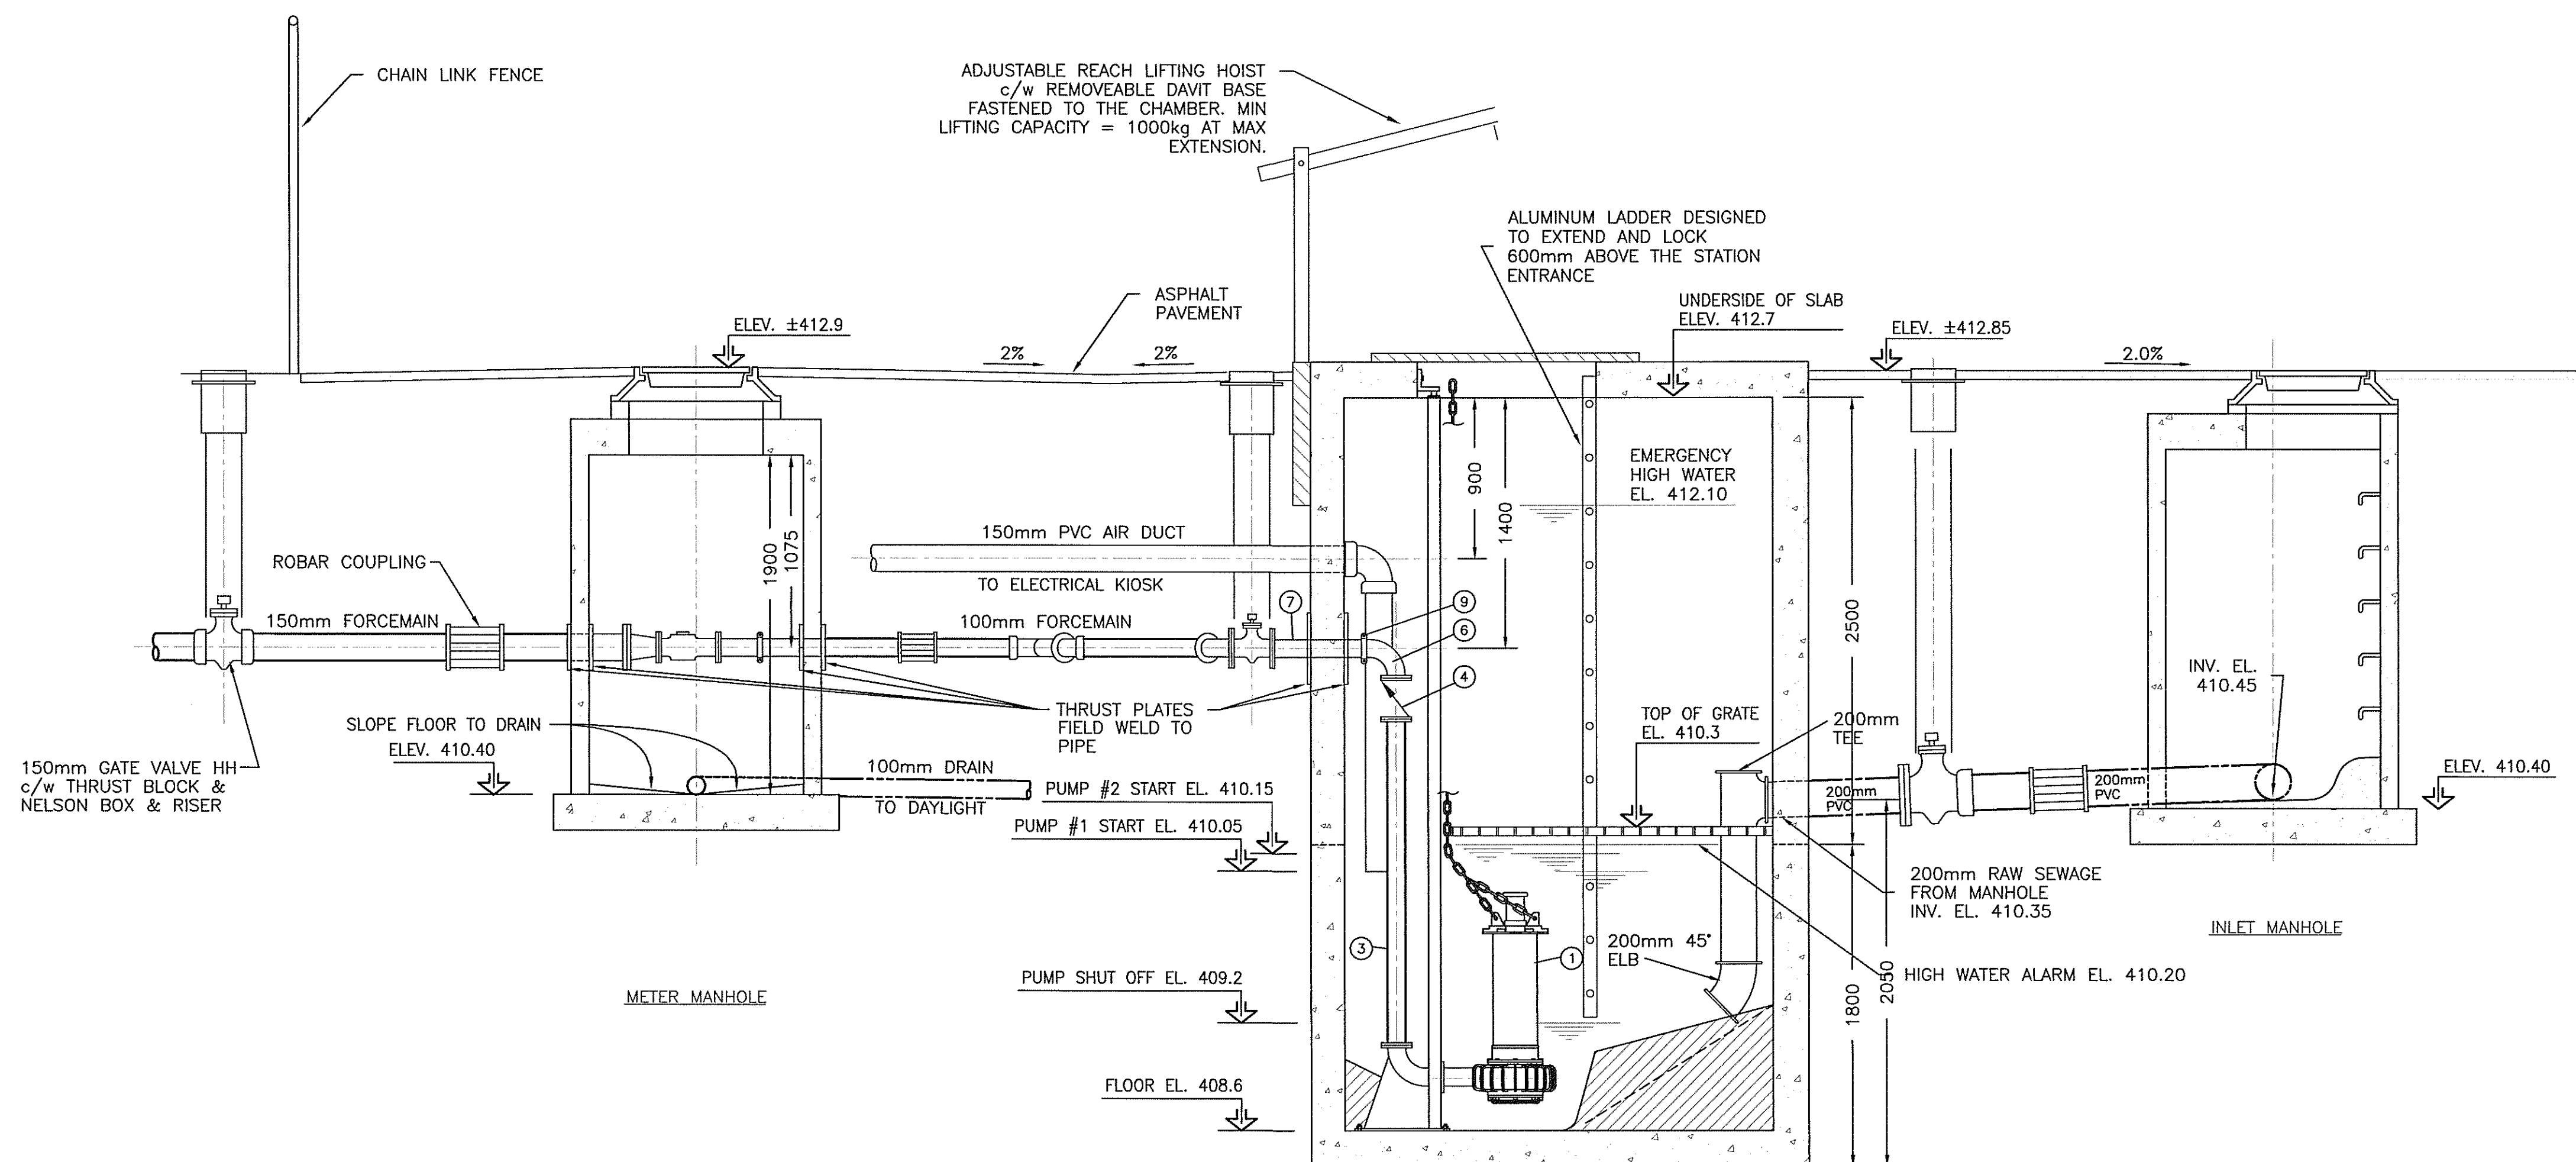

SECTION A-A
SCALE 1:25


"This as-constructed information was not prepared by the Regional District of Central Okanagan and therefore there is no guarantee of its accuracy. It is the recipient's and user's responsibility to confirm the accuracy of this as-constructed information before proceeding with any work that may be affected by this as-constructed information."

'AS CONSTRUCTED'

LEGEND CABLE TV _____ J CAP GAS _____ V CATCH BASIN SAN. SEWER _____ V ELECTRICAL BOX STORM SEWER _____ H HYDRANT U.G. ELECTRICAL _____ X VALVE U.G. TELEPHONE _____ L LAMP STANDARD WATER _____	SAN # SANITARY MH (EXISTING OR FUTURE) SAN # SANITARY MH (PROPOSED) STM # STORM MH (EXISTING OR FUTURE) STM # STORM MH (PROPOSED) TRANSFORMER UTILITY JUNCTION BOX	<table border="1"> <tr> <td>1</td> <td>01/13/99</td> <td>SH</td> <td>AS CONSTRUCTED</td> <td></td> <td></td> <td></td> <td></td> <td></td> <td></td> <td></td> <td></td> <td></td> <td></td> <td></td> <td></td> <td></td> <td></td> <td></td> <td></td> </tr> <tr> <th>No.</th> <th>DATE</th> <th>BY</th> <th>REVISION</th> <th>Chk'd</th> <th>No.</th> <th>DATE</th> <th>BY</th> <th>REVISION</th> <th>Chk'd</th> <th colspan="10"></th> </tr> </table>	1	01/13/99	SH	AS CONSTRUCTED																	No.	DATE	BY	REVISION	Chk'd	No.	DATE	BY	REVISION	Chk'd												P.ENG. DRAWN JRB DESIGN DLB APPROVED DATE APRIL 10/98 SCALE 1:25	PROTECH CONSULTANTS 1989 LTD. 202 - 815 Hwy. 97 S. Kelowna B.C. Phone 769-6411 FAX 769-3377 HORIZON VILLAGE BARE LAND STRATA SUBDIVISION LIFT STATION SECTION A-A	DRAWING NO. 9728-LS2 REV. NO. 1
			1	01/13/99	SH	AS CONSTRUCTED																																								
No.	DATE	BY	REVISION	Chk'd	No.	DATE	BY	REVISION	Chk'd																																					

Fontaine-bleue

HORIZON VILLAGE LS 20

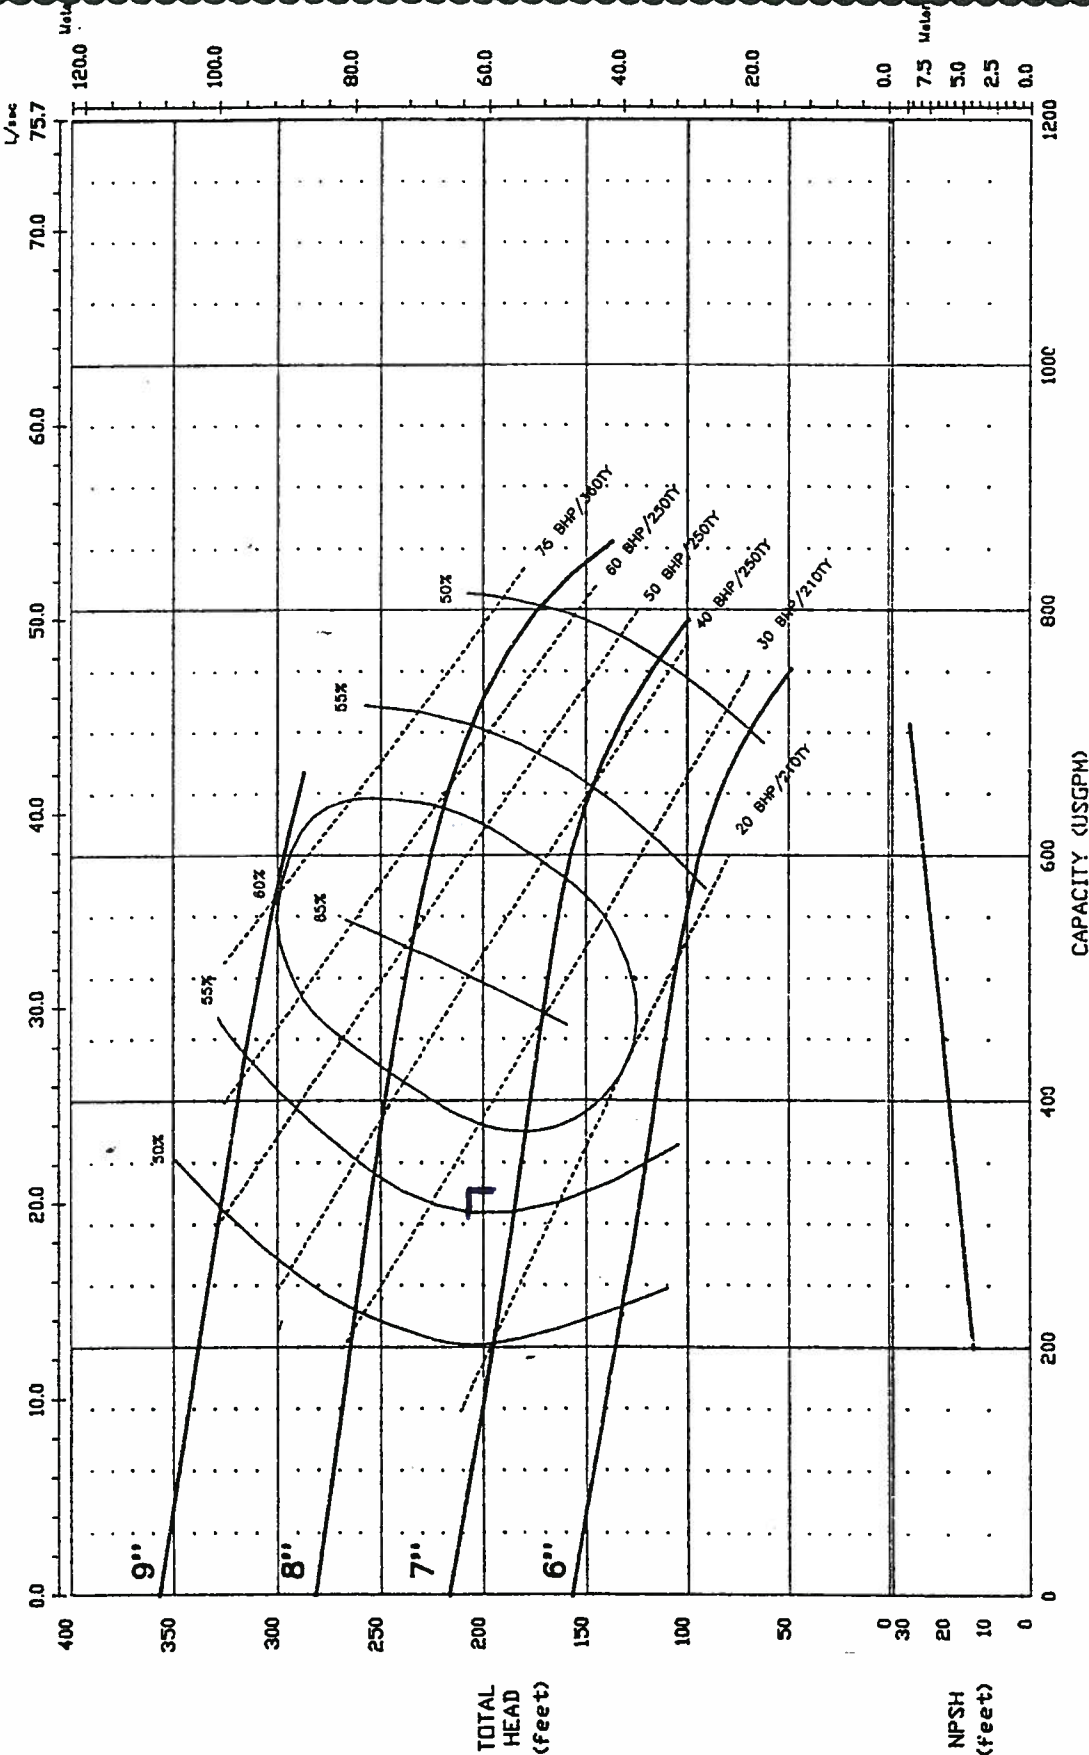

SPEED: 3600 RPM
FREQUENCY: 60 Hz
IMPELLER: CA8-8
Vanes: 2
Eye diameter: 3 in (76 mm)
Solid: 3 in (76 mm)
Eye area: 7.07 in² (45 cm²)
Suction size: 3 in (76 mm)
Discharge: 4 in (101 mm)
PUMP: 10BH
OPERATING POINT 325 USGPM @ 2.05'

In effect:

Supersedes:

Section:

Page:



District of West Kelowna

Sanitary Lift Station Evaluation

Station: Kelkoa Drive LS 21
Inspection By: Jim Kentel

Year Constructed: 8/1/2000
Year Upgraded:

Matrix Rating
(10 - highest rating)
(1 - lowest rating)

Civil	22
Process Mechanical	86
Electrical Instrumentation	19
Total Station Rating	127 (max. rating 370 points)

Civil:

	<u>Matrix Rating</u>
Parking Area:	n/a
Drainage: Good	10
Influent sewer: 1-200; 1-150	10
Site access: Easement poor	1
Water service: No	1
	<u>22</u>



Process Mechanical:

	<u>Matrix Rating</u>
Station type: Pre Fab Semi-Positive Displacement	n/a
Number of pumps: 2	n/a
Pump Redundancy: Yes	n/a
Pump Manufacturer / Type: Environment/one/grinder	7
Pump Model: 2014-129	n/a
Rated Capacity: 0.7 L/S @ 28m TDH	n/a
Capacity Confirmation:	n/a
Forcemain pipe type / diameter: PVC Sch 40/38mm	10
Header pipe type / diameter: SS/38mm	10
Check valve type / diameter: Glass lined PVC/38mm	10
Isolation valve type / diameter: SS ball/38mm	10
Piping Condition: Good	10
Emergency pumpout connection: No	1
Pressure gauges: No	1
Inlet bar screen: No	1
Wetwell condition: Good	10
Access Hatches: FRP	10
Ladder / Platform: No	1
Wetwell benching: No	1
Odour Control: No	1
Ventilation: No	1
Water washdown: No	1
Confined Space Entry Requirements: No	1
	<u>86</u>

Electrical / Instrumentation:

**Matrix
Rating**

Service Type	V / A / Phase / Wire	n/a
Pump 1 :	HP 1	n/a
	Volts 240 Rpm 1725	n/a
	FLA	n/a
Starting Current		n/a
Pump 2 :	HP 1	n/a
	Volts 240 Rpm 1725	n/a
	FLA	n/a
Starting Current		n/a
Alarm Functions:	None Buzzer	2
		n/a
		n/a
		n/a
Receptacles:	No	1
Interior Lighting:	No	1
Exterior Lighting:	No	1
SCADA / Telemetry:		1
Main Breaker:		1
Control Panel:		1
Lighting Panel:	No	1
Flowmeter:	No	1
Grounding:		1
UPS:		1
PLC:		1
Level Control:	Yes	5
Standby Generator:	No	1
		19
Comments:		

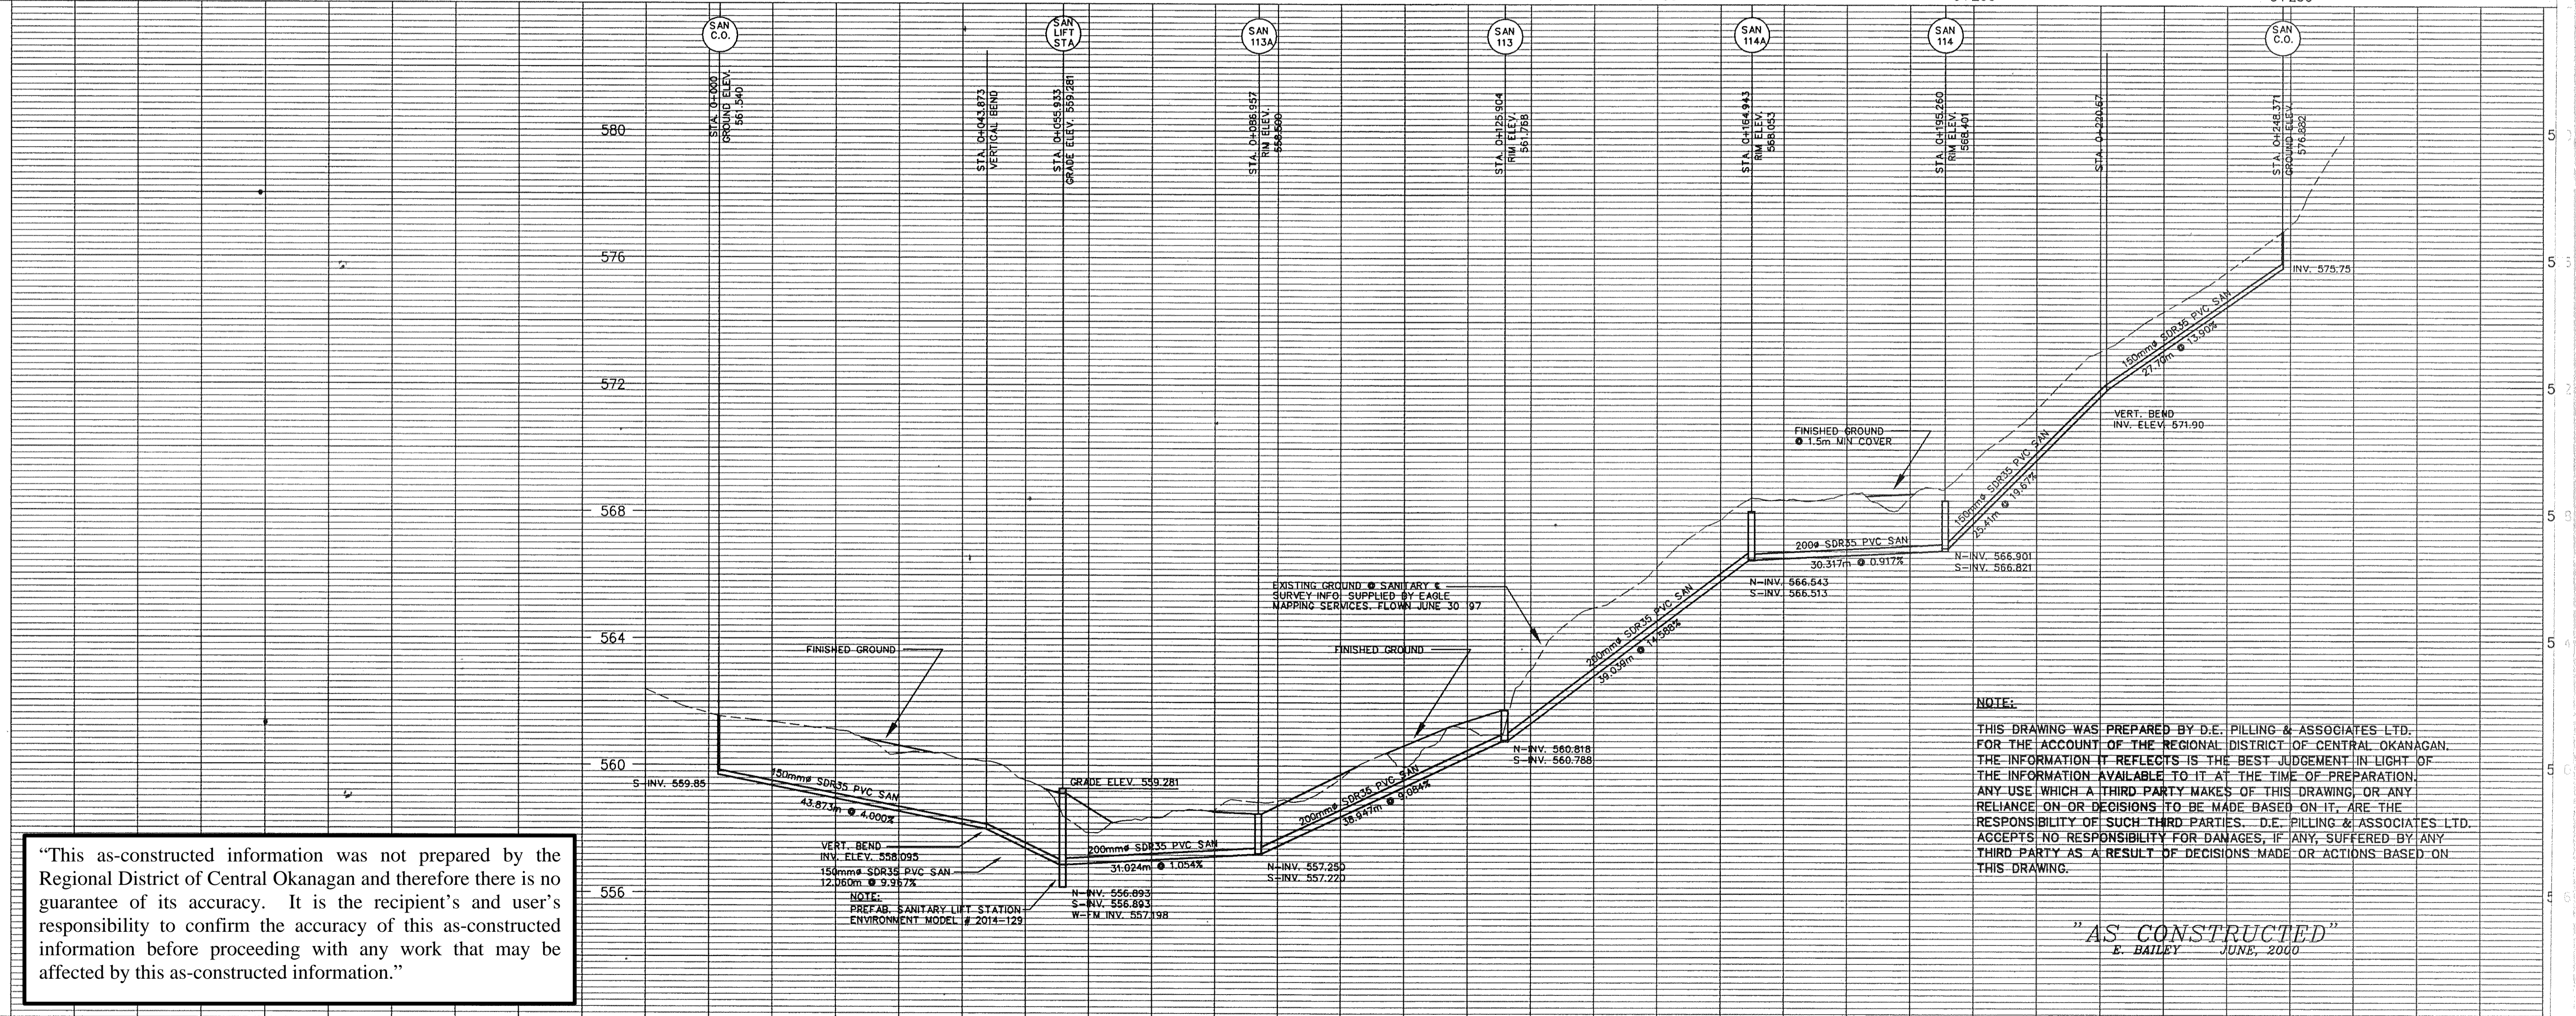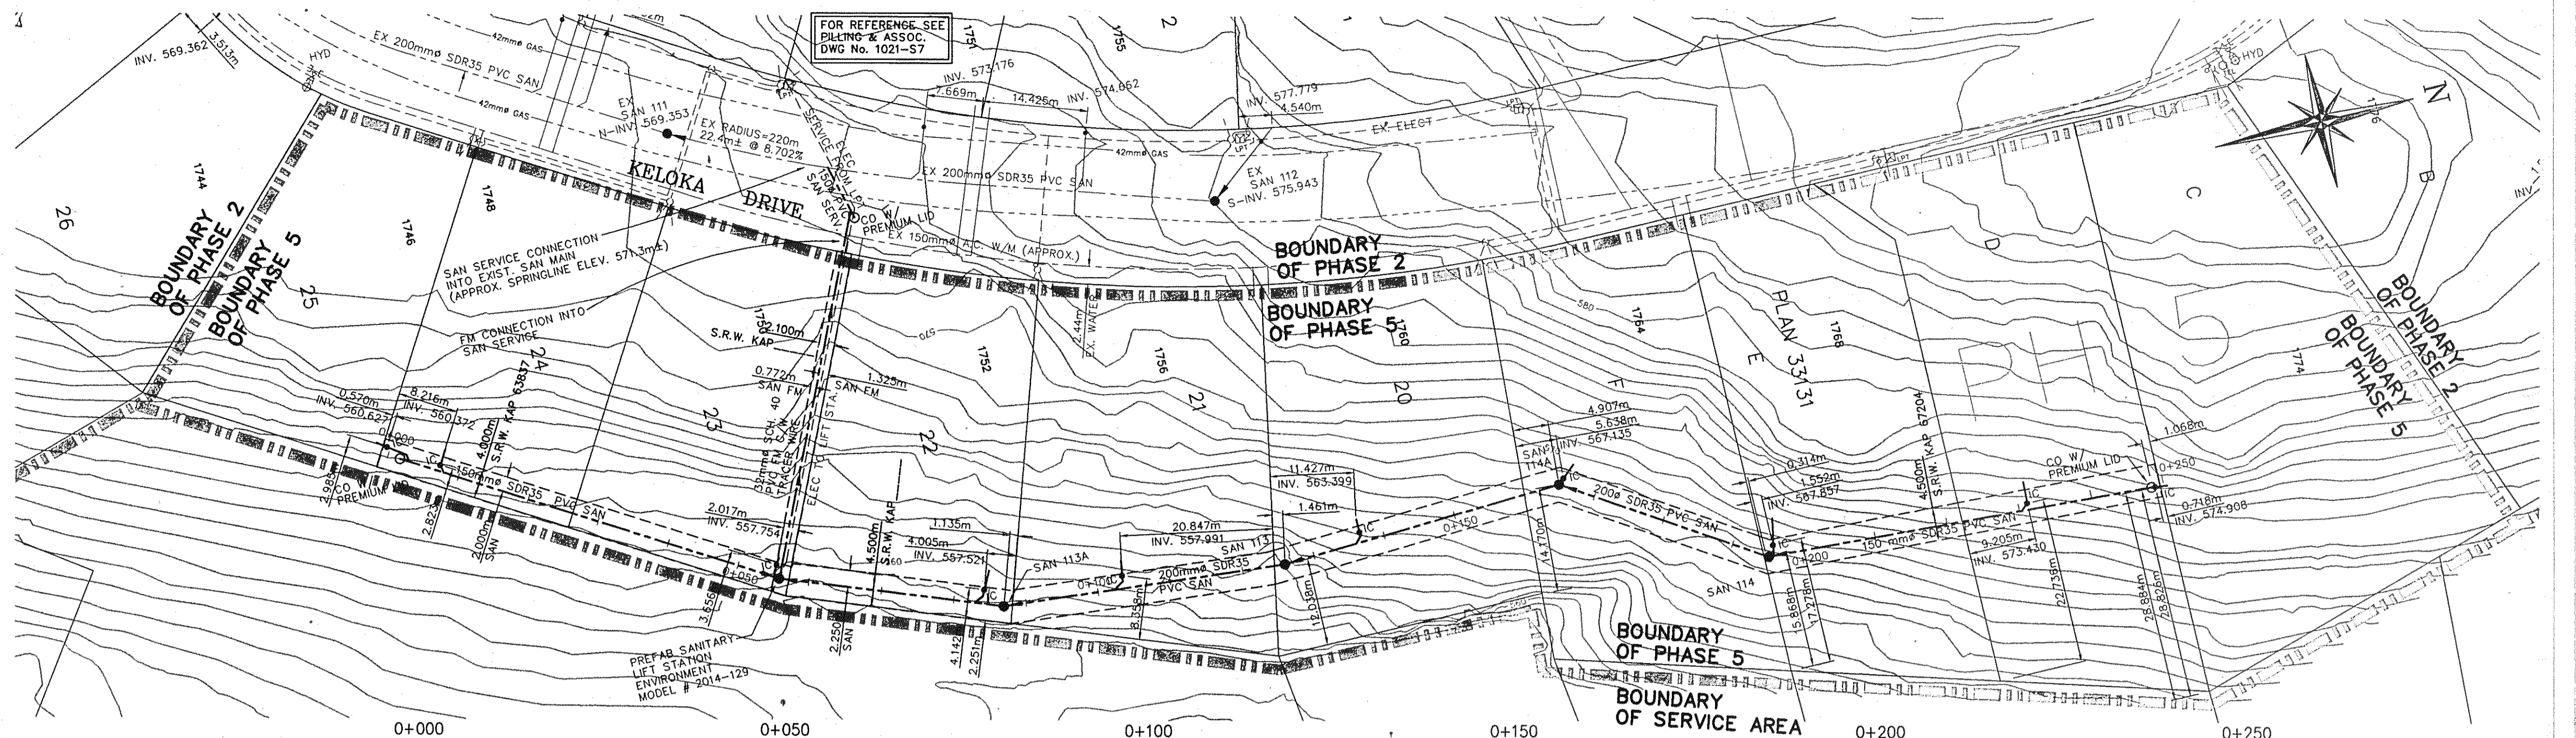


"This as-constructed information was not prepared by the Regional District of Central Okanagan and therefore there is no guarantee of its accuracy. It is the recipient's and user's responsibility to confirm the accuracy of this as-constructed information before proceeding with any work that may be affected by this as-constructed information."

NOTE:
 THIS DRAWING WAS PREPARED BY D.E. PILLING & ASSOCIATES LTD. FOR THE ACCOUNT OF THE REGIONAL DISTRICT OF CENTRAL OKANAGAN. THE INFORMATION IT REFLECTS IS THE BEST JUDGEMENT IN LIGHT OF THE INFORMATION AVAILABLE TO IT AT THE TIME OF PREPARATION. ANY USE WHICH A THIRD PARTY MAKES OF THIS DRAWING, OR ANY RELIANCE ON OR DECISIONS TO BE MADE BASED ON IT, ARE THE RESPONSIBILITY OF SUCH THIRD PARTIES. D.E. PILLING & ASSOCIATES LTD. ACCEPTS NO RESPONSIBILITY FOR DAMAGES, IF ANY, SUFFERED BY ANY THIRD PARTY AS A RESULT OF DECISIONS MADE OR ACTIONS BASED ON THIS DRAWING.

"AS CONSTRUCTED"
 E. BAILEY JUNE, 2000

No.	MM/DD/YY	DATE	BY	REVISION	Chk'd
2	08/08/00		CMW	REVISED AS PER R.D.C.O.	DEP
1	06/14/00		EBB	AS CONSTRUCTED	DEP

No.	MM/DD/YY	DATE	BY	REVISION	Chk'd
2	08/08/00		CMW	REVISED AS PER R.D.C.O.	DEP
1	06/14/00		EBB	AS CONSTRUCTED	DEP

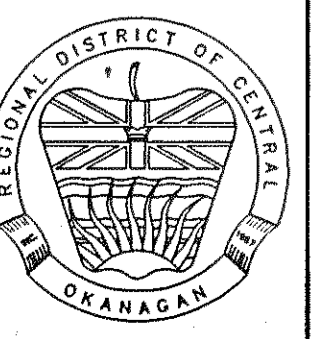

DALE E. PILLING, P.ENG.	DESIGN	EBB
	APPROVED	P.A.C.E.
	DATE	MAR 2000
	SCALE	H 1:500 V 1:100

PACE
 D. E. PILLING and ASSOCIATES
 CONSULTING ENGINEERING Ltd.
 #200, 540 GROVES AVENUE, KELOWNA, B.C. V1Y 4Y7
 TEL: 1-250-763-2315
 FAX: 1-250-763-6559

**R.D.C.O. SANITARY SEWER EXTENSION
 WEST KELOWNA ESTATES
 KELOKA DRIVE LOWER EASEMENT**

DRAWING NO.	1379-S1
REV. NO.	2

GP 2014

NO BAFFLE

General Applications

The size, efficiency and operating economy of the GP 2014 make it an ideal choice for multiple dwellings, waterfront property, subdivision developments and marinas. The GP 2014 is ideally suited for both new and existing communities.

General Features

The GP 2014 Grinder Pump is a complete unit that includes: two grinder pumps with check valves, HDPE (high density polyethylene) tank and controls. The GP 2014 is packaged into a single complete unit, ready for installation.

All solids are ground into fine particles, allowing them to pass easily through the pump, check valve and small-diameter pipelines. Even objects that are not normally found in sewage, such as plastic, rubber, fiber, wood, etc., are ground into fine particles.

The 1 1/4-inch discharge connection is adaptable to any piping materials, thereby allowing it to meet local code requirements.

The tank is made of tough corrosion-resistant HDPE. The optimum tank capacity of 150 gallons is based on computer studies of water usage patterns. A single GP 2014 is ideal for up to four average, single-family homes, and can also be used for up to 12 average, single-family homes with the consent of the factory. This model can accommodate flows of 3000 GPD.

The internal check valve assembly, located in each grinder pump, is custom-designed for non-clog, trouble-free operation.

The grinder pump is automatically activated and runs infrequently for very short periods. The annual energy consumption is typically that of a 40-watt light bulb.

Units are available for indoor and outdoor installations. Outdoor units are designed to accommodate a wide range of burial depths.

Operational Information

Motor

1 hp, 1,725 rpm, high torque, capacitor start, thermally protected, 120/240V, 60 Hz, 1 phase

Inlet Connections

4-inch inlet grommet standard for DWV pipe. Other inlet configurations available from the factory.

Discharge Connections

Pump discharge terminates in 1 1/4-inch NPT female thread. Can easily be adapted to 1 1/4-inch PVC pipe or any other material required by local codes.

Discharge*

15 gpm at 0 psig (per pump)

11 gpm at 40 psig (per pump)


9 gpm at 60 psig (per pump)

Control Panel

This station is designed to use the Alternating Control Panel, MOD T260.

Overload Capacity

The maximum pressure that the pump can generate is limited by the motor characteristics. The motor generates a pressure well below the rating of the piping and appurtenances. The automatic reset feature does not require manual operation following overload.

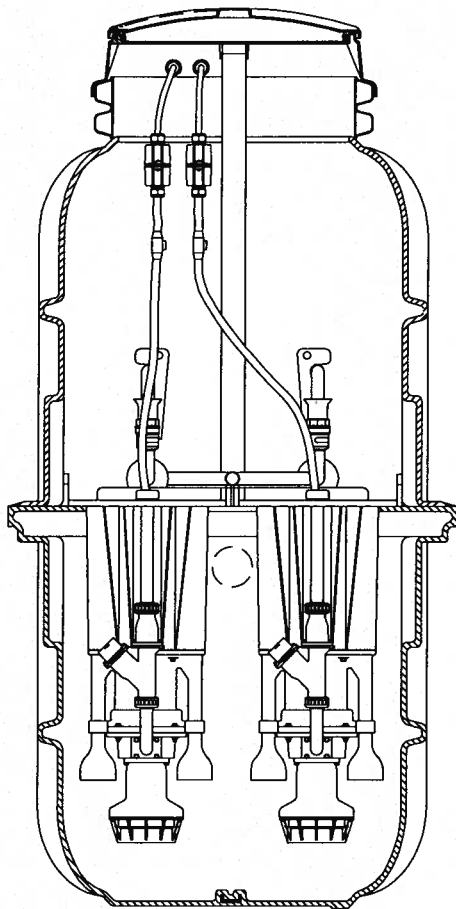


Patent Numbers: 5,752,315 5,562,254
5,439,180

* Discharge data includes loss through check valve, which is minimal

PA1348P02 Rev. -, 3/03

2014-129 NO BAFFLE

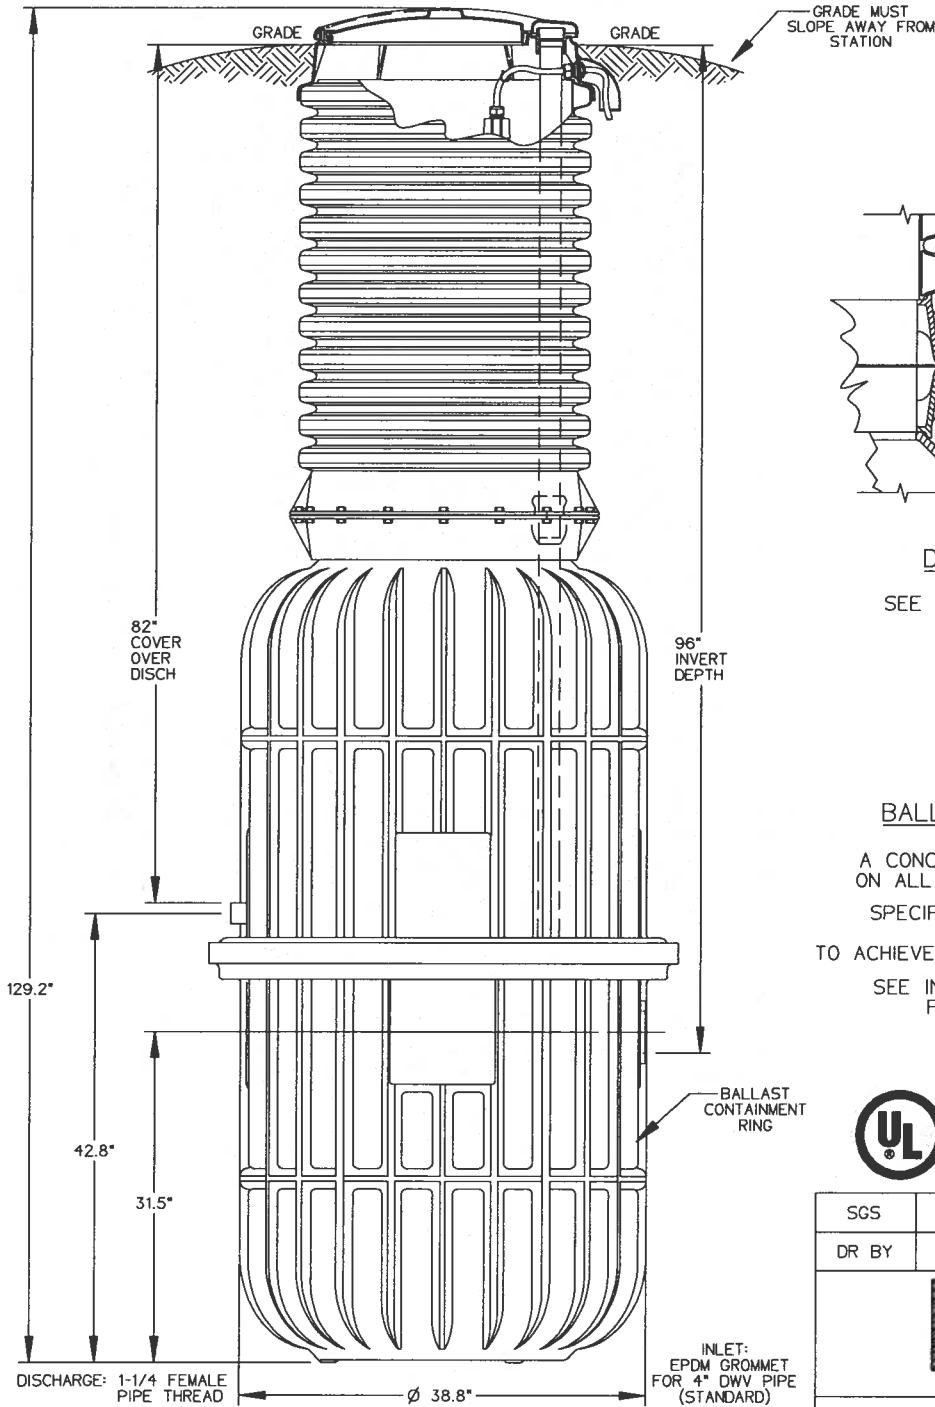

DETAIL, FIELD JOINT

SEE INSTALLATION INSTRUCTIONS FOR FURTHER DETAILS

BALLAST REQUIREMENTS

A CONCRETE ANCHOR IS REQUIRED ON ALL MODEL 2014-129 STATIONS
SPECIFIC CONCRETE DIMENSIONS ARE REQUIRED TO ACHIEVE NECESSARY BALLAST EFFECT
SEE INSTALLATION INSTRUCTIONS FOR BALLAST DETAILS



SGS	CAH	3-25-03	-	1/16
DR BY	CHK'D	DATE	ISSUE	SCALE




MODEL 2014-129, NO BAFFLE

PA1337P14

2014 NO BAFFLE

FIELD JOINT REQUIRED
FOR MODELS
2014-129 & 2014-160

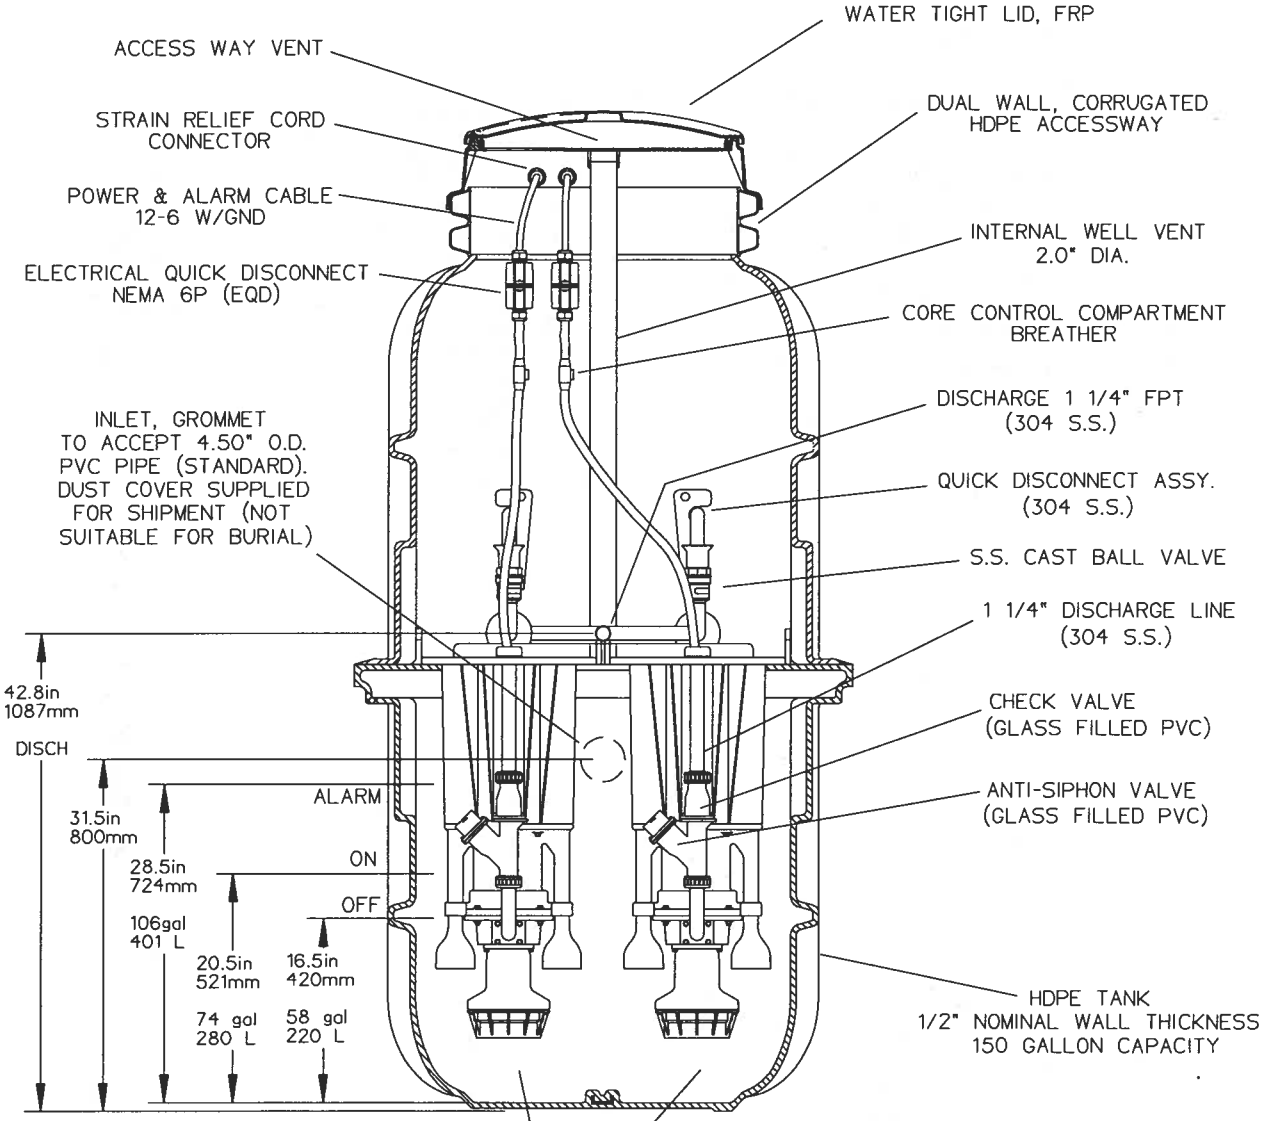

42.8in
1087mm

DISCH

31.5in
800mm

28.5in
724mm

106gal
401 L

20.5in
521mm

16.5in
420mm

74 gal
280 L

58 gal
220 L

SEMI-POSITIVE DISPLACEMENT TYPE PUMP
EACH DIRECTLY DRIVEN BY A 1 HP MOTOR
CAPABLE OF DELIVERING 9 gpm AT 138' T.D.H.
(34 lpm AT 42m T.D.H.)

BALLAST REQUIREMENTS

A CONCRETE ANCHOR IS REQUIRED
ON ALL OUTDOOR MODEL 2014 STATIONS
SPECIFIC CONCRETE DIMENSIONS ARE REQUIRED
TO ACHIEVE NECESSARY BALLAST EFFECT
SEE INSTALLATION INSTRUCTIONS FOR FURTHER DETAILS



SGS	CAH	03/22/03	A	1/16
DR BY	CHK'D	DATE	ISSUE	SCALE



MODEL 2014, NO BAFFLE, DETAIL SHEET

PA0910P02



District of West Kelowna

Sanitary Lift Station Evaluation

Station: Ross Road LS 22
Inspection By: Jim Kentel

Year Constructed: 10/1/1996
Year Upgraded:

Matrix Rating			
(10 - highest rating)	Civil		40
(1 - lowest rating)	Process Mechanical		112
	Electrical Instrumentation		108
	Total Station Rating		260 (max. rating 370 points)



Civil:Matrix
Rating

Parking Area:	_____	n/a
Drainage:	Good	10
Influent sewer:	Gravity 200	10
Site access:	Good	10
Water service:	50 Yard Hydrant	10
		40

Process Mechanical:Matrix
Rating

Station type:	Above Ground Self Priming	n/a
Number of pumps:	2	n/a
Pump Redundancy:	Yes	n/a
Pump Manufacturer / Type:	Gorman Rupp	8
Pump Model:	T4A3-B	n/a
Rated Capacity:	33.2 L/S @ 18.9m TDH	n/a
Capacity Confirmation:	_____	n/a
Discharge pipe type / diameter:	PVC/150m	10
Header pipe type / diameter:	CI/100mm	8
Check valve type / diameter:	CI/100	8
Isolation valve type / diameter:	CI Plug / 100	8
Piping Condition:	Good	8
Emergency pumpout connection:	No	1
Pressure gauges:	Yes	10
Inlet bar screen:	No	1
Wetwell condition:	Conc Box Culvert 2.4x2.4	8
Access Hatches:	MH Frames and Covers	5
Ladder / Platform:	Rungs/No	5
Wetwell benching:	Concrete	8
Odour Control:	No	1
Ventilation:	Yes	8
Water washdown:	Yes	10
Confined Space Entry Requirements	N/A	5
		112



Electrical / Instrumentation:

Matrix
Rating

Service Type	V / A / Phase / Wire	n/a
Pump 1 :	HP 20	n/a
	Volts 575 Rpm 1550	n/a
	FLA	n/a
Starting Current		n/a
Pump 2 :	HP 20	n/a
	Volts 575 Rpm 1550	n/a
	FLA	n/a
Starting Current		n/a
Alarm Functions:	Yes	10
		n/a
		n/a
		n/a
Receptacle	No	1
Interior Lighting:	No	1
Exterior Lighting:	No	1
SCADA / Telemetry:	Yes	10
Main Breaker:	Yes	10
Control Panel:		10
Lighting Panel:		10
Flowmeter:	Grey line	10
Grounding:	Yes	10
UPS:	Yes	10
PLC:	Yes	10
Level Control:	Milltronics	10
Standby Generator:	standy motor	5
		108
Comments:		


ITEM	DESCRIPTION	MAT'L & SIZE
1	PUMP	CAST IRON T4A3-B
2	MOTOR	CAST IRON
3	CHECK VALVE	CAST IRON 4"
4	PLUG VALVE	CAST IRON 4"
5	MOTOR CONTROL PANEL	STEEL
6	LIQUID LEVEL PANEL	STEEL
7	BELTGUARD	STEEL

"This as-constructed information was not prepared by the Regional District of Central Okanagan and therefore there is no guarantee of its accuracy. It is the recipient's and user's responsibility to confirm the accuracy of this as-constructed information before proceeding with any work that may be affected by this as-constructed information."

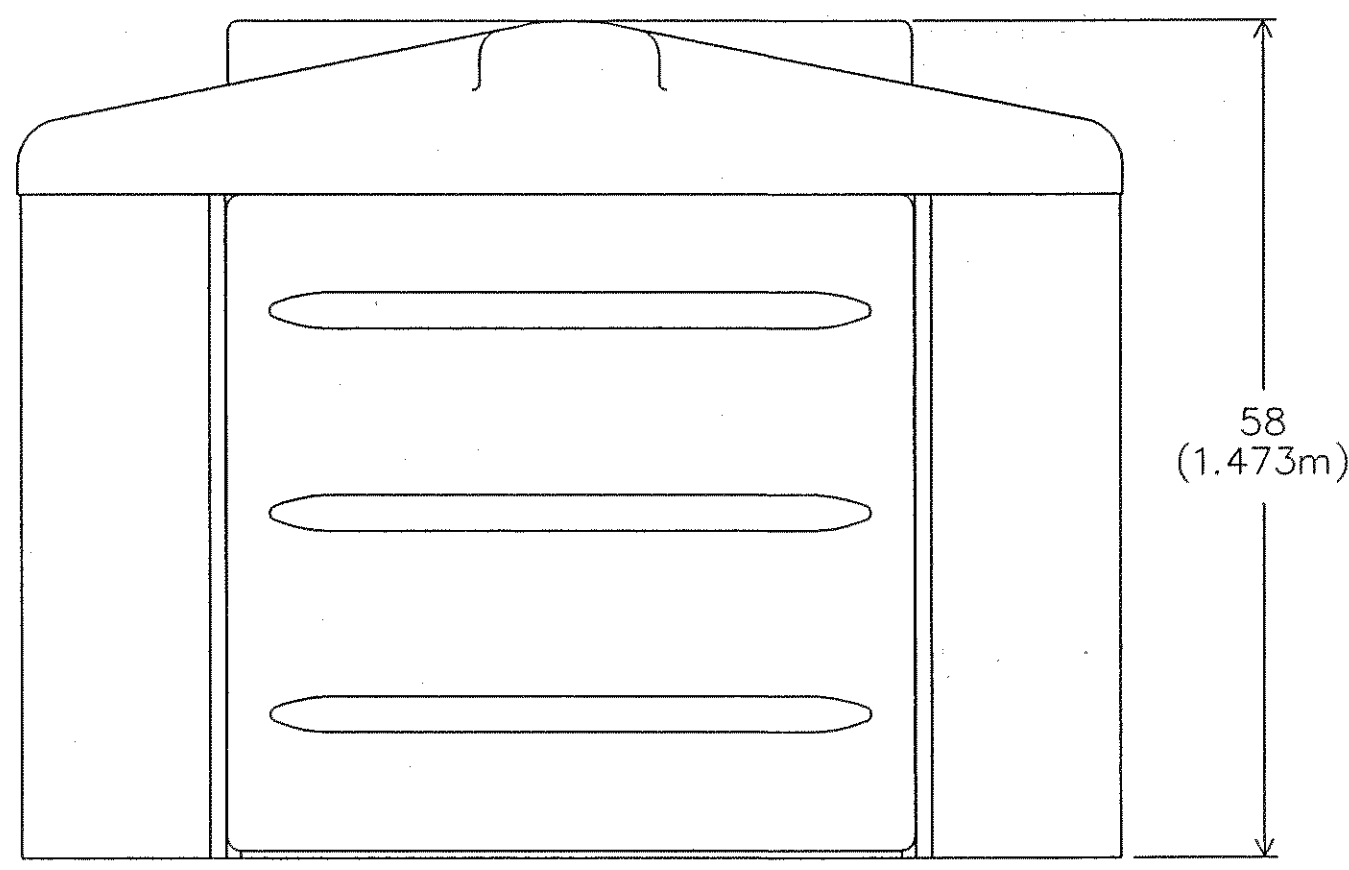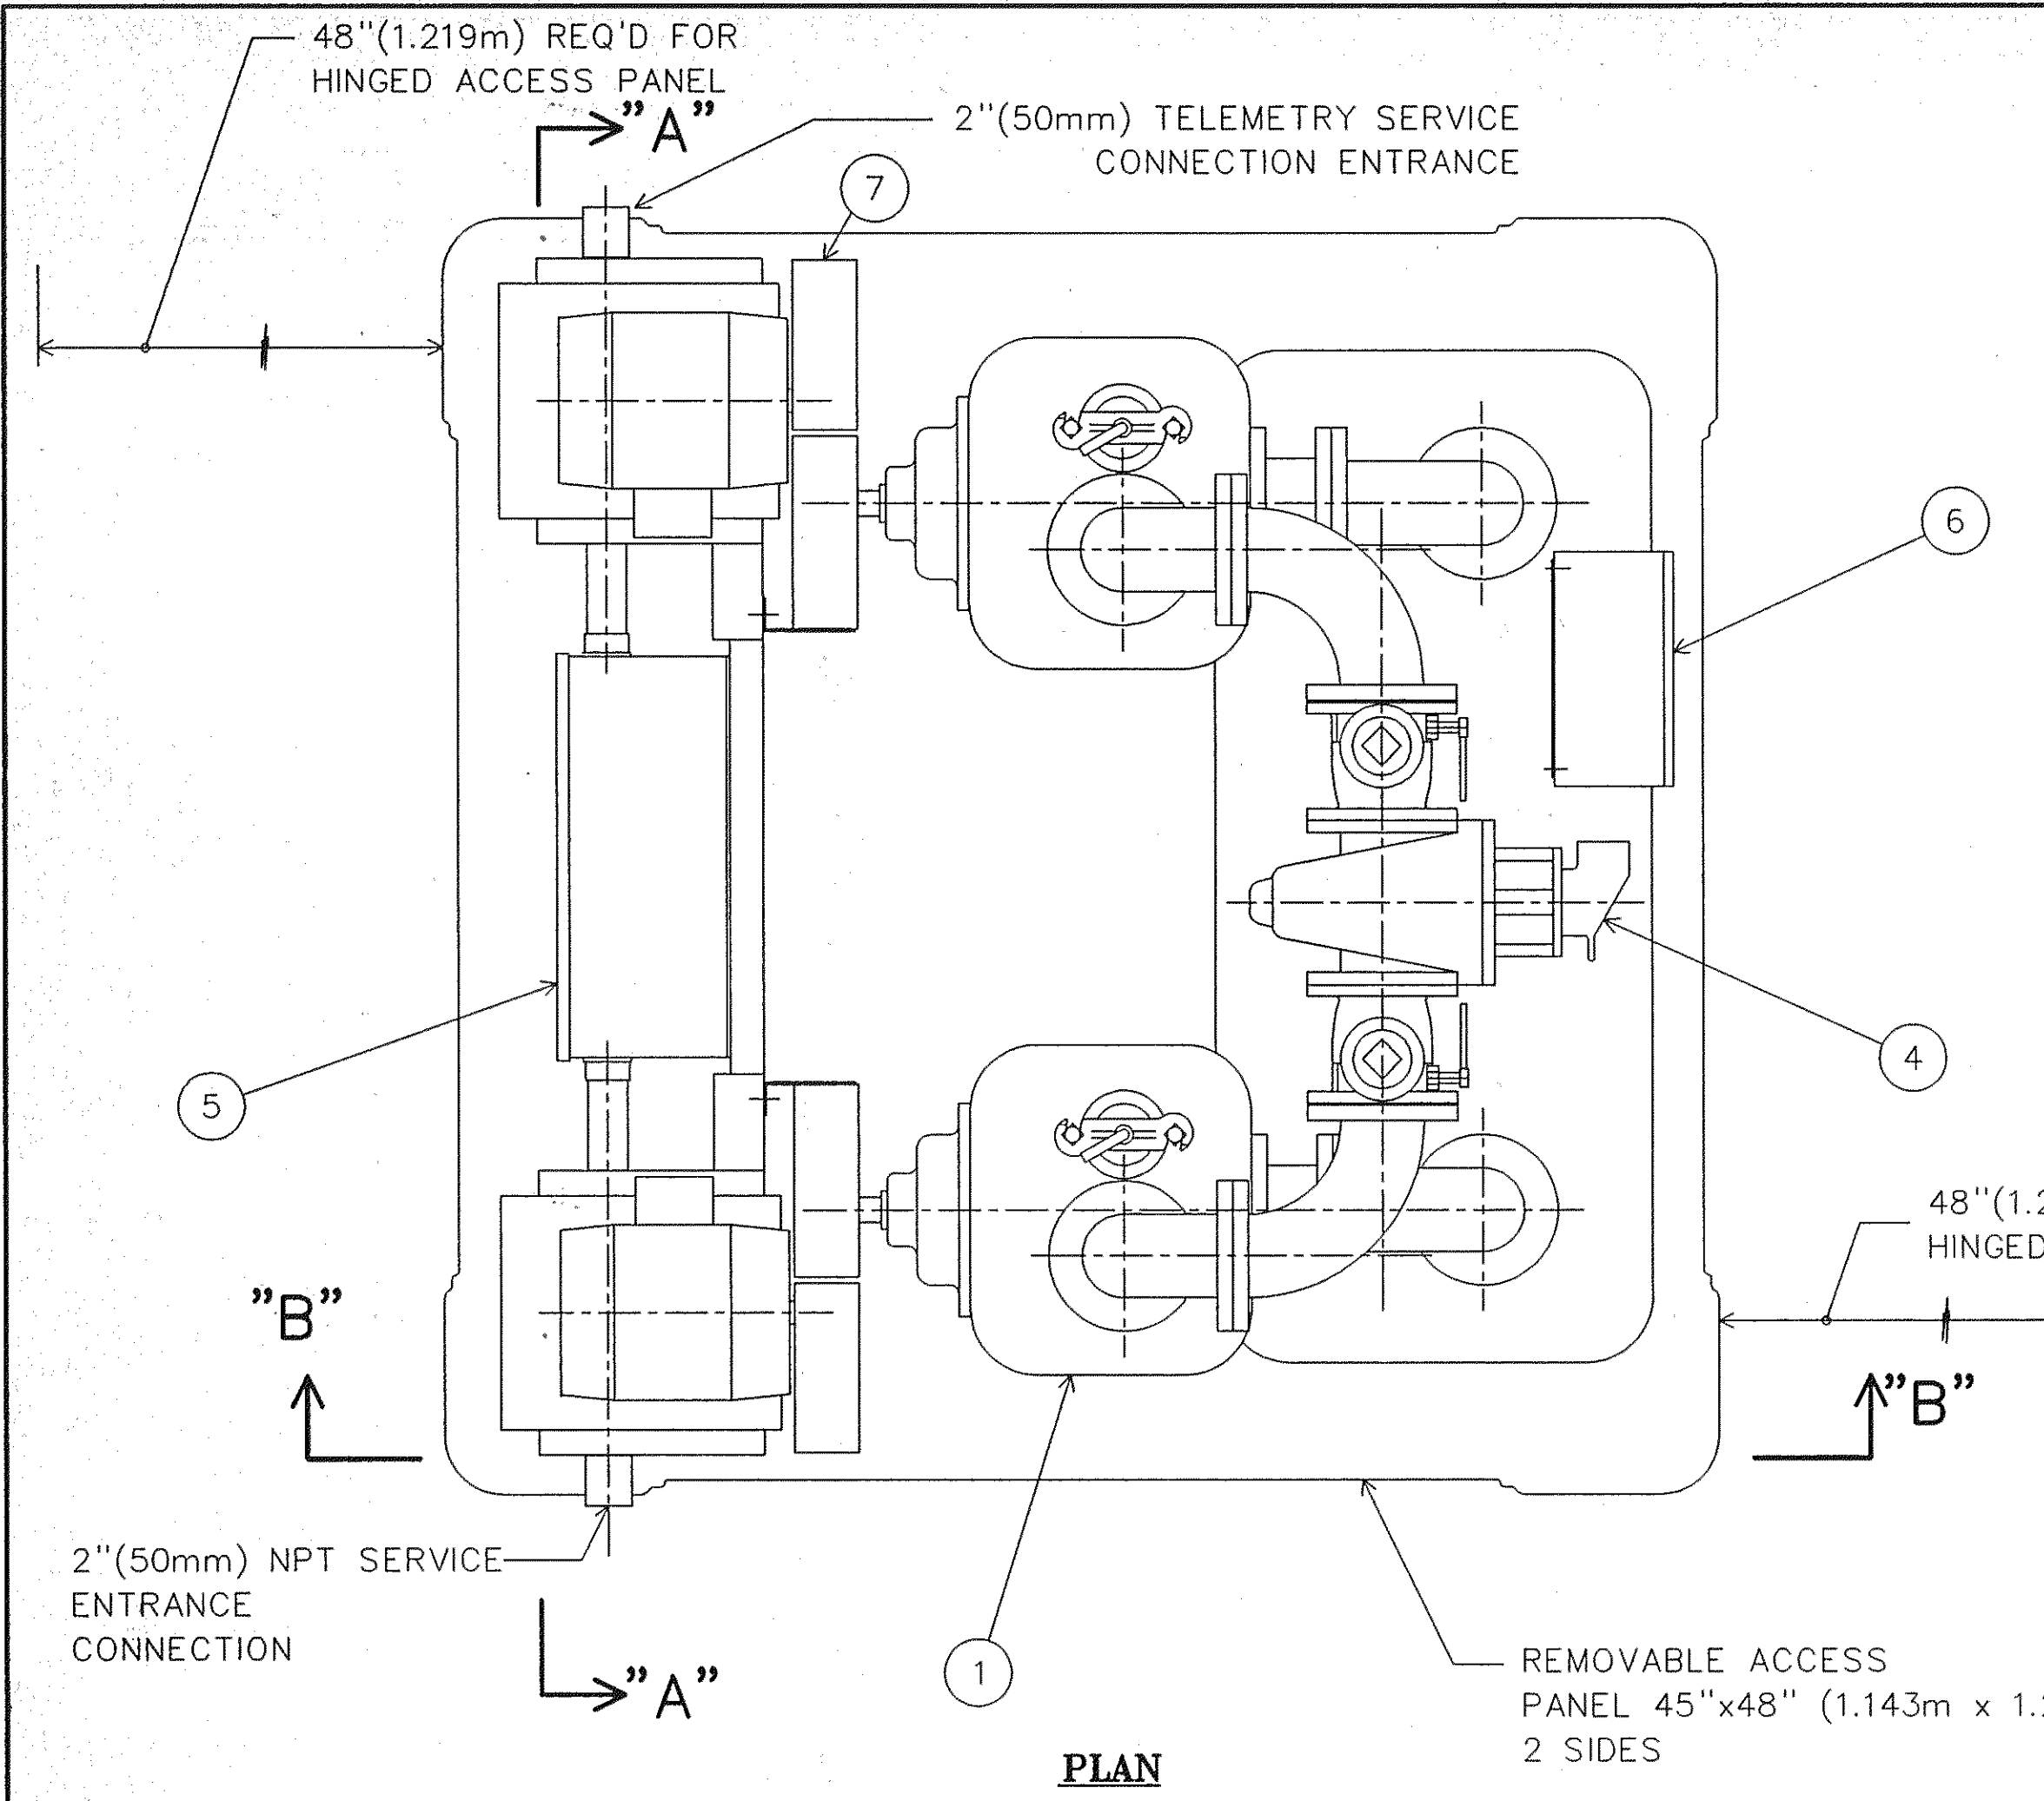


ELEVATION

5/8"(16mm) FOUNDATION BOLTS 4 REQ'D (BY OTHERS)
4"(100mm) BOLT PROJECTION FROM PAD

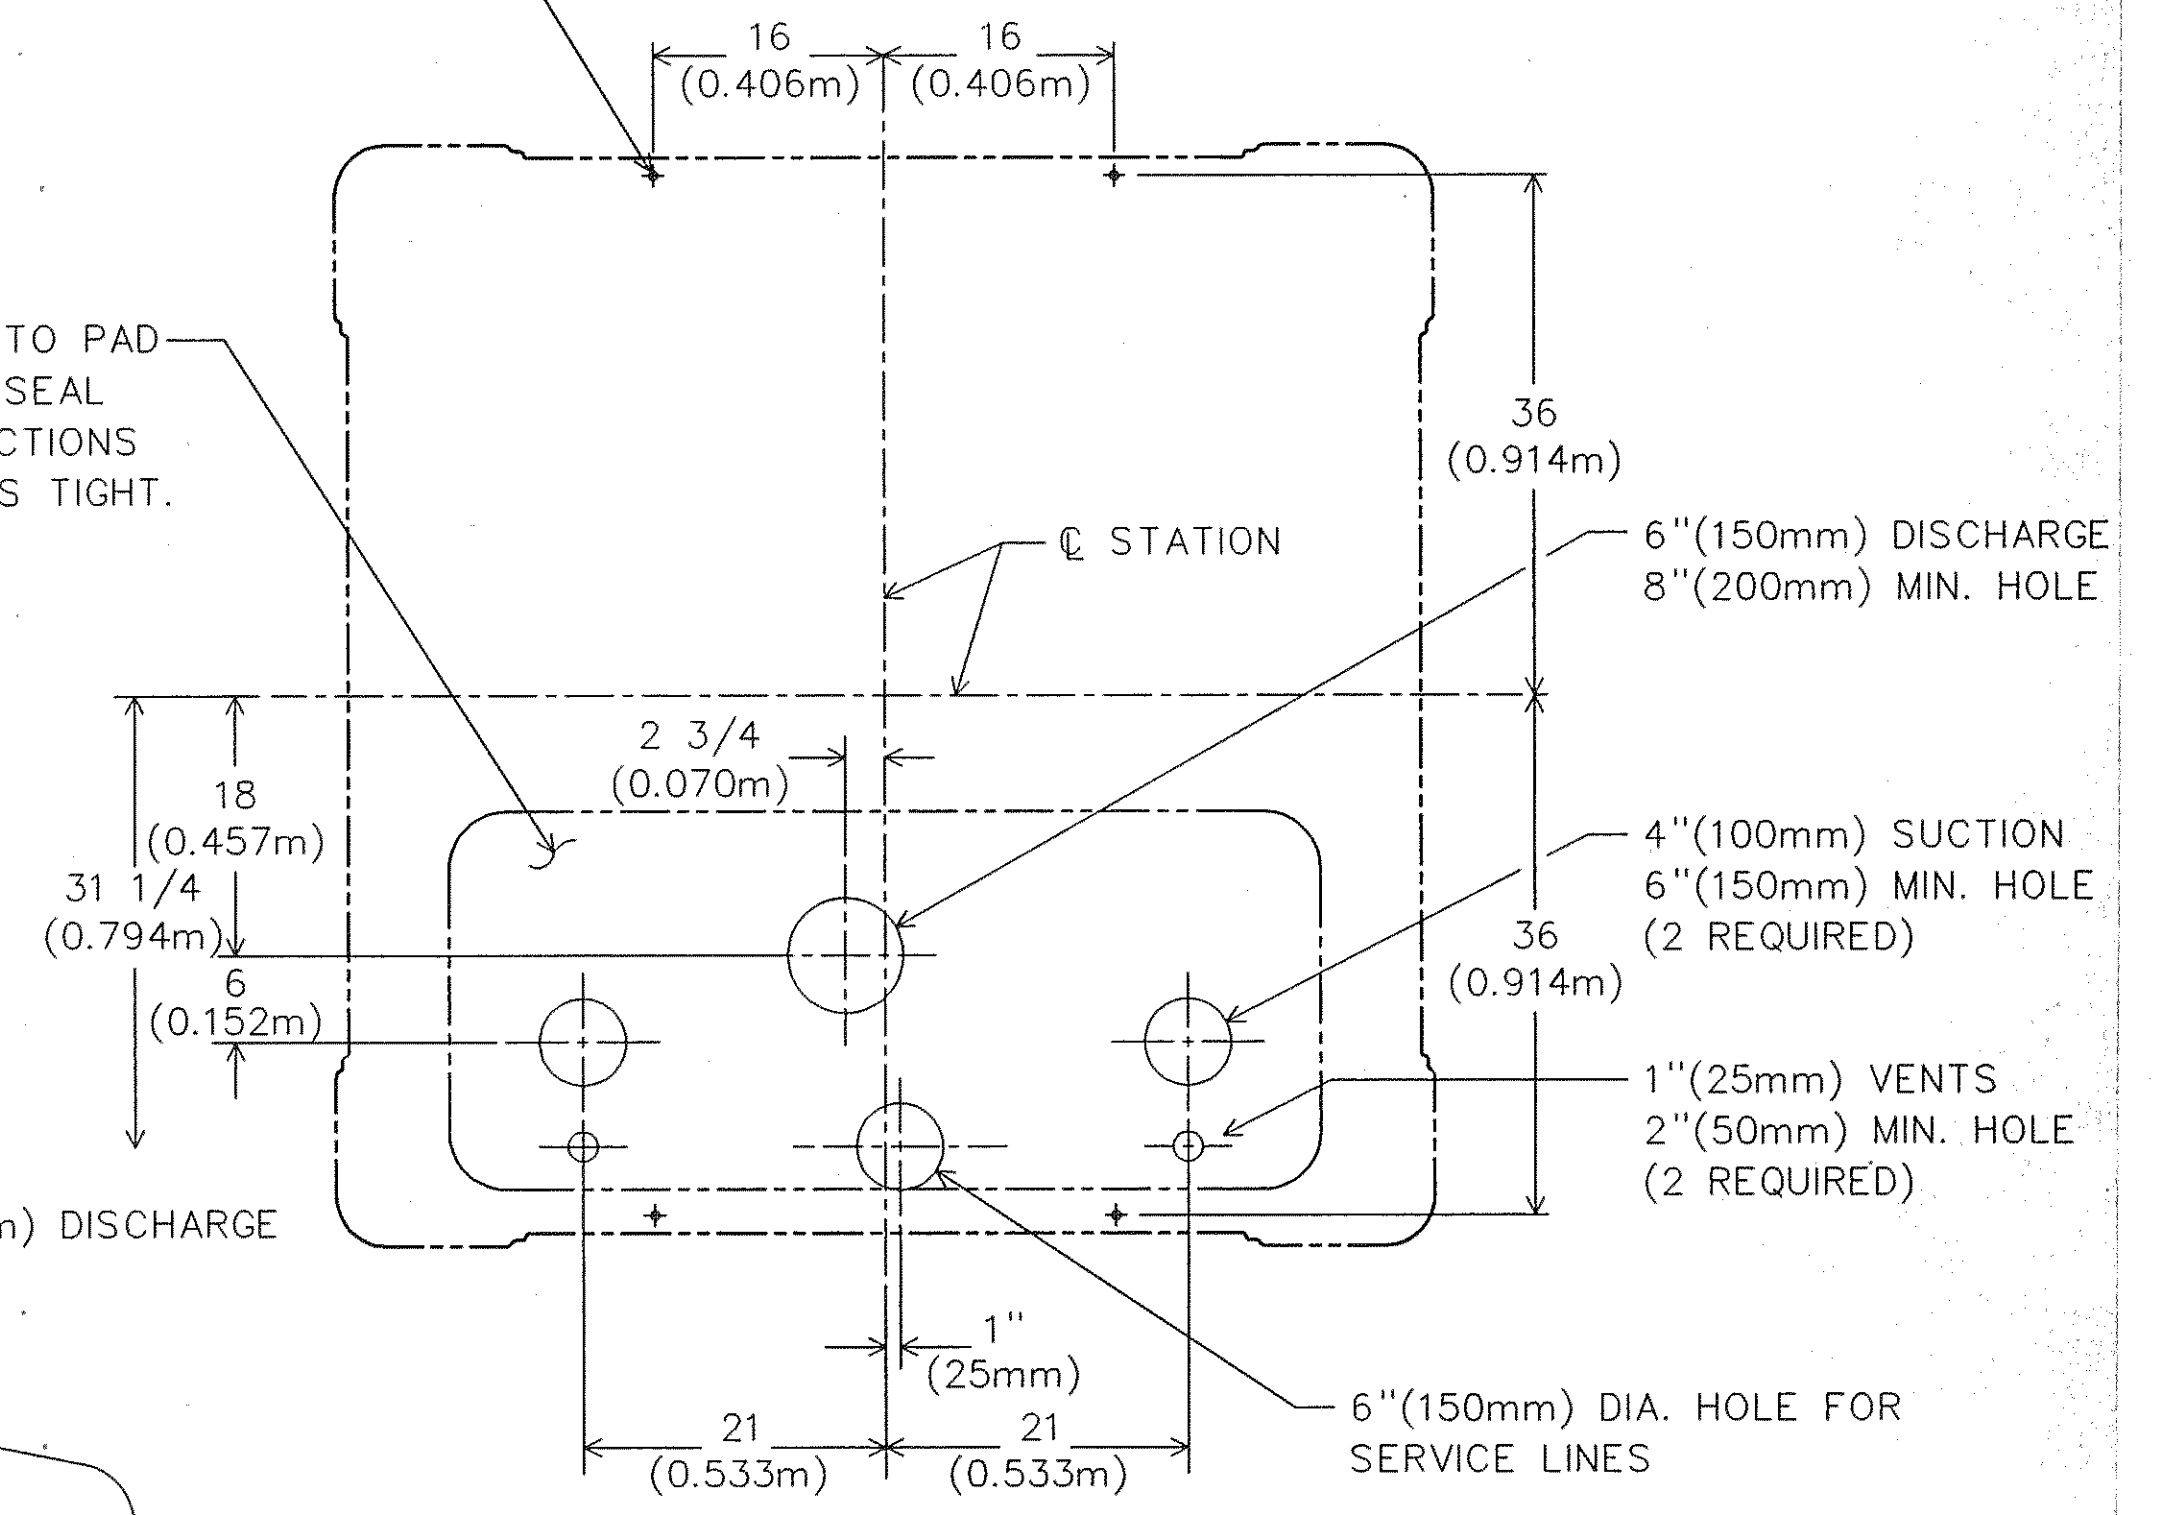


PLAN

THIS AREA OPEN TO PAD
INSTALLER MUST SEAL ALL THRU CONNECTIONS TO WET WELL GAS TIGHT.

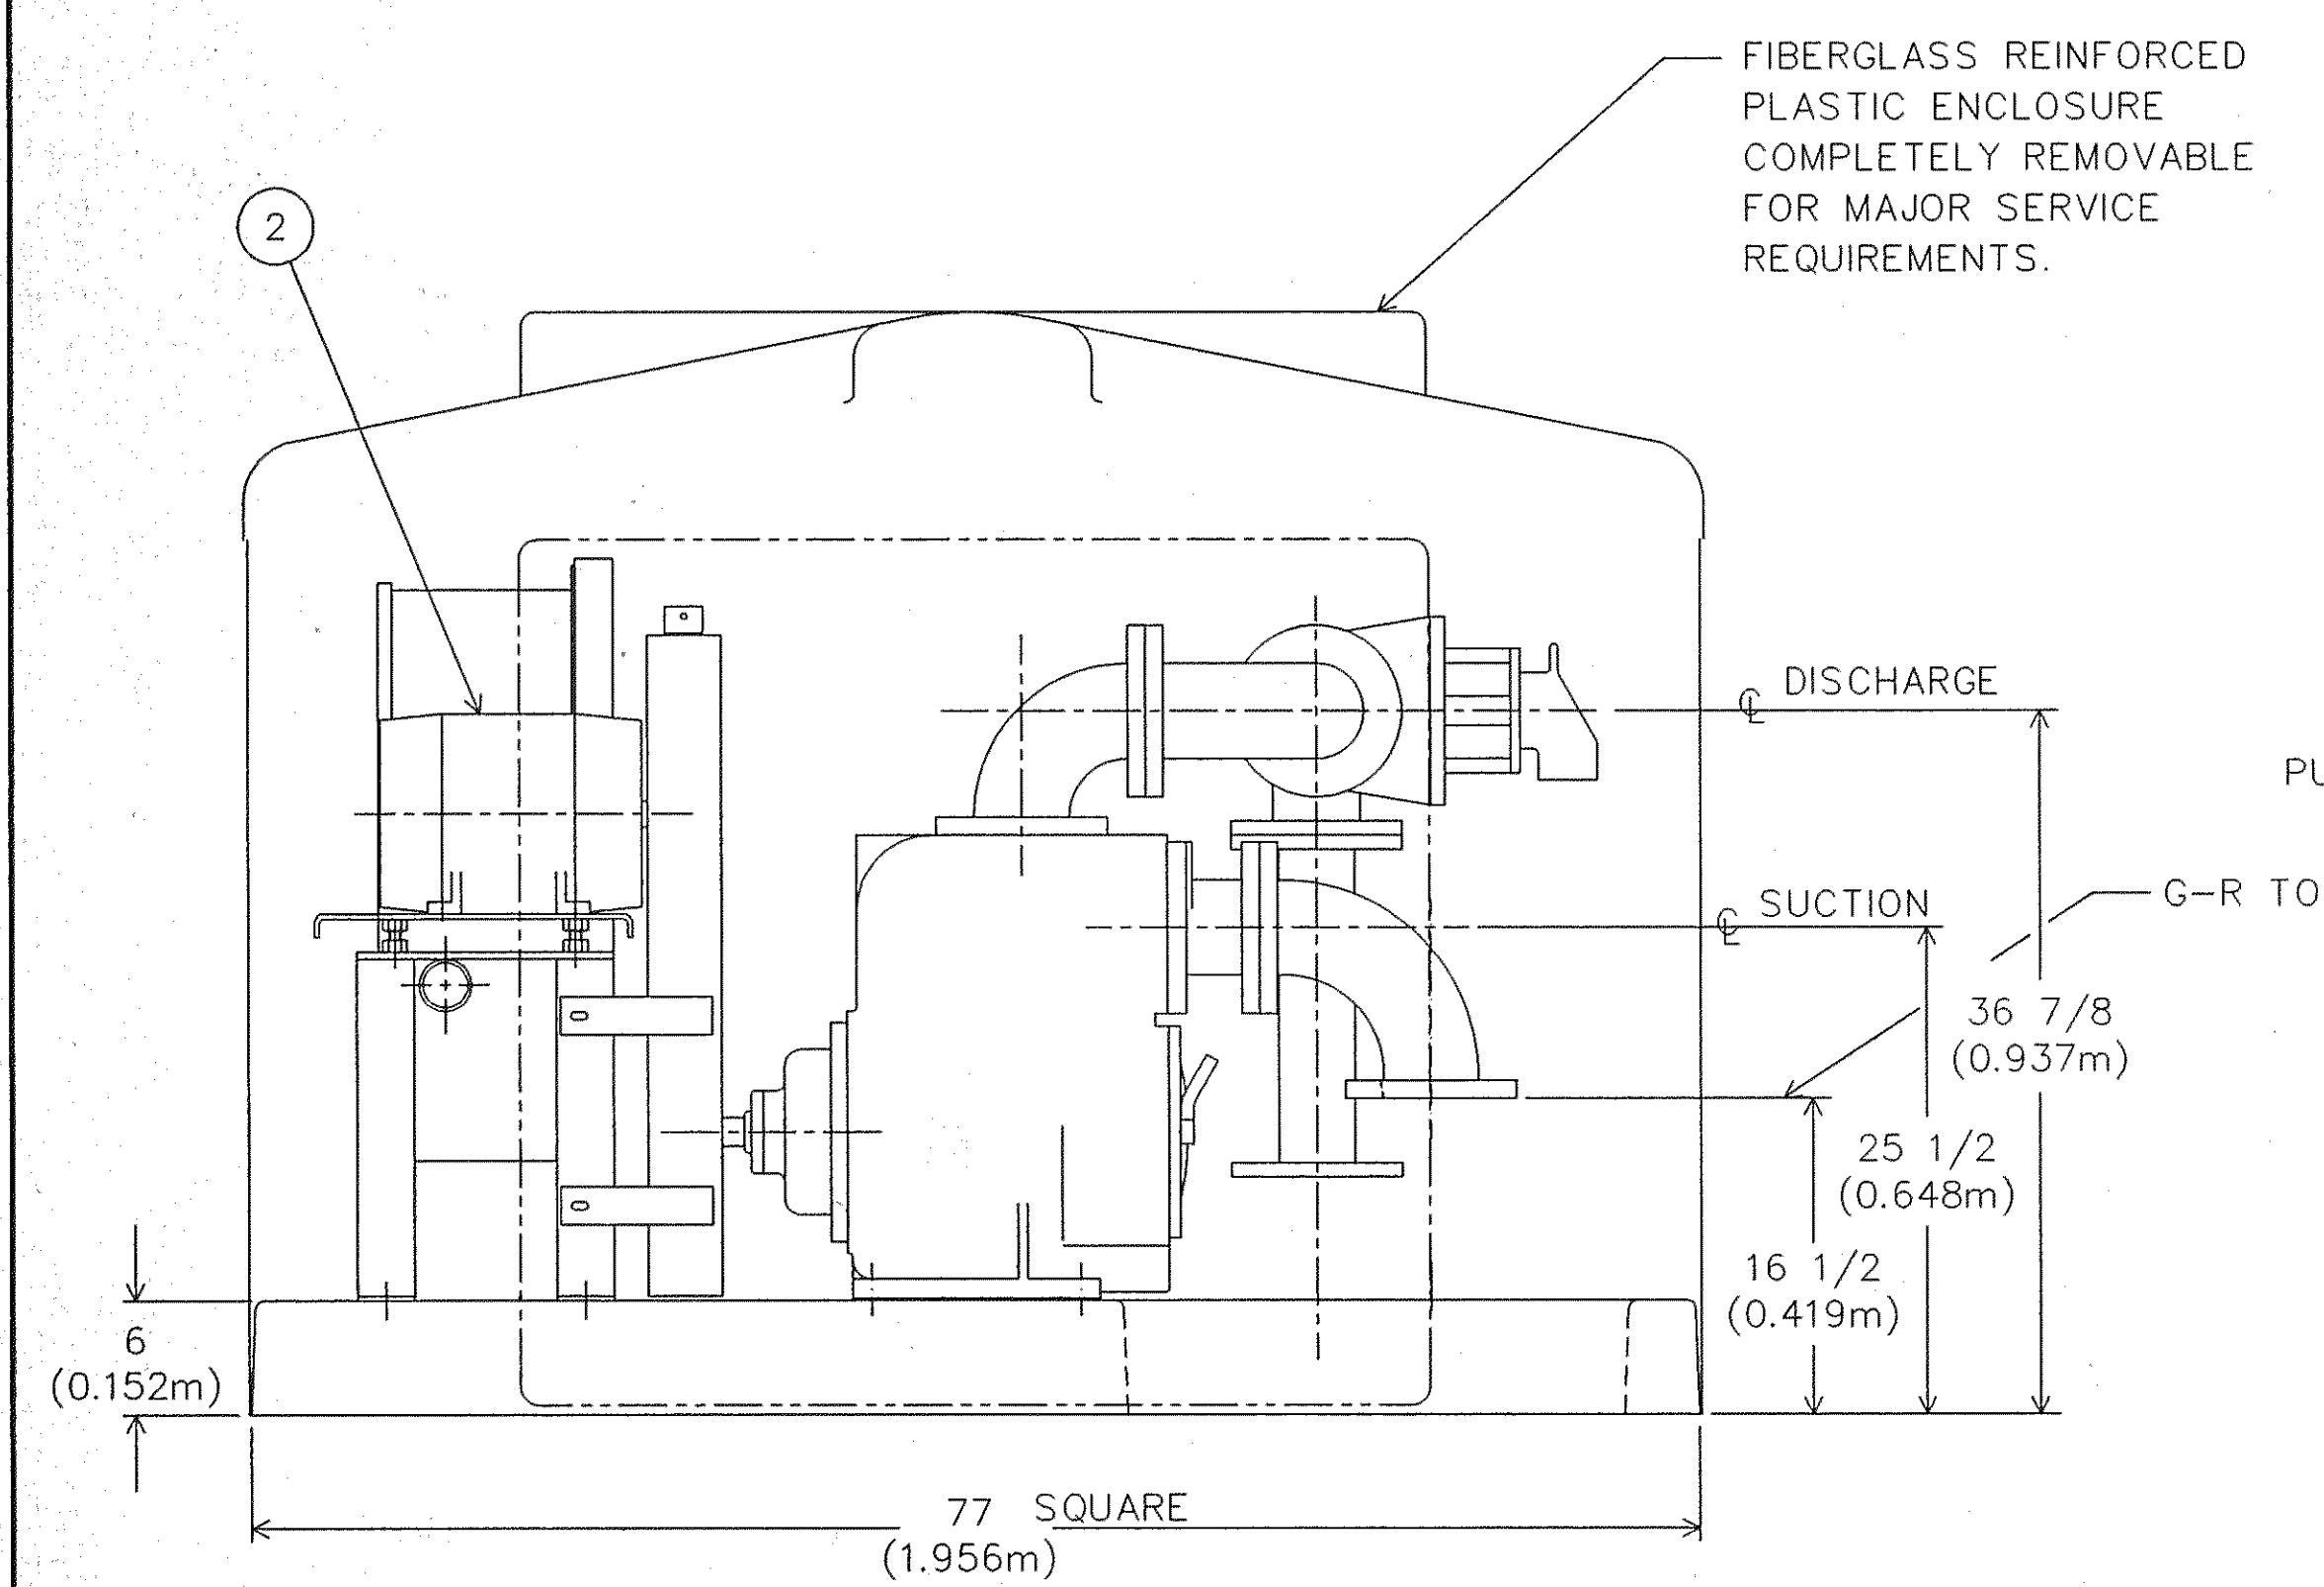

SECTION "A"

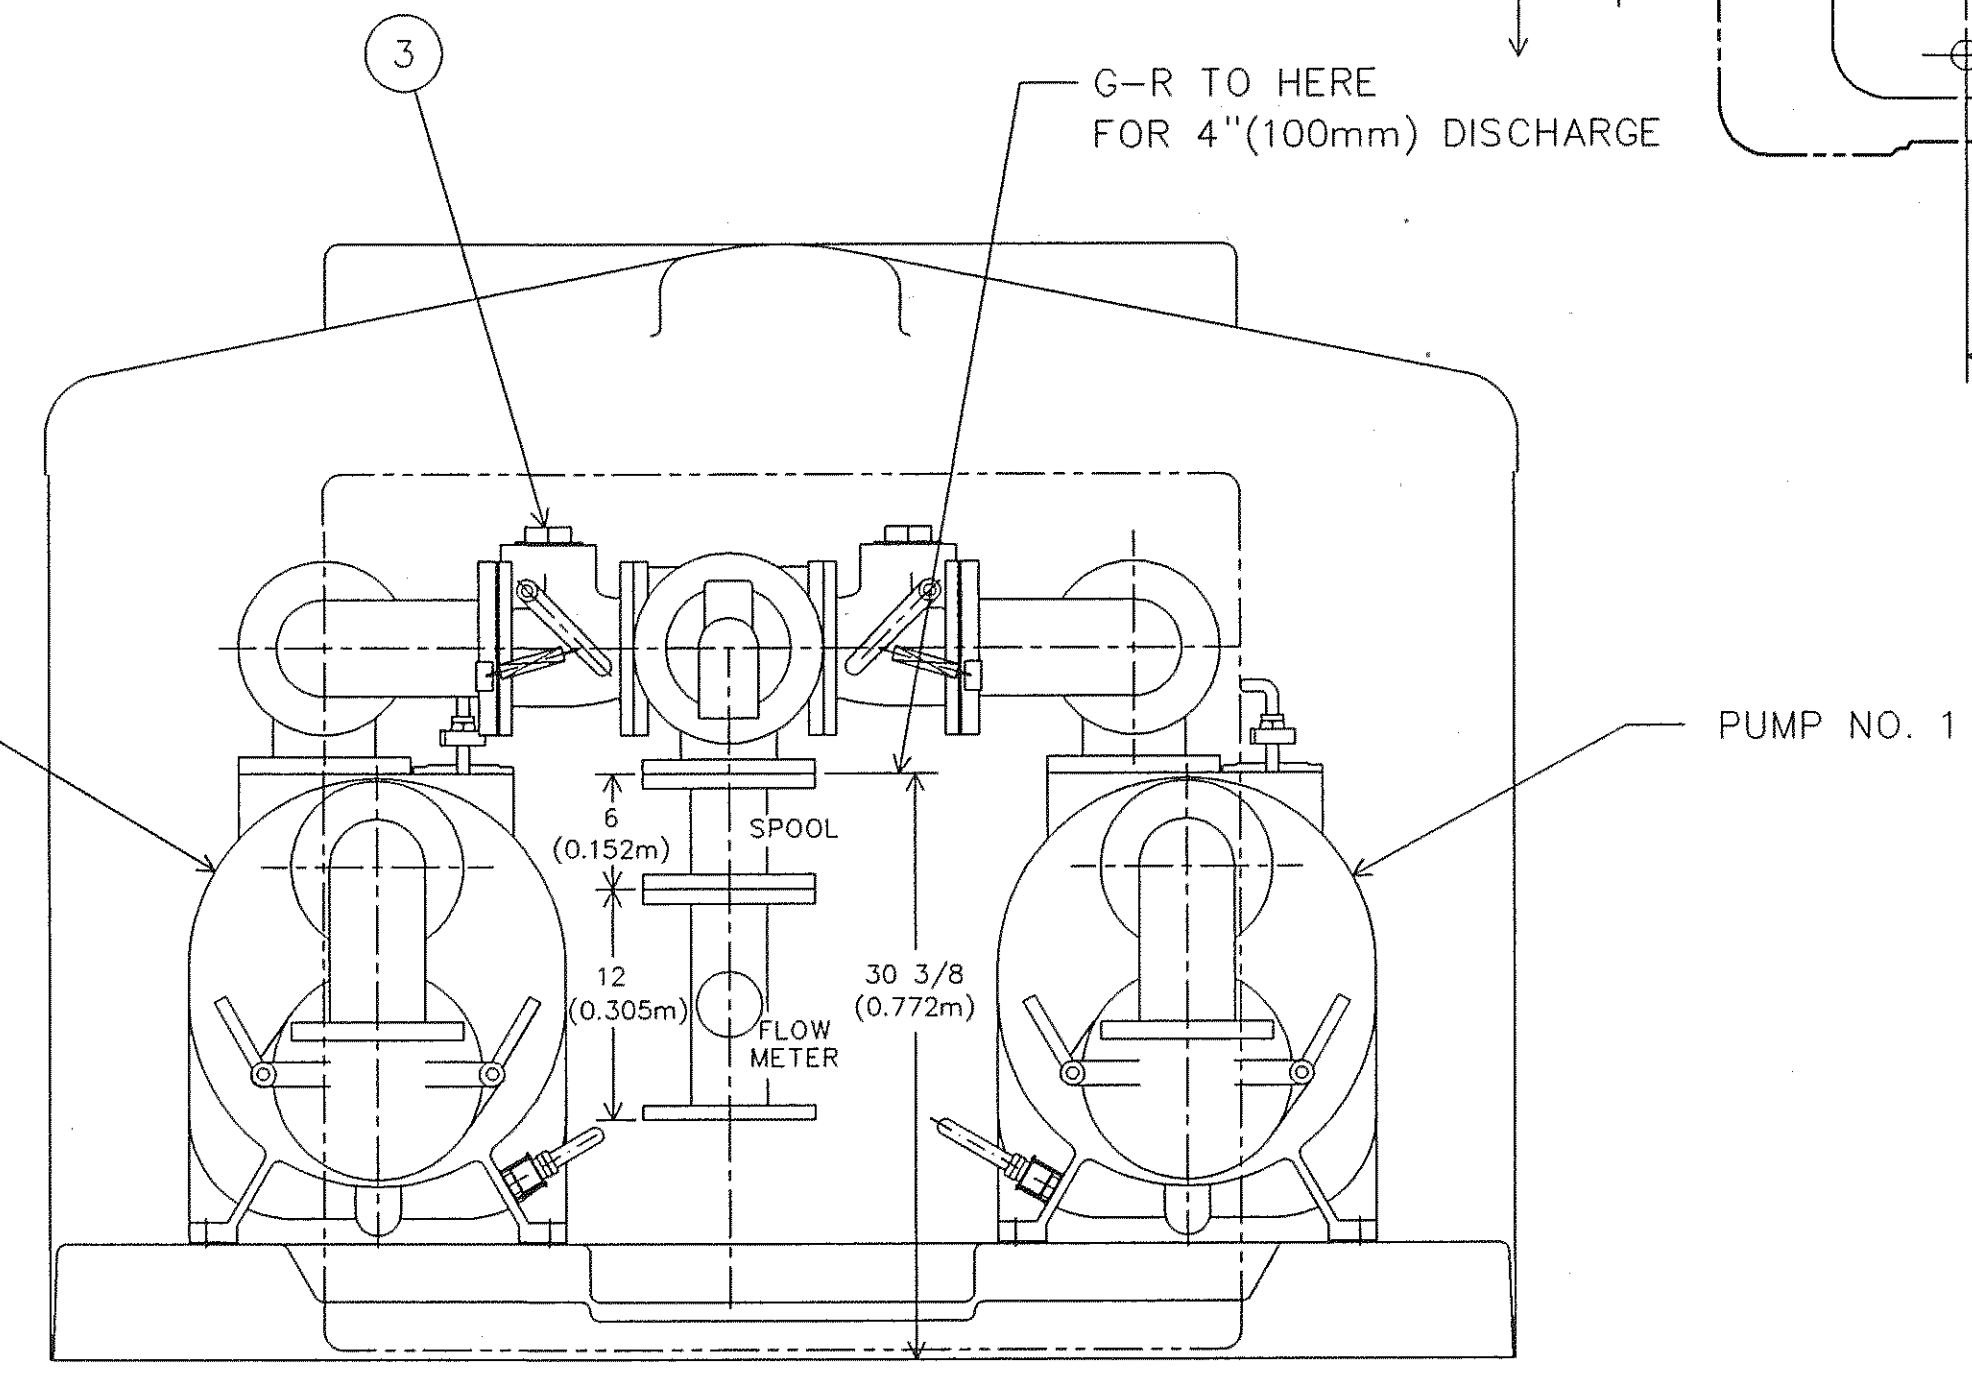

SECTION "A"

NOTE: CUSTOMER SUCTION AND DISCHARGE CONNECTIONS ARE 125# FLANGE

4 X 4 X 4 AS SHOWN
4 X 4 X 6 WITH INCREASER



THE GORMAN-RUPP CO.
MANSFIELD, OHIO ST. THOMAS, ONTARIO

NAME 6' X 6' ABOVEGROUND SEWAGE LIFT STATION W/DUPLEX T4A3-B PUMPS				
DRN. BM	CHK. KEH	APP. PFB	DATE 3/24/75	SERIAL NO.
D 45121-007				

LEGEND	SYMBOL	DESCRIPTION
WATER	HYD	HYDRANT
SAN. SEWER	WV	WATER VALVE
STORM SEWER	PP	POWER POLE
GAS	LS	LAMP STD.
U.G. TELEPHONE	TR	TRANSFORMER
U.G. ELECTRICAL	CB	CATCH BASIN
	DW	DRYWELL
	PERC	PERC. HOLE
	PP	POWER POLE
	LS	LAMP STD.
	TR	TRANSFORMER
	TEL	TEL. SB
	ELECT	ELECT. SB

No.	MM/DD/YY	DATE	BY	REVISION	Chk'd	No.	MM/DD/YY	DATE	BY	REVISION	Chk'd
1	09/13/96		R.H.	FLOW METER ADDED TO STATION	D.E.P.						
2	11/01/96		E.B.B.	FLOW METER RELOCATED, VENT PIPES ADDED	D.E.P.						
3	11/15/96		E.B.B.	FLOW METER RELOCATED, SPOOL ADDED	D.E.P.						

REG. DIST. OF CENTRAL OKANAGAN

PROFESSIONAL ENGINEER

D.E. PHILLIPS

VICTORIA B.C.

SCALE 1:10 IMPERIAL

WESTSIDE INDUSTRIAL PARK
REG. DIST. OF CENTRAL OKANAGAN
1450 K.L.O. ROAD KELOWNA, B.C. V1W-3Z4

LIFT STATION #2 - DETAILS

DRAWING NO. 1036-S14
REV. NO. 100.303
REV. NO. 3
PLOT DATE: 11-13-96 05:15 pm

WL-02991

45121007.DGN

ROSS ROAD LS 22


STN #2

REPRIMING LIFTS

650 rpm	5 feet	750 rpm	8 feet
850 rpm	16 feet	950 rpm	19 feet
1050 rpm	22 feet	1150 rpm	24 feet
1250 rpm	25 feet	1350 rpm	25 feet
1450 rpm	25 feet	1550 rpm	25 feet
1650 rpm	25 feet	1750 rpm	25 feet
1850 rpm	25 feet	1950 rpm	25 feet

Model T4A-B Size 4" x 4"
 Imp. Dia. 9 3/4"
 RPM VARIOUS
 Max. Sinks 3"

TEST PERFORMANCE
 70°F clear water at sea level
 4 foot horizontal offset with
 4 inch suction pipe

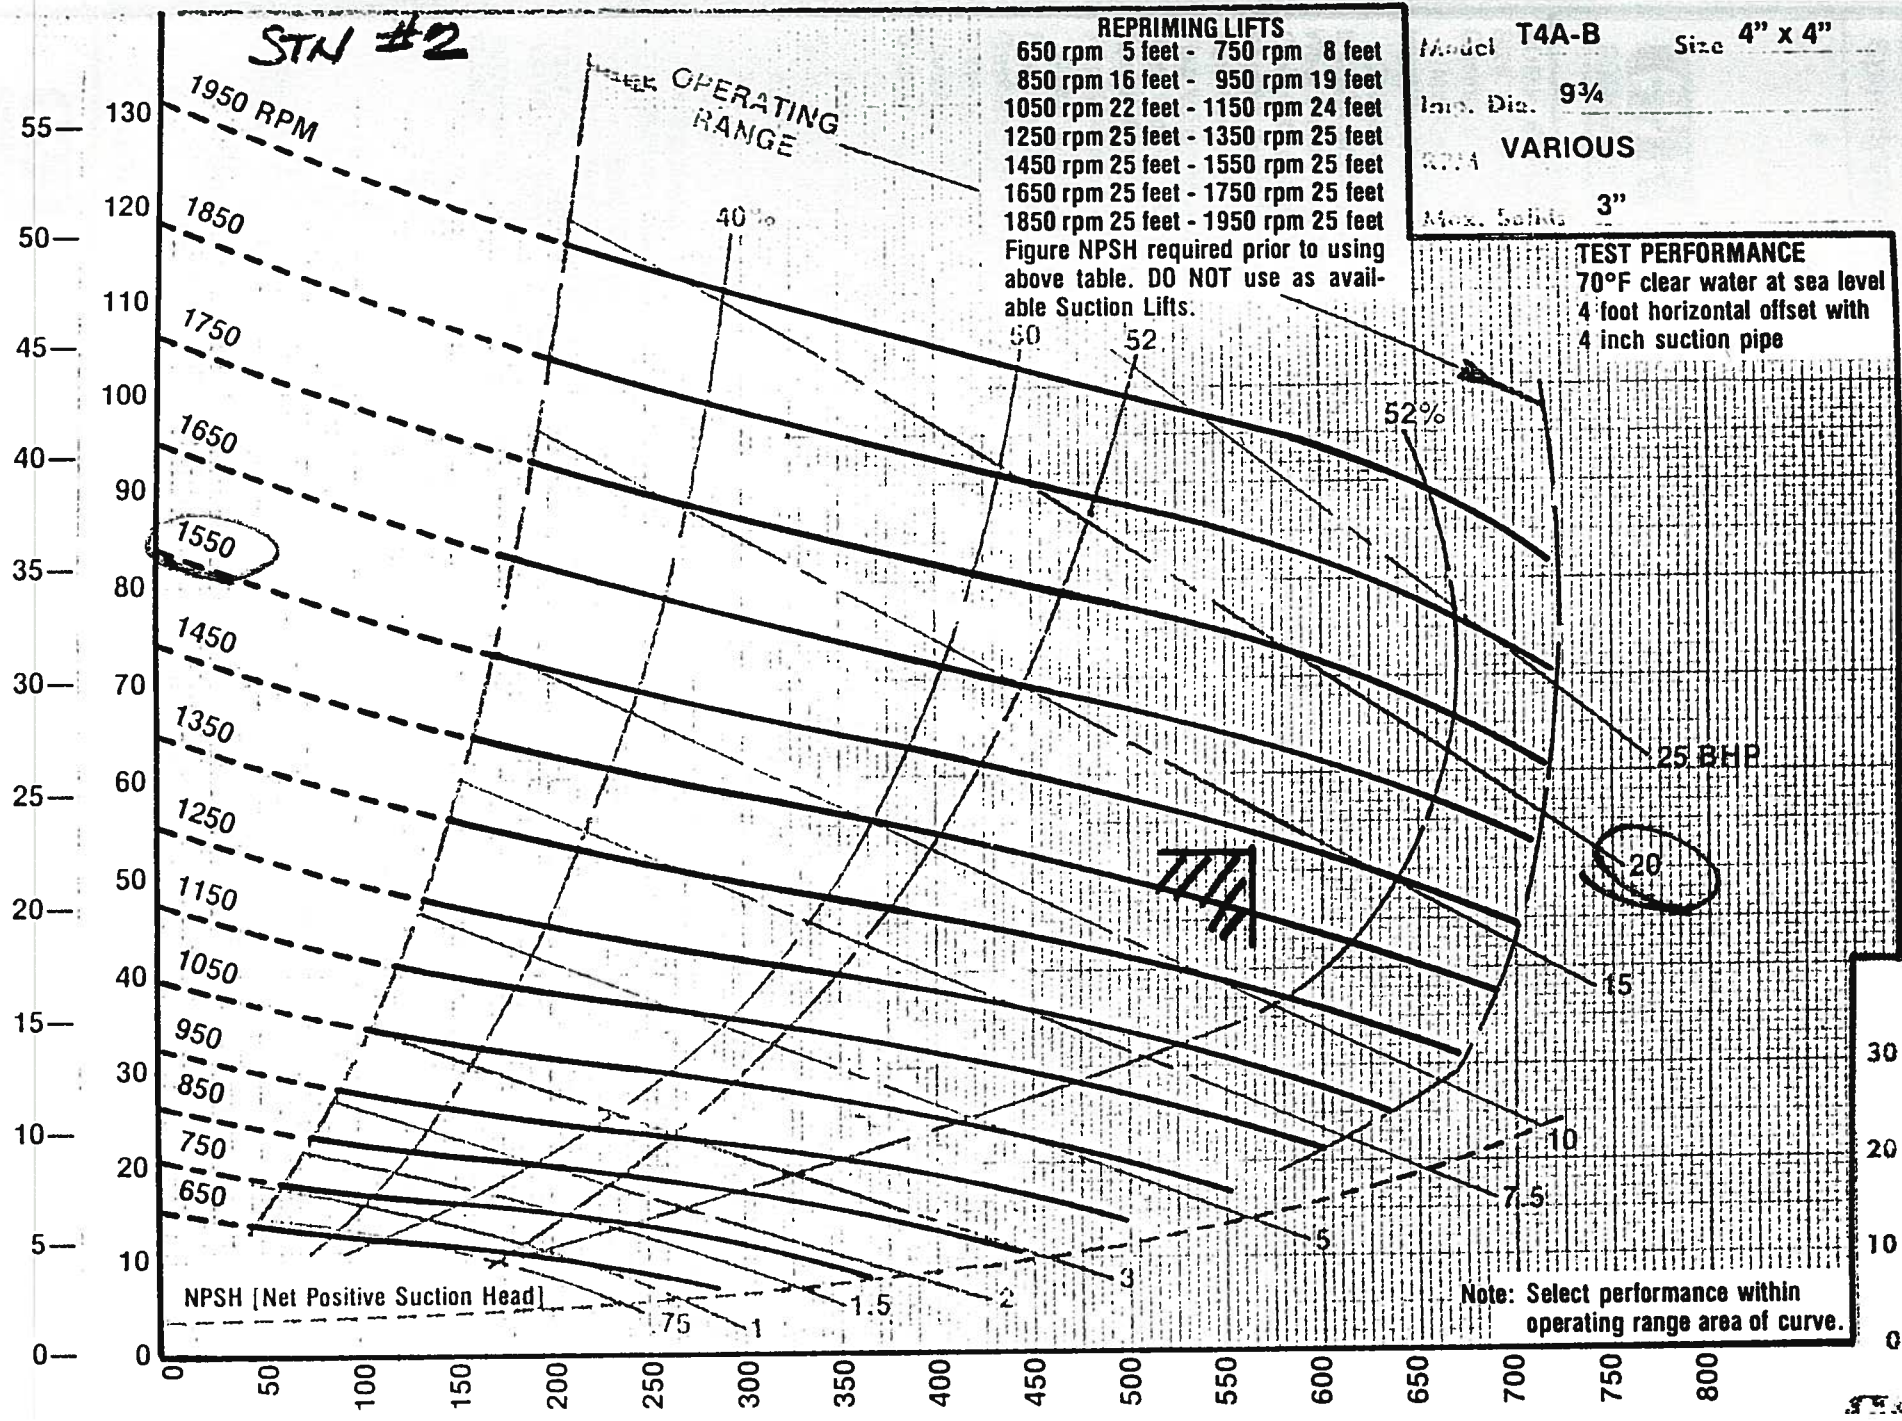

PERFORMANCE CHART NO. T4A-4 2-21-79 SECTION 55 PAGE 1154 REQUIRED NPSH



District of West Kelowna

Sanitary Lift Station Evaluation

Station: Brentwood Road LS 23
Inspection By: Jim Kentel

Year Constructed: 10/1/1997
Year Upgraded:

Matrix Rating				
(10 - highest rating)	Civil	40		
(1 - lowest rating)	Process Mechanical	86		
	Electrical Instrumentation	125		
	Total Station Rating	251 (max. rating 370 points)		Matrix



Civil:Matrix
Rating

Parking Area:	_____	n/a
Drainage:	Good	10
Influent sewer:	200	10
Site access:	Good	10
Water service:	Yes	10
		40

Process Mechanical:Matrix
Rating


Station type:	Concrete / 1.8m MH	n/a
Number of pumps:	2	n/a
Pump Redundancy:	Yes	n/a
Pump Manufacturer / Type:	FLYGT	5
Pump Model:	CP 3102 MT	n/a
Rated Capacity:	9.0 L/S @ 10.1m TDH	n/a
Capacity Confirmation:	_____	n/a
Discharge pipe type / diameter:	PVC Sch 40/75	9
Header pipe type / diameter:	CI/75	5
Check valve type / diameter:	FLYGT HDL / 75mm	5
Isolation valve type / diameter:	Plug / 75mm	5
Piping Condition:	Poor	5
Emergency pumpout connection:	No	1
Pressure gauges:	No	1
Inlet bar screen:	No	1
Wetwell condition:	Good	8
Access Hatches:	Alum checker plate/ no good	8
Ladder / Platform:	/No	3
Wetwell benching:	concrete	8
Odour Control:	No	1
Ventilation:	No	1
Water washdown:	50mm yard hydrant	10
Confined Space Entry Requirements	Davit	10
		86

Electrical / Instrumentation:

Matrix
Rating


Service Type	V / A / Phase / Wire	n/a
Pump 1 :	HP 3.9	n/a
	Volts 230 Rpm 1730	n/a
	FLA 16A	n/a
Starting Current	45A	n/a
Pump 2 :	HP 3.9	n/a
	Volts 230 Rpm 1730	n/a
	FLA 16A	n/a
Starting Current	45A	n/a
Alarm Functions:	Yes	8
		n/a
		n/a
		n/a
Receptacle	Yes	10
Interior Lighting:		10
Exterior Lighting:		1
SCADA / Telemetry:		10
Main Breaker:		10
Control Panel:		10
Lighting Panel:		10
Flowmeter:	Yes not working	5
Grounding:		10
Surge Protection:		10
UPS:		10
PLC:		10
Level Control:	/Bulbs Milltronics level control	10
Standby Generator:	No	1
		125
Comments:		

"This as-constructed information was not prepared by the Regional District of Central Okanagan and therefore there is no guarantee of its accuracy. It is the recipient's and user's responsibility to confirm the accuracy of this as-constructed information before proceeding with any work that may be affected by this as-constructed information."

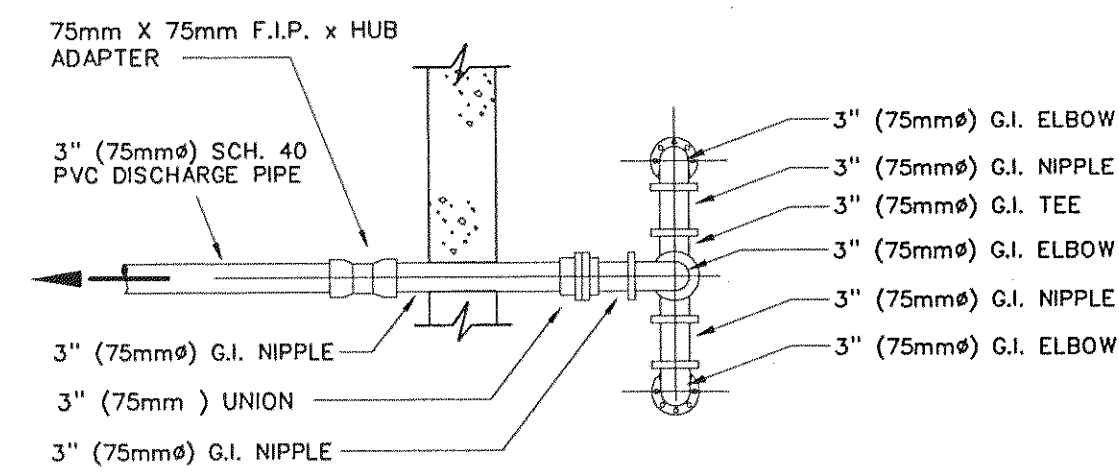


FORCEMAIN PIPEFITTING
PLAN DETAIL


N.T.S.

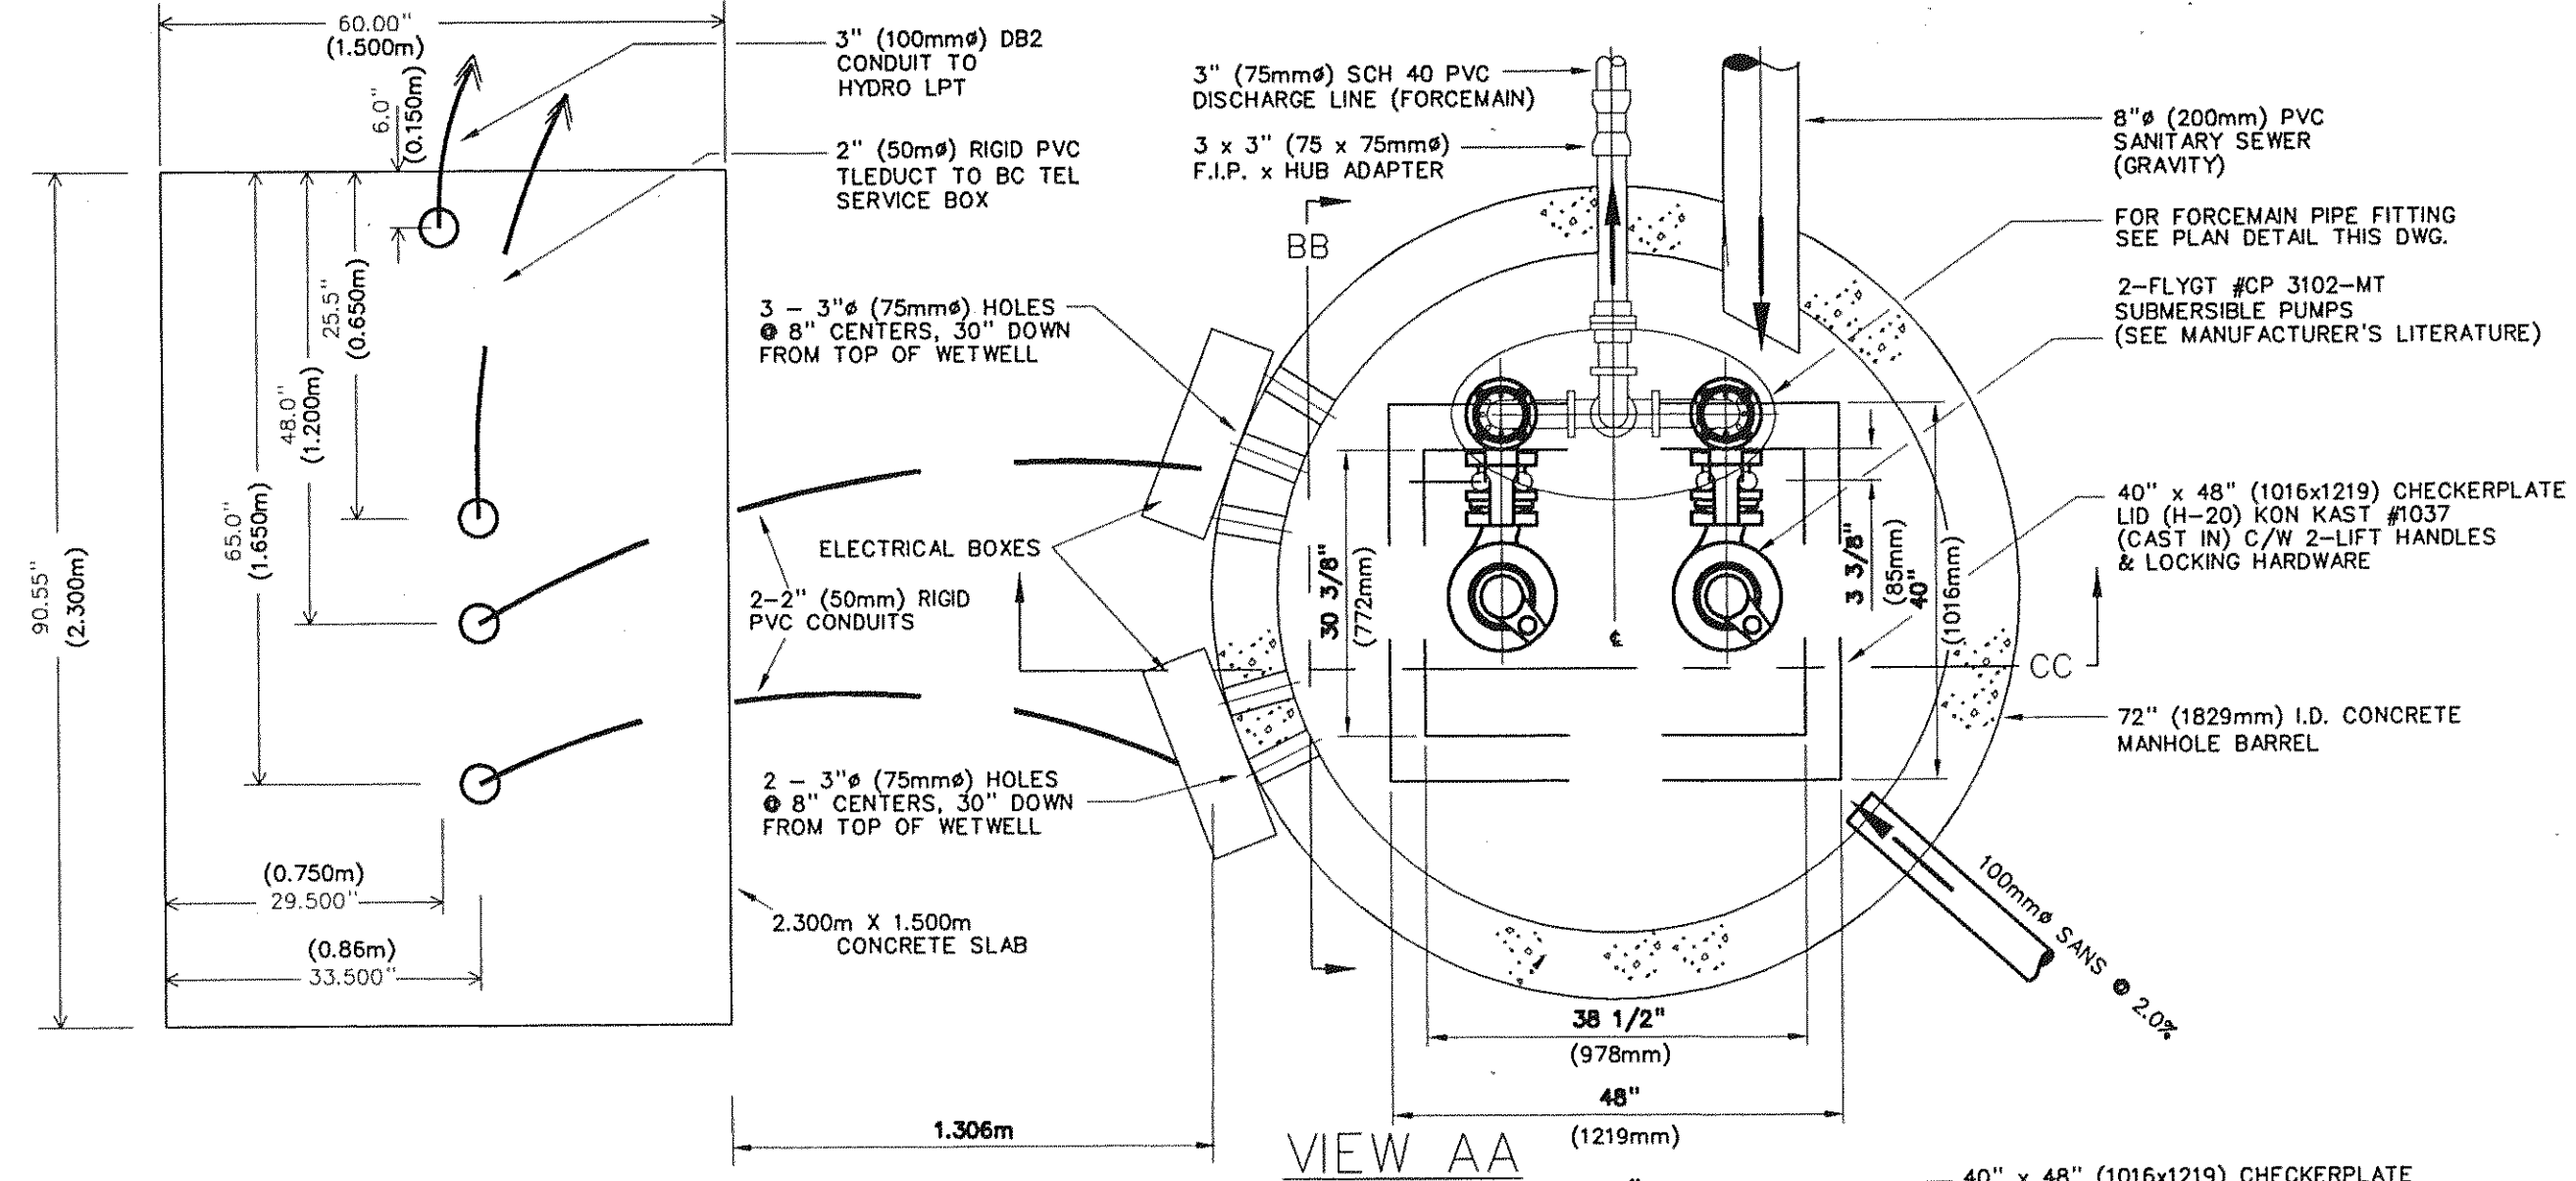


VIEW AA

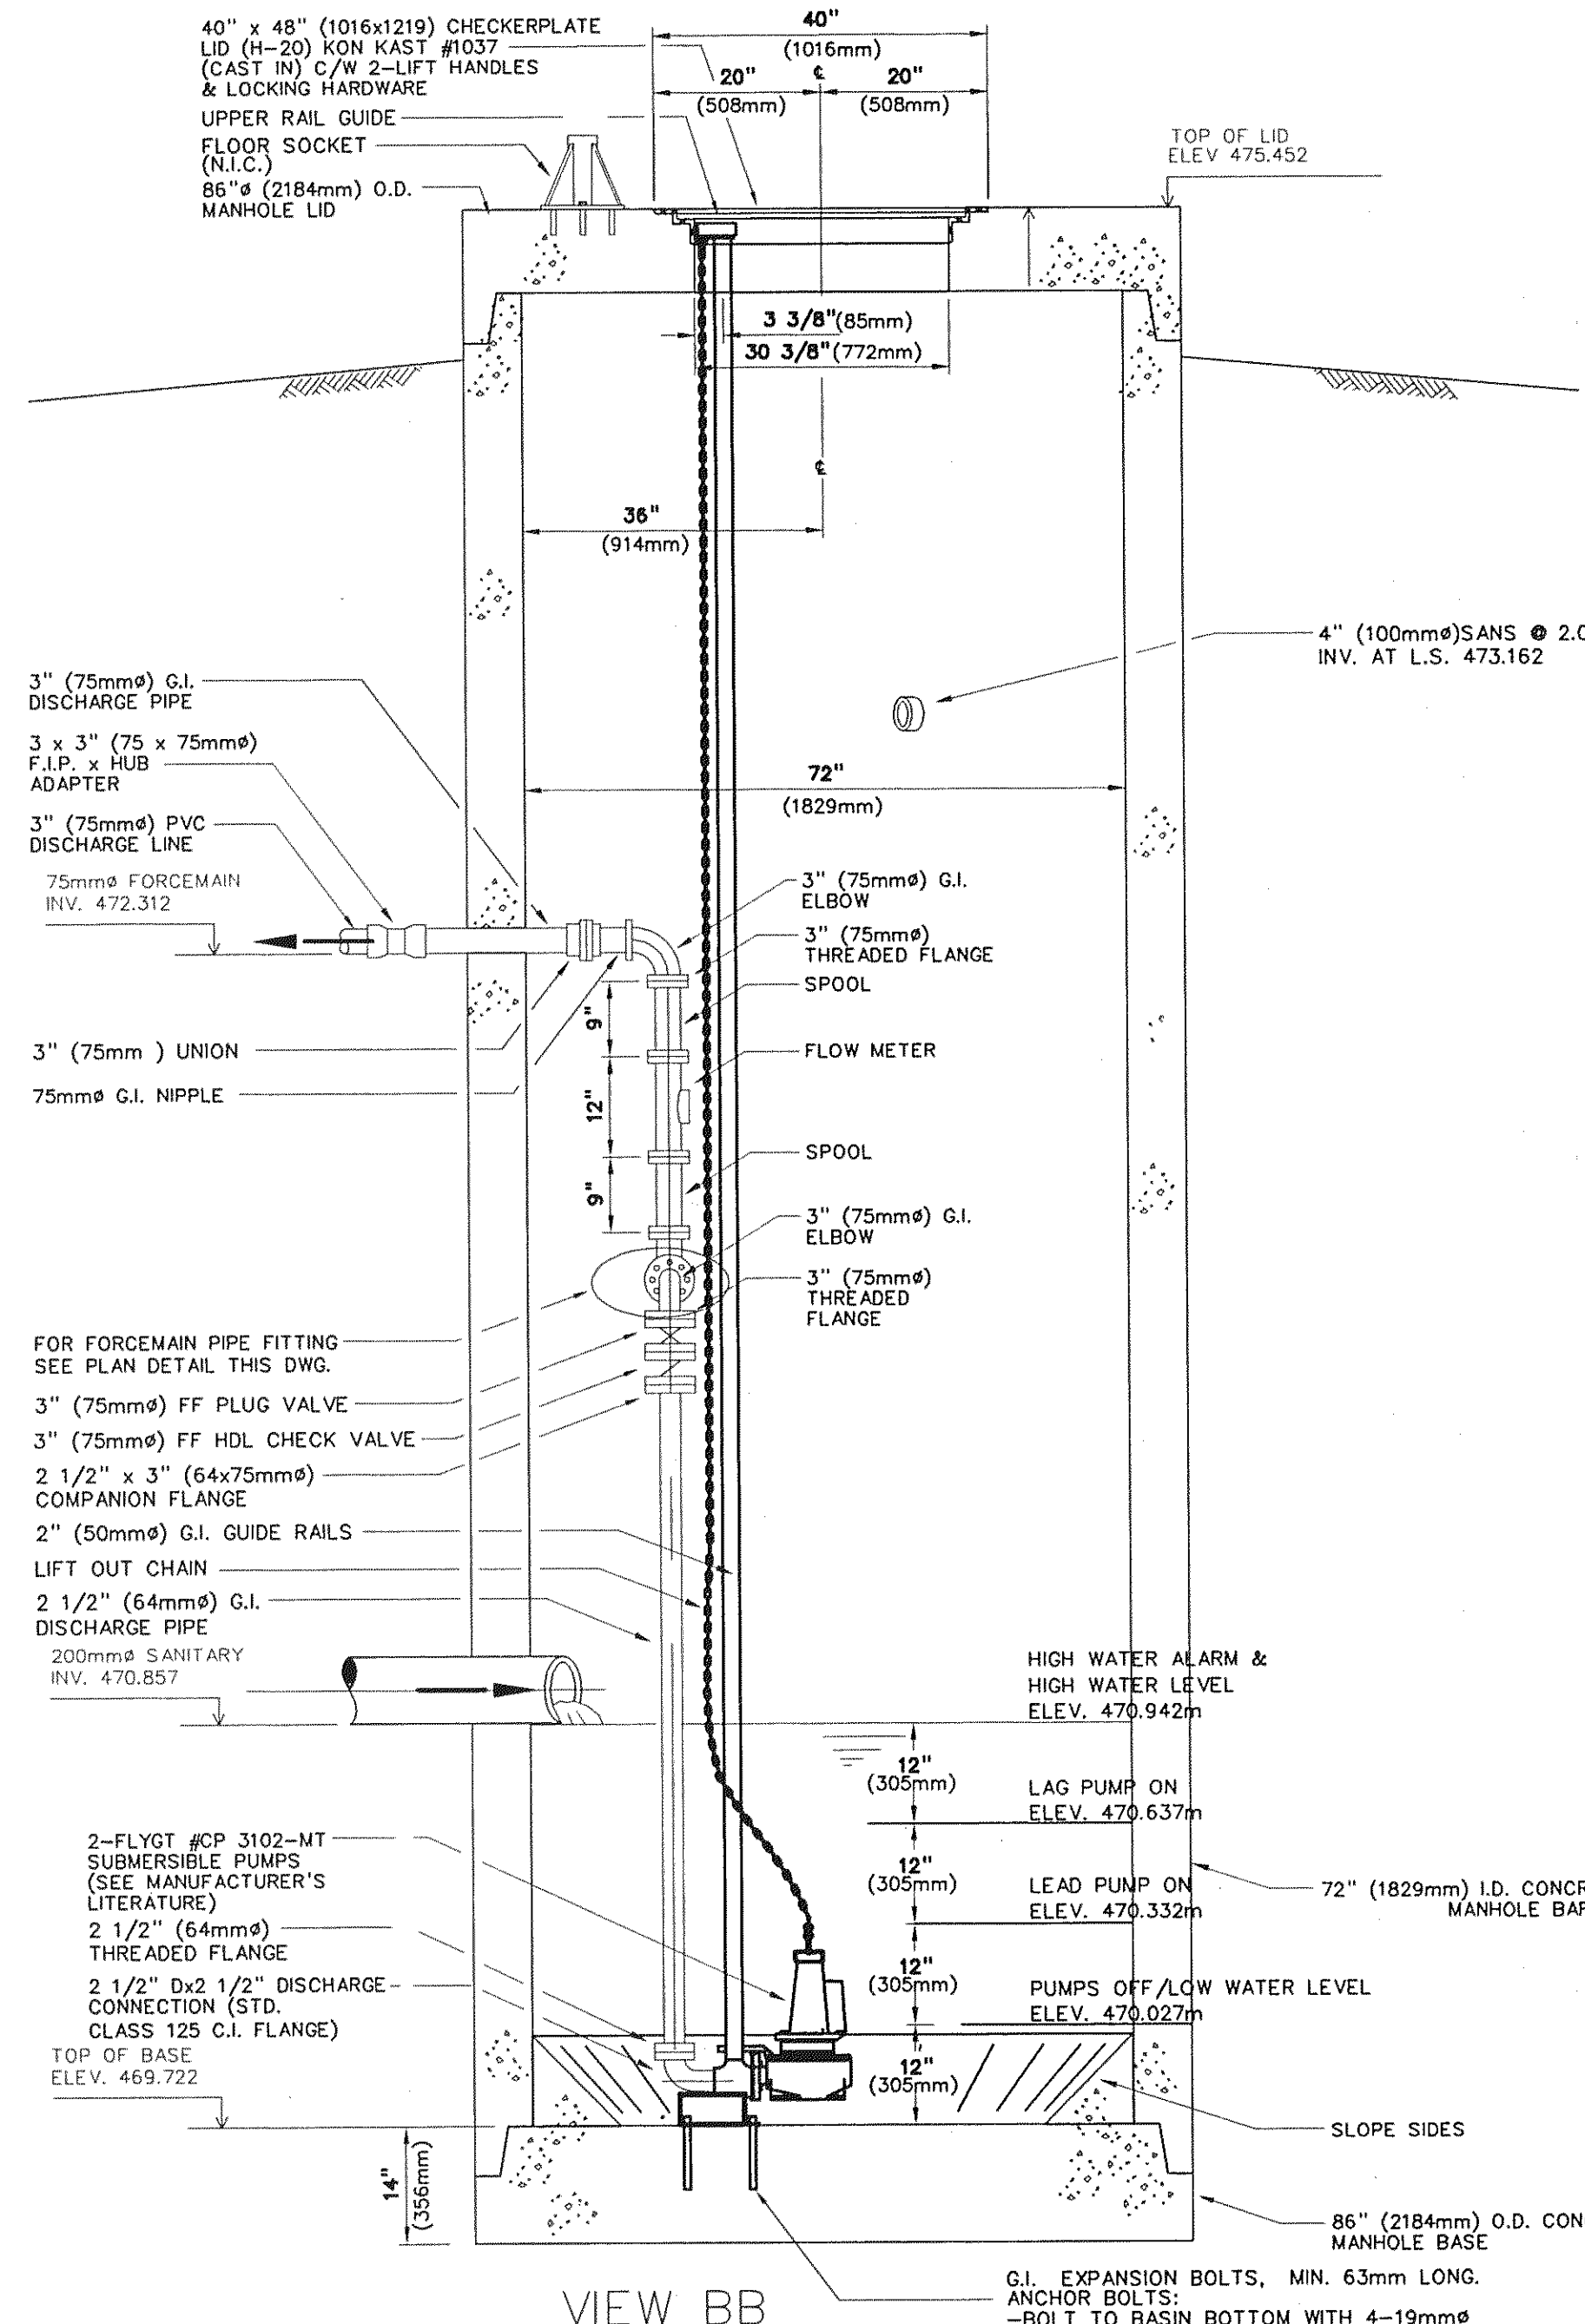

VIEW BB

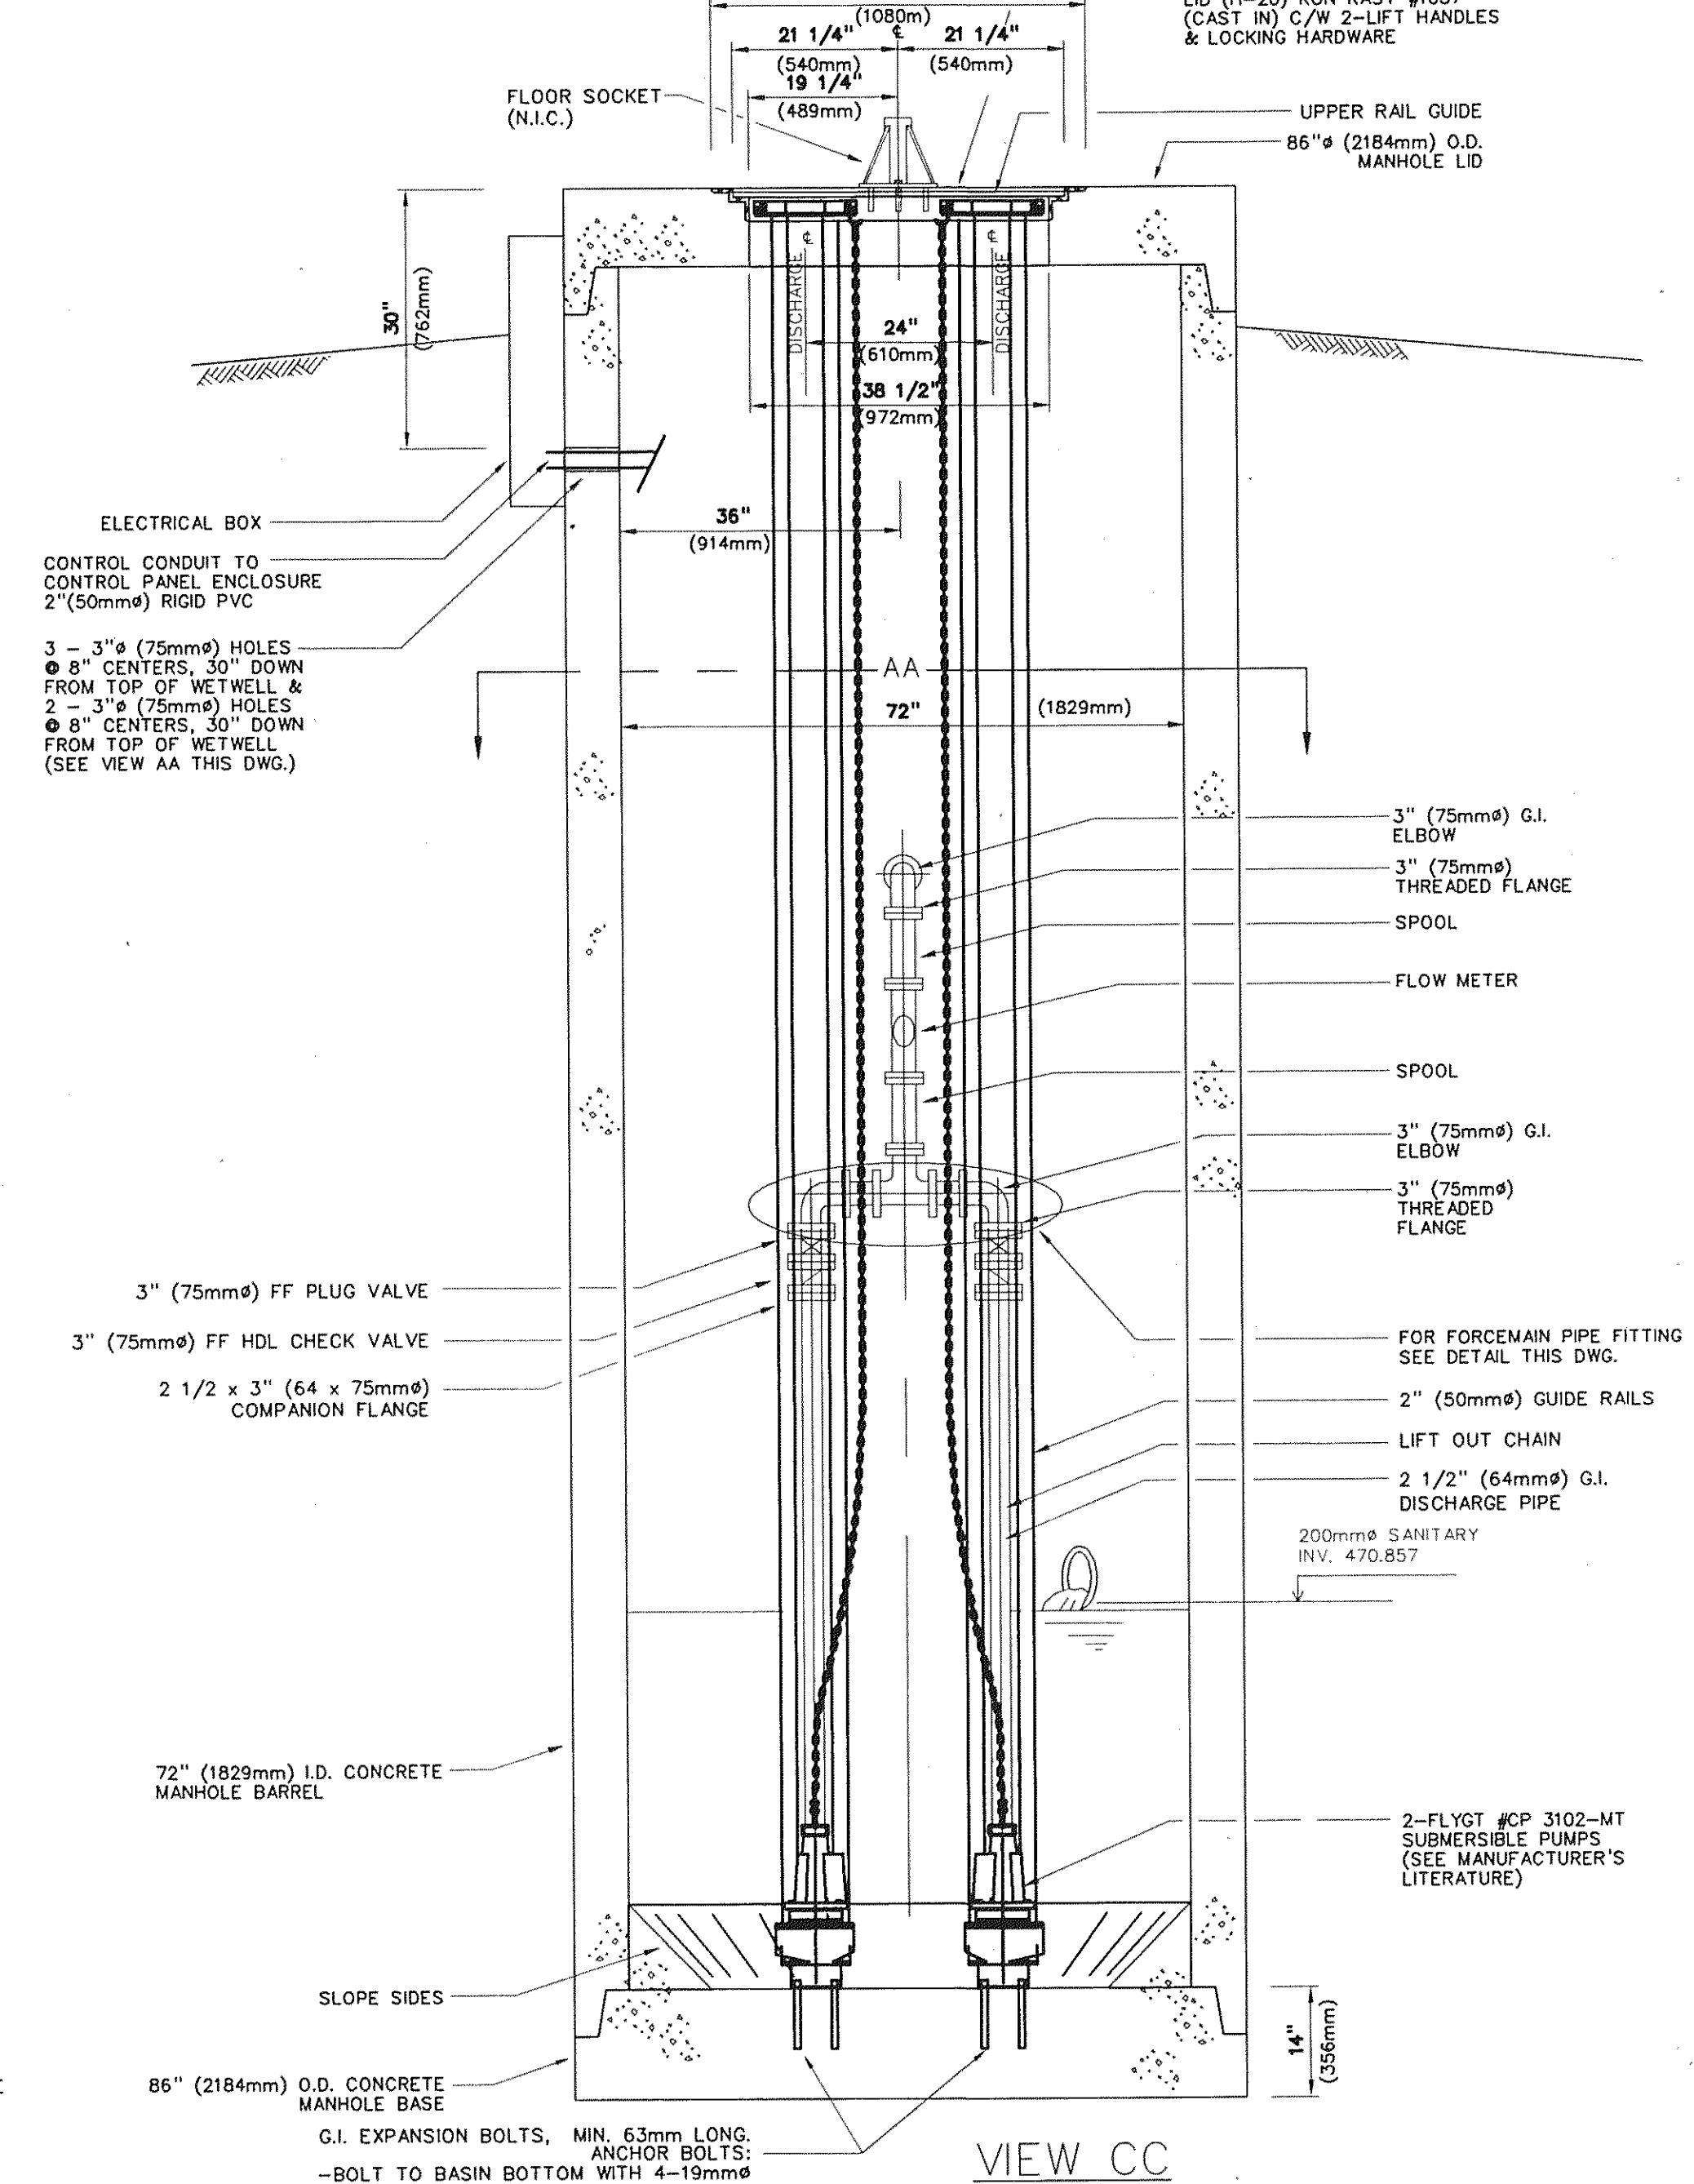


VIEW CC

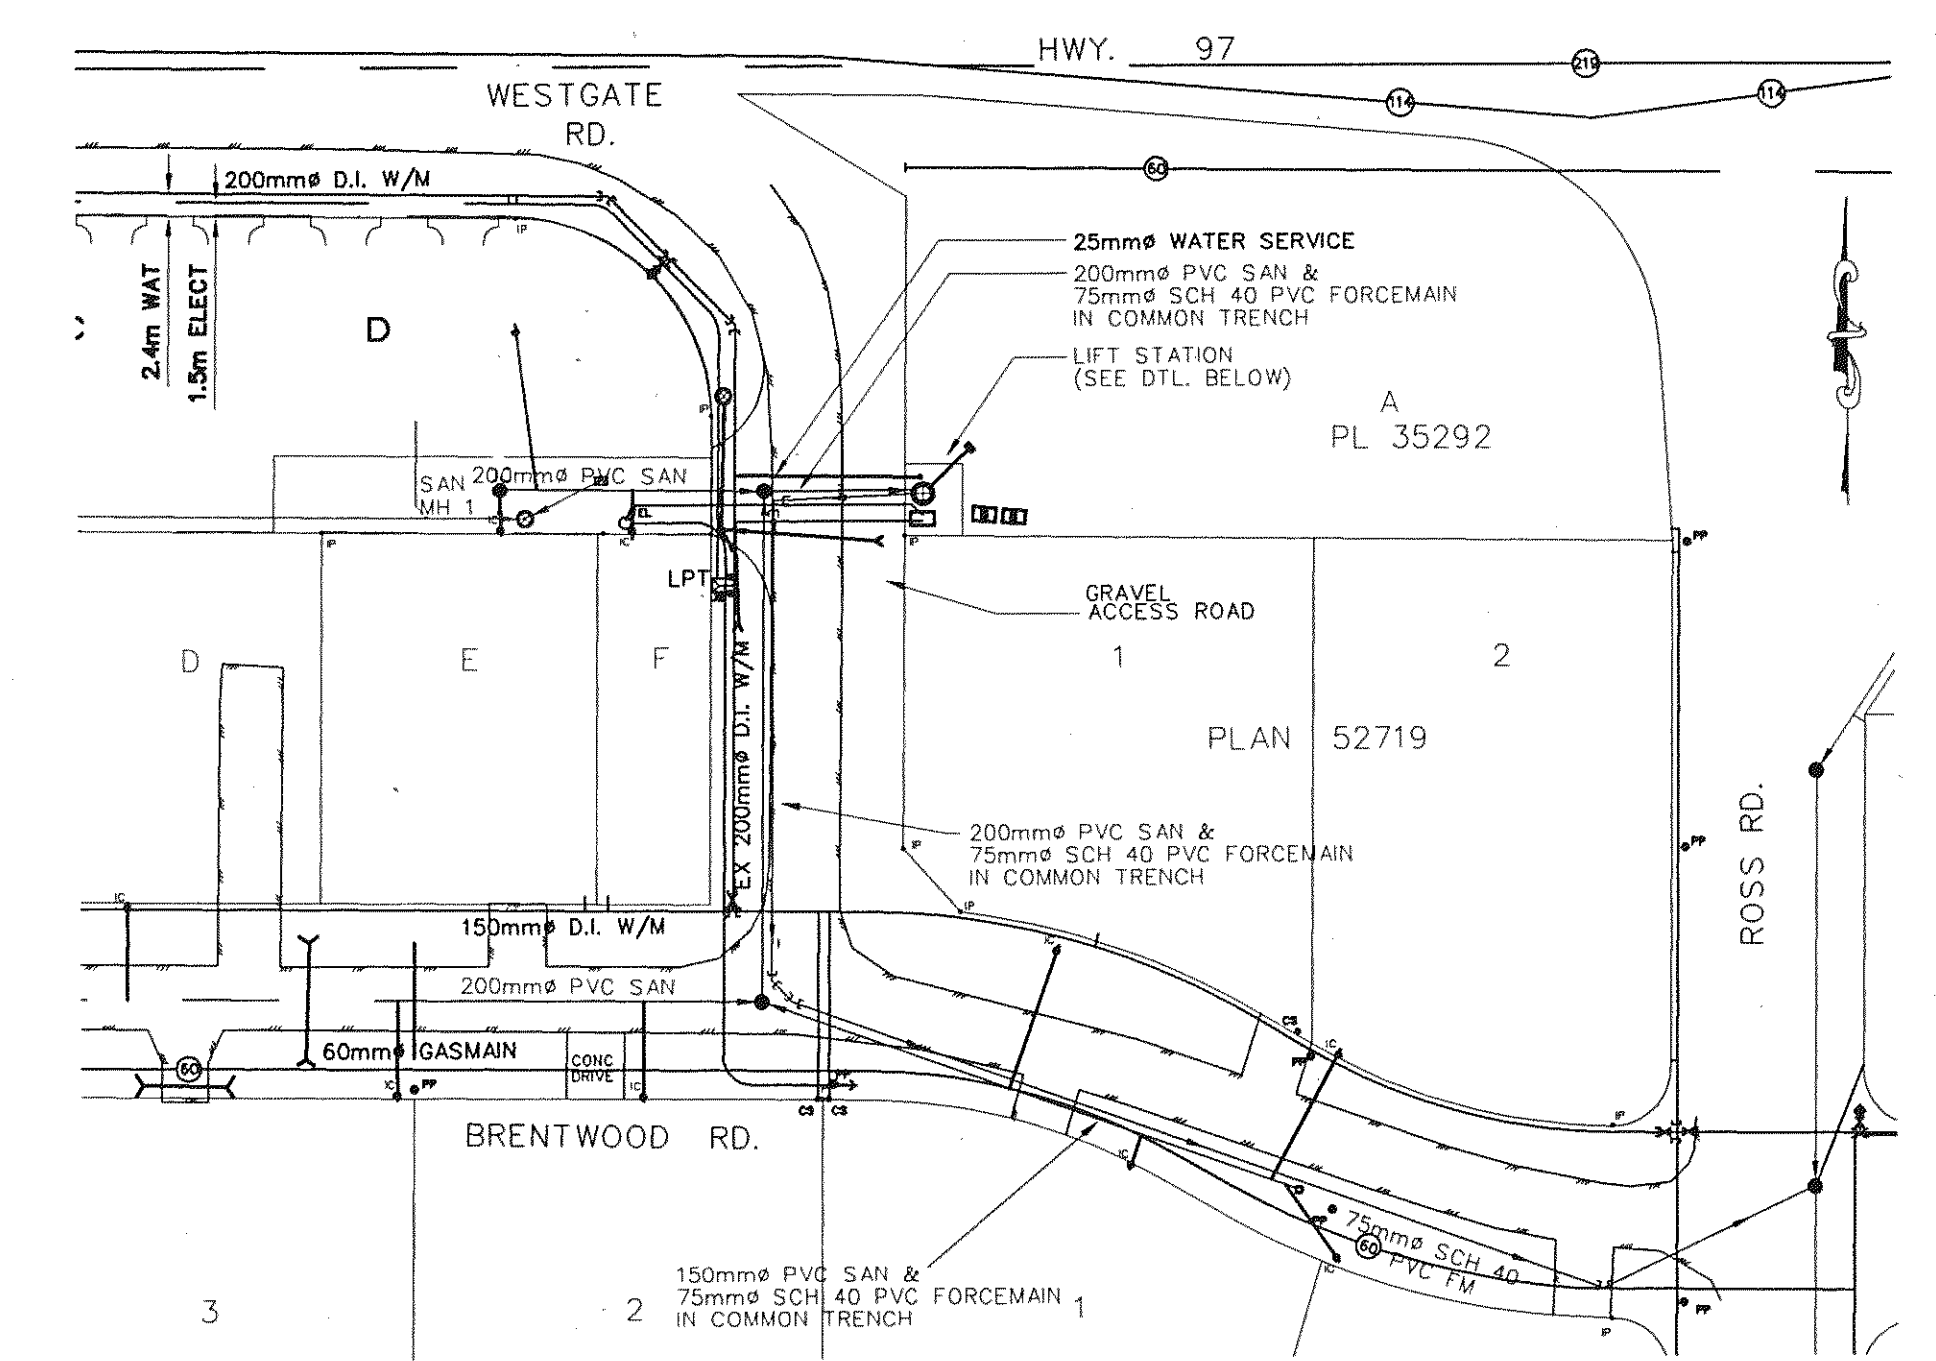

LOCATION PLAN

N.T.S.

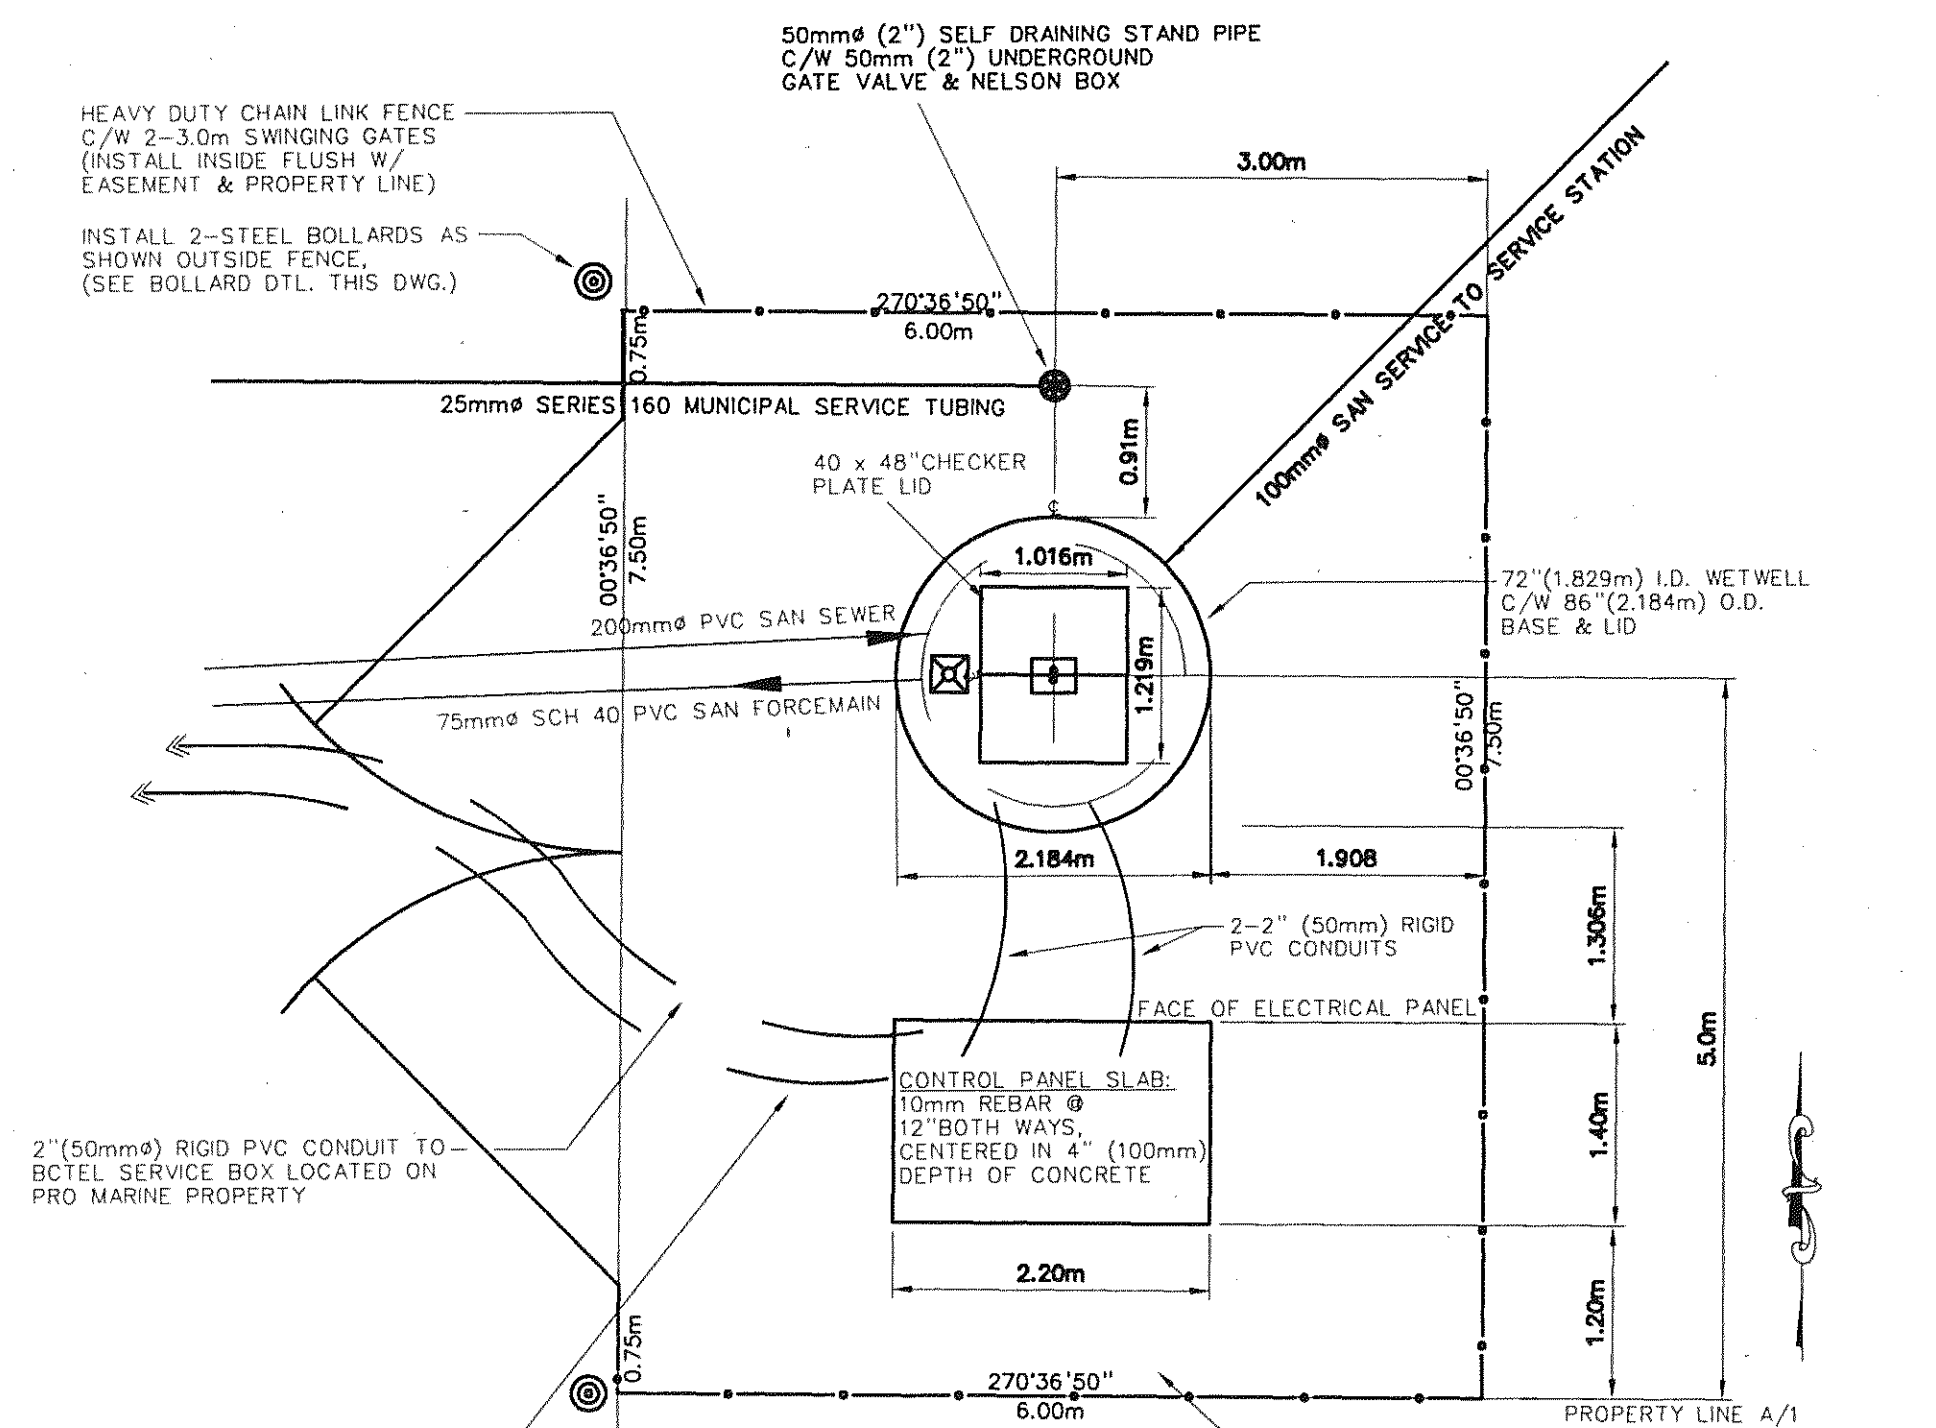


LIFT STATION
DETAIL

NOTE:

- THE CONTRACTOR MUST GIVE 24 HR NOTICE TO THE ELECTRICAL CONTRACTOR PRIOR TO INSTALLATION OF ANY ELECTRICAL & TELEPHONE WORKS.
- ARRANGE FOR SHIPMENT AND DELIVERY OF ALL PUMPS, ELECTRICAL EQUIPMENT, ACCESS HATCHES, AND ANY OTHER ITEMS LISTED AS BEING SUPPLIED BY OWNER. CHECK FOR ANY DAMAGE OR DEFICIENCIES, AND ARRANGE FOR DELIVERY TO SITE FOR INSTALLATION.
- OTHER THAN PROVIDED FOR IN THE SUPPLEMENTARY CONDITIONS OF THE AGREEMENT, THE CONTRACTOR SHALL BE REQUIRED TO PROVIDE ALL PIPING, VALVES, AND SUPPORTS INCLUDING THOSE NOT SPECIFICALLY LISTED AS BEING SUPPLIED BY OWNER.
- PLACE EFFLUENT PUMPS INTO OPERATION.
- PROVIDE OWNER WITH COMPLETE SET OF OPERATING AND MAINTENANCE INSTRUCTIONS FOR PUMPS AND ELECTRICAL EQUIPMENT.
- PROVIDE AND PLACE ALL CONDUIT

CONCRETE NOTES


- THE SAFETY OF ALL CONSTRUCTION WORK IN OR ABOUT THE SITE INCLUDING ALL FORMWORK & SUPPORT IS THE SOLE RESPONSIBILITY OF THE CONTRACTOR. ALL RULES & REGULATIONS OF THE W.C.B. SHALL BE STRICTLY ADHERED TO.
- MINIMUM CONCRETE STRENGTH f'_c TO BE 30 MPa AFTER 28 DAYS. ALL FOUNDATION & FOOTING SECTIONS SHALL BE AS INDICATED. PLAN & REINFORCED CONCRETE TESTING, MATERIALS, CONSTRUCTION AND DESIGN TO CONFORM TO C.S.A. 823.1973.

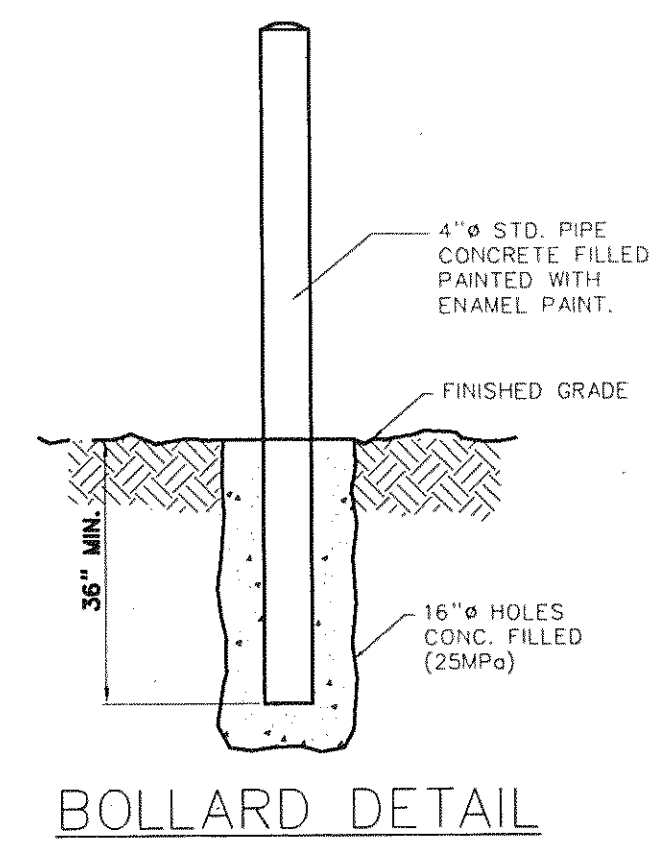

BOLLARD DETAIL

LEGEND	SYMBOL	DESCRIPTION
WATER	Hydrant symbol	HYDRANT
SAN. SEWER	Water valve symbol	WATER VALVE
GAS	Reducer symbol	REDUCER
U.G. TELEPHONE	Sanitary MH symbol	SANITARY MH
U.G. ELECTRICAL	Storm MH symbol	STORM MH
	Catch Basin symbol	CATCH BASIN
	Drywell symbol	DRYWELL
	Perc. Hole symbol	PERC. HOLE
	Power Pole symbol	POWER POLE
	Lamp Std. symbol	LAMP STD.
	Traffic Light symbol	TRAFFIC LIGHT
	Transformer symbol	TRANSFORMER
	Tel. SB symbol	TEL. SB
	Elect. SB symbol	ELECT. SB

NO.	DATE	BY	REVISION	CHK'D
C	OCT. 29, 97	R.H.	AS CONSTRUCTED	D.E.P.
B	JULY 30, 97	R.H.	ADDED FLOOR SOCKET, SPECIFIED LADDER RUNGS	D.E.P.
A	JULY 27, 97	E.B.B.	REVISED SAN SERVICES, MH 1 & 4, ADDED SER. TO LOT 3	D.E.P.

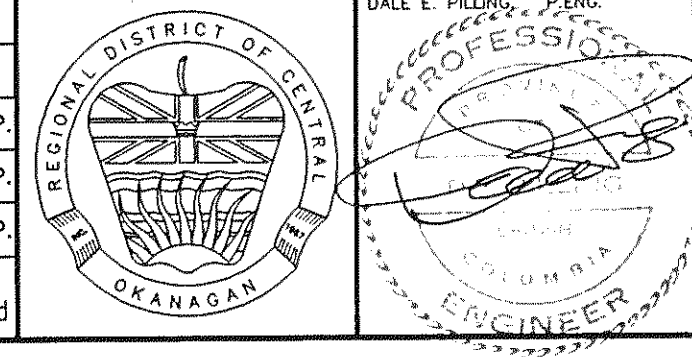

DRAWN	E.B.B.
DESIGN	P.A.C.E.
APPROVED	D.E.P.
DATE	JUNE, 1997
SCALE	1 : 20 IMPERIAL

PACE CONSULTING ENGINEERING Ltd.
2200, 540 GROVES AVENUE, KELOWNA, B.C. V1Y-4T7
TEL: 763-2315 FAX: 763-5558

WESTGATE-BRENTWOOD RD SANITARY
REG. DIST. OF CENTRAL OKANAGAN
1450 K.L.O. ROAD, KELOWNA, B.C. V1W-3Z4

SANITARY LIFT STATION DETAILS

DRAWING NO.	1147-S3
MUNICIPAL NO.	-
REV. NO.	C



PERFORMANCE CURVE

PRODUCT
CP3102.180

TYPE
MT

DATE
97-07-28

PROJECT
Westgate- Brentwood Pumps LS 23

CURVE NO
61-433-00-3030

ISSUE
2

MOTOR COS FI	0.93	1/1-LOAD	3/4-LOAD	1/2-LOAD	MOTOR SHAFT POWER 3.4 HP
MOTOR EFFICIENCY	78.5 %	---	---	---	STARTING CURRENT ... A
GEAR EFFICIENCY	---	---	---	---	RATED CURRENT ... 16 A

IMPELLER DIAMETER
--- MM

MOTORTYPE STATOR REV
--- --- ---


COMMENTS
NEVA CLOG

OUTLET
100 MM
IMP. THROUGHLET
76 MM

RATED SPEED **1730** RPM
TOT.MOM.OF INERTIA ... **0.030** KG*M2
NO. OF BLADES **1**


FREQ PHASES VOLTAGE POLES
60 HZ 1 230 V 4

GEARTYPE RATIO
--- ---

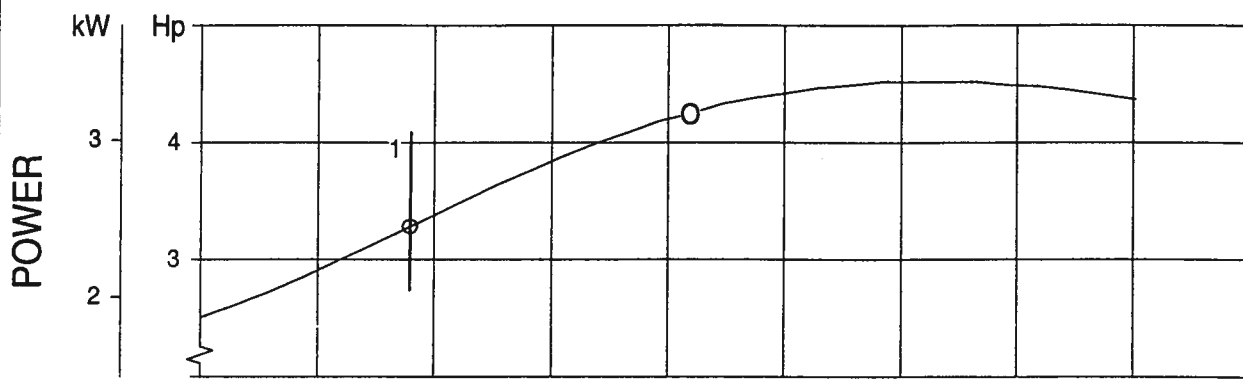

DUTY-POINTS:	FLOW(l/s)	HEAD(m)	POWER(Hp)	EFF(%)	NPSH(m)	GUARANTY
BEP:	21.0	7.06	4.25 (—)	45.8 (—)	5.6	—
1	8.97	10.1	3.29 (—)	36.0 (—)	5.3	—

NPSH_{RE}

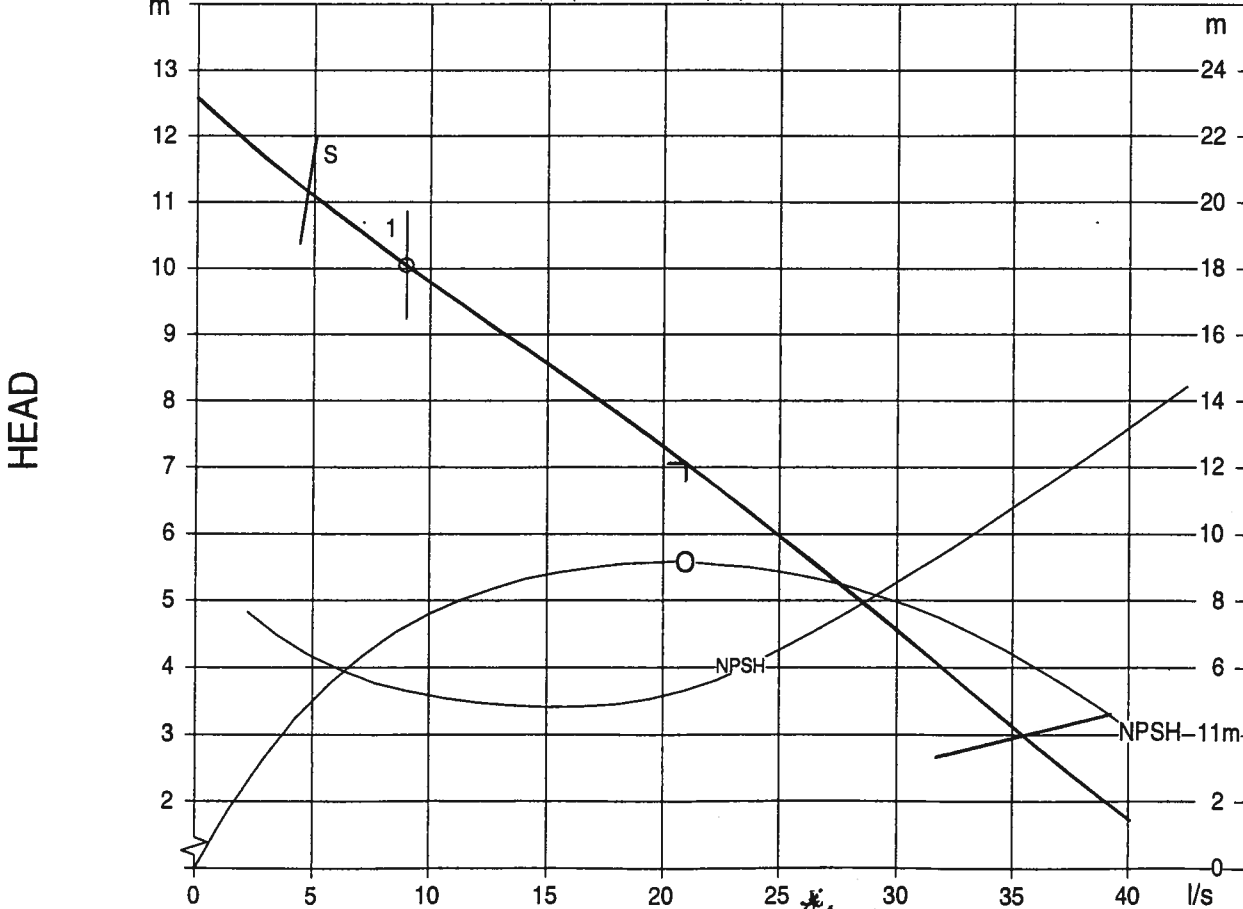

FLOW APPROVED
*ELIMINATE MINICAS II

S: RISK FOR SEDIMENTATION AT VELOCITY BELOW 0.6 M/S
(STANDARD DIAM. 100 MM)

CURVES SHOW PERFORMANCE WITH CLEAR WATER



HI-CURVE

Aug 13/97

[Signature]

Pre-release 3 ITT Flygt

FLYPS 1.2



District of West Kelowna

Sanitary Lift Station Evaluation

Station: Sunnybrae Road 24
Inspection By: Jim Kentel

Year Constructed: 2001
Year Upgraded:

Matrix Rating		
(10 - highest rating)	Civil	31
(1 - lowest rating)	Process Mechanical	20
	Electrical Instrumentation	15
	Total Station Rating	66 (max. rating 370 points)



Civil:

**Matrix
Rating**

Parking Area:	_____	n/a
Drainage:	Good	10
Influent sewer:	Good	10
Site access:	Good	10
Water service:	_____	1
		31

Process Mechanical:



**Matrix
Rating**

Station type:	_____	n/a
Number of pumps:	_____	n/a
Pump Redundancy:	_____	n/a
Pump Manufacturer / Type:	_____	1
Pump Model:	_____	n/a
Rated Capacity:	_____	n/a
Capacity Confirmation:	_____	n/a
Discharge pipe type / diameter:	_____	1
Header pipe type / diameter:	_____	1
Check valve type / diameter:	_____	1
Isolation valve type / diameter:	_____	1
Piping Condition:	_____	1
Emergency pumpout connection:	_____	1
Pressure gauges:	_____	1
Inlet bar screen:	_____	1
Wetwell condition:	_____	1
Access Hatches:	_____	1
Ladder / Platform:	_____	1
Wetwell benching:	_____	1
Odour Control:	_____	1
Ventilation:	_____	1
Humidity Control / Dehumidification:	_____	1
Grease / Debris Accumulation:	_____	1
Water washdown:	_____	1
Sump pump:	_____	1
Confined Space Entry Requirements	_____	1
		20


Electrical / Instrumentation:

Matrix
Rating

Service Type	V / A / Phase / Wire	n/a
Pump 1 :	HP	n/a
	Volts Rpm	n/a
	FLA	n/a
	Starter	n/a
Pump 2 :	HP	n/a
	Volts Rpm	n/a
	FLA	n/a
	Starter	n/a
Alarm Functions:		1
		n/a
		n/a
		n/a
Receptacles:		1
Interior Lighting:		1
Exterior Lighting:		1
SCADA / Telemetry:		1
Main Breaker:		1
Control Panel:		1
Lighting Panel:		1
Flowmeter:		1
Grounding:		1
Surge Protection:		1
UPS:		1
PLC:		1
Level Control:		1
Standby Generator:		1
		15
Comments:		

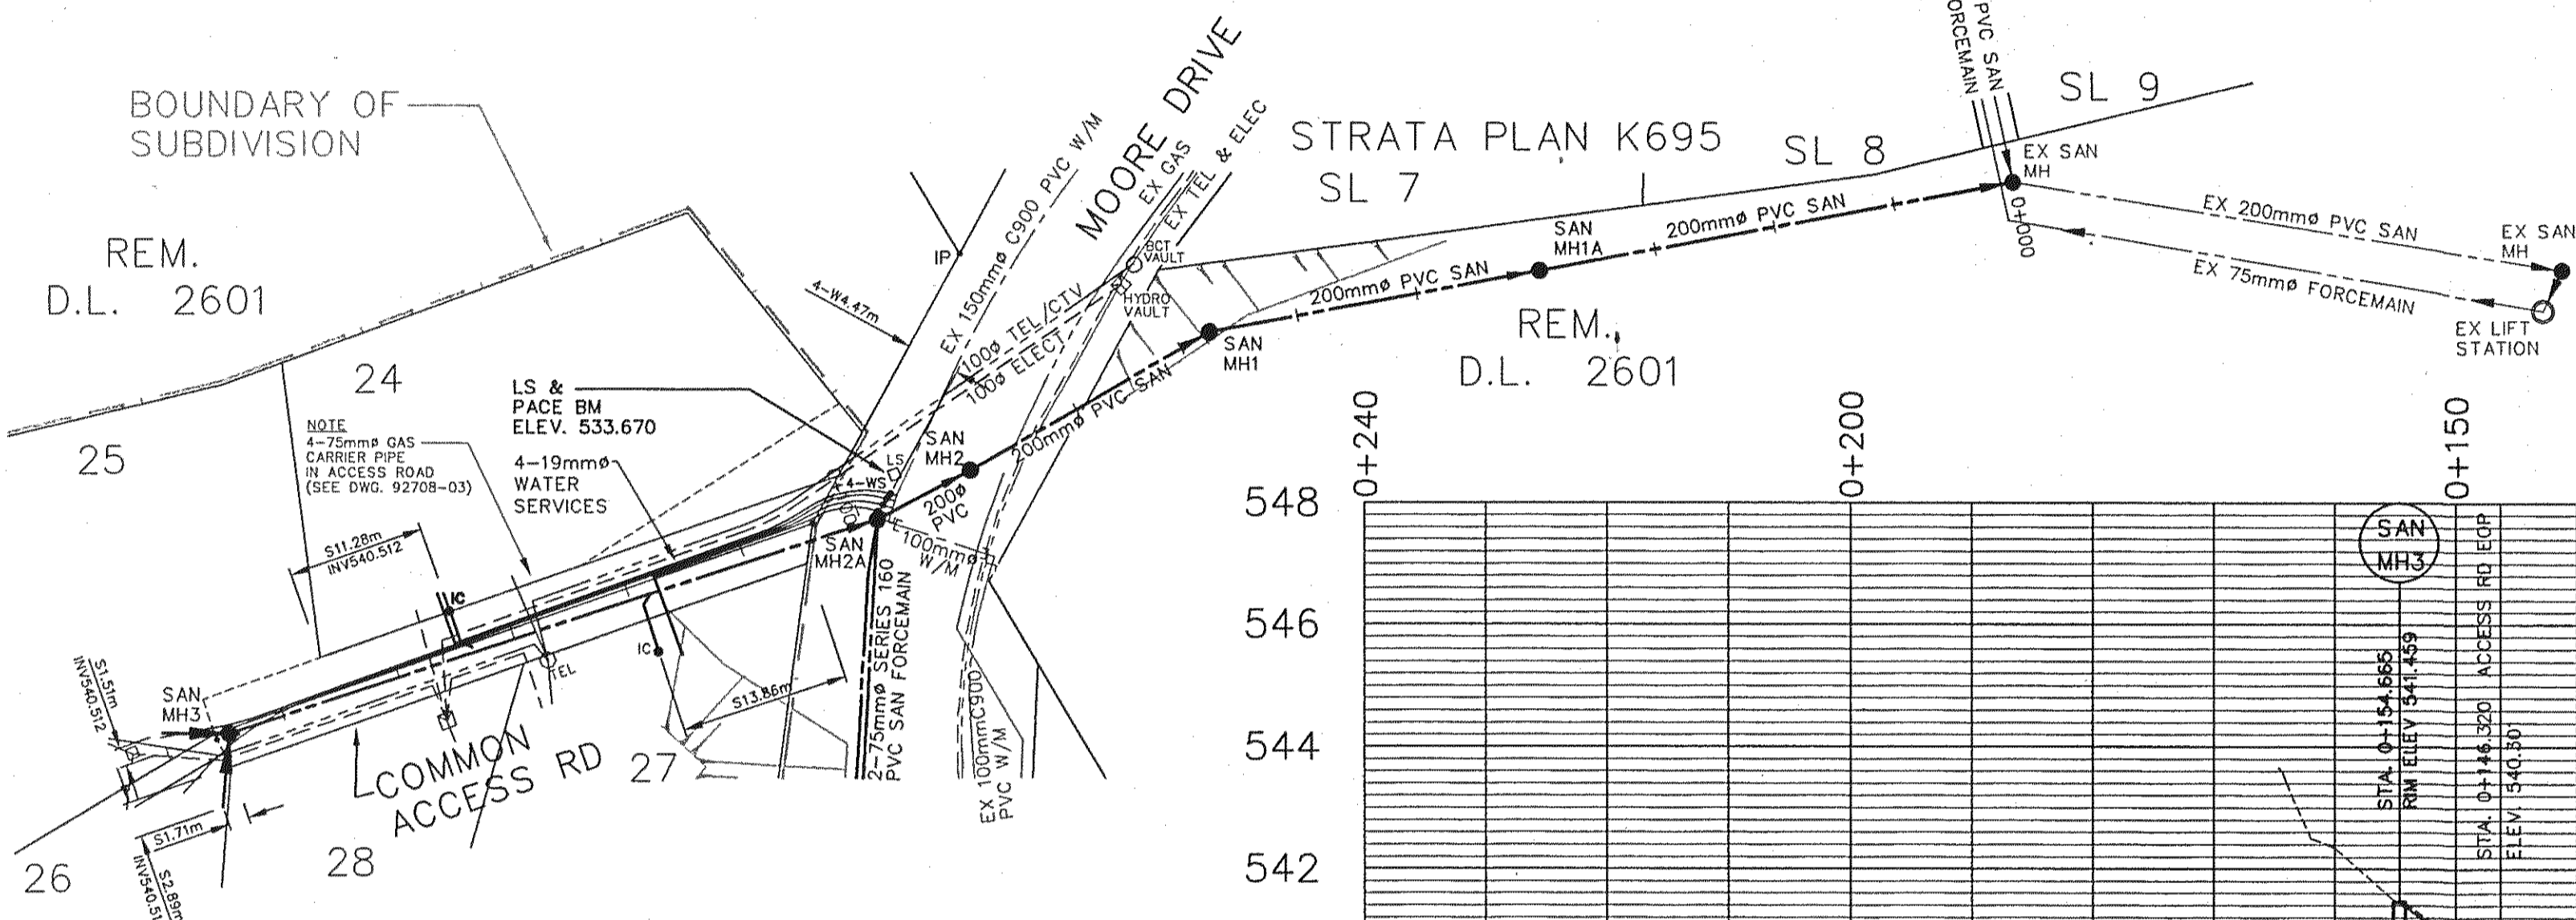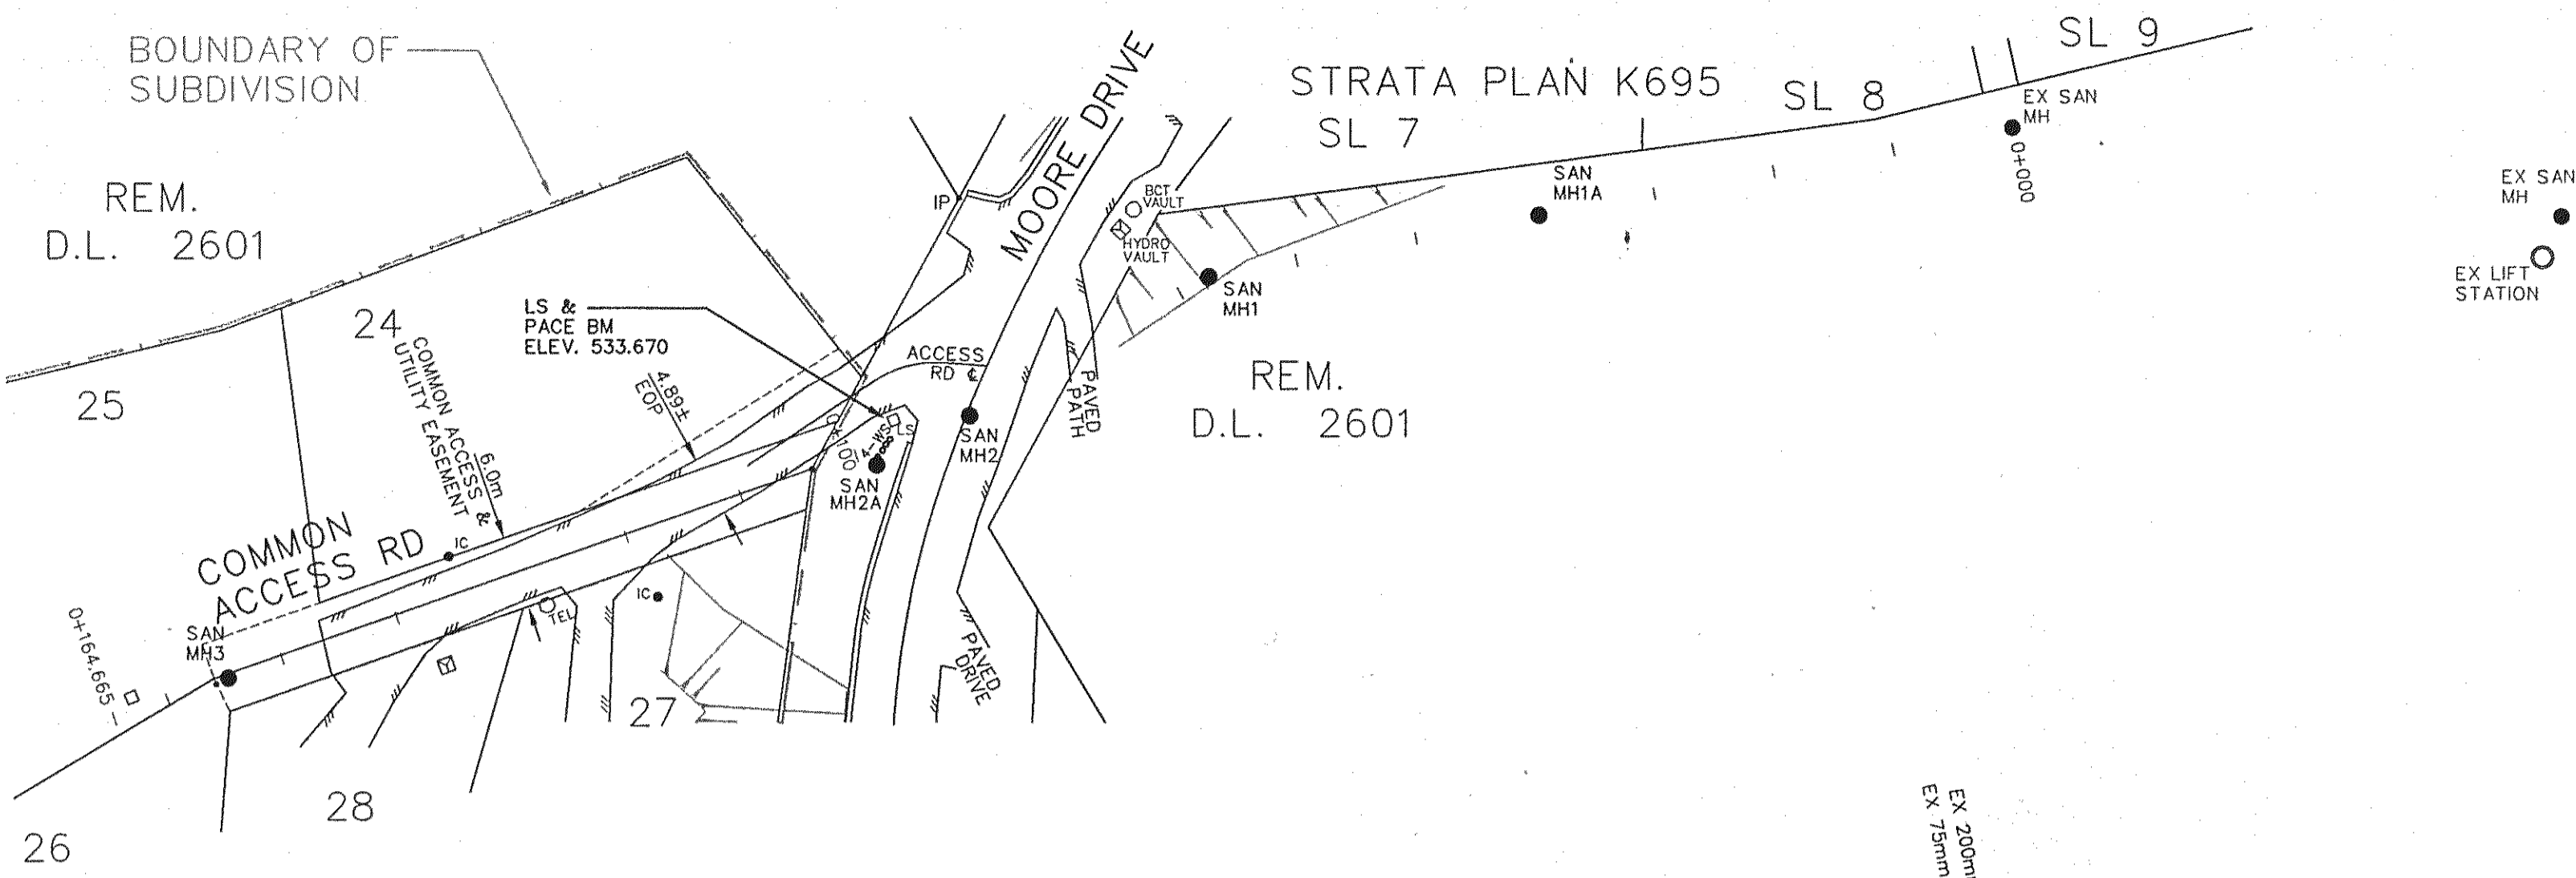

"This as-constructed information was not prepared by the Regional District of Central Okanagan and therefore there is no guarantee of its accuracy. It is the recipient's and user's responsibility to confirm the accuracy of this as-constructed information before proceeding with any work that may be affected by this as-constructed information."

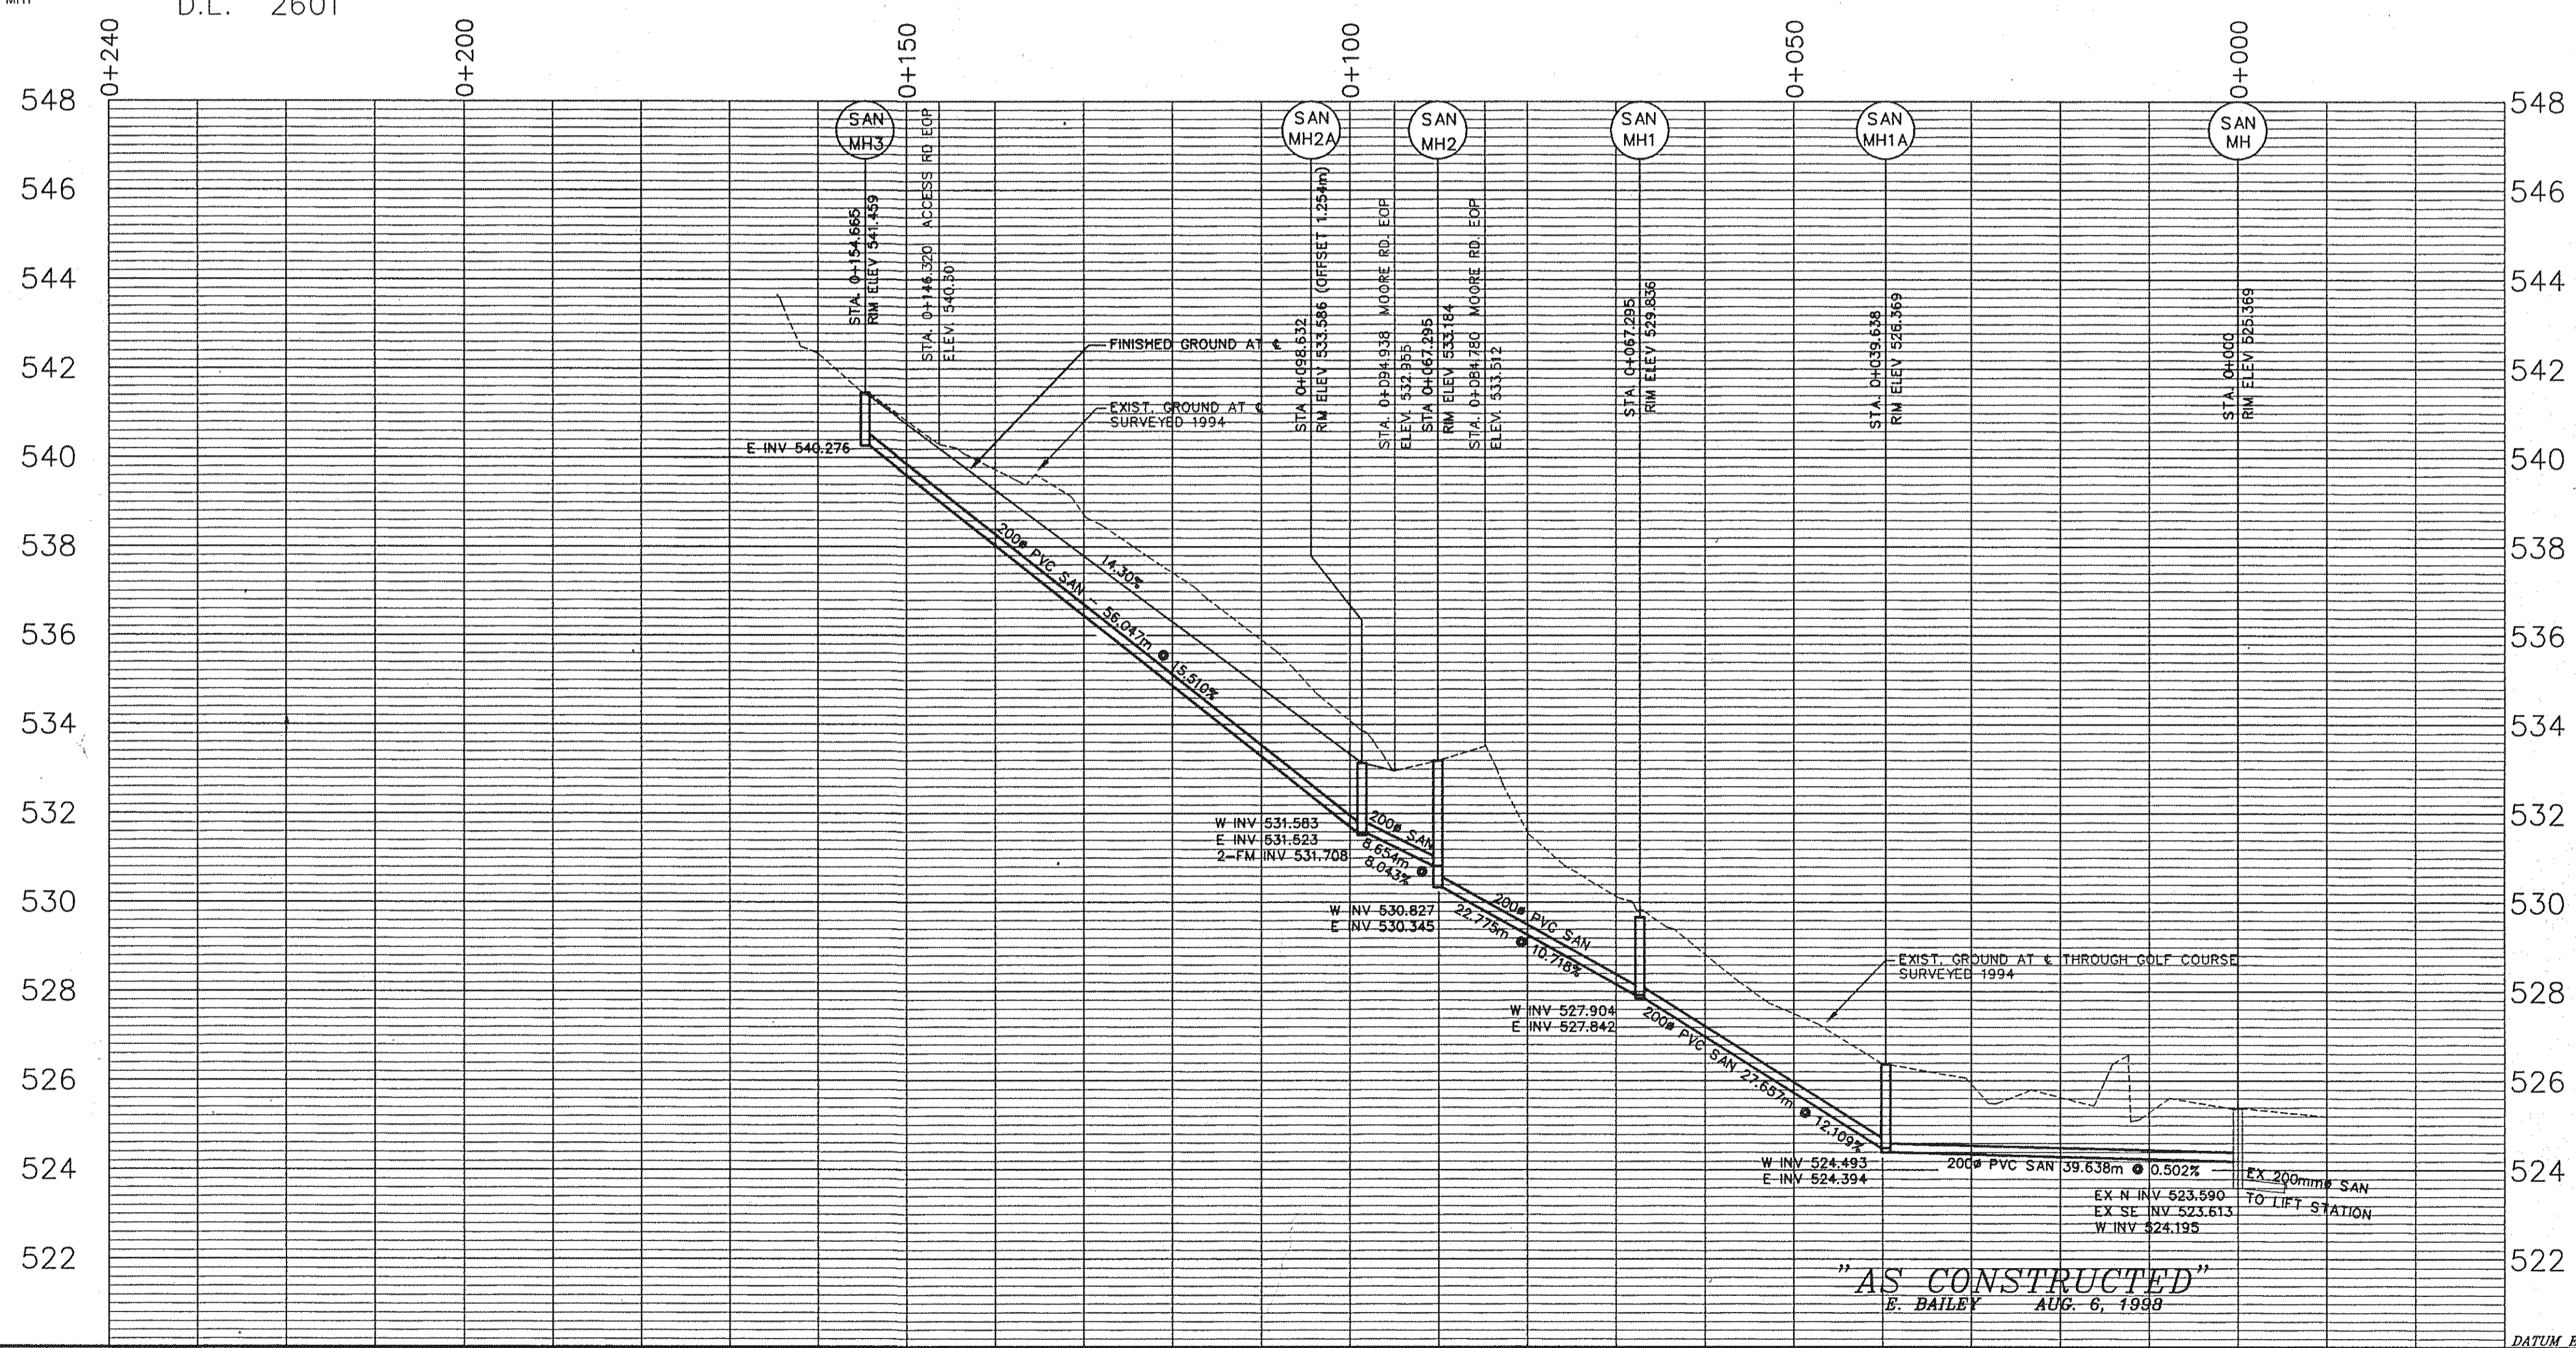


LEGEND

WATER	-----	MANHOLE	● M.H.
SAN. SEWER	-----	POWER POLE	○ P.P.
STORM SEWER	-----	LAMP STANDARD	□ L.S.
GAS	-----	CATCH BASIN	□ C.B.
U/G TELEPHONE	-----	HYDRANT	⊕ H.D.
U/G ELECTRICAL	-----	TREES	○ T

NO.	DATE	BY	REVISION	CH'KD
1	NOV.15,'94	EBB	REVISED SANITARY MAIN ACROSS GOLF COURSE	
2	NOV.22,'94	EBB	REVISED WATER AS PER LAKEVIEW IRRIGATION	
3	DEC.16,'94	EBB	REVISED WATER AS PER LAKEVIEW IRRIGATION	
4	AUG 6,'98	EBB	AS CONSTRUCTED	

D.E.P. DRAWN BY: E.B.B.
 D.E.P. DESIGN BY: P.A.C.E.
 D.E.P. APPROVED BY: D.E.P.
 DATE: NOV., 1994

SCALE:
 Horz. 1:500
 Vert. 1:100

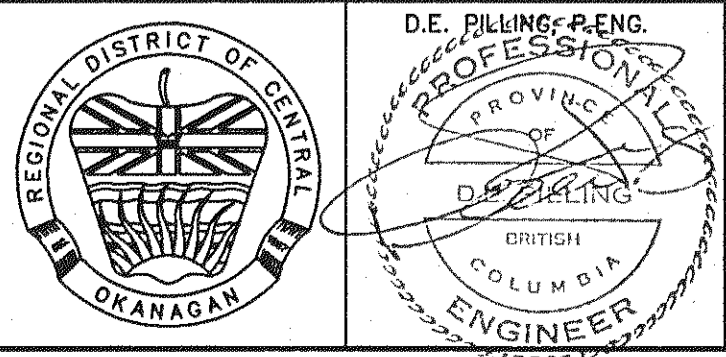

PACE
 D.E. PILLING and ASSOCIATES
 CONSULTING ENGINEERING Ltd.
 # 200, 540 GROVES AVENUE, KELOWNA, B.C. V1Y 4T7
 TEL. 763-2315 FAX. 763-6559

MOORE DRIVE SUBDIVISION - STRATA PLAN & PROFILE "ACCESS RD" & SANITARY
 JOHN MOORE
 2871 MOORE DRIVE, WESTBANK, B.C. V0H 2A0

DATUM ELEV. 520.000
 DRAWING NO. 92708-0
 REV. NO. 4



District of West Kelowna

Sanitary Lift Station Evaluation

Station: Ensign Way LS 25
Inspection By: Jim Kentel

Year Constructed: 1990
Year Upgraded:

Matrix Rating		
(10 - highest rating)	Civil	26
(1 - lowest rating)	Process Mechanical	20
	Electrical Instrumentation	15
	Total Station Rating	61 (max. rating 370 points)




Electrical / Instrumentation:

Matrix
Rating

Service Type	V / A / Phase / Wire	n/a
Pump 1 :	HP	n/a
	Volts Rpm	n/a
	FLA	n/a
	Starter	n/a
Pump 2 :	HP	n/a
	Volts Rpm	n/a
	FLA	n/a
	Starter	n/a
Alarm Functions:		1
		n/a
		n/a
		n/a
Receptacles:		1
Interior Lighting:		1
Exterior Lighting:		1
SCADA / Telemetry:		1
Main Breaker:		1
Control Panel:		1
Lighting Panel:		1
Flowmeter:		1
Grounding:		1
Surge Protection:		1
UPS:		1
PLC:		1
Level Control:		1
Standby Generator:		1
		15
Comments:		

PART OF LOT 4 PLAN 38319

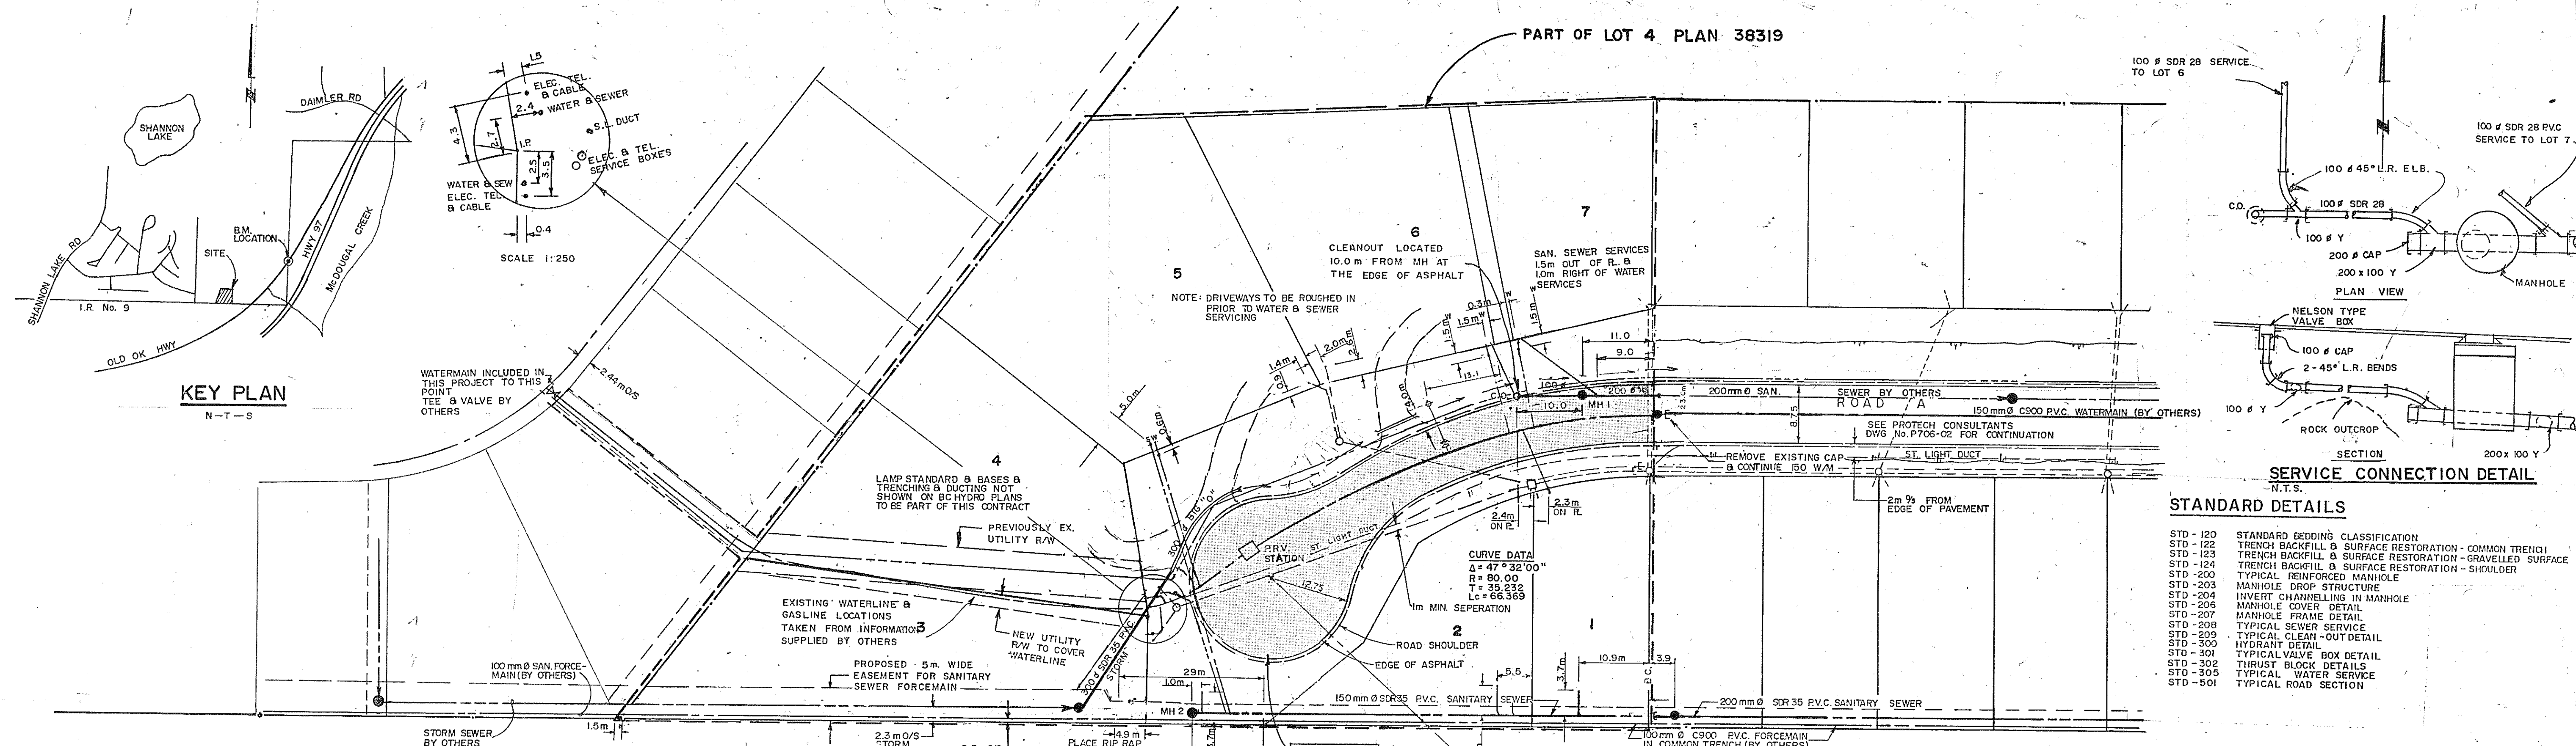

STANDARD DETAILS


STD	DESCRIPTION
STD - 120	STANDARD BEDDING CLASSIFICATION
STD - 122	TRENCH BACKFILL & SURFACE RESTORATION - COMMON TRENCH
STD - 123	TRENCH BACKFILL & SURFACE RESTORATION - GRAVELLED SURFACE
STD - 124	TRENCH BACKFILL & SURFACE RESTORATION - SHOULDER
STD - 200	TYPICAL REINFORCED MANHOLE
STD - 203	MANHOLE DROP STRUCTURE
STD - 204	INVERT CHANNELLING IN MANHOLE
STD - 206	MANHOLE COVER DETAIL
STD - 207	MANHOLE FRAME DETAIL
STD - 208	TYPICAL SEWER SERVICE
STD - 209	TYPICAL CLEAN-OUT DETAIL
STD - 300	IVORANT DETAIL
STD - 301	TYPICAL VALVE BOX DETAIL
STD - 302	THRUST BLOCK DETAILS
STD - 303	TYPICAL WATER SERVICE
STD - 501	TYPICAL ROAD SECTION

NOTE: ELEVATIONS REFERENCED TO DEPT. OF HIGHWAYS B.M. 1P AT N.E. CORNER OF LOT A PLAN 15871 ELEVATION - 443.686

NOTE: LOCATION & SIZING OF DUCTING FOR STREET LAMPS TO BE CONFIRMED BY THE DEVELOPERS ELECTRICIAN PRIOR TO INSTALLATION OF B.C. HYDRO DUCTING. STREET LIGHT DUCTING SHALL BE PLACED IN A COMMON TRENCH WITH B.C. HYDRO DUCTING & SHALL CONFORM TO B.C. HYDRO & LOCAL ELECTRICAL CODES AND SPECIFICATIONS.

NOTES:
 ALL ROAD CONSTRUCTION IS TO BE TO MINISTRY OF HIGHWAYS STANDARDS FOR OPEN SHOULDERED, PAVED SUBDIVISION ROADS.
 ROADS (INCLUDING CALDESAC) TO HAVE 1% CROSSFALL TO DITCH ON THE HIGH SIDE. SEE SECTION A-A.
 ROADS TO HAVE 10% DEEP.
 RIM ELEV. SHOWN ON PLAN ARE APPROX. ONLY. EXACT RIM EL. TO BE SET TO MATCH FINISHED GRADES & CROSS SLOPES.
 MANHOLES SET IN ASPHALT TO HAVE RIM ELEV. TO MATCH ROAD GRADE PRIOR TO PAVING.

I N D I A N R E S E R V E N O . 9

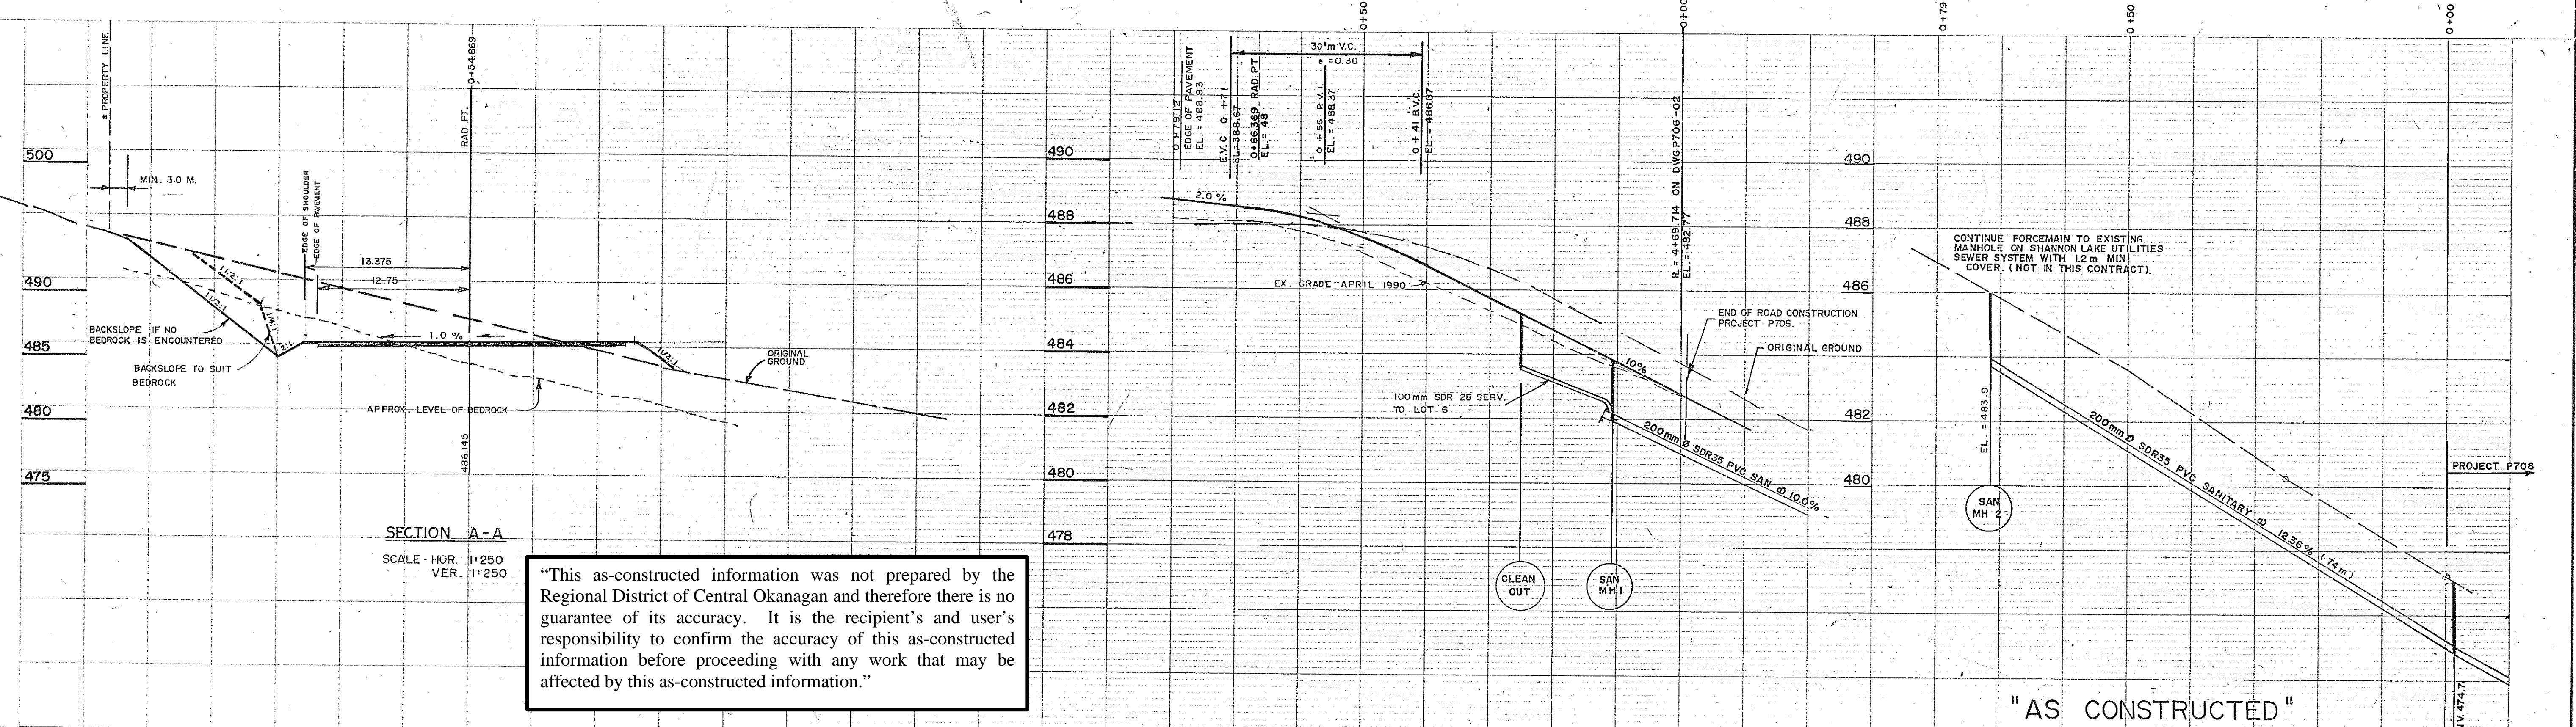


"This as-constructed information was not prepared by the Regional District of Central Okanagan and therefore there is no guarantee of its accuracy. It is the recipient's and user's responsibility to confirm the accuracy of this as-constructed information before proceeding with any work that may be affected by this as-constructed information."

"AS CONSTRUCTED"


Legend

Water	Manhole	○-M
San Sewer	Power Pole	○-P
Storm Sewer	Lamp Standard	○-L
Gas	Catch Basin	○-C
UG Telephone	Hydrant	○-H
UG Electrical	Trees	○-T

No.	Date	Revision
11	JULY 17/87	DETAILS OF SERVICES ADDED
10	JUNE 9/87	AS CONSTRUCTED
9	APR 2/87	ROAD GRADE
8	MAR 20/87	GENERAL REVISIONS
7	JAN 18/87	ADD GAS

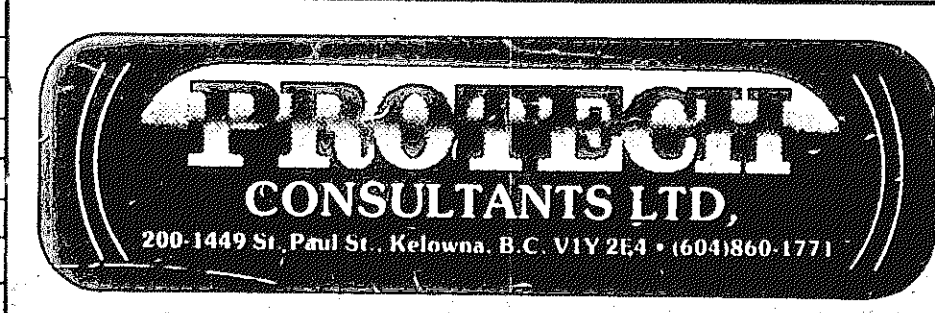

No.	Date	By	Revision	Chkd
6	OCT 13/1987	DB	ADD NOTE RE STREET LIGHT	
5	OCT 8/1987	JB	ADD HYDRO, REVISE WATER SERVICES, ISSUED FOR TENDER	
4	OCT 1/1987	JB	ADD PRV, STORM, & WATER SERVICES	
3	SEPT 17/1987	JB	REVISE	
2	AUG 4/1987	JB	REVISE LOTS, DESIGN GRADE, ADD SANITARY & ELECTRICAL	
1	JULY 17/1987	DB	PLAN NO. & LOT LAYOUT	

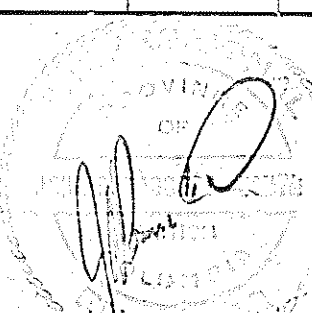

Drawn	D.A. PEROZAK, A.Sc.T.	C. ENSIGN — RESIDENTIAL SUBDIVISION	Division
Design	D.A. PEROZAK, A.Sc.T.		
Approved		PROPOSED EXTENSION OF ROAD "A" FOR 7 RESIDENTIAL LOTS	Drawing No. P 739 - 02
Date	JUNE 1, 1987		
Scale	HOR 1:500 VER 1:100		Rev. No. 11

SHANNON LAKE



District of West Kelowna

Sanitary Lift Station Evaluation

Station: Hayman Road LS 26
Inspection By: Jim Kentel

Year Constructed: 8/1/2012
Year Upgraded:

(10 - highest rating)	Civil	35
(1 - lowest rating)	Process Mechanical	163
	Electrical Instrumentation	122
	Total Station Rating	320 (max. rating 370 points)



Civil:Matrix
Rating

Parking Area:	<u>Paved/Gravel</u>	n/a
Drainage:	<u>Good</u>	10
Influent sewer:	<u>200mm Gravity</u>	10
Site access:	<u>Good</u>	10
Water service:	<u>Irrigation service only</u>	5
		35

Process Mechanical:Matrix
Rating

Station type:	<u>FRP 2.44m diameter</u>	n/a
Number of pumps:	<u>2</u>	n/a
Pump Redundancy:	<u>Yes</u>	n/a
Pump Manufacturer / Type:	<u>Flygt</u>	10
Pump Model:	<u>C/D1 3057.181HT</u>	n/a
Rated Capacity:	<u>8.4 L/S @ 12.4m TDH</u>	n/a
Capacity Confirmation:		n/a
Forcemain pipe type / diameter:	<u>FRP/50 to PVC / 75mm</u>	10
Header pipe type / diameter:	<u>FRP/ 50 to 80 mm</u>	10
Check valve type / diameter:	<u>80mm Flygy Sinking ball HDL 5087</u>	10
Isolation valve type / diameter:	<u>80mm Keystone Plug</u>	10
Piping Condition:	<u>New</u>	10
Emergency pumpout connection:	<u>Yes</u>	10
Pressure gauges:	<u>Yes</u>	10
Inlet bar screen:	<u>No</u>	1
Wetwell condition:	<u>New</u>	10
Access Hatches:	<u>Flygt</u>	10
Ladder / Platform:	<u>Yes/FRP</u>	18
Wetwell benching:	<u>T.O.P. Base</u>	18
Odour Control:	<u>Carbon Provision</u>	5
Ventilation:	<u>Fan</u>	10
Water washdown:	<u>No</u>	1
Confined Space Entry Requirements	<u>Davit</u>	10
		163

Electrical / Instrumentation:

Matrix
Rating

Service Type	V / A / Phase / Wire	n/a
Pump 1 :	HP 2.3	n/a
	Volts 2330 Rpm 3325	n/a
	FLA 10A	n/a
Starting Current	35A	n/a
Pump 2 :	HP 2.3	n/a
	Volts 2330 Rpm 3325	n/a
	FLA 10A	n/a
Starting Current	35A	n/a
Alarm Functions:	Yes	10
		n/a
		n/a
		n/a
Receptacle	Yes GFI	10
Interior Lighting:	Yes	10
Exterior Lighting:	No	1
SCADA / Telemetry:	Yes	10
Control Panel:	Yes	10
Lighting Panel:	Yes	10
Flowmeter:	Siemens SiTrans FM35100W	10
Grounding:	Yes	10
Lighting Protection:	Yes	10
UPS:	Yes	10
PLC:	Yes	10
Level Control:	Milltronics/bulb backup	10
Standby Generator:	No	1
		122
Comments:		





PERFORMANCE CURVE

PRODUCT	TYPE
CP3057.181	HT

DATE	PROJECT	CURVE NO	ISSUE
2011-05-24	Hayman Road PS - single phase/option b	61-266-00-2364	1

MOTOR COS PHI	1/1-LOAD	3/4-LOAD	1/2-LOAD	MOTOR SHAFT POWER	2.3	hp	IMPELLER DIAMETER			
MOTOR EFFICIENCY	0.97	0.97	0.96	STARTING CURRENT	35	A	104 mm			
GEAR EFFICIENCY	—	—	—	RATED CURRENT	10	A	MOTORTYPE	STATOR	REV	
COMMENTS	INLET/OUTLET			RATED SPEED	3325	rpm	13-10-2BZ	03-	10	
NEVACLOG	- / 50 mm			TOT.MOM.OF INERTIA	—		FREQ.	PHASES	VOLTAGE	POLES
	IMP. THROUGHLET			NO. OF BLADES	1		60 Hz	1	230 V	2
	48 mm						GEARTYPE	RATIO		
							—	—		

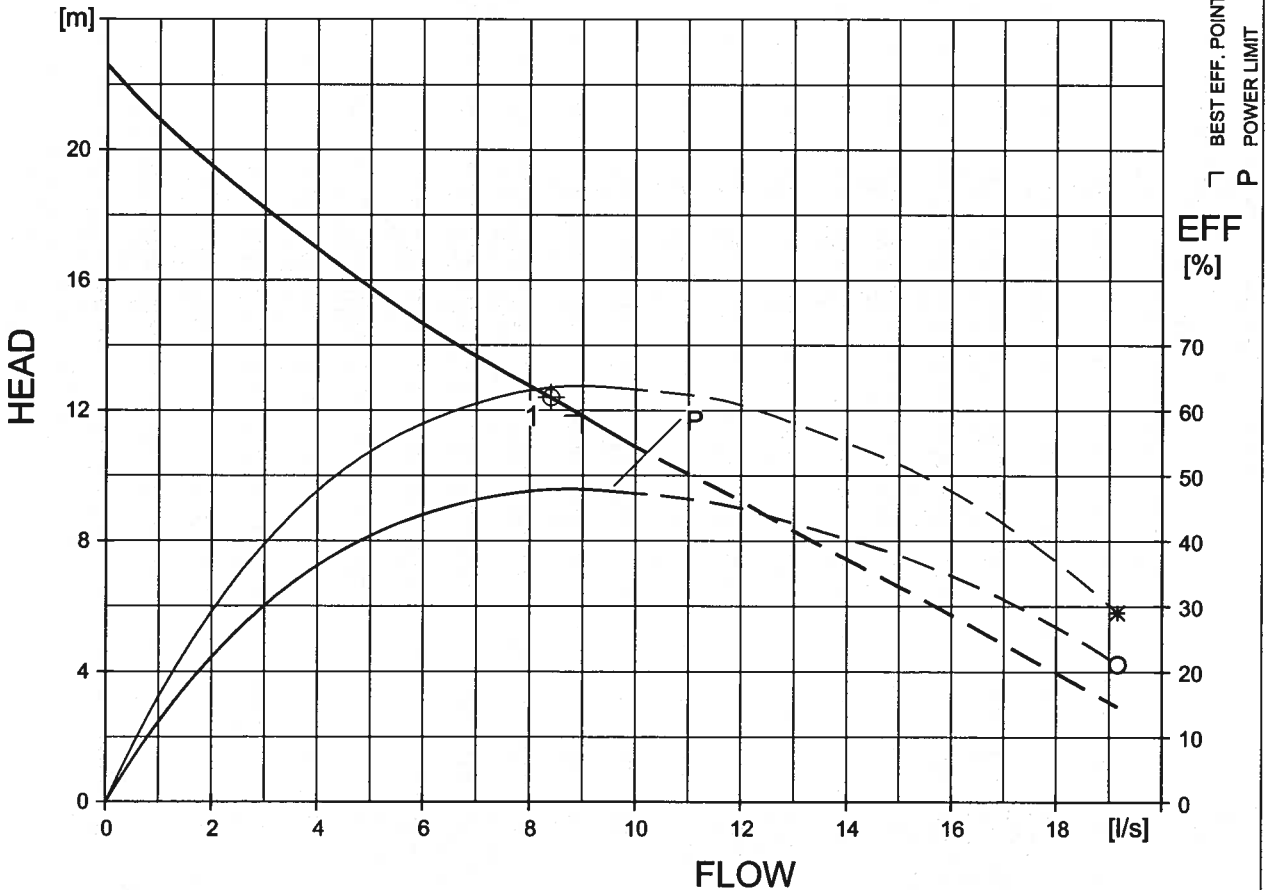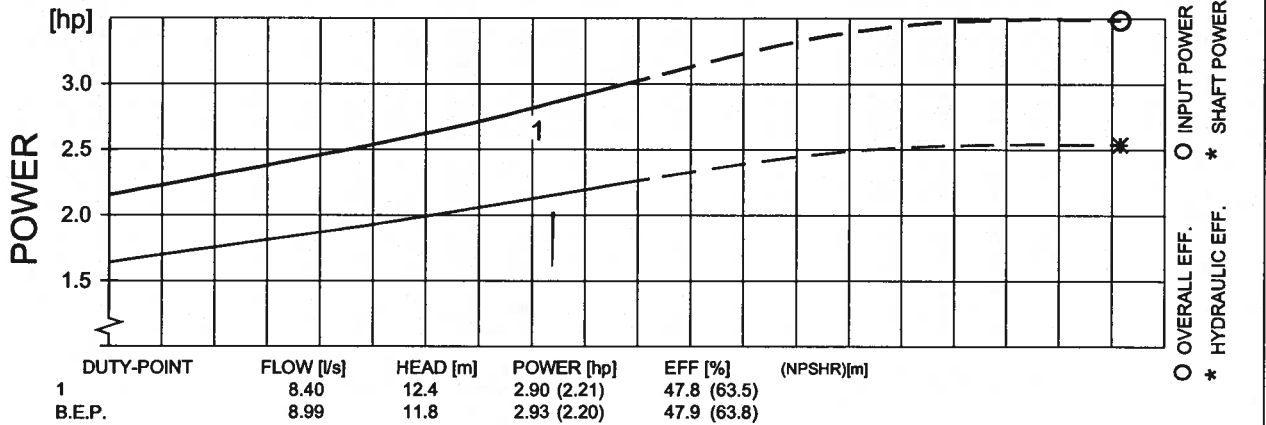

FLYPS3.1.6.6 (20090313)

Performance with clear water and rating data at 40 °C



CURVE




District of West Kelowna

Sanitary Lift Station Evaluation

Station: Bridgeview Road LS 27
Inspection By: Jim Kentel

Year Constructed: 8/1/2012
Year Upgraded: No Info

(10 - highest rating)	Civil	31
(1 - lowest rating)	Process Mechanical	152
	Electrical Instrumentation	132
	Total Station Rating	315 (max. rating 370 points)

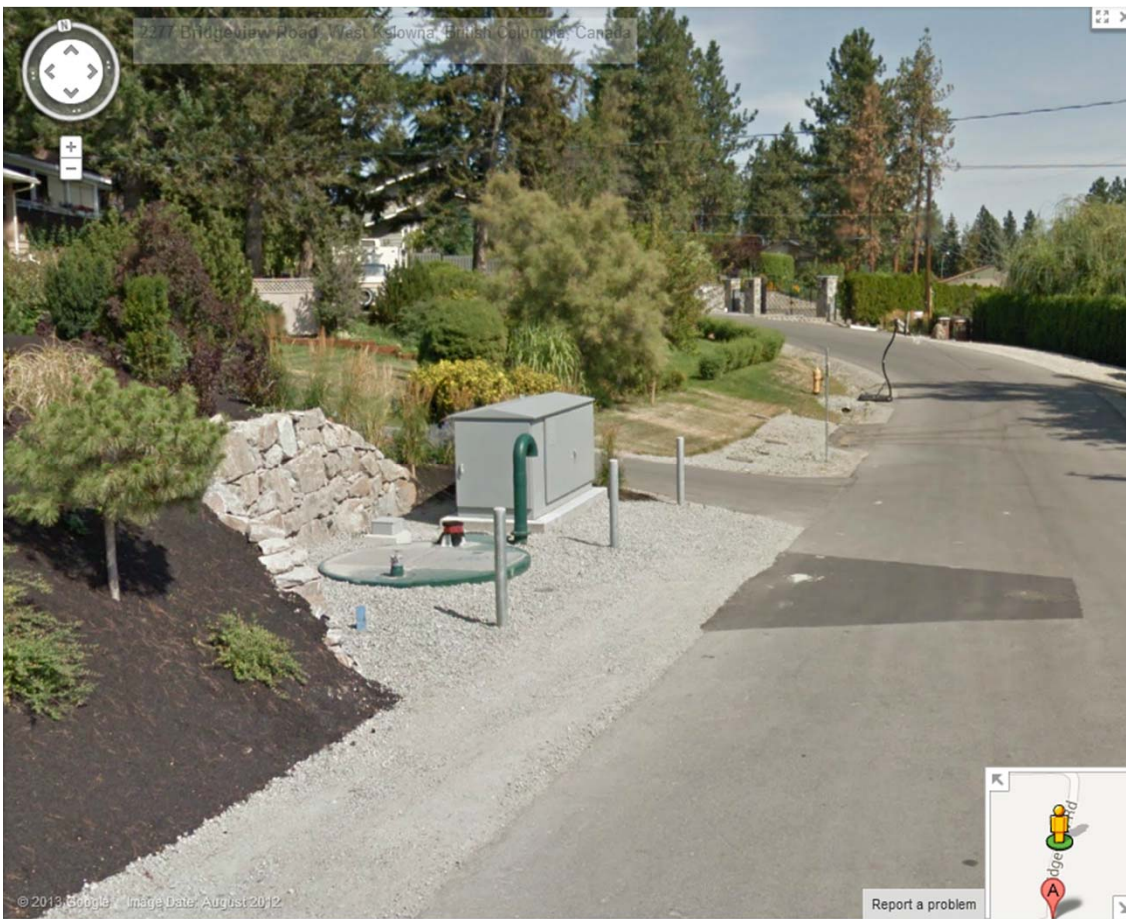

Civil:Matrix
Rating

Parking Area:	Paved/Gravel	n/a
Drainage:	Good	10
Influent sewer:	200mm Gravity PVC	10
Site access:	Good	10
Water service:	No	1
		31

Process Mechanical:Matrix
Rating

Station type:	FRP 2.44m Diameter	n/a
Number of pumps:	2	n/a
Pump Redundancy:	Yes	n/a
Pump Manufacturer / Type:	Flygt NP 3153	10
Pump Model:	HT . 181	n/a
Rated Capacity:	11.1 L/S @ 25.4m TDH	n/a
Capacity Confirmation:		n/a
Forcemain pipe type / diameter:	100mm PVC	10
Header pipe type / diameter:	FRP/100	10
Check valve type / diameter:	Flygt Sinking Ball HDL 5087/100	10
Isolation valve type / diameter:	Keystone Plug / 100	10
Piping Condition:	New	10
Emergency pumpout connection:	Yes	10
Pressure gauges:	Yes	10
Inlet bar screen:	No	1
Wetwell condition:	New	10
Access Hatches:	Flygt	10
Ladder / Platform:	Yes/FRP	10
Wetwell benching:	Top base	10
Odour Control:	Carbon Filter	10
Ventilation:	Fan	10
Water washdown:	No	1
Confined Space Entry Requirements	Davit	10
		152

Electrical / Instrumentation:

Matrix
Rating

Service Type	V / A / Phase / Wire	n/a
Pump 1 :	HP 15	n/a
	Volts 600 Rpm 1760	n/a
	FLA 15A	n/a
Starting Current	95A	n/a
Pump 2 :	HP 15	n/a
	Volts 600 Rpm 1760	n/a
	FLA 15A	n/a
Starting Current	95A	n/a
Alarm Functions:	Yes	10
	Phase inverter	n/a
		n/a
		n/a
Receptacle	Yes	10
Interior Lighting:	Yes	10
Exterior Lighting:	No	1
SCADA / Telemetry:	Yes	10
Main Breaker:	Yes	10
Control Panel:	Yes	10
Lighting Panel:	Yes	10
Flowmeter:	Yes	10
Grounding:	Yes	10
Lighting Protection:	Yes	10
UPS:	Yes	10
PLC:	Yes	10
Level Control:	Milltronics/bulbs	10
Standby Generator:	No	1
		132
Comments:	New Station	



PERFORMANCE CURVE

PRODUCT	NP3153.181	TYPE	HT
---------	------------	------	----



DATE	2011-07-22
------	------------

PROJECT	BRIDGEVIEW
---------	------------

CURVE NO	63-465-00-3050
----------	----------------

ISSUE	6
-------	---

MOTOR COS PHI	0.78	3/4-LOAD	0.71	1/2-LOAD	0.58	MOTOR SHAFT POWER	12	hp	IMPELLER DIAMETER			
MOTOR EFFICIENCY	88.5 %		88.5 %		87.0 %	STARTING CURRENT ...	228	A	239 mm			
GEAR EFFICIENCY	---		---		---	RATED CURRENT ...	32	A	MOTORTYPE	STATOR	REV	
COMMENTS				INLET/OUTLET	-100 mm	RATED SPEED	1765	rpm	21-15-4AA	05Y//	11	
				IMP. THROUGHLET	---	TOT.MOM.OF INERTIA ...	0.082	kgm2	FREQ.	PHASES	VOLTAGE	POLES
						NO. OF BLADES	2		60 Hz	3	230 V	4
									GEARTYPE	RATIO		
									---	---		

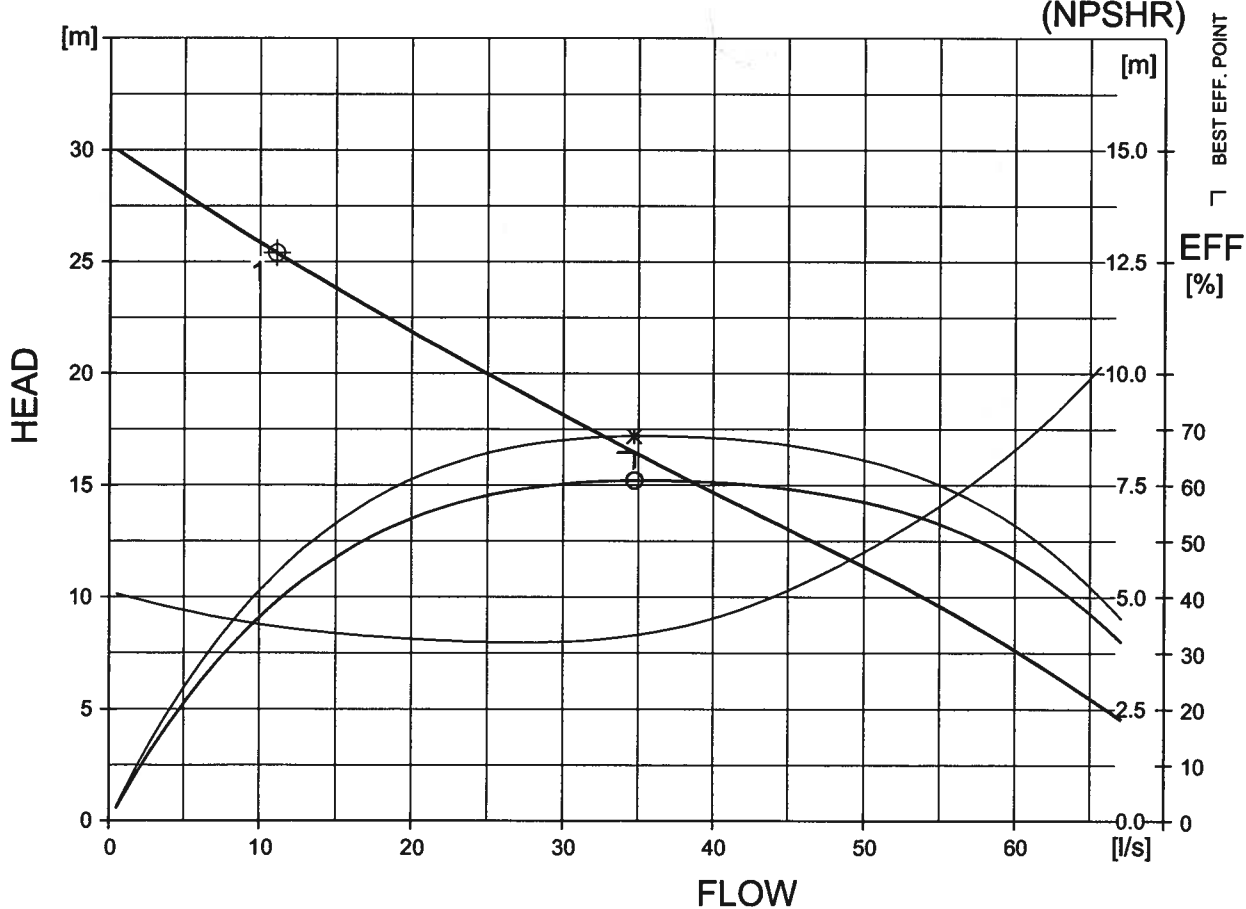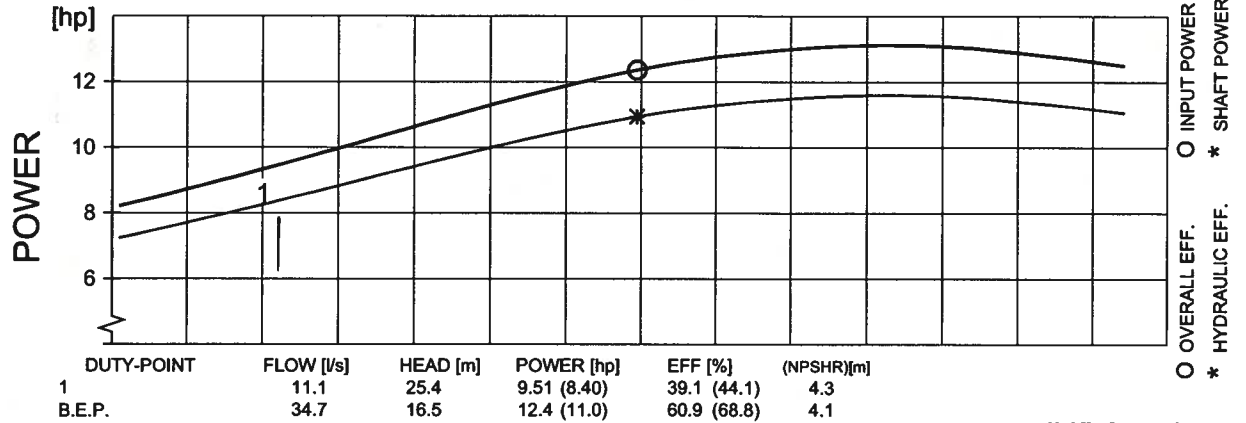

FLYPS3.1.6.6 (20090313)

(NPSHR) = (NPSH3) + margins

Performance with clear water and rating data at 40 °C



CURVE



District of West Kelowna

Sanitary Lift Station Evaluation

Station: East Boundary Road LS 28
Reviewed By: Jim Kentel

Year Constructed: 10/1/1993
Year Upgraded: No Info

Matrix Rating		
(10 - highest rating)	Civil	50
(1 - lowest rating)	Process Mechanical	110
	Electrical Instrumentation	140
	Total Station Rating	300 (max. rating 380 points)



Civil:Matrix
Rating

Parking Area:	_____	n/a
Drainage:	Good	10
Influent sewer:	375 PVC	10
Site access:	Good	10
Water service:	_____	10
Gas service:	Yes	10
		<u>50</u>

Process Mechanical:Matrix
Rating

Station type:	Above ground	n/a
Number of pumps:	2	n/a
Pump Redundancy:	Yes	n/a
Pump Manufacturer / Type:	Gorman Rupp	7
Pump Model:	T10A3-B	n/a
Rated Capacity:	110 L/S @ 21.3m TDH	n/a
Capacity Confirmation:	_____	n/a
Discharge pipe type / diameter:	/350	9
Header pipe type / diameter:	DI / 250	9
Check valve type / diameter:	Swing check / 250	8
Isolation valve type / diameter:	Plug / 250	8
Piping Condition:	Good	7
Emergency pumpout connection:	_____	1
Pressure gauges:	Yes	10
Inlet bar screen:	No	1
Wetwell condition:	Good	10
Access Hatches:	_____	5
Ladder / Platform:	No	1
Wetwell benching:	Good	8
Odour Control:	No	1
Ventilation:	Yes	10
Water washdown:	_____	10
Confined Space Entry Requirements	_____	5
		<u>110</u>

Electrical / Instrumentation:

Matrix
Rating

Service Type	V / A / Phase / Wire	n/a
Pump 1 :	HP 50	n/a
	Volts 575 Rpm 1150	n/a
	FLA	n/a
	Starter	n/a
Pump 2 :	HP 50	n/a
	Volts 575 Rpm 1150	n/a
	FLA	n/a
	Starter	n/a
Alarm Functions:	Yes	10
		n/a
		n/a
		n/a
Receptacle	Yes	10
Interior Lighting:	Yes	10
Exterior Lighting:	Yes	10
SCADA / Telemetry:	Yes	10
Main Breaker:		10
Control Panel:	Yes	10
Lighting Panel:	Yes	10
Flowmeter:	Yes	10
Grounding:	Yes	10
UPS:	Yes	10
PLC:	Yes	10
Level Control:	Milltronics/ Bulb	10
Standby Generator:	Natural gas engine	10
		140
Comments:	Wetwell capacity is limited	
	limited pump removal options	

EAST BOUNDARY

REQUIRED NPSH

Model **T10A-B** Size **10"**
 Imp. Dia. **14³/₄**
 RPM **VARIOUS**
 Max. Solids **3"**


TEST PERFORMANCE
 70°F clear water at sea level
 5 foot horizontal offset with
 10 inch suction pipe

REPRIMING LIFTS

- 650 rpm 7 feet - 750 rpm 11 feet
- 850 rpm 14 feet - 950 rpm 17 feet
- 1050 rpm 18 feet - 1150 rpm 22 feet
- 1250 rpm 19 feet - 1350 rpm 22 feet
- 1450 rpm 22 feet

Figure NPSH required prior to using
 above table. DO NOT use as available
 Suction Lifts.

Consult factory on operating conditions
 above 1350 rpm when TDSL exceeds 20 feet.

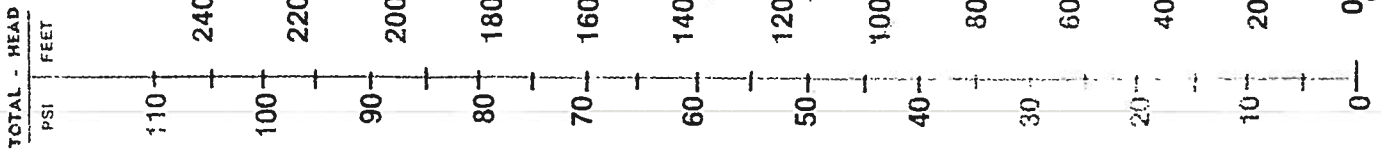

Contact the factory on special applications or applications exceeding
 priming or other performance limitations indicated.
 For Pump Performance Certification Apply to the Company.

U. S. GALLONS PER MINUTE

THE GEORGE BORMAN COMPANY

Printed in U. S. A.





Appendix E: Opinion of Probable Costs

**OPINION OF PROBABLE COST - RECOMMENDED BACKUP GENERATOR LOCATIONS ONLY
DISTRICT OF WEST KELOWNA
SANITARY SEWER LIFT STATIONS**

Stn No	Site Name	Pump HP	Site Power	Comment	Electrical Material Cost	Electrical Labour Cost	Telemetry Upgrade Cost	Civil	Pumping Station	Contingency & Engineering (40%)	Total	Year of Upgrade
1	Inverness	3	600V				\$ 5,000.00			\$ 2,000.00	\$ 7,000.00	2028
2	Glengary	2.3	240V				\$ 5,000.00			\$ 2,000.00	\$ 7,000.00	2030
3	Whitworth	6	600V	Needs new Kiosk and flowmeter	\$ 10,000.00	\$ 10,000.00	\$ 5,000.00	\$ 5,000.00		\$ 12,000.00	\$ 42,000.00	2025
4	Pineridge	2	240V	upgrade pumps to grinders			\$ 5,000.00		\$ 10,000.00	\$ 6,000.00	\$ 21,000.00	2031
5	Hitchner Jennings	6	600V	Needs new Kiosk and flowmeter	\$ 10,000.00	\$ 10,000.00	\$ 5,000.00	\$ 5,000.00		\$ 12,000.00	\$ 42,000.00	2024
6	Newport			Not in operation Puumped periodically				\$ 100,000.00		\$ 40,000.00	\$ 140,000.00	2018
7	Pritchard	10	600V	Needs new Kiosk and Genset for Backup Power	\$ 80,000.00	\$ 25,000.00	\$ 5,000.00	\$ 20,000.00		\$ 52,000.00	\$ 182,000.00	2020
8	Greenbay	20	600V	Needs new Kiosk and Genset for Backup Power	\$ 100,000.00	\$ 25,000.00	\$ 5,000.00	\$ 25,000.00		\$ 62,000.00	\$ 217,000.00	2019
9	Boucherie A			RDCO operated						\$ -	\$ -	
10	Boucherie B			RDCO operated						\$ -	\$ -	
11	Sunnyside	40	600V	Needs new Kiosk and Genset for Backup Power	\$ 120,000.00	\$ 25,000.00	\$ 5,000.00	\$ 30,000.00		\$ 72,000.00	\$ 252,000.00	2026
12	King	5.4	240V	Complete station c/w flowmeter	\$ 10,000.00	\$ 10,000.00	\$ 5,000.00	\$ 100,000.00	\$ 80,000.00	\$ 82,000.00	\$ 287,000.00	2022
13	Thacker	3	240V	Complete station c/w flowmeter	\$ 10,000.00	\$ 10,000.00	\$ 5,000.00	\$ 100,000.00	\$ 75,000.00	\$ 80,000.00	\$ 280,000.00	2023
14	Collins Hill	25	600V	Genset for Backup Power	\$ 35,000.00	\$ 10,000.00	\$ 5,000.00	\$ 20,000.00		\$ 28,000.00	\$ 98,000.00	2028
15	Casa Rio	1	240V	Complete station c/w flowmeter	\$ 10,000.00	\$ 10,000.00	\$ 5,000.00	\$ 110,000.00	\$ 75,000.00	\$ 84,000.00	\$ 294,000.00	2016
16	Stevens	20	600V	Needs Genset for Backup Power	\$ 35,000.00	\$ 10,000.00	\$ 5,000.00	\$ 20,000.00		\$ 28,000.00	\$ 98,000.00	2021
17	Somerset	3	240V	Complete station c/w flowmeter	\$ 10,000.00	\$ 10,000.00	\$ 5,000.00	\$ 100,000.00	\$ 75,000.00	\$ 80,000.00	\$ 280,000.00	2027
18	Devon Court	3	240V	Complete station c/w flowmeter	\$ 10,000.00	\$ 10,000.00	\$ 5,000.00	\$ 100,000.00	\$ 75,000.00	\$ 80,000.00	\$ 280,000.00	2026
19	Faulkner	75	600V	Upgraded in 2013						\$ -	\$ -	2013
20	Horizon		600V	Being Upgraded in 2015					\$ 930,000.00	\$ 372,000.00	\$ 1,302,000.00	2015
21	Kelokoa	1	240V	Station could be removed by gravity if SRW could be acquired				\$ 100,000.00		\$ 40,000.00	\$ 140,000.00	2015
22	Ross Road	20	600V	Needs Genset for Backup Power	\$ 35,000.00	\$ 10,000.00	\$ 5,000.00	\$ 20,000.00		\$ 28,000.00	\$ 98,000.00	2021
23	Brentwood	3.9	240V	Complete station	\$ 5,000.00	\$ 5,000.00	\$ 5,000.00	\$ 110,000.00	\$ 85,000.00	\$ 84,000.00	\$ 294,000.00	2020
24	Sunnybrae		240V	Complete station c/w flowmeter	\$ 10,000.00	\$ 10,000.00	\$ 5,000.00	\$ 100,000.00	\$ 80,000.00	\$ 82,000.00	\$ 287,000.00	2017
25	Ensign			Complete station c/w flowmeter	\$ 10,000.00	\$ 10,000.00	\$ 5,000.00	\$ 100,000.00	\$ 75,000.00	\$ 80,000.00	\$ 280,000.00	2015
26	Hayman	2.3	240V				\$ 5,000.00			\$ 2,000.00	\$ 7,000.00	2032
27	Bridgeview	15	600V	Needs Genset for Backup Power	\$ 40,000.00	\$ 10,000.00	\$ 5,000.00	\$ 20,000.00		\$ 30,000.00	\$ 105,000.00	2032
28	East Boundary	50	600V	Upgrade VFD's, PLCs and Radio Telemetry Upsize wetwell	\$ 50,000.00	\$ 25,000.00	\$ 5,000.00	\$ 100,000.00	\$ 75,000.00	\$ 102,000.00	\$ 357,000.00	2016
	Total				\$ 590,000.00	\$ 235,000.00	\$ 110,000.00	\$ 1,285,000.00	\$ 1,635,000.00	\$ 1,542,000.00	\$ 5,397,000.00	
	Less projects eligible for DCC funding (LS#8 and LS#20)										\$ 1,519,000.00	
	Total costs for capital work projects										\$ 3,878,000.00	